# **Subject To Field Inspection**

N TURAL F E US ACE CONCRETE IE ILE ILE IL	WALL ASSEMBLY TAG  ROOM TAG  DOOR TAG  PLUMBING FIXTURE TAG  FINISH & MATERIAL TAG  WINDOW TAG  CENTERLINE  NORTH ARROW  HOSE BIB	ROOM NAME 100  XXX SIZE  X1  SIZE  Q  L  L  L  L  L  L  L  L  L  L  L  L	PROJECT DESCRIPTION NEW MULTI-BUILDING, SINGLE-FAMILY AND DUPLEX, RESIDENTIAL ACTIVE LIVING RETIREMENT (55+) COMMUNITY DEVELOPMENT CONSISTING OF 33 DETACHED SINGLE-LEVEL HOUSES WITH ATTACHED GARAGES AND 35 SINGLE-LEVEL DUPLES (70 UNITS). THE DEVELOPMENT WILL GAIN ACCESS FROM RIDGETOP BLVD, NW AND FROM NW TIMBER SHADOW CT. THROUGH NEW GATED ENTRANCES. THE DEVELOPMENT WILL HAVE PRIVATE ACCESS CORRIDORS WITH SIDEWALKS AND DESIGNATED PARALLEL PARKING SPACES. A COMMUNITY CENTER (CONVENTION SPACE) AND MANAGEMENT OFFICE BUILDING, AS WELL AS A MAILBOX KIOSK, ARE INCLUDED IN THE PROPOSAL.  PROJECT ADDRESS 12000 RIDGETOP BLVD SILVERDALE, WA 98383  PROJECT SIZE	TODD STEEL T: 253-759-2287 Todd@Norpoint.com  ARCHITECT STEEL ARCHITECTS PLLC 2323 N. 31ST ST. TACOMA, WA 98403  CONTACT: JAMES STEEL	VOLUME 26 OF PLATS, PAGE(S) 214 THROUGH 217, INCLUSIVE AND LYING SOUTH OF THE SOUTHERLY BOUNDARY OF THE PLAT OF THACKERY HILLS, ACCORDING TO THE PLAT RECORDED IN VOLUME 26 OF PLATS, PAGE(S) 170 THROUGH 175, INCLUSIVE; EXCEPT THE PLAT OF TIMBER GLEN, ACCORDING TO THE PLAT RECORDED IN VOLUME 25 OF PLATS, PAGE(S) 145, 146 AND 147; EXCEPT THE EASTERLY PORTIONS OF SAID PREMISES DESCRIBED AS PARCELS B AND C IN DEED TO KITSAP COUNTY RECORDED UNDER AUDITOR'S FILE NO. 8503290061; EXCEPT THAT EASTERLY PORTION DESCRIBED IN DEED	A1.4 PARTIAL SITE PLAN A1.5 PARTIAL SITE PLAN A1.6 PARTIAL SITE PLAN A1.7 PARTIAL SITE PLAN A1.8 PARTIAL SITE PLAN A1.9 PARTIAL SITE PLAN	STEEL ARCHITE PLLC  CONTACT: JAMES STEEL PO BOX 7600 TACOMA WA 98
TURAL  F  US  ACE CONCRETE  ILE  ILE  L	ROOM TAG  DOOR TAG  PLUMBING FIXTURE TAG  FINISH & MATERIAL TAG  WINDOW TAG  CENTERLINE  NORTH ARROW	ROOM NAME 100  XXX  SIZE  X1  SIZE  Q	RESIDENTIAL ACTIVE LIVING RETIREMENT (55+) COMMUNITY DEVELOPMENT CONSISTING OF 33 DETACHED SINGLE-LEVEL HOUSES WITH ATTACHED GARAGES AND 35 SINGLE-LEVEL DUPLES (70 UNITS). THE DEVELOPMENT WILL GAIN ACCESS FROM RIDGETOP BLVD. NW AND FROM NW TIMBER SHADOW CT. THROUGH NEW GATED ENTRANCES. THE DEVELOPMENT WILL HAVE PRIVATE ACCESS CORRIDORS WITH SIDEWALKS AND DESIGNATED PARALLEL PARKING SPACES. A COMMUNITY CENTER (CONVENTION SPACE) AND MANAGEMENT OFFICE BUILDING, AS WELL AS A MAILBOX KIOSK, ARE INCLUDED IN THE PROPOSAL.  PROJECT ADDRESS 12000 RIDGETOP BLVD SILVERDALE, WA 98383	PO BOX 2132 TACOMA, WA 98401  CONTACT: TODD STEEL T: 253-759-2287 Todd@Norpoint.com  ARCHITECT STEEL ARCHITECTS PLLC 2323 N. 31ST ST. TACOMA, WA 98403  CONTACT: JAMES STEEL	QUARTER AND OF THE WEST THREE QUARTERS OF THE NORTHEAST QUARTER OF THE SOUTHWEST QUARTER, SECTION 10, TOWNSHIP 25 NORTH, RANGE 1 EAST, W.M., IN KITSAP COUNTY, WASHINGTON, LYING EASTERLY OF RIDGETOP BOULEVARD AS CONVEYED TO KITSAP COUNTY BY DEED RECORDED UNDER AUDITOR'S FILE NO. 8503290061 AND LYING NORTH OF THE NORTHERLYBOUNDARY OF THE PLAT OF NORTHWOOD SUBDIVISION, ACCORDING TO THE PLAT RECORDED IN VOLUME 26 OF PLATS, PAGE(S) 214 THROUGH 217, INCLUSIVE AND LYING SOUTH OF THE SOUTHERLY BOUNDARY OF THE PLAT OF THACKERY HILLS, ACCORDING TO THE PLAT RECORDED IN VOLUME 26 OF PLATS, PAGE(S) 170 THROUGH 175, INCLUSIVE; EXCEPT THE PLAT OF TIMBER GLEN, ACCORDING TO THE PLAT RECORDED IN VOLUME 25 OF PLATS, PAGE(S) 145, 146 AND 147; EXCEPT THE EASTERLY PORTIONS OF SAID PREMISES DESCRIBED AS PARCELS B AND C IN DEED TO KITSAP COUNTY RECORDED UNDER AUDITOR'S FILE NO. 8503290061; EXCEPT THAT EASTERLY PORTION DESCRIBED IN DEED	A1.2 PARTIAL SITE PLAN A1.3 PARTIAL SITE PLAN A1.4 PARTIAL SITE PLAN A1.5 PARTIAL SITE PLAN A1.6 PARTIAL SITE PLAN A1.7 PARTIAL SITE PLAN A1.8 PARTIAL SITE PLAN A1.9 PARTIAL SITE PLAN A2.1 BUILDING 'Y' FLOOR PLAN A2.2 BUILDING 'Y' ROOF PLAN A2.2 BUILDING 'Y' ROOF PLAN - ALT. 'A' A2.2-B BUILDING 'Y' ROOF PLAN - ALT. 'B'	CONTACT: JAMES STEEL PO BOX 7600
TURAL  F  US  ACE CONCRETE  ILE  ILE  L	DOOR TAG  PLUMBING FIXTURE TAG  FINISH & MATERIAL TAG  WINDOW TAG  CENTERLINE  NORTH ARROW	ROOM NAME  100  XXX  SIZE  X1  SIZE  Q	COMMUNITY DEVELOPMENT CONSISTING OF 33 DETACHED SINGLE-LEVEL HOUSES WITH ATTACHED GARAGES AND 35 SINGLE-LEVEL DUPLES (70 UNITS). THE DEVELOPMENT WILL GAIN ACCESS FROM RIDGETOP BLVD. NW AND FROM NW TIMBER SHADOW CT. THROUGH NEW GATED ENTRANCES. THE DEVELOPMENT WILL HAVE PRIVATE ACCESS CORRIDORS WITH SIDEWALKS AND DESIGNATED PARALLEL PARKING SPACES. A COMMUNITY CENTER (CONVENTION SPACE) AND MANAGEMENT OFFICE BUILDING, AS WELL AS A MAILBOX KIOSK, ARE INCLUDED IN THE PROPOSAL.  PROJECT ADDRESS 12000 RIDGETOP BLVD SILVERDALE, WA 98383	TACOMA, WA 98401  CONTACT: TODD STEEL T: 253-759-2287 Todd@Norpoint.com  ARCHITECT STEEL ARCHITECTS PLLC 2323 N. 31ST ST. TACOMA, WA 98403  CONTACT: JAMES STEEL	QUARTER OF THE SOUTHWEST QUARTER, SECTION 10, TOWNSHIP 25 NORTH, RANGE 1 EAST, W.M., IN KITSAP COUNTY, WASHINGTON, LYING EASTERLY OF RIDGETOP BOULEVARD AS CONVEYED TO KITSAP COUNTY BY DEED RECORDED UNDER AUDITOR'S FILE NO. 8503290061 AND LYING NORTH OF THE NORTHERLYBOUNDARY OF THE PLAT OF NORTHWOOD SUBDIVISION, ACCORDING TO THE PLAT RECORDED IN VOLUME 26 OF PLATS, PAGE(S) 214 THROUGH 217, INCLUSIVE AND LYING SOUTH OF THE SOUTHERLY BOUNDARY OF THE PLAT OF THACKERY HILLS, ACCORDING TO THE PLAT RECORDED IN VOLUME 26 OF PLATS, PAGE(S) 170 THROUGH 175, INCLUSIVE; EXCEPT THE PLAT OF TIMBER GLEN, ACCORDING TO THE PLAT RECORDED IN VOLUME 25 OF PLATS, PAGE(S) 145, 146 AND 147; EXCEPT THE EASTERLY PORTIONS OF SAID PREMISES DESCRIBED AS PARCELS B AND C IN DEED TO KITSAP COUNTY RECORDED UNDER AUDITOR'S FILE NO. 8503290061; EXCEPT THAT EASTERLY PORTION DESCRIBED IN DEED	A1.3 PARTIAL SITE PLAN A1.4 PARTIAL SITE PLAN A1.5 PARTIAL SITE PLAN A1.6 PARTIAL SITE PLAN A1.7 PARTIAL SITE PLAN A1.8 PARTIAL SITE PLAN A1.9 PARTIAL SITE PLAN A2.1 BUILDING 'Y' FLOOR PLAN A2.2 BUILDING 'Y' ROOF PLAN A2.2-A BUILDING 'Y' ROOF PLAN - ALT. 'A' A2.2-B BUILDING 'Y' ROOF PLAN - ALT. 'B'	JAMES STEEL PO BOX 7600
TURAL  F  US  ACE CONCRETE  ILE  ILE  L	DOOR TAG  PLUMBING FIXTURE TAG  FINISH & MATERIAL TAG  WINDOW TAG  CENTERLINE  NORTH ARROW	XXX SIZE  X1  SIZE  X1  SIZE	DETACHED SINGLE-LEVEL HOUSES WITH ATTACHED GARAGES AND 35 SINGLE-LEVEL DUPLES (70 UNITS). THE DEVELOPMENT WILL GAIN ACCESS FROM RIDGETOP BLVD NW AND FROM NW TIMBER SHADOW CT. THROUGH NEW GATED ENTRANCES. THE DEVELOPMENT WILL HAVE PRIVATE ACCESS CORRIDORS WITH SIDEWALKS AND DESIGNATED PARALLEL PARKING SPACES. A COMMUNITY CENTER (CONVENTION SPACE) AND MANAGEMENT OFFICE BUILDING, AS WELL AS A MAILBOX KIOSK, ARE INCLUDED IN THE PROPOSAL.  PROJECT ADDRESS 12000 RIDGETOP BLVD SILVERDALE, WA 98383	CONTACT: TODD STEEL T: 253-759-2287 Todd@Norpoint.com  ARCHITECT STEEL ARCHITECTS PLLC 2323 N. 31ST ST. TACOMA, WA 98403  CONTACT: JAMES STEEL	NORTH, RANGE 1 EAST, W.M., IN KITSAP COUNTY, WASHINGTON, LYING EASTERLY OF RIDGETOP BOULEVARD AS CONVEYED TO KITSAP COUNTY BY DEED RECORDED UNDER AUDITOR'S FILE NO. 8503290061 AND LYING NORTH OF THE NORTHERLYBOUNDARY OF THE PLAT OF NORTHWOOD SUBDIVISION, ACCORDING TO THE PLAT RECORDED IN VOLUME 26 OF PLATS, PAGE(S) 214 THROUGH 217, INCLUSIVE AND LYING SOUTH OF THE SOUTHERLY BOUNDARY OF THE PLAT OF THACKERY HILLS, ACCORDING TO THE PLAT RECORDED IN VOLUME 26 OF PLATS, PAGE(S) 170 THROUGH 175, INCLUSIVE; EXCEPT THE PLAT OF TIMBER GLEN, ACCORDING TO THE PLAT RECORDED IN VOLUME 25 OF PLATS, PAGE(S) 145, 146 AND 147; EXCEPT THE EASTERLY PORTIONS OF SAID PREMISES DESCRIBED AS PARCELS B AND C IN DEED TO KITSAP COUNTY RECORDED UNDER AUDITOR'S FILE NO. 8503290061; EXCEPT THAT EASTERLY PORTION DESCRIBED IN DEED	A1.4 PARTIAL SITE PLAN A1.5 PARTIAL SITE PLAN A1.6 PARTIAL SITE PLAN A1.7 PARTIAL SITE PLAN A1.8 PARTIAL SITE PLAN A1.9 PARTIAL SITE PLAN A2.1 BUILDING 'Y' FLOOR PLAN A2.2 BUILDING 'Y' ROOF PLAN A2.2-A BUILDING 'Y' ROOF PLAN - ALT. 'A' A2.2-B BUILDING 'Y' ROOF PLAN - ALT. 'B'	PO BOX 7600
TURAL  F : US ACE CONCRETE  IE  ILE  L	DOOR TAG  PLUMBING FIXTURE TAG  FINISH & MATERIAL TAG  WINDOW TAG  CENTERLINE  NORTH ARROW	XXXX SIZE  \(\infty\) \(\infty\) \(\infty\) SIZE	GARAGES AND 35 SINGLE-LEVEL DUPLES (70 UNITS). THE DEVELOPMENT WILL GAIN ACCESS FROM RIDGETOP BLVD. NW AND FROM NW TIMBER SHADOW CT. THROUGH NEW GATED ENTRANCES. THE DEVELOPMENT WILL HAVE PRIVATE ACCESS CORRIDORS WITH SIDEWALKS AND DESIGNATED PARALLEL PARKING SPACES. A COMMUNITY CENTER (CONVENTION SPACE) AND MANAGEMENT OFFICE BUILDING, AS WELL AS A MAILBOX KIOSK, ARE INCLUDED IN THE PROPOSAL.  PROJECT ADDRESS 12000 RIDGETOP BLVD SILVERDALE, WA 98383	TODD STEEL T: 253-759-2287 Todd@Norpoint.com  ARCHITECT STEEL ARCHITECTS PLLC 2323 N. 31ST ST. TACOMA, WA 98403  CONTACT: JAMES STEEL	EASTERLY OF RIDGETOP BOULEVARD AS CONVEYED TO KITSAP COUNTY BY DEED RECORDED UNDER AUDITOR'S FILE NO. 8503290061 AND LYING NORTH OF THE NORTHERLYBOUNDARY OF THE PLAT OF NORTHWOOD SUBDIVISION, ACCORDING TO THE PLAT RECORDED IN VOLUME 26 OF PLATS, PAGE(S) 214 THROUGH 217, INCLUSIVE AND LYING SOUTH OF THE SOUTHERLY BOUNDARY OF THE PLAT OF THACKERY HILLS, ACCORDING TO THE PLAT RECORDED IN VOLUME 26 OF PLATS, PAGE(S) 170 THROUGH 175, INCLUSIVE; EXCEPT THE PLAT OF TIMBER GLEN, ACCORDING TO THE PLAT RECORDED IN VOLUME 25 OF PLATS, PAGE(S) 145, 146 AND 147; EXCEPT THE EASTERLY PORTIONS OF SAID PREMISES DESCRIBED AS PARCELS B AND C IN DEED TO KITSAP COUNTY RECORDED UNDER AUDITOR'S FILE NO. 8503290061; EXCEPT THAT EASTERLY PORTION DESCRIBED IN DEED	A1.5 PARTIAL SITE PLAN A1.6 PARTIAL SITE PLAN A1.7 PARTIAL SITE PLAN A1.8 PARTIAL SITE PLAN A1.9 PARTIAL SITE PLAN A2.1 BUILDING 'Y' FLOOR PLAN A2.2 BUILDING 'Y' ROOF PLAN A2.2-A BUILDING 'Y' ROOF PLAN - ALT. 'A' A2.2-B BUILDING 'Y' ROOF PLAN - ALT. 'B'	
TURAL  F E US ACE CONCRETE  IE  ILE  L	PLUMBING FIXTURE TAG  FINISH & MATERIAL TAG  WINDOW TAG  CENTERLINE  NORTH ARROW	SIZE  \( \infty \)  \( \times \)  SIZE  \( \times \)  SIZE	DEVELOPMENT WILL GAIN ACCESS FROM RIDGETOP BLVD. NW AND FROM NW TIMBER SHADOW CT. THROUGH NEW GATED ENTRANCES. THE DEVELOPMENT WILL HAVE PRIVATE ACCESS CORRIDORS WITH SIDEWALKS AND DESIGNATED PARALLEL PARKING SPACES. A COMMUNITY CENTER (CONVENTION SPACE) AND MANAGEMENT OFFICE BUILDING, AS WELL AS A MAILBOX KIOSK, ARE INCLUDED IN THE PROPOSAL.  PROJECT ADDRESS 12000 RIDGETOP BLVD SILVERDALE, WA 98383	TODD STEEL T: 253-759-2287 Todd@Norpoint.com  ARCHITECT STEEL ARCHITECTS PLLC 2323 N. 31ST ST. TACOMA, WA 98403  CONTACT: JAMES STEEL	AND LYING NORTH OF THE NORTHERLYBOUNDARY OF THE PLAT OF NORTHWOOD SUBDIVISION, ACCORDING TO THE PLAT RECORDED IN VOLUME 26 OF PLATS, PAGE(S) 214 THROUGH 217, INCLUSIVE AND LYING SOUTH OF THE SOUTHERLY BOUNDARY OF THE PLAT OF THACKERY HILLS, ACCORDING TO THE PLAT RECORDED IN VOLUME 26 OF PLATS, PAGE(S) 170 THROUGH 175, INCLUSIVE; EXCEPT THE PLAT OF TIMBER GLEN, ACCORDING TO THE PLAT RECORDED IN VOLUME 25 OF PLATS, PAGE(S) 145, 146 AND 147; EXCEPT THE EASTERLY PORTIONS OF SAID PREMISES DESCRIBED AS PARCELS B AND C IN DEED TO KITSAP COUNTY RECORDED UNDER AUDITOR'S FILE NO. 8503290061; EXCEPT THAT EASTERLY PORTION DESCRIBED IN DEED	A1.7 PARTIAL SITE PLAN A1.8 PARTIAL SITE PLAN A1.9 PARTIAL SITE PLAN A2.1 BUILDING 'Y' FLOOR PLAN A2.2 BUILDING 'Y' ROOF PLAN A2.2-A BUILDING 'Y' ROOF PLAN - ALT. 'A' A2.2-B BUILDING 'Y' ROOF PLAN - ALT. 'B'	TACOMA WA 9
FEUS ACE CONCRETE  ILE  ILE  L	PLUMBING FIXTURE TAG  FINISH & MATERIAL TAG  WINDOW TAG  CENTERLINE  NORTH ARROW	SIZE  \( \infty \)  \( \times \)  SIZE  \( \times \)  SIZE	GATED ENTRANCES. THE DEVELOPMENT WILL HAVE PRIVATE ACCESS CORRIDORS WITH SIDEWALKS AND DESIGNATED PARALLEL PARKING SPACES. A COMMUNITY CENTER (CONVENTION SPACE) AND MANAGEMENT OFFICE BUILDING, AS WELL AS A MAILBOX KIOSK, ARE INCLUDED IN THE PROPOSAL.  PROJECT ADDRESS 12000 RIDGETOP BLVD SILVERDALE, WA 98383	T: 253-759-2287 Todd@Norpoint.com  ARCHITECT STEEL ARCHITECTS PLLC 2323 N. 31ST ST. TACOMA, WA 98403  CONTACT: JAMES STEEL	VOLUME 26 OF PLATS, PAGE(S) 214 THROUGH 217, INCLUSIVE AND LYING SOUTH OF THE SOUTHERLY BOUNDARY OF THE PLAT OF THACKERY HILLS, ACCORDING TO THE PLAT RECORDED IN VOLUME 26 OF PLATS, PAGE(S) 170 THROUGH 175, INCLUSIVE; EXCEPT THE PLAT OF TIMBER GLEN, ACCORDING TO THE PLAT RECORDED IN VOLUME 25 OF PLATS, PAGE(S) 145, 146 AND 147; EXCEPT THE EASTERLY PORTIONS OF SAID PREMISES DESCRIBED AS PARCELS B AND C IN DEED TO KITSAP COUNTY RECORDED UNDER AUDITOR'S FILE NO. 8503290061; EXCEPT THAT EASTERLY PORTION DESCRIBED IN DEED	A1.8 PARTIAL SITE PLAN A1.9 PARTIAL SITE PLAN A2.1 BUILDING 'Y' FLOOR PLAN A2.2 BUILDING 'Y' ROOF PLAN A2.2-A BUILDING 'Y' ROOF PLAN - ALT. 'A' A2.2-B BUILDING 'Y' ROOF PLAN - ALT. 'B'	
EUS ACE CONCRETE  IE  ILE  ILE  L	FINISH & MATERIAL TAG  WINDOW TAG  CENTERLINE  NORTH ARROW	X1  SIZE  E	PRIVATE ACCESS CORRIDORS WITH SIDEWALKS AND DESIGNATED PARALLEL PARKING SPACES. A COMMUNITY CENTER (CONVENTION SPACE) AND MANAGEMENT OFFICE BUILDING, AS WELL AS A MAILBOX KIOSK, ARE INCLUDED IN THE PROPOSAL.  PROJECT ADDRESS 12000 RIDGETOP BLVD SILVERDALE, WA 98383	ARCHITECT STEEL ARCHITECTS PLLC 2323 N. 31ST ST. TACOMA, WA 98403  CONTACT: JAMES STEEL	LYING SOUTH OF THE SOUTHERLY BOUNDARY OF THE PLAT OF THACKERY HILLS, ACCORDING TO THE PLAT RECORDED IN VOLUME 26 OF PLATS, PAGE(S) 170 THROUGH 175, INCLUSIVE; EXCEPT THE PLAT OF TIMBER GLEN, ACCORDING TO THE PLAT RECORDED IN VOLUME 25 OF PLATS, PAGE(S) 145, 146 AND 147; EXCEPT THE EASTERLY PORTIONS OF SAID PREMISES DESCRIBED AS PARCELS B AND C IN DEED TO KITSAP COUNTY RECORDED UNDER AUDITOR'S FILE NO. 8503290061; EXCEPT THAT EASTERLY PORTION DESCRIBED IN DEED	A1.9 PARTIAL SITE PLAN A2.1 BUILDING 'Y' FLOOR PLAN A2.2 BUILDING 'Y' ROOF PLAN A2.2-A BUILDING 'Y' ROOF PLAN - ALT. 'A' A2.2-B BUILDING 'Y' ROOF PLAN - ALT. 'B'	
EUS ACE CONCRETE  IE  ILE  ILE  L	FINISH & MATERIAL TAG  WINDOW TAG  CENTERLINE  NORTH ARROW	X1  SIZE  E	DESIGNATED PARALLEL PARKING SPACES. A COMMUNITY CENTER (CONVENTION SPACE) AND MANAGEMENT OFFICE BUILDING, AS WELL AS A MAILBOX KIOSK, ARE INCLUDED IN THE PROPOSAL.  PROJECT ADDRESS 12000 RIDGETOP BLVD SILVERDALE, WA 98383	STEEL ARCHITECTS PLLC 2323 N. 31ST ST. TACOMA, WA 98403  CONTACT: JAMES STEEL	THACKERY HILLS, ACCORDING TO THE PLAT RECORDED IN VOLUME 26 OF PLATS, PAGE(S) 170 THROUGH 175, INCLUSIVE; EXCEPT THE PLAT OF TIMBER GLEN, ACCORDING TO THE PLAT RECORDED IN VOLUME 25 OF PLATS, PAGE(S) 145, 146 AND 147; EXCEPT THE EASTERLY PORTIONS OF SAID PREMISES DESCRIBED AS PARCELS B AND C IN DEED TO KITSAP COUNTY RECORDED UNDER AUDITOR'S FILE NO. 8503290061; EXCEPT THAT EASTERLY PORTION DESCRIBED IN DEED	A2.1 BUILDING 'Y' FLOOR PLAN A2.2 BUILDING 'Y' ROOF PLAN A2.2-A BUILDING 'Y' ROOF PLAN - ALT. 'A' A2.2-B BUILDING 'Y' ROOF PLAN - ALT. 'B'	
US ACE CONCRETE  IE  ILE  ILE  L	FINISH & MATERIAL TAG  WINDOW TAG  CENTERLINE  NORTH ARROW	X1  SIZE  E	CENTER (CONVENTION SPACE) AND MANAGEMENT OFFICE BUILDING, AS WELL AS A MAILBOX KIOSK, ARE INCLUDED IN THE PROPOSAL.  PROJECT ADDRESS 12000 RIDGETOP BLVD SILVERDALE, WA 98383	STEEL ARCHITECTS PLLC 2323 N. 31ST ST. TACOMA, WA 98403  CONTACT: JAMES STEEL	OF PLATS, PAGE(S) 170 THROUGH 175, INCLUSIVE; EXCEPT THE PLAT OF TIMBER GLEN, ACCORDING TO THE PLAT RECORDED IN VOLUME 25 OF PLATS, PAGE(S) 145, 146 AND 147; EXCEPT THE EASTERLY PORTIONS OF SAID PREMISES DESCRIBED AS PARCELS B AND C IN DEED TO KITSAP COUNTY RECORDED UNDER AUDITOR'S FILE NO. 8503290061; EXCEPT THAT EASTERLY PORTION DESCRIBED IN DEED	A2.2 BUILDING 'Y' ROOF PLAN A2.2-A BUILDING 'Y' ROOF PLAN - ALT. 'A' A2.2-B BUILDING 'Y' ROOF PLAN - ALT. 'B'	
ILE I ER	WINDOW TAG  CENTERLINE  NORTH ARROW	SIZE	OFFICE BUILDING, AS WELL AS A MAILBOX KIOSK, ARE INCLUDED IN THE PROPOSAL.  PROJECT ADDRESS 12000 RIDGETOP BLVD SILVERDALE, WA 98383	2323 N. 31ST ST. TACOMA, WA 98403  CONTACT: JAMES STEEL	OF PLATS, PAGE(S) 145, 146 AND 147; EXCEPT THE EASTERLY PORTIONS OF SAID PREMISES DESCRIBED AS PARCELS B AND C IN DEED TO KITSAP COUNTY RECORDED UNDER AUDITOR'S FILE NO. 8503290061; EXCEPT THAT EASTERLY PORTION DESCRIBED IN DEED	A2.2-A BUILDING 'Y' ROOF PLAN - ALT. 'A' A2.2-B BUILDING 'Y' ROOF PLAN - ALT. 'B'	
ILE I ER	WINDOW TAG  CENTERLINE  NORTH ARROW	SIZE	PROJECT ADDRESS 12000 RIDGETOP BLVD SILVERDALE, WA 98383	TACOMA, WA 98403  CONTACT:  JAMES STEEL	PORTIONS OF SAID PREMISES DESCRIBED AS PARCELS B AND C IN DEED TO KITSAP COUNTY RECORDED UNDER AUDITOR'S FILE NO. 8503290061; EXCEPT THAT EASTERLY PORTION DESCRIBED IN DEED		
ILE I ER	CENTERLINE  NORTH ARROW	SIZE	12000 RIDGETOP BLVD SILVERDALE, WA 98383	JAMES STEEL	8503290061; EXCEPT THAT EASTERLY PORTION DESCRIBED IN DEED	A3.1 BUILDING 'Y' EXTERIOR ELEVATIONS	
I ER L	CENTERLINE  NORTH ARROW	SIZE	12000 RIDGETOP BLVD SILVERDALE, WA 98383	JAMES STEEL	,		1
I ER L	CENTERLINE  NORTH ARROW	SIZE	SILVERDALE, WA 98383		TO KITSAP COUNTY RECORDED UNDER AUDITOR'S FILE NO.	A3.1-A BUILDING 'Y' EXTERIOR ELEVATIONS - ALT. 'A' A3.1-B BUILDING 'Y' EXTERIOR ELEVATIONS - ALT. 'B'	
I ER L	NORTH ARROW	Ç		ו וי אלי אין אין אין אין אין אין אין אין אין אי	8312060091.	A3.2 BUILDING 'Y' EXTERIOR ELEVATIONS	
ER L	NORTH ARROW	Ç	PROJECT SIZE	T: 253-883-3826 James@SteelArchitects.com	PARCEL II:	A3.2-A BUILDING 'Y' EXTERIOR ELEVATIONS - ALT. 'A'	
L			<del></del>		THE EAST QUARTER OF THE NORTHEAST QUARTER OF THE	A3.2-B BUILDING 'Y' EXTERIOR ELEVATIONS - ALT. 'B'	
L				CIVIL ENGINEER	SOUTHWEST QUARTER, SECTION 10, TOWNSHIP 25 NORTH, RANGE 1	A4.1 BUILDING 'Y' BUILDING SECTIONS	
			DETACHED SINGLE-FAMILY HOUSES (BUILDING TYPE X)	CONTOUR ENGINEERING LLC	EAST, W.M., IN KITSAP COUNTY, WASHINGTON; EXCEPT THE NORTH 30		
	HOSE BIB		1488 SF RESIDENCE 468 SF GARAGE	4706 97TH ST NW	FEET OF THE SOUTH 707 FEET OF THE WEST 15 FEET.	A4.1-B BUILDING 'Y' BUILDING SECTIONS - ALT. 'B'	
	HOSE BIB		99 SF PORCH	GIG HARBOR, WA 98332		A6.1 WINDOW AND DOOR SCHEDULES A6.2 WALL SCHEDULE	
		4	2,055 SF	CONTACT:	CODE DATA	A7.1 EXTERIOR DETAILS	111
Т		<u> </u>		BRETT ALLEN		A7.2 EXTERIOR DETAILS	
Τ	2		TOTAL 2055 SF X 33 BUILDINGS <u>67,815 SF</u>	T: 253-857-5454	APPLICABLE CODES <u>KITSAP COUNTY CODE</u>	A7.3 EXTERIOR DETAILS	
	SMOKE DETECTOR	SD		Brett.Allen@ContourEngineeringLLC.com	2015 IBC, AS AMMENDED BY WA	A8.1 BUILDING 'Y' INTERIOR ELEVATIONS	
			DUPLEX Y (BUILDING TYPE Y)  1284 SF RESIDENCE	LANDOCADE ADDITION	STATE AND KITSAP COUNTY		
OR	EXHAUST FAN		473 SF GARAGE	LANDSCAPE ARCHITECT		E1.1 BUILDING 'Y' ELECTRICAL PLAN	$\sim$
Off	27(17(00) 17(1)	E	99 SF PORCH	LYON LANDSCAPE ARCHITECTS	2015 IRC, AS AMMENDED BY WA		<del></del>
			1856 SF X 2 UNITS = 3.712 SF	1015 PACIFIC AVENUE, SUITE #203 TACOMA, WA	STATE AND KITSAP COUNTY		111
•	ELEVATION MARK	• T.O. MARK ELEV +0'-0"	_	T: 253-209-4053	2015 WA ENERGY CODE (WSEC)	BASIC PERMIT PACKAGE	=
		ELEV +U -U	TOTAL 3712 SF X 19 BUILDINGS <u>70,528 SF</u>		WA STATE FUEL GAS CODE	REVIEWED FOR CODE COMPLIANCE	
GE	GRID LINE	(X)		<u>SURVEY</u>	<u> </u>	WITH IRC 2015	<del> </del>
D	GRID LINE	X	DUPLEX Z (BUILDING TYPE Z) 1278 SF RESIDENCE	CONTOUR ENGINEERING LLC	OCCUPANCY R-3 (IRC) - PERMANENT SINGLE	KITSAP COUNTY BUILDING DEPARTMENT	
ORE			299 SF GARAGE	4706 97TH ST NW	FAMILY OR DUPLEX DWELLING		
ONE	ENLARGED DETAIL MARK	(XX AX.X)	99 SF PORCH	GIG HARBOR, WA 98332			
AL			1070 CE V 0 LINITO 0 050 CE	CONTACT:	CONSTRUCTION TYPE V-B (IBC) UNPROTECTED WOOD		
ENT/AC				BRETT ALLEN	FRAME (NON-SPRINKLERED)	CHANGES	(A)
	BUILDING SECTION MARK	AX.X)	─ TOTAL 3352 SF X 16 BUILDINGS <u>53,632 SF</u>	T: 253-857-5454		MUST Be Approved Prior	
N				Brett.Allen@ContourEngineeringLLC.com	Validity of permit. The issuance or granting of a permit shall not be construed to be a permit for, or an approval of, any violation of any	To Performing Work	
	SECTION MARK	$\begin{pmatrix} 1 \\ \Lambda \vee \vee \end{pmatrix}$	COMMUNITY CENTER (NOT INCLUDED WITH THIS APPLIC.) 2541 SF INTERIOR	anliance	of the provisions of the International Codes or any other ordinance of Kitsap County. Permits presuming to give authority to violate or		
DNAL RESIDENTIAL CODE		(AA.A)	640 SF GARAGE	tor code compli-	cancel the provisions of the International Codes and ordinances of Kitsap County shall not be valid. IBC & IRC 105		
			187 SF FRONT PORCH	Reviewed for code 2015  Reviewed for code 2015  With IRC 2015  Department			
	EXTERIOR ELEVATION MARK	$\begin{pmatrix} X \\ AX.X \end{pmatrix}$	512 SF BACK PORCH	anty Burrago.War		Must Comply With	
OT/FEET			3,880 SF	Kitsap Octobria @Co.1/2020	compliance	All Washington	<b> </b> (
		X	TOTAL 3,880 SF X 1 BUILDING 3,880 SF	and for cor	ode compliance RC 2015 uilding Department oo kitsap.wa.us	State Codes	
AL	INTERIOR ELEVATION MARK	1	101AL 3,000 SF X 1 BUILDING 3,000 SF	Reviewed with IRV	uilding Departs		
URER		^ AX.X/ ^			50.1.		
		X	MAILBOX KIOSK (NOT INCLUDED WITH THIS APPLIC.)	GShapiro 05/0	04/2023	N. E.	
IEOUS			TOTAL 330 SF <u>330 SF</u>	NW Gustafson Rd NW Blissful Ln		W Rd	
				MA DA	See	Valle	10044 RE
7				Ln NW	NW Schold by Strillium Heights	and the second s	AR AR
R SQUARE INCH			TOTAL BUILDING AREA 196,185 SF	E 3	The Signature Apartments & Apartments	NW Olivia Rd	Jan H
ER SQUARE FOOT			100,1000	i jear i	Treetops Apartments Q	Central Valley Rd NE	JAMES RANDA
TREATED				NW Westgate Rd	NW Misty Ridge Lo	Central Parky Nu NE	STATE OF WA
_E				MAN Rd N		27/1/// eac	
				BB 2	E BOINT DY NYM		
OCEILING PLAN ATOR				Clear Creek RV Center	PROJECT PROJECT		ISSUANCES:
				NW Flintwood Ct. E. NW Bisch El.	LOCATION Rum	Walker Rd NW Walker Rd NE	BLDG. PERMIT
				NW Hosman Cir -	Rotary	Ď B	1 REV 1
				K R d J	Gateway Park	WE Wal	
ENING				Cree		NW Sigurd Henson Rd 등	
	KITSAP COUNTY			Old F	Santa Fe Ridge	d Z	
	DEPARTMENT OF			No Traile at Silverdale	Apartments		
RADE	COMMUNITY			1			
TIONS	DEVELOPMENT			The Home Depot	Ridgetop Q Marigory	NWEIKLE CONTROL VOLLOW	
	Approved Dutlation Descrite"			3			22 X 34 =
	Approved Building Permit #S:				OB 6 pg.		$ 22 \times 34  =  11 \times 17  =  11 \times 17 $
STEEL	19-02320			All Star Lanes	s & Casino Q	Centr	
	19-03256			3		o Va	DRAWING TI
STEEL	19-03257			and the state of t	NW Myhre Rd	Jubile R	
STEEL	1			with the same of t	Lowe's Home	STU DI NE	GENERAL INFOF
STEEL				NW Highland Ct Target 💽		(B) (B)	
STEEL				Kitsap Mall Silverdale S C	N N N N N N N N N N N N N N N N N N N	NW Paulson Rd NE Paulson Rd NE Paul	
STEEL AL ND GROOVE				S Silverdale 3.0			
STEEL				Kitsap Victoria	Costco Wholesale	nice .	I SHEET NIIM
STEEL AL ND GROOVE				Esap Mal	Costco Wholesale (2)  NE Wadda (2)  NW Hogan L	nice Ave	SHEET NUM
STEEL AL ND GROOVE				Central Kitsap Wellington Wellington	Costco Wholesale P	Ln Tupelo Way NW	SHEET NUME
STEEL AL ND GROOVE				Esap Mal	Costco Wholesale P		
STEEL AL ND GROOVE THERWISE NOTED				Central Kitsap Wellington Wellington NW KRSap Pl	Costco Wholesale Ridgetop Blvd NW  Ridgetop Blvd NW  Ridgetop Blvd NW		
STEEL AL ND GROOVE				Central Kitsap Wellington Wellington NW KRsap Pl  NW KRsap Pl  Rid	Costco Wholesale		A0.1
STEEL AL ND GROOVE THERWISE NOTED				Central Kitsap Wellington Wellington NW KRSap Pl	Costco Wholesale Ridgetop Blvd NW  Ridgetop Blvd NW  Ridgetop Blvd NW		AO.1
EN	ING DE NS	ING  KITSAP COUNTY DEPARTMENT OF COMMUNITY DEVELOPMENT  Approved Building Permit #s:  19-02320 19-03256 19-03257	ING  KITSAP COUNTY DEPARTMENT OF COMMUNITY DEVELOPMENT  Approved Building Permit #s:  19-02320 19-03256 19-03257	ING  KITSAP COUNTY DEPARTMENT OF COMMUNITY DEVELOPMENT  Approved Building Permit #s:  19-02320 19-03256 19-03257	ING  KITSAP COUNTY DEPARTMENT OF COMMUNITY DEVELOPMENT  Approved Building Permit #s:  19-02320 19-03256 19-03257  GROOVE	ROUNG  KITSAP COUNTY DEPARTMENT OF COMMUNITY DEVELOPMENT  Apartments  Approved Building Permit #s:  19-02320 19-03257  GROOVE	RICE CPECTOR OF COUNTY  DEPARTMENT OF  COMMUNITY  DEVELOPMENT  Approve Building Permit #s:  19-02320 19-03256 19-03257  GROOVE

Permit Number: 20-01252

1	BUILDING NUMBER	BUILDING TYPE	MIRRORED (FLOOR PLAN FLIPPED BLDG X)	ALTERNATE (TERRACED UNIT BLDG Y)
3	1	Χ	NO	
4	2	X	NO	
4	3	X	NO	
5				
6				
7			110	
8				
9 Y Y YES 110 X YES 111 Z 12 Y A A 13 X YES 14 X NO 15 X YES 16 X NO 17 X YES 18 X NO 19 X NO 20 X YES 21 X NO 22 X YES 21 X NO 22 X YES 23 X NO 24 X YES 25 X NO 26 X NO 27 Z 28 Y B 29 Y A A 30 Y A 31 Z 32 Y B 33 X YES 34 Y B 35 Z 36 Z 37 Z 38 Z 39 Z 40 Y 41 Z 42 Y 43 Z 44 Z 45 Y 46 Z 47 Z 48 Y 49 Y 50 Y 51 Y 50 Y 51 Y 50 Y 51 Y 50 Y 51 Y 51 Y 52 Y 53 Z 54 Z 55 Y 56 Y 56 Y 56 Y 56 X 50 NO 60 X YES 66 X NO 62 X YES 66 X NO 66 X NO 66 X NO 66 X YES 66 X NO 67 X NO 68 X YES 66 X YES 66 X YES 66 X YES 66 X NO 67 X NO 68 X YES 66 X YES 66 X YES 66 X YES 66 X NO 67 X NO 68 X NO 69 X YES 66 X NO COM, CENTER				
110				
111         Z         A           12         Y         A           13         X         YES           14         X         NO           15         X         YES           16         X         NO           17         X         YES           18         X         NO           20         X         YES           21         X         NO           22         X         YES           21         X         NO           22         X         YES           23         X         NO           24         X         YES           25         X         NO           26         X         NO           27         Z         Z           28         Y         B           29         Y         A           30         Y         A           31         Z         B           33         X         YES           34         Y         A           35         Z         A           36         Z         A				
12	10		YES	
13	11	Z		
14	12	Υ		Α
16	13	X	YES	
16	14	X		
16				
17         X         YES           18         X         NO           19         X         NO           20         X         YES           21         X         NO           22         X         YES           23         X         NO           24         X         YES           25         X         NO           26         X         NO           27         Z         Z           28         Y         B           29         Y         A           30         Y         A           31         Z         B           33         X         YES           34         Y         A           35         Z         B           36         Z         37           38         Z         39           2         Y         A           40         Y         44           41         Z         44           42         Y         A           45         Y         A           46         Z         A           47				
18         X         NO           19         X         NO           20         X         YES           21         X         NO           22         X         YES           23         X         NO           24         X         YES           25         X         NO           26         X         NO           27         Z         Z           28         Y         B           29         Y         A           30         Y         A           31         Z         B           33         X         YES           34         Y         A           35         Z         B           34         Y         A           35         Z         A           36         Z         A           37         Z         A           38         Z         A           39         Z         A           40         Y         Y           41         Z         A           47         Z         A           48				
19	17	X		
20         X         YES           21         X         NO           22         X         YES           23         X         NO           24         X         YES           25         X         NO           26         X         NO           27         Z         B           28         Y         B           29         Y         A           30         Y         A           31         Z         B           32         Y         B           33         X         YES           34         Y         A           35         Z         A           36         Z         337           37         Z         38           39         Z         A           40         Y         Y           41         Z         A           42         Y         A           43         Z         A           44         Z         A           45         Y         A           51         Y         B           51 <td>18</td> <td>X</td> <td>NO</td> <td></td>	18	X	NO	
20         X         YES           21         X         NO           22         X         YES           23         X         NO           24         X         YES           25         X         NO           26         X         NO           27         Z         B           28         Y         B           29         Y         A           30         Y         A           31         Z         B           32         Y         B           33         X         YES           34         Y         A           35         Z         A           36         Z         337           37         Z         38           39         Z         A           40         Y         44           41         Z         A           45         Y         A           45         Y         A           46         Z         A           47         Z         A           48         Y         A           49 <td>19</td> <td>X</td> <td>NO</td> <td></td>	19	X	NO	
21         X         NO           22         X         YES           23         X         NO           24         X         YES           25         X         NO           26         X         NO           27         Z         Z           28         Y         B           29         Y         A           30         Y         A           31         Z         B           32         Y         B           33         X         YES           34         Y         A           35         Z         B           36         Z         A           36         Z         A           38         Z         A           39         Z         A           40         Y         Y           41         Z         A           45         Y         A           46         Z         A           47         Z         A           48         Y         A           49         Y         B           51	20	Χ	YES	
22         X         YES           23         X         NO           24         X         YES           25         X         NO           26         X         NO           27         Z           28         Y         B           29         Y         A           30         Y         A           31         Z         B           32         Y         B           33         X         YES           34         Y         A           35         Z         B           36         Z         33           36         Z         33           38         Z         33           39         Z         40           40         Y         41           42         Y         43           44         Z         44           45         Y         46           2         47         Z           48         Y         49           49         Y         B           51         Y         B           52         Y<				
23         X         NO           24         X         YES           25         X         NO           26         X         NO           27         Z         B           28         Y         B           29         Y         A           30         Y         A           31         Z         B           33         X         YES           34         Y         A           35         Z         36           36         Z         37           38         Z         38           39         Z         40           41         Z         44           42         Y         43           44         Z         44           47         Z         44           49         Y         B           50         Y         B           51         Y         B           52         Y         A           53         Z         55           54         Z         55           7         X         YES           58<				
24         X         YES           25         X         NO           26         X         NO           27         Z         Z           28         Y         B           29         Y         A           30         Y         A           31         Z         B           33         X         YES           34         Y         A           35         Z         A           36         Z         33           37         Z         38           39         Z         40           40         Y         41           42         Y         43           2         44         Z           44         Z         44           47         Z         48           49         Y         B           50         Y         B           51         Y         B           51         Y         A           52         Y         A           53         Z         A           54         Z         A           55				
25         X         NO           26         X         NO           27         Z         B           28         Y         B           29         Y         A           30         Y         A           31         Z         B           32         Y         B           33         X         YES           34         Y         A           35         Z         A           36         Z         A           37         Z         A           38         Z         A           39         Z         A           40         Y         Y           41         Z         Y           42         Y         Y           44         Z         Y           45         Y         Y           46         Z         Y           47         Z         A           51         Y         B           51         Y         B           52         Y         A           53         Z         A           55         <				
26       X       NO         27       Z         28       Y       B         29       Y       A         30       Y       A         31       Z       B         32       Y       B         33       X       YES         34       Y       A         35       Z       A         36       Z       A         37       Z       A         38       Z       A         39       Z       A         40       Y       A         41       Z       A         42       Y       A         43       Z       A         44       Z       A         45       Y       A         46       Z       A         47       Z       A         48       Y       A         49       Y       B         51       Y       B         51       Y       B         52       Y       A         53       Z       A         55       Y       A				
27       Z         28       Y         29       Y         30       Y         31       Z         32       Y         33       X         34       Y         35       Z         36       Z         37       Z         38       Z         39       Z         40       Y         41       Z         42       Y         43       Z         44       Z         45       Y         46       Z         47       Z         48       Y         49       Y         50       Y       B         51       Y       B         52       Y       A         53       Z       A         54       Z       A         55       Y       B         57       X       YES         58       X       YES         58       X       YES         55       Y       A         57       X       YES	25	Χ	NO	
27       Z         28       Y         29       Y         30       Y         31       Z         32       Y         33       X         34       Y         35       Z         36       Z         37       Z         38       Z         39       Z         40       Y         41       Z         42       Y         43       Z         44       Z         45       Y         46       Z         47       Z         48       Y         49       Y         50       Y       B         51       Y       B         52       Y       A         53       Z       A         54       Z       A         55       Y       B         57       X       YES         58       X       YES         58       X       YES         55       Y       A         57       X       YES	26	X	NO	
28         Y         A           30         Y         A           31         Z         B           32         Y         B           33         X         YES           34         Y         A           35         Z         A           36         Z         A           37         Z         A           38         Z         A           39         Z         A           40         Y         A           41         Z         A           42         Y         A           43         Z         A           44         Z         A           45         Y         A           46         Z         A           47         Z         A           48         Y         A           49         Y         B           51         Y         B           52         Y         A           53         Z         A           54         Z         A           55         Y         A           56 <td< td=""><td></td><td></td><td></td><td></td></td<>				
29       Y       A         30       Y       A         31       Z       B         32       Y       B         33       X       YES         34       Y       A         35       Z       36         36       Z       37         38       Z       39         39       Z       40         40       Y       41         41       Z       42         42       Y       43         44       Z       44         45       Y       46         47       Z       48         49       Y       B         50       Y       B         51       Y       B         52       Y       A         53       Z       55         56       Y       55         57       X       YES         58       X       YES         59       X       NO         60       X       YES         63       X       NO         64       X       YES         66<				R
30       Y       A         31       Z       B         32       Y       B         33       X       YES         34       Y       A         35       Z       A         36       Z       33         37       Z       38         39       Z       A         40       Y       A         41       Z       A         42       Y       A         43       Z       A         44       Z       A         45       Y       B         46       Z       A         47       Z       B         48       Y       B         51       Y       B         51       Y       B         51       Y       B         52       Y       A         53       Z       A         54       Z       A         55       Y       B         57       X       YES         58       X       YES         59       X       NO         60				
31       Z         32       Y       B         33       X       YES         34       Y       A         35       Z       A         36       Z       37         38       Z       39         40       Y       41         41       Z       42         43       Z       44         44       Z       44         45       Y       46         47       Z       48         49       Y       B         51       Y       B         51       Y       B         51       Y       B         51       Y       B         52       Y       A         53       Z       A         54       Z       A         55       Y       B         57       X       YES         58       X       YES         59       X       NO         60       X       YES         61       X       NO         62       X       YES         63       X				
32       Y       YES         33       X       YES         34       Y       A         35       Z       36         37       Z       38         39       Z       39         40       Y       41         41       Z       42         43       Z       44         45       Y       46         47       Z       48         49       Y       B         50       Y       B         51       Y       B         52       Y       A         53       Z       55         54       Z       55         57       X       YES         58       X       YES         59       X       NO         60       X       YES         61       X       NO         62       X       YES         63       X       NO         64       X       YES         65       X       YES         66       X       NO         66       X       NO	30	Y		A
33       X       YES         34       Y       A         35       Z         36       Z         37       Z         38       Z         39       Z         40       Y         41       Z         42       Y         43       Z         44       Z         45       Y         46       Z         47       Z         48       Y         49       Y         50       Y       B         51       Y       B         52       Y       A         53       Z         54       Z       A         55       Y       B         57       X       YES         59       X       NO         60       X       YES         61       X       NO         62       X       YES         63       X       NO         64       X       YES         65       X       YES         66       X       NO <td< td=""><td>31</td><td>Z</td><td></td><td></td></td<>	31	Z		
34       Y       A         35       Z         36       Z         37       Z         38       Z         39       Z         40       Y         41       Z         42       Y         43       Z         44       Z         45       Y         46       Z         47       Z         48       Y         49       Y         50       Y       B         51       Y       B         51       Y       B         52       Y       A         53       Z       A         55       Y       B         57       X       YES         58       X       YES         59       X       NO         60       X       YES         61       X       NO         62       X       YES         63       X       NO         64       X       YES         65       X       YES         66       X       NO	32	Υ		В
34       Y       A         35       Z         36       Z         37       Z         38       Z         39       Z         40       Y         41       Z         42       Y         43       Z         44       Z         45       Y         46       Z         47       Z         48       Y         49       Y         50       Y       B         51       Y       B         51       Y       B         52       Y       A         53       Z       A         55       Y       B         57       X       YES         58       X       YES         59       X       NO         60       X       YES         61       X       NO         62       X       YES         63       X       NO         64       X       YES         65       X       YES         66       X       NO	33	X	YES	
35       Z         36       Z         37       Z         38       Z         39       Z         40       Y         41       Z         42       Y         43       Z         44       Z         45       Y         46       Z         47       Z         48       Y         49       Y         50       Y       B         51       Y       B         51       Y       B         52       Y       A         53       Z         54       Z         55       Y         56       Y         57       X       YES         58       X       YES         59       X       NO         60       X       YES         61       X       NO         62       X       YES         63       X       NO         64       X       YES         65       X       YES         66       X       NO <td></td> <td></td> <td>, = 5</td> <td>Δ</td>			, = 5	Δ
36       Z         37       Z         38       Z         39       Z         40       Y         41       Z         42       Y         43       Z         44       Z         45       Y         46       Z         47       Z         48       Y         49       Y         50       Y       B         51       Y       B         51       Y       B         52       Y       A         53       Z       A         54       Z       A         55       Y       YES         58       X       YES         59       X       NO         60       X       YES         61       X       NO         62       X       YES         63       X       NO         64       X       YES         65       X       YES         66       X       NO         677       X       NO         678       X <t< td=""><td></td><td></td><td></td><td>/ \</td></t<>				/ \
37				
38       Z         39       Z         40       Y         41       Z         42       Y         43       Z         44       Z         45       Y         46       Z         47       Z         48       Y         49       Y         50       Y       B         51       Y       B         52       Y       A         53       Z       S         54       Z       A         55       Y       S         56       Y       YES         58       X       YES         59       X       NO         60       X       YES         61       X       NO         62       X       YES         63       X       NO         64       X       YES         65       X       YES         66       X       NO         67       X       NO         67       X       NO         68       X       NO <td< td=""><td></td><td></td><td></td><td></td></td<>				
39       Z         40       Y         41       Z         42       Y         43       Z         44       Z         45       Y         46       Z         47       Z         48       Y         49       Y         50       Y       B         51       Y       B         51       Y       B         52       Y       A         53       Z       A         54       Z       A         55       Y       A         56       Y       YES         58       X       YES         59       X       NO         60       X       YES         61       X       NO         62       X       YES         63       X       NO         64       X       YES         65       X       YES         66       X       NO         67       X       NO         68       X       NO         66       X       NO	37	Z		
40 Y 41 Z 42 Y 43 Z 44 Z 45 Y 46 Z 47 Z 48 Y 49 Y 50 Y B 51 Y B 51 Y B 52 Y A 53 Z 54 Z 55 Y 56 Y 57 X YES 58 X YES 59 X NO 60 X YES 61 X NO 62 X YES 63 X NO 64 X YES 66 X NO 67 X NO 68 X NO 68 X NO 60 COM. CENTER	38	Z		
40 Y 41 Z 42 Y 43 Z 44 Z 45 Y 46 Z 47 Z 48 Y 49 Y 50 Y B 51 Y B 51 Y B 52 Y A 53 Z 54 Z 55 Y 56 Y 57 X YES 58 X YES 59 X NO 60 X YES 61 X NO 62 X YES 63 X NO 64 X YES 66 X NO 67 X NO 68 X NO 68 X NO 60 COM. CENTER	39	Z		
41       Z         42       Y         43       Z         44       Z         45       Y         46       Z         47       Z         48       Y         49       Y         50       Y       B         51       Y       B         51       Y       B         52       Y       A         53       Z       A         54       Z       A         55       Y       YES         58       X       YES         59       X       NO         60       X       YES         61       X       NO         62       X       YES         63       X       NO         64       X       YES         65       X       YES         66       X       NO         67       X       NO         68       X       NO         68       X       NO         60M. CENTER       Image: Company of the company	40	Υ		
42       Y         43       Z         44       Z         45       Y         46       Z         47       Z         48       Y         49       Y         50       Y       B         51       Y       B         51       Y       A         53       Z       A         54       Z       A         55       Y       A         56       Y       YES         58       X       YES         59       X       NO         60       X       YES         61       X       NO         62       X       YES         63       X       NO         64       X       YES         65       X       YES         66       X       NO         67       X       NO         68       X       NO         68       X       NO         60M. CENTER       Image: Content of the c				
43 Z 44 Z 45 Y 46 Z 47 Z 48 Y 49 Y 50 Y B 51 Y B 52 Y A 53 Z 54 Z 55 Y 56 Y 57 X YES 58 X YES 59 X NO 60 X YES 61 X NO 62 X YES 63 X NO 64 X YES 65 X YES 66 X YES 66 X NO 67 X NO 68 X NO 60 COM. CENTER				
44       Z         45       Y         46       Z         47       Z         48       Y         49       Y         50       Y       B         51       Y       B         52       Y       A         53       Z       A         54       Z       A         55       Y       YES         58       X       YES         59       X       NO         60       X       YES         61       X       NO         62       X       YES         63       X       NO         64       X       YES         65       X       YES         66       X       NO         67       X       NO         68       X       NO         68       X       NO         COM.       CENTER       Image: Content of the				
45 Y 46 Z 47 Z 48 Y 49 Y 50 Y B 51 Y B 52 Y A 53 Z 54 Z 55 Y 56 Y 57 X YES 58 X YES 59 X NO 60 X YES 61 X NO 62 X YES 63 X NO 64 X YES 65 X YES 66 X YES 66 X YES 66 X NO 67 X NO 68 X NO 68 X NO 60 COM. CENTER				
46       Z         47       Z         48       Y         49       Y         50       Y       B         51       Y       B         52       Y       A         53       Z       A         54       Z       A         55       Y       A         56       Y       YES         58       X       YES         59       X       NO         60       X       YES         61       X       NO         62       X       YES         63       X       NO         64       X       YES         65       X       YES         66       X       NO         67       X       NO         68       X       NO         COM.       CENTER       NO				
47       Z         48       Y         49       Y         50       Y         51       Y         51       Y         52       Y         53       Z         54       Z         55       Y         56       Y         57       X       YES         59       X       NO         60       X       YES         61       X       NO         62       X       YES         63       X       NO         64       X       YES         65       X       YES         66       X       NO         67       X       NO         68       X       NO         COM.       CENTER       NO	45	Υ		
47       Z         48       Y         49       Y         50       Y         51       Y         51       Y         52       Y         53       Z         54       Z         55       Y         56       Y         57       X       YES         59       X       NO         60       X       YES         61       X       NO         62       X       YES         63       X       NO         64       X       YES         65       X       YES         66       X       NO         67       X       NO         68       X       NO         COM.       CENTER       NO	46	Z		
48       Y         49       Y         50       Y         51       Y         51       Y         52       Y         53       Z         54       Z         55       Y         56       Y         57       X       YES         59       X       NO         60       X       YES         61       X       NO         62       X       YES         63       X       NO         64       X       YES         65       X       YES         66       X       NO         67       X       NO         68       X       NO         COM.       CENTER       NO	47			
49       Y         50       Y         51       Y         51       Y         52       Y         53       Z         54       Z         55       Y         56       Y         57       X       YES         58       X       YES         59       X       NO         60       X       YES         61       X       NO         62       X       YES         63       X       NO         64       X       YES         65       X       YES         66       X       NO         67       X       NO         68       X       NO         COM.       CENTER       Incompany of the property				
50       Y       B         51       Y       B         52       Y       A         53       Z       A         54       Z       A         55       Y       A         56       Y       A         57       X       YES         59       X       NO         60       X       YES         61       X       NO         62       X       YES         63       X       NO         64       X       YES         65       X       YES         66       X       NO         67       X       NO         68       X       NO         COM.       CENTER       NO				
51       Y       B         52       Y       A         53       Z       A         54       Z       A         55       Y       B         56       Y       YES         58       X       YES         59       X       NO         60       X       YES         61       X       NO         62       X       YES         63       X       NO         64       X       YES         65       X       YES         66       X       NO         67       X       NO         68       X       NO         COM.       COM.       CENTER				
52       Y       A         53       Z         54       Z         55       Y         56       Y         57       X         58       X         59       X         60       X         61       X         61       X         62       X         63       X         64       X         65       X         66       X         67       X         NO         68       X         COM.         CENTER				
53       Z         54       Z         55       Y         56       Y         57       X       YES         58       X       YES         59       X       NO         60       X       YES         61       X       NO         62       X       YES         63       X       NO         64       X       YES         65       X       YES         66       X       NO         67       X       NO         68       X       NO         COM.       CENTER       NO				
54       Z         55       Y         56       Y         57       X       YES         58       X       YES         59       X       NO         60       X       YES         61       X       NO         62       X       YES         63       X       NO         64       X       YES         65       X       YES         66       X       NO         67       X       NO         68       X       NO         COM.       CENTER	52	Υ		A
54       Z         55       Y         56       Y         57       X       YES         58       X       YES         59       X       NO         60       X       YES         61       X       NO         62       X       YES         63       X       NO         64       X       YES         65       X       YES         66       X       NO         67       X       NO         68       X       NO         COM.       CENTER	53	Z		
55       Y         56       Y         57       X       YES         58       X       YES         59       X       NO         60       X       YES         61       X       NO         62       X       YES         63       X       NO         64       X       YES         65       X       YES         66       X       NO         67       X       NO         68       X       NO         COM.       CENTER				
56       Y         57       X       YES         58       X       YES         59       X       NO         60       X       YES         61       X       NO         62       X       YES         63       X       NO         64       X       YES         65       X       YES         66       X       NO         67       X       NO         68       X       NO         COM.       CENTER				
57       X       YES         58       X       YES         59       X       NO         60       X       YES         61       X       NO         62       X       YES         63       X       NO         64       X       YES         65       X       YES         66       X       NO         67       X       NO         68       X       NO         COM.       CENTER				
58       X       YES         59       X       NO         60       X       YES         61       X       NO         62       X       YES         63       X       NO         64       X       YES         65       X       YES         66       X       NO         67       X       NO         68       X       NO         COM.       COM.       CENTER			VEO	
59       X       NO         60       X       YES         61       X       NO         62       X       YES         63       X       NO         64       X       YES         65       X       YES         66       X       NO         67       X       NO         68       X       NO         COM.       CENTER				
60 X YES 61 X NO 62 X YES 63 X NO 64 X YES 65 X YES 66 X NO 67 X NO 68 X NO COM. CENTER				
61 X NO 62 X YES 63 X NO 64 X YES 65 X YES 66 X NO 67 X NO 68 X NO COM. CENTER	59	X	NO	
62       X       YES         63       X       NO         64       X       YES         65       X       YES         66       X       NO         67       X       NO         68       X       NO         COM.       CENTER	60	Χ	YES	
62       X       YES         63       X       NO         64       X       YES         65       X       YES         66       X       NO         67       X       NO         68       X       NO         COM.       CENTER	61	Χ	NO	
63 X NO 64 X YES 65 X YES 66 X NO 67 X NO 68 X NO COM. CENTER				
64 X YES 65 X YES 66 X NO 67 X NO 68 X NO COM. CENTER				
65 X YES 66 X NO 67 X NO 68 X NO COM. CENTER				
66 X NO 67 X NO 68 X NO COM. CENTER				
67 X NO 68 X NO COM. CENTER		X		
68 X NO COM. CENTER	66	X	NO	
68 X NO COM. CENTER	67	X	NO	
COM. CENTER				
	COM.			
MAIL BOX	MAILBOX			

## **BUILDING USE MATRIX**

-		
	BUILDING TYPE	USE
	X	RESIDENTIAL COTTAGE (SINGLE FAMILY DWELLING) V TWO-CAR GARAGE
	Y	DUPLEX (TWO DWELLING BUILDING) W/ TWO-CAR GARAGE EACH UNIT
	Z	DUPLEX (TWO DWELLING BUILDING) W/ ONE-CAR GARAGE EACH UNIT

## GENERAL SITE PLAN NOTES

- 1. REFER TO CIVIL FOR: WATER PURVEYOR, FIRE PROTECTION SYSTEM & HYDRANT LOCATIONS, CIRCULATION PLAN, ACCESS CORRIDOR TURNING RADII, & EMERGENCY VEHICLE ACCESS
- ROAD CRITERIA.

  2. REFER TO LANDSCAPE DRAWINGS FOR PLANTING AND LANDSCAPE IRRIGATION INFORMATION.

BASIC PERMIT PACKAGE REVIEWED FOR CODE COMPLIANCE
WITH IRC 2015
KITSAP COUNTY BUILDING DEPARTMENT

STEEL ARCHITECTS PLLC

CONTACT: JAMES STEEL PO BOX 7600 TACOMA WA 98417

> ES ON BLVD NW 98383 7 120 SIL

REGISTERED ARCHITECT JAMES RANDALL STEEL STATE OF WASHINGTON

ISSUANCES: BLDG. PERMIT 2018.12.10 2019.04.10

22 X 34 = FULL SIZE 11 X 17 = HALF SIZE

DRAWING TITLE: SITE PLAN -OVERALL

SHEET NUMBER:

A1.1

BLDG. PERMIT APPLIC.



GENERAL SITE PLAN NOTES

- 1. REFER TO CIVIL FOR: WATER PURVEYOR, FIRE PROTECTION SYSTEM & HYDRANT LOCATIONS, CIRCULATION PLAN, ACCESS CORRIDOR TURNING RADII, & EMERGENCY VEHICLE ACCESS

  POAD CRITERIA.
- ROAD CRITERIA.

  2. REFER TO LANDSCAPE DRAWINGS FOR PLANTING AND LANDSCAPE IRRIGATION INFORMATION.

CONTACT:
JAMES STEEL
PO BOX 7600
TACOMA WA 98417

STEEL ARCHITECTS

PLLC

BASIC PERMIT PACKAGE
REVIEWED FOR CODE COMPLIANCE
WITH IRC 2015
KITSAP COUNTY BUILDING DEPARTMENT

Reviewed for code complied

With IRC 2015

With IRC 2015

With IRC 2015

Kitsap County Building Department

PQuiriar @ co.kitsap.wa.us

05/01/2020

Reviewed for code compliance

With IRC 2015

E RIDGE

COTTAGES ON THE RID 12000 RIDGETOP BLVD NW SILVERDALE, WA 98383

REGISTERED ARCHITECT

JAMES RANDALL STEEL STATE OF WASHINGTON

ISSUANCES:

BLDG. PERMIT 2018.12.10 REV 1 2019.04.10

22 X 34 = FULL SIZE 11 X 17 = HALF SIZE


DRAWING TITLE:

PARTIAL SITE PLAN

SHEET NUMBER:

A1.2

BLDG. PERMIT APPLIC.

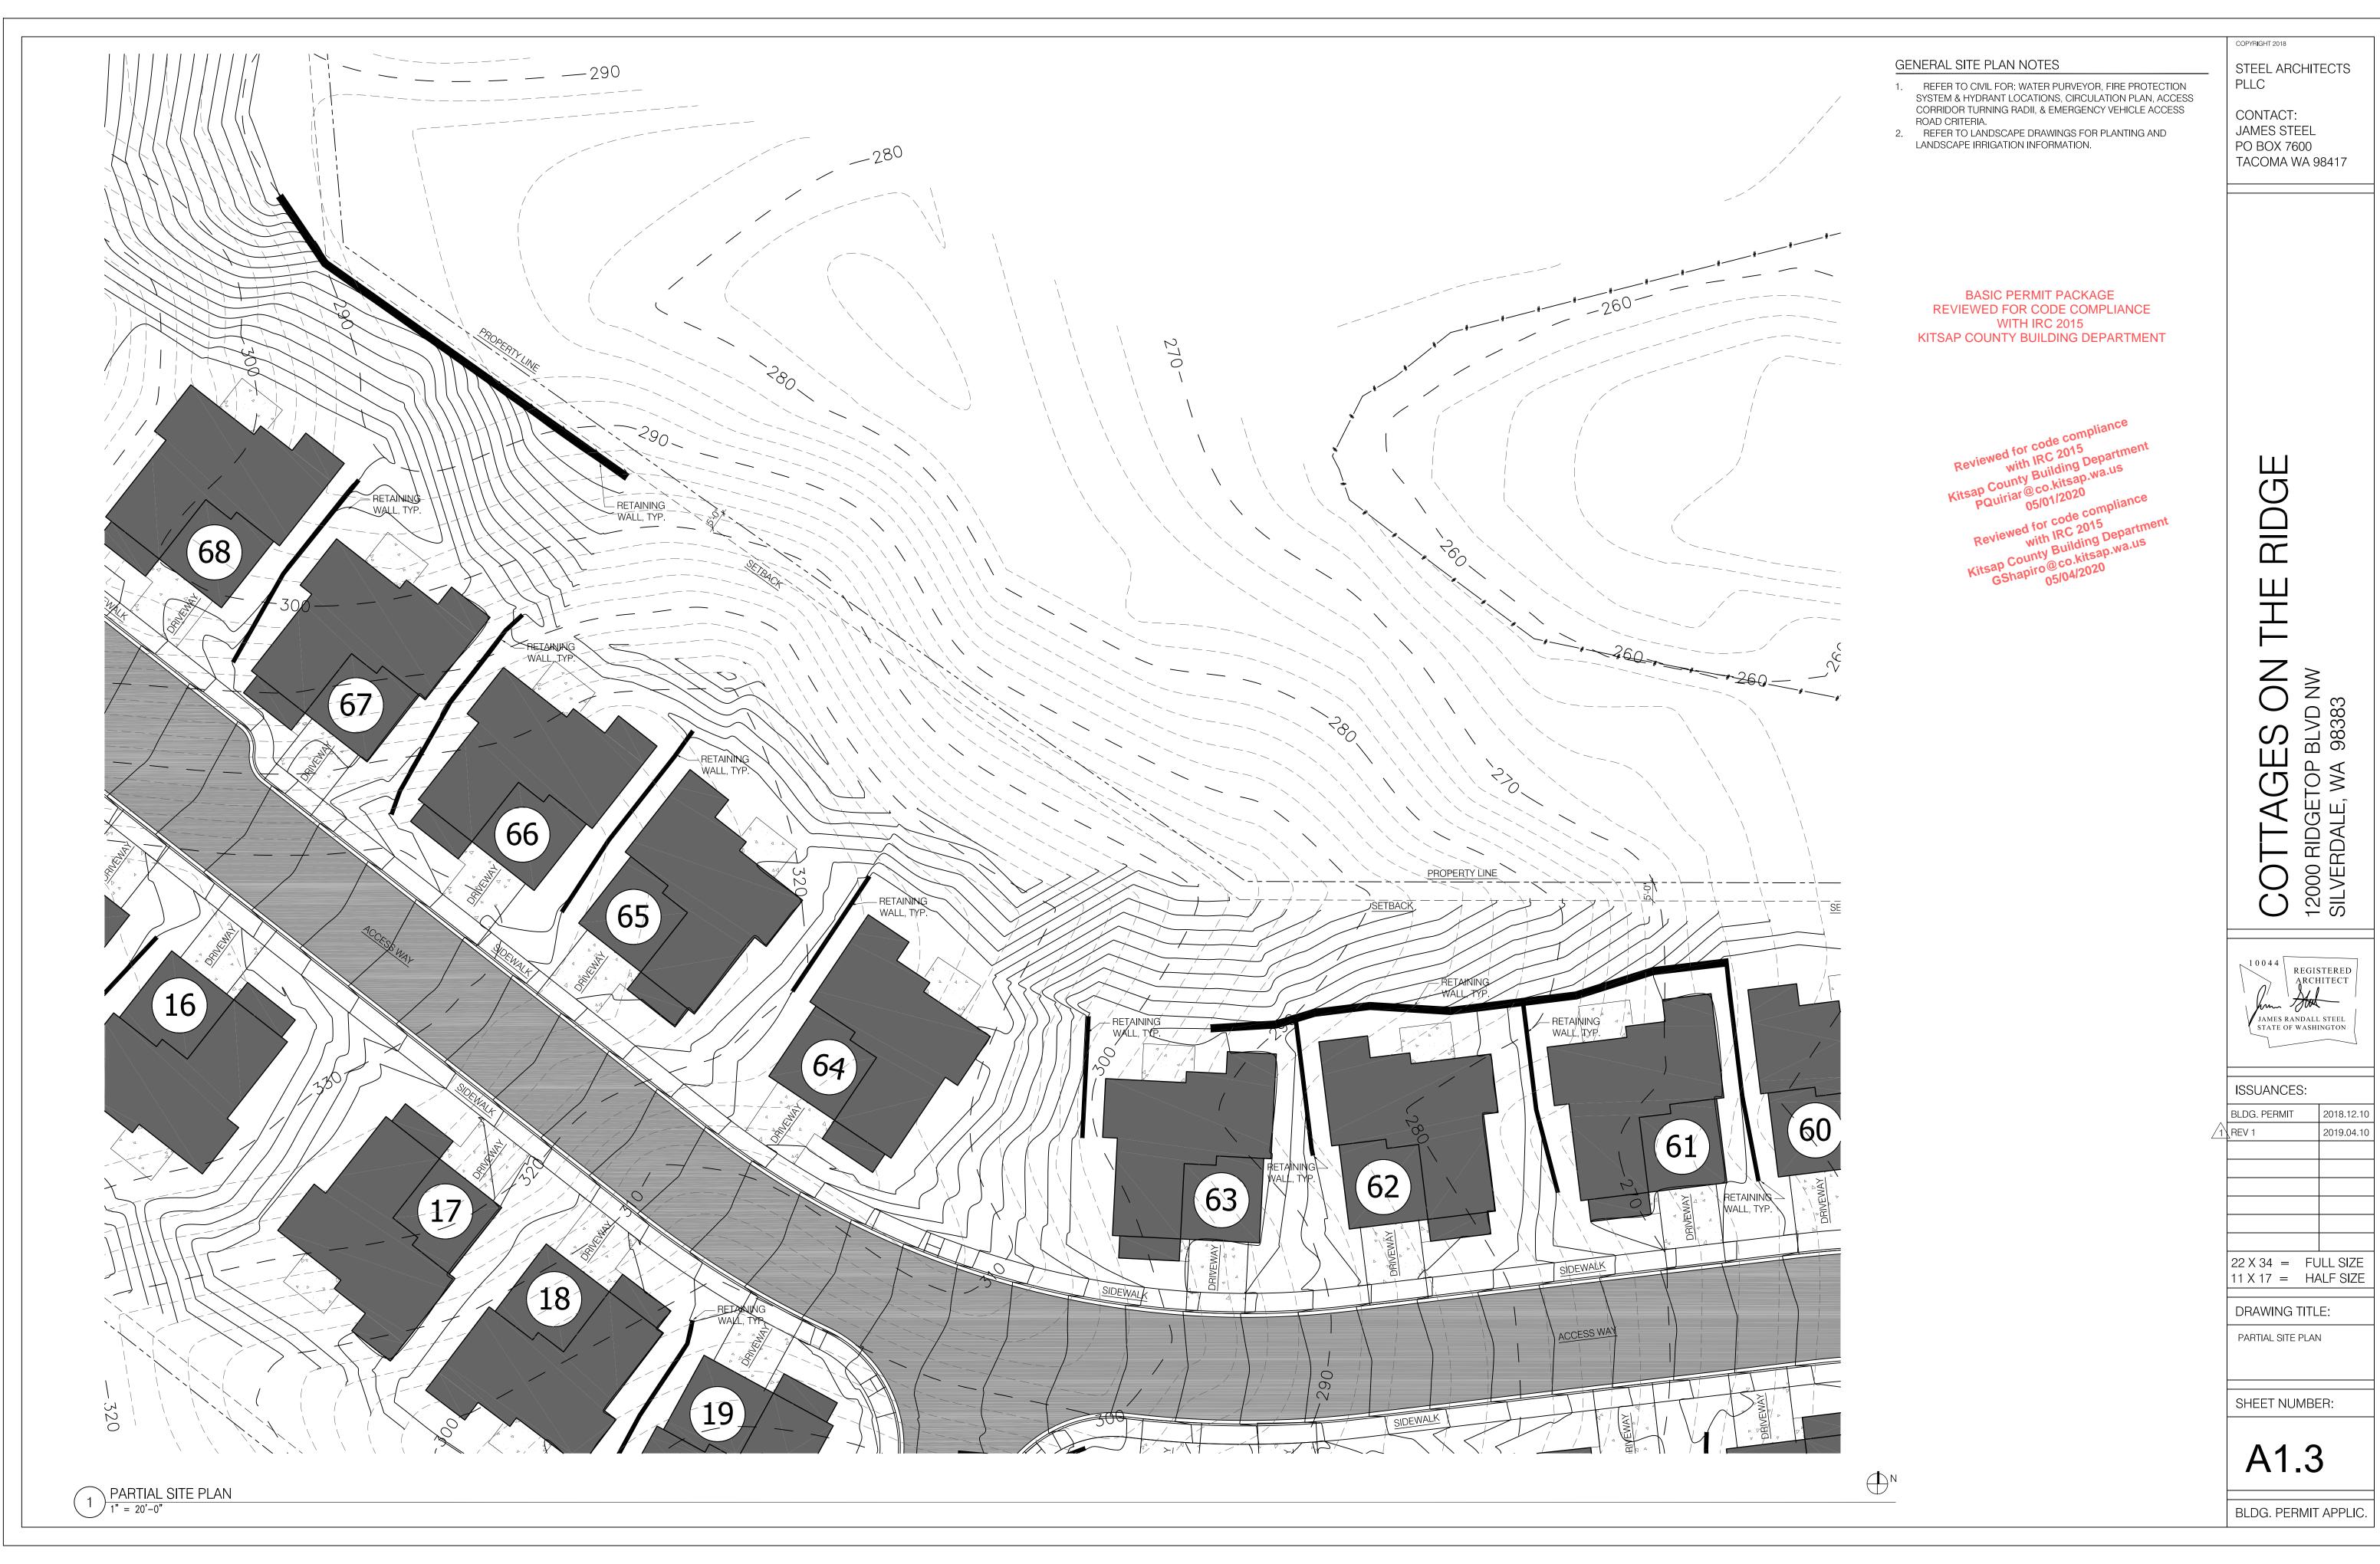



2018.12.10 2019.04.10



2018.12.10 2019.04.10











2018.12.10 2019.04.10




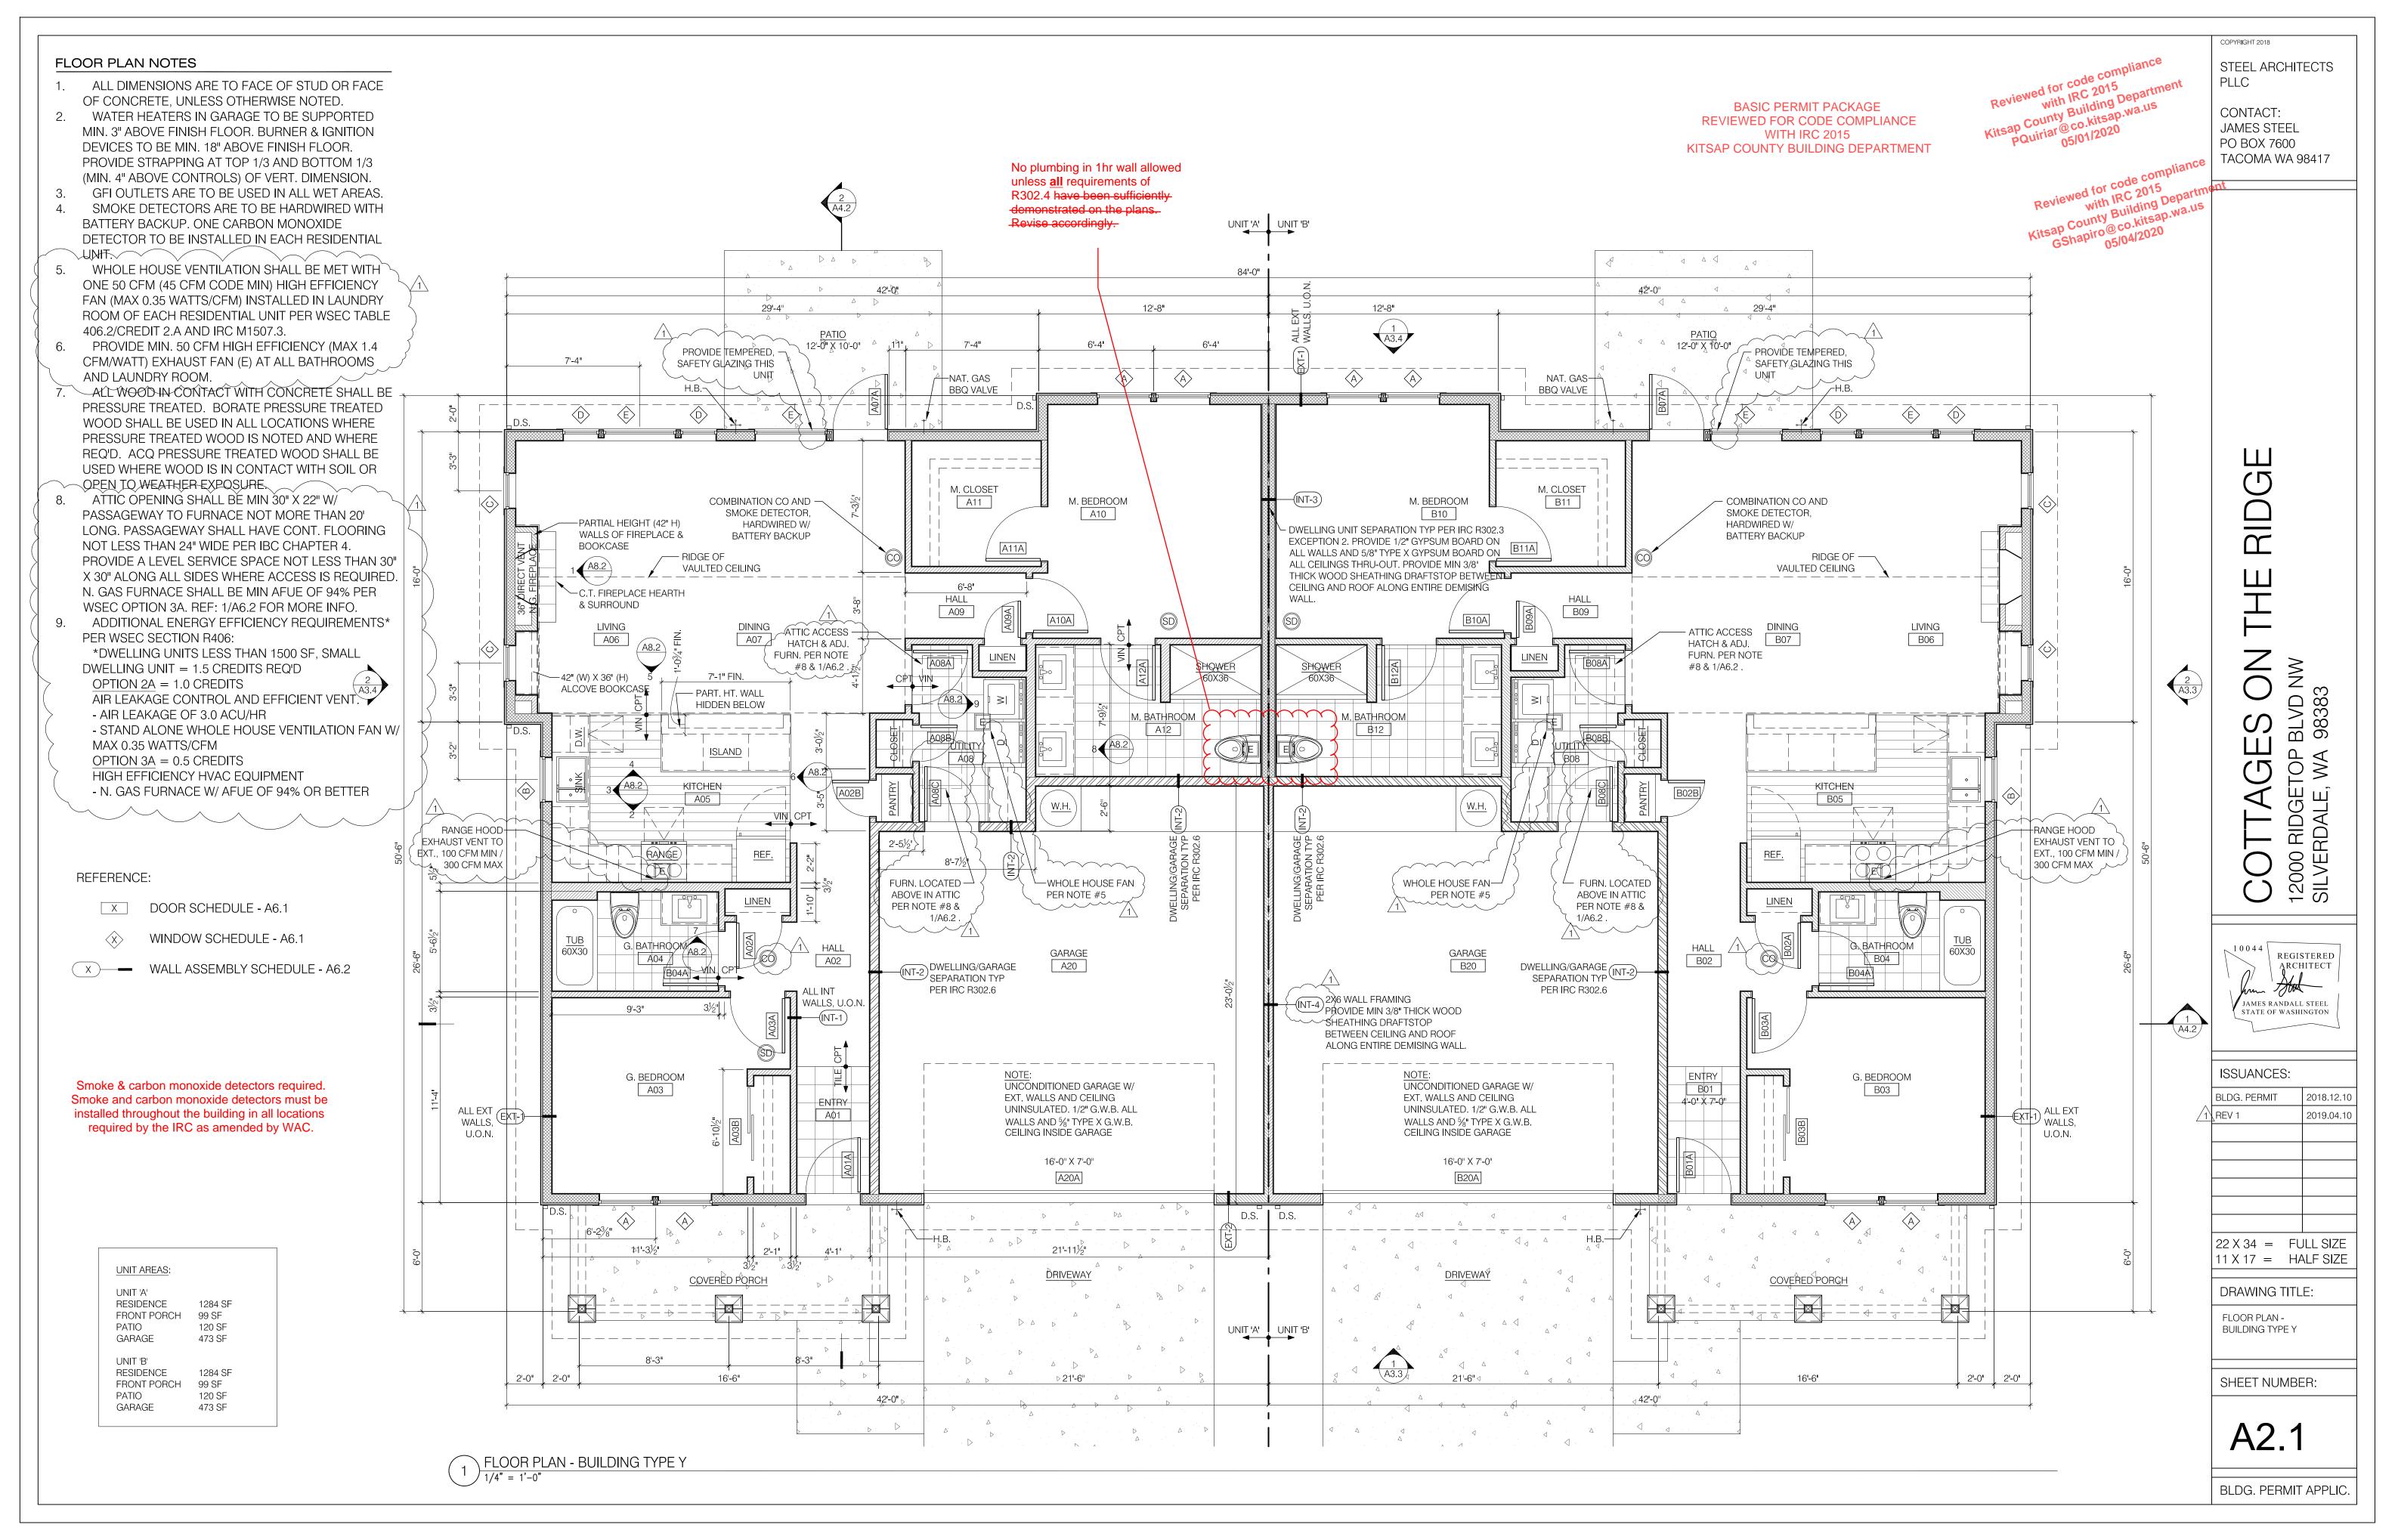


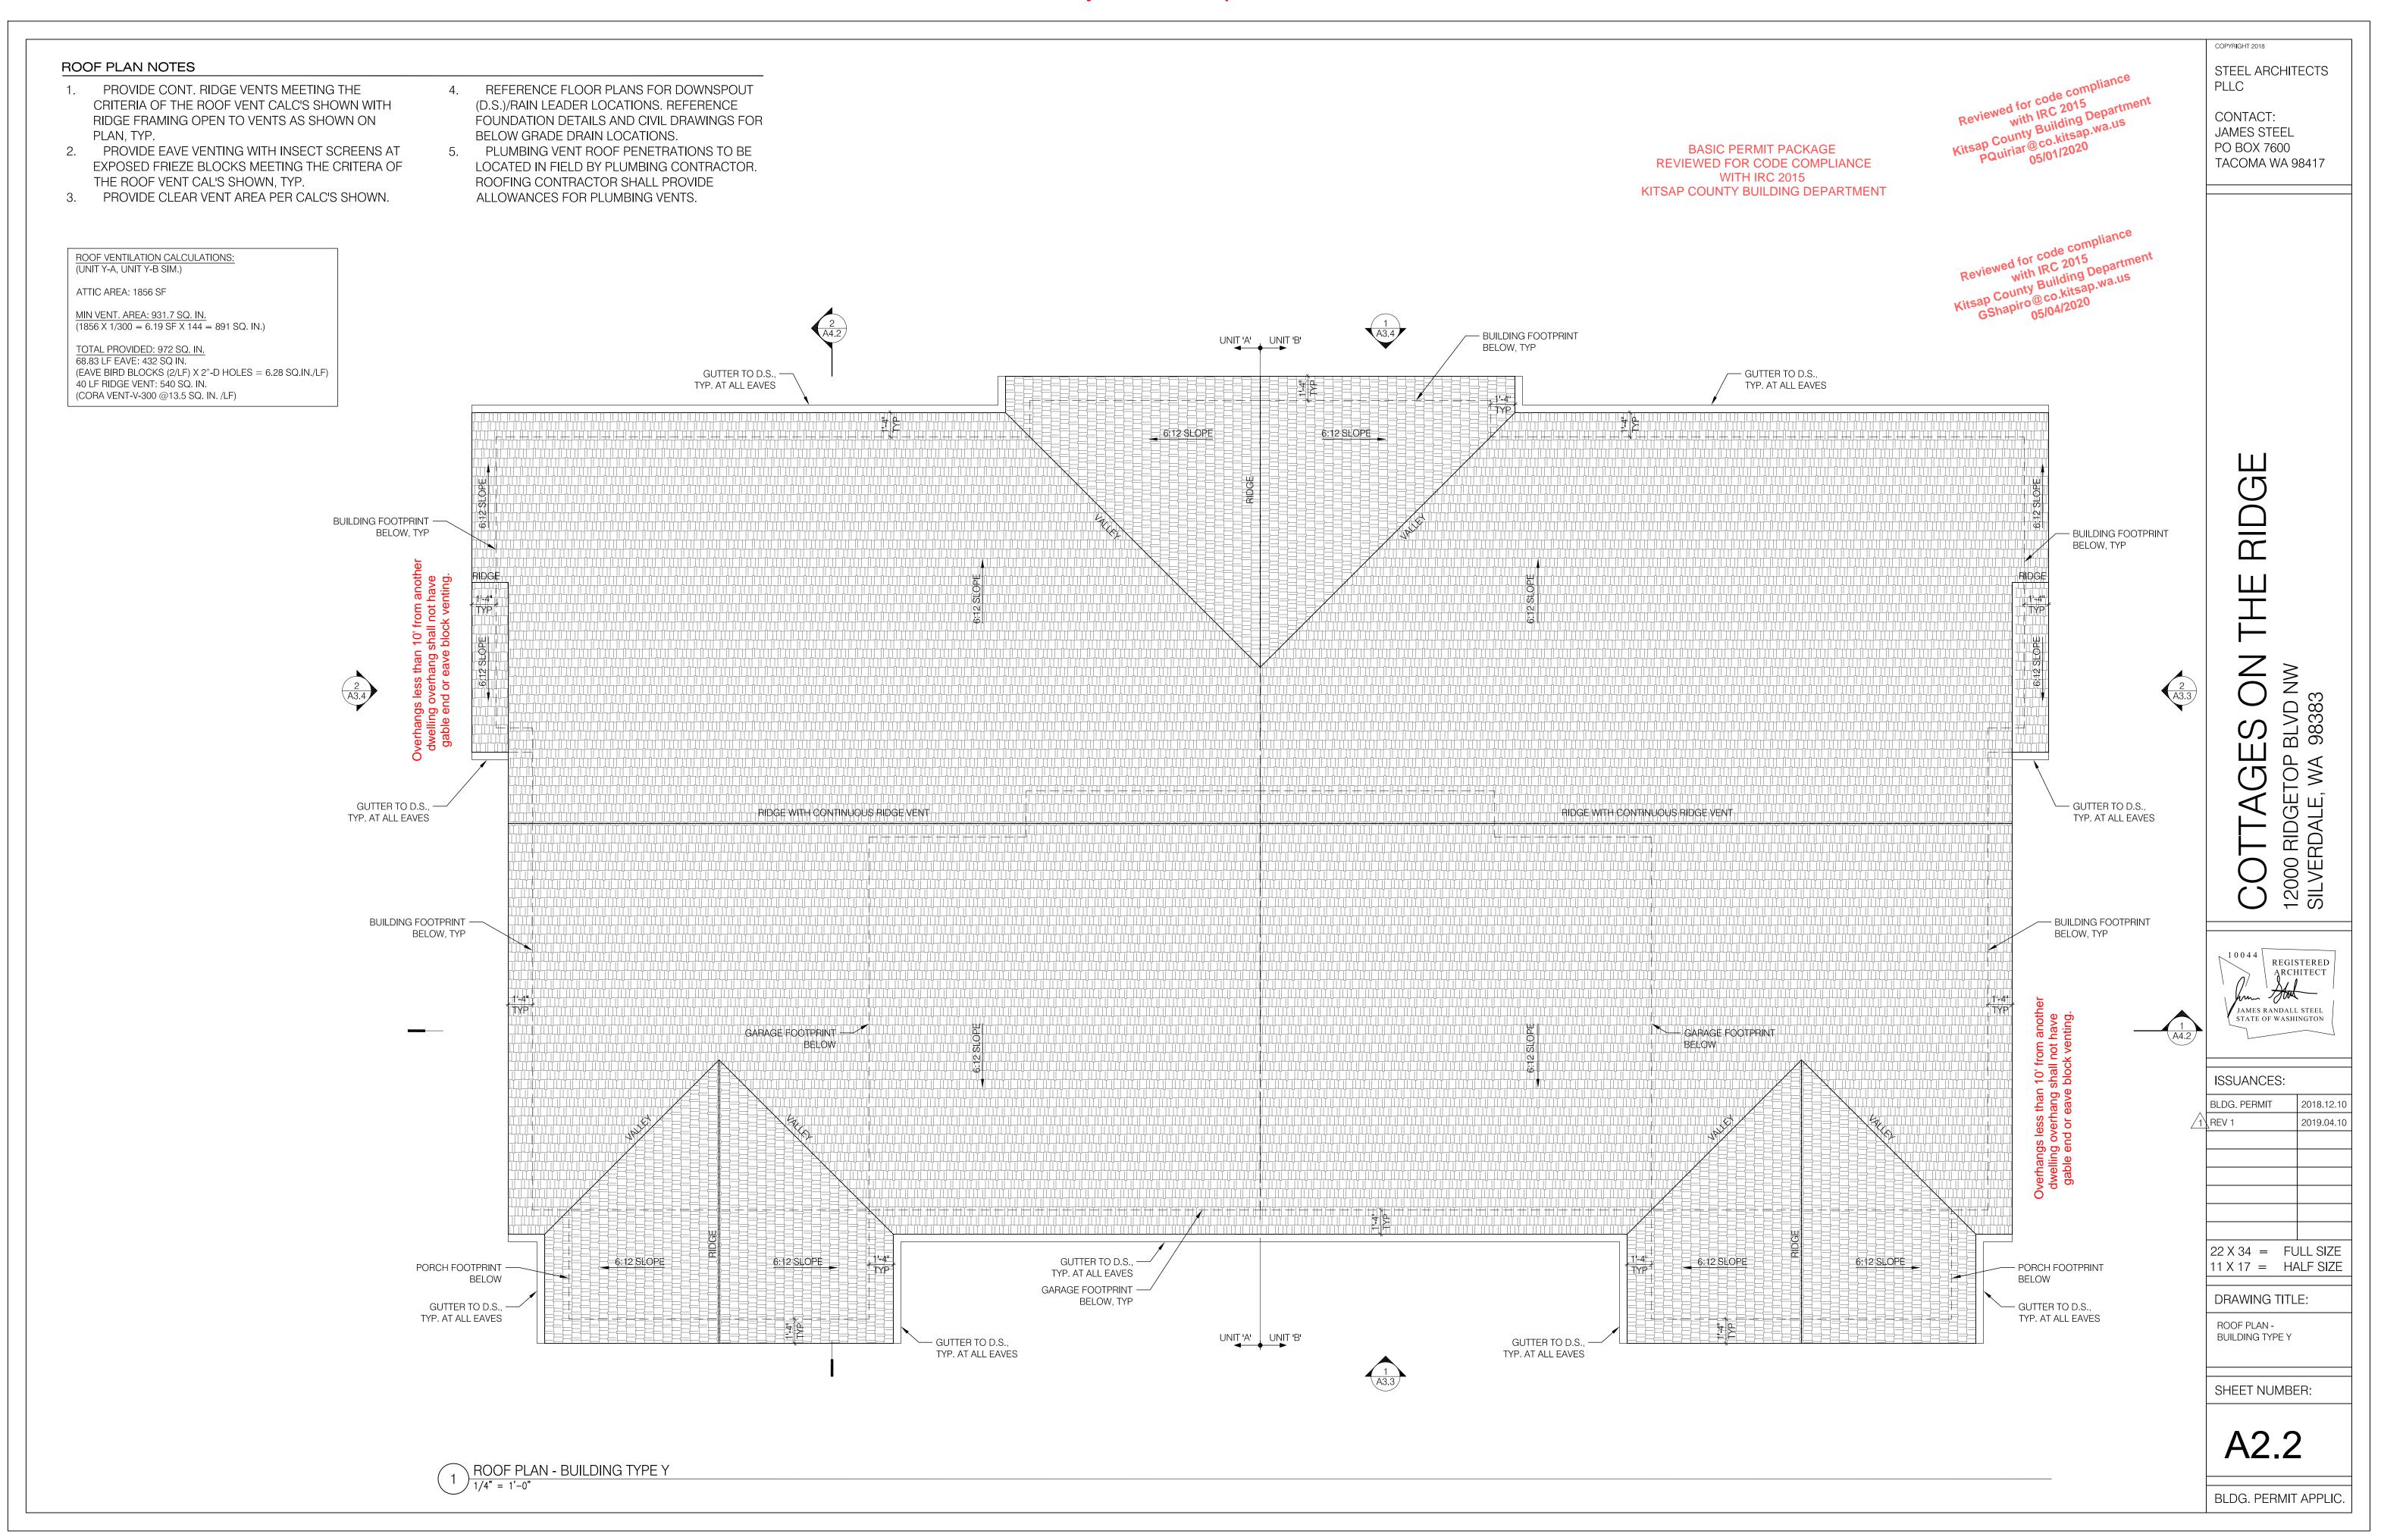


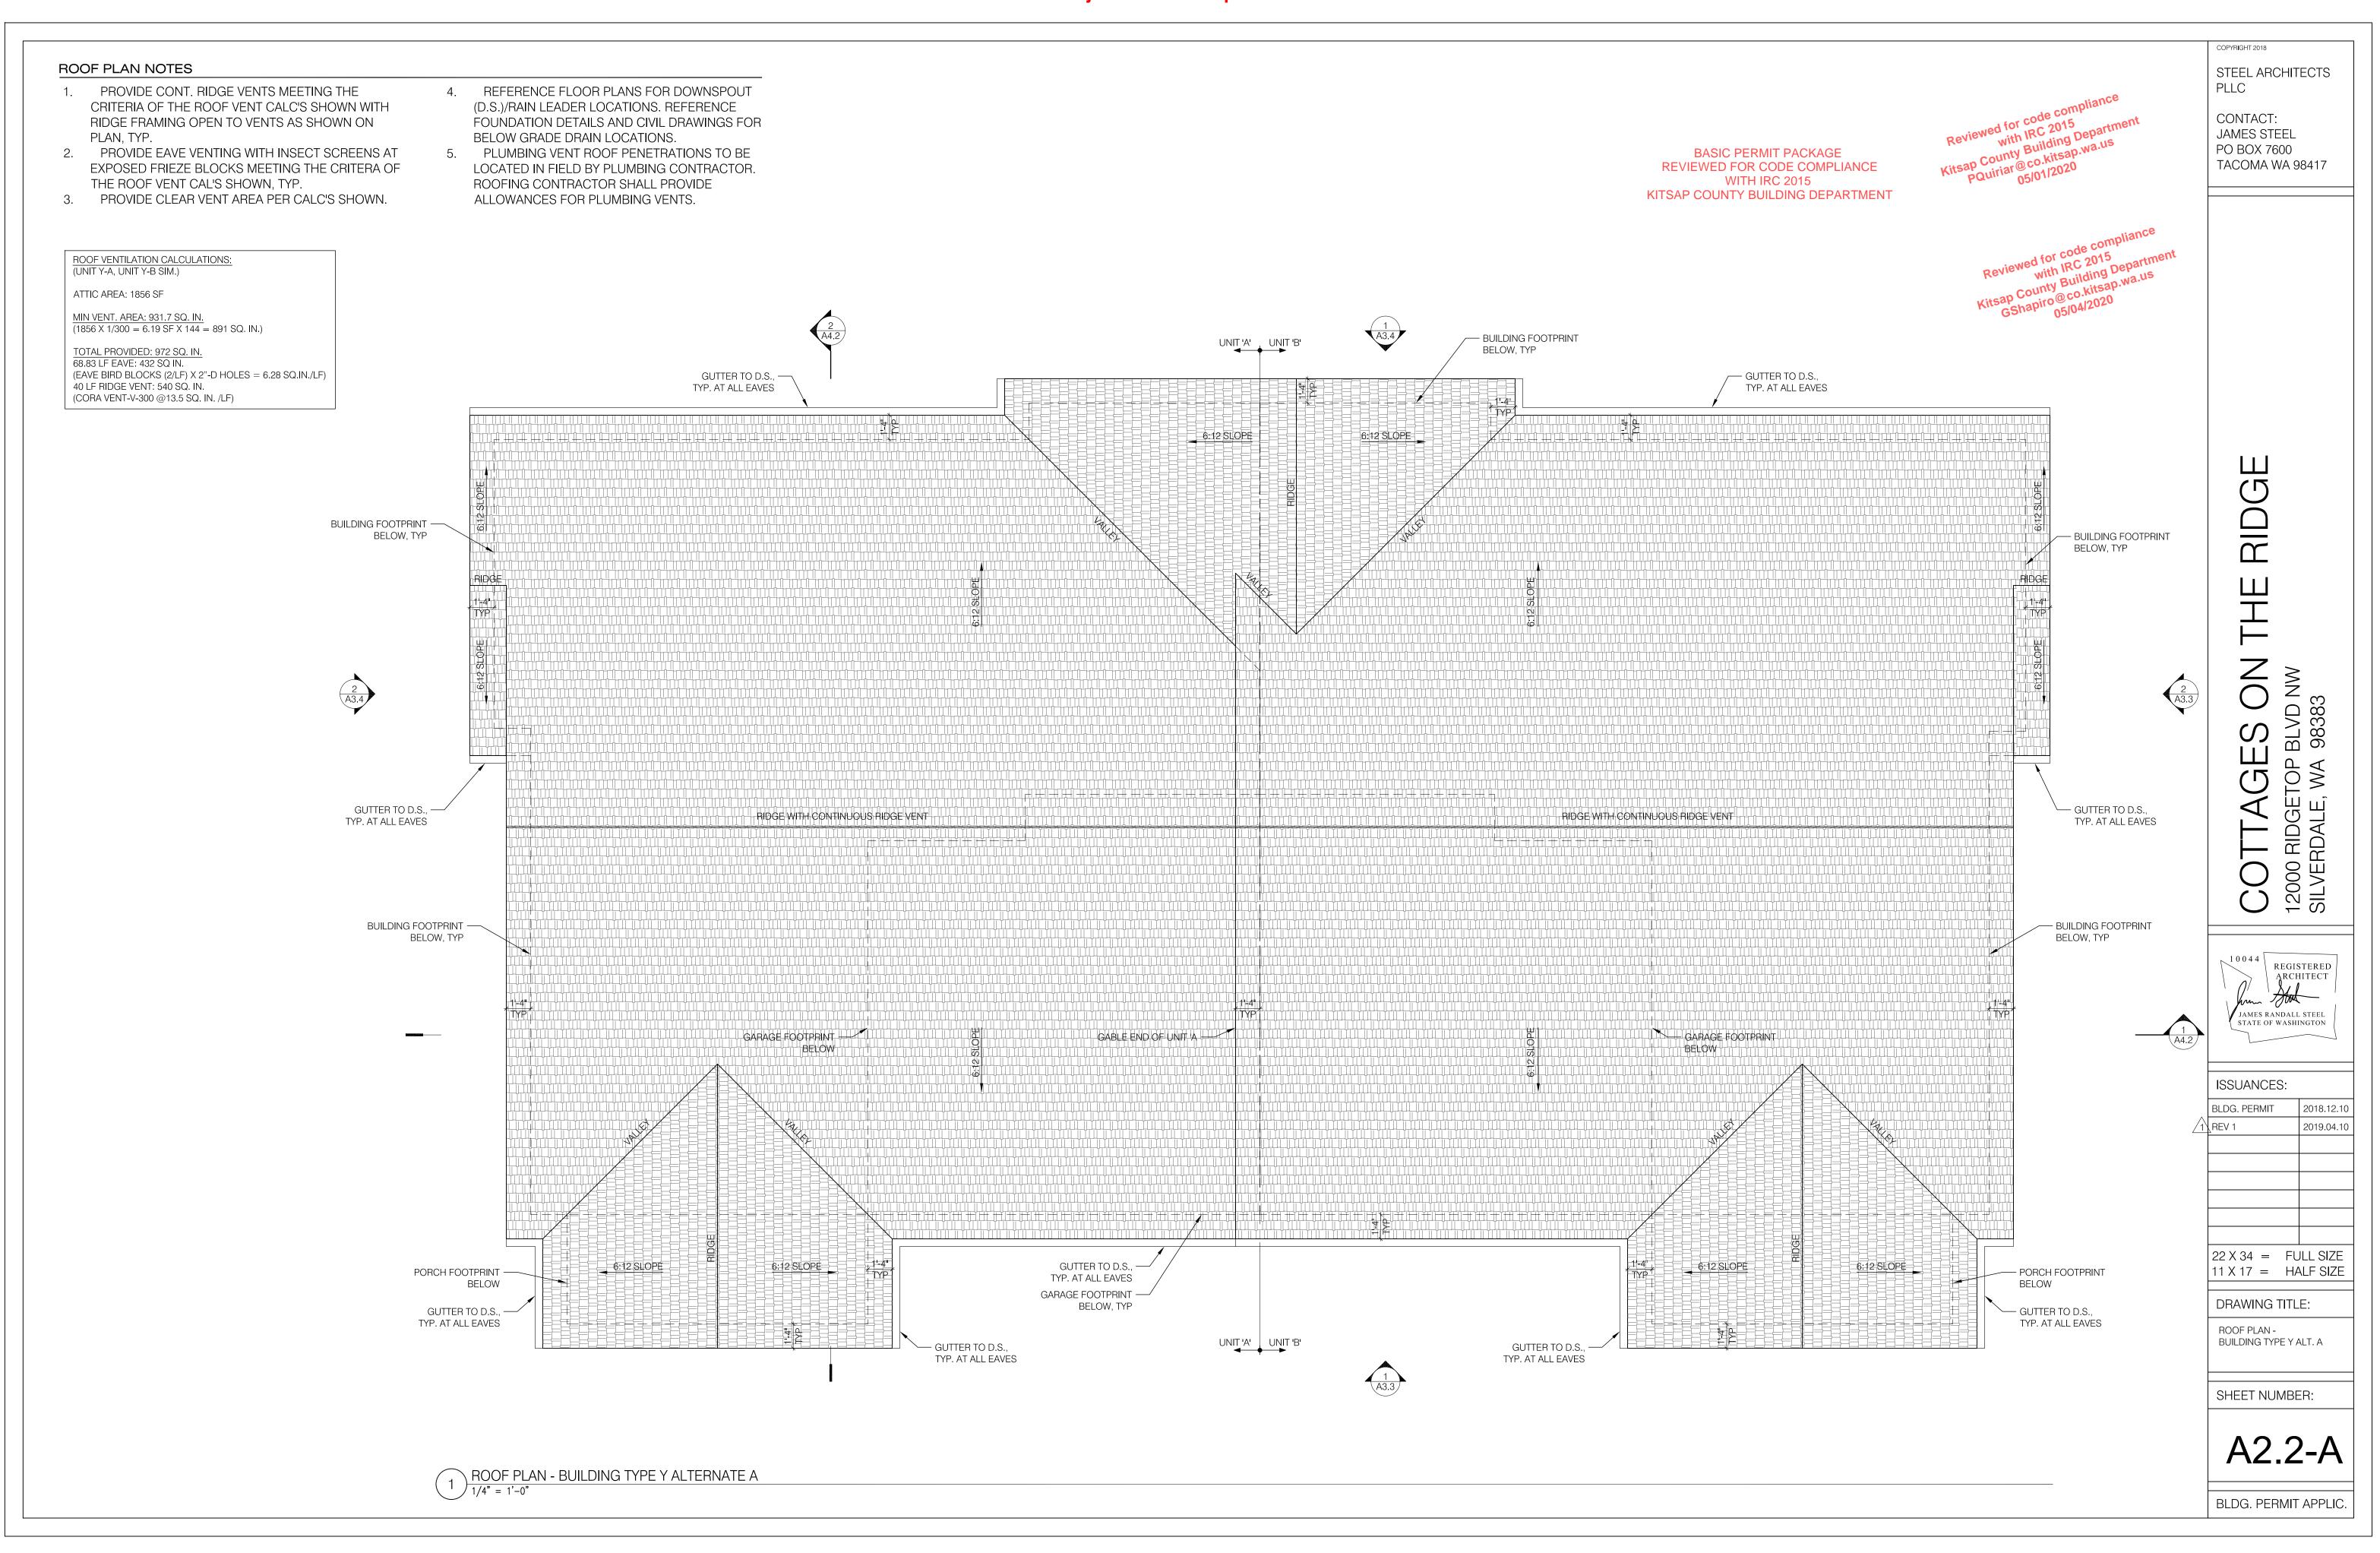

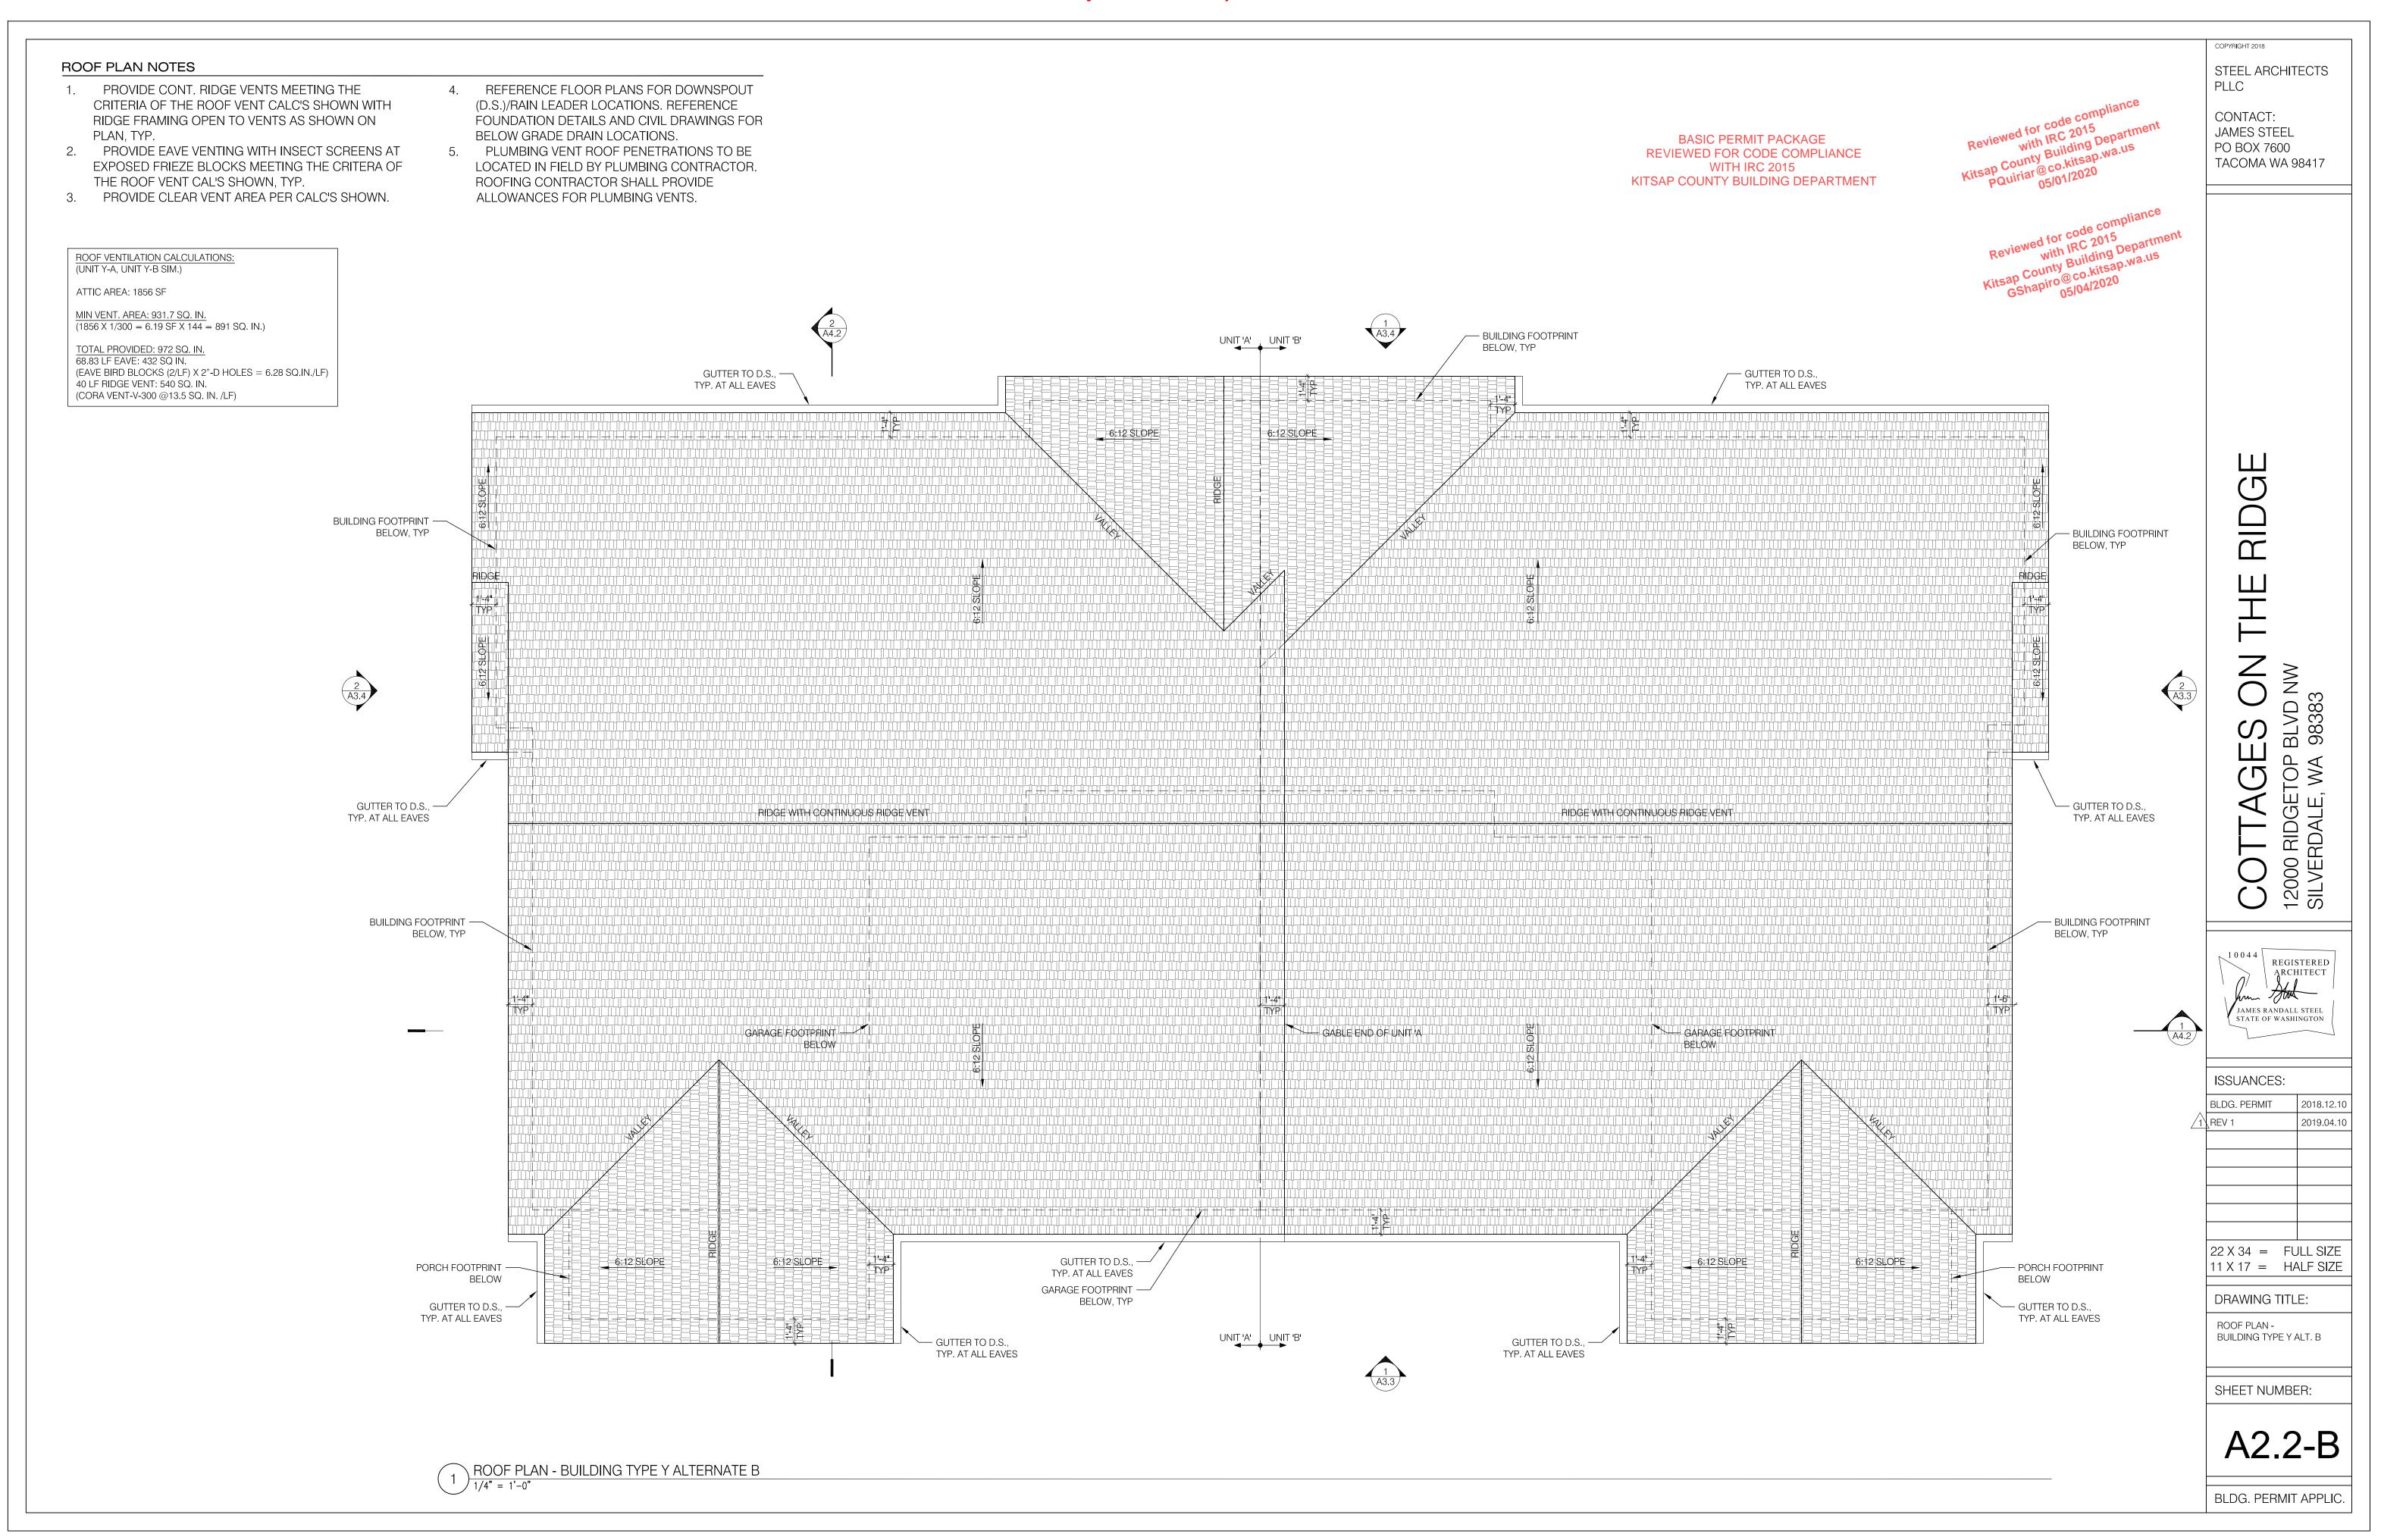


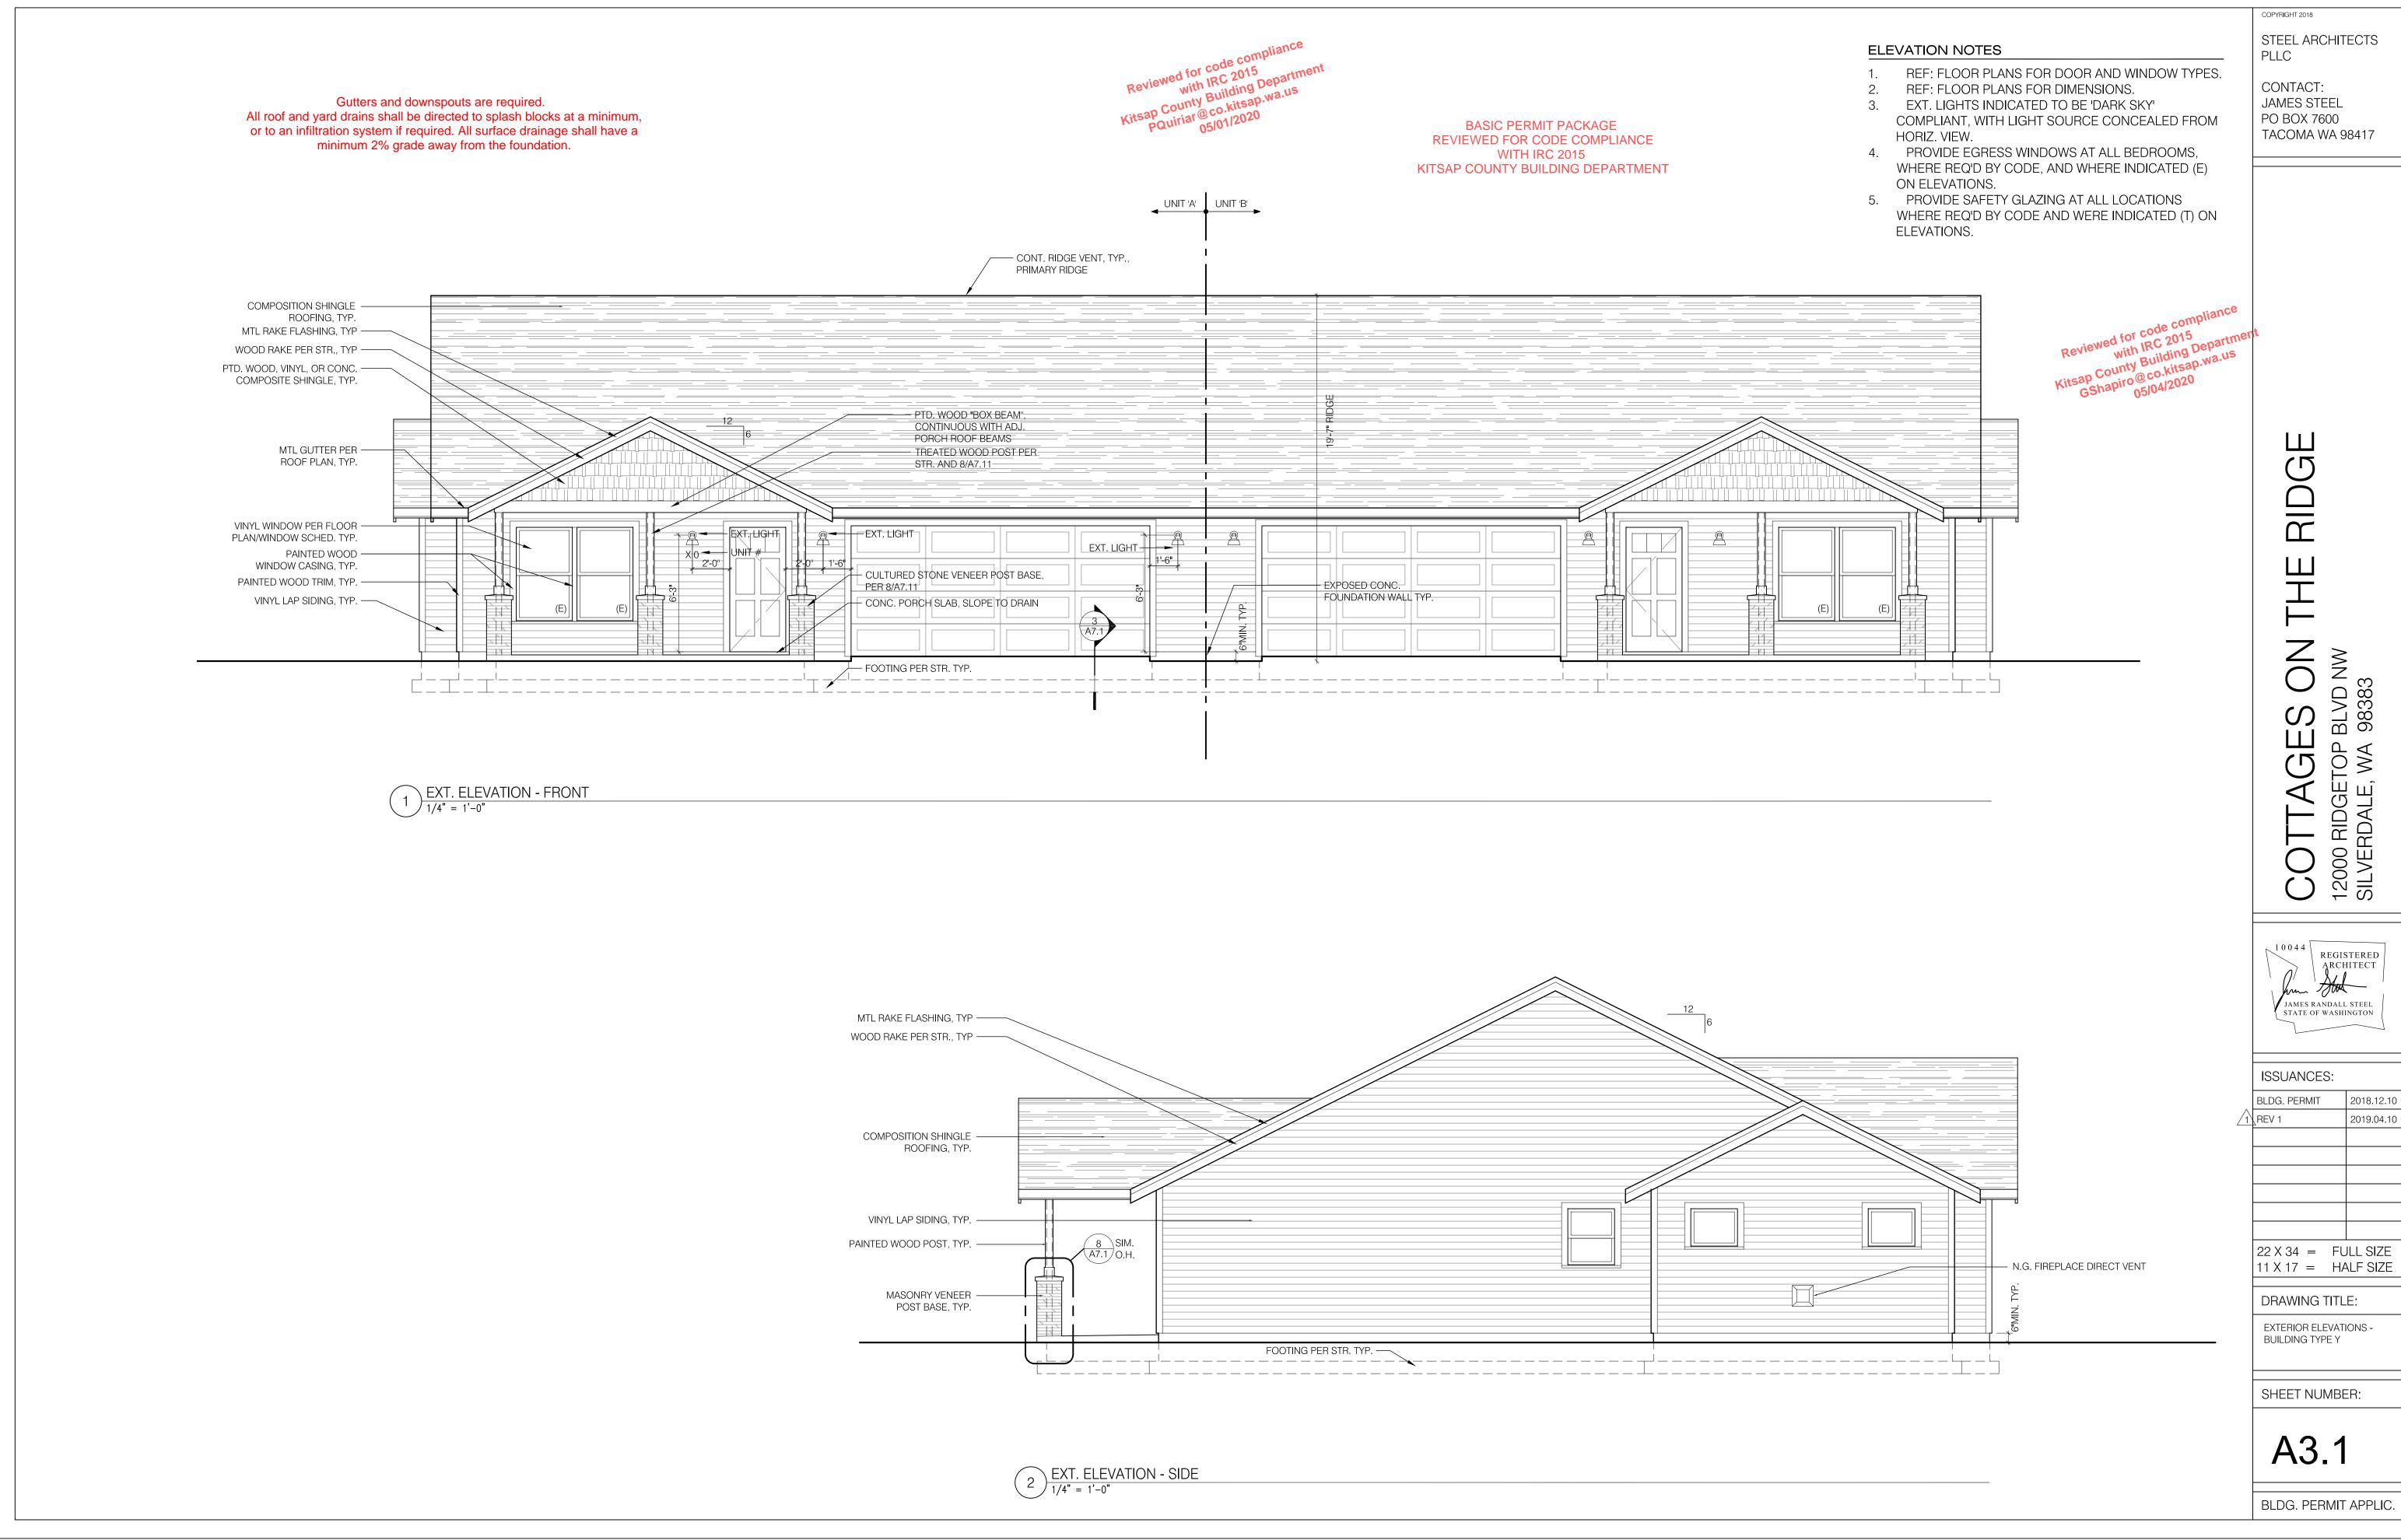


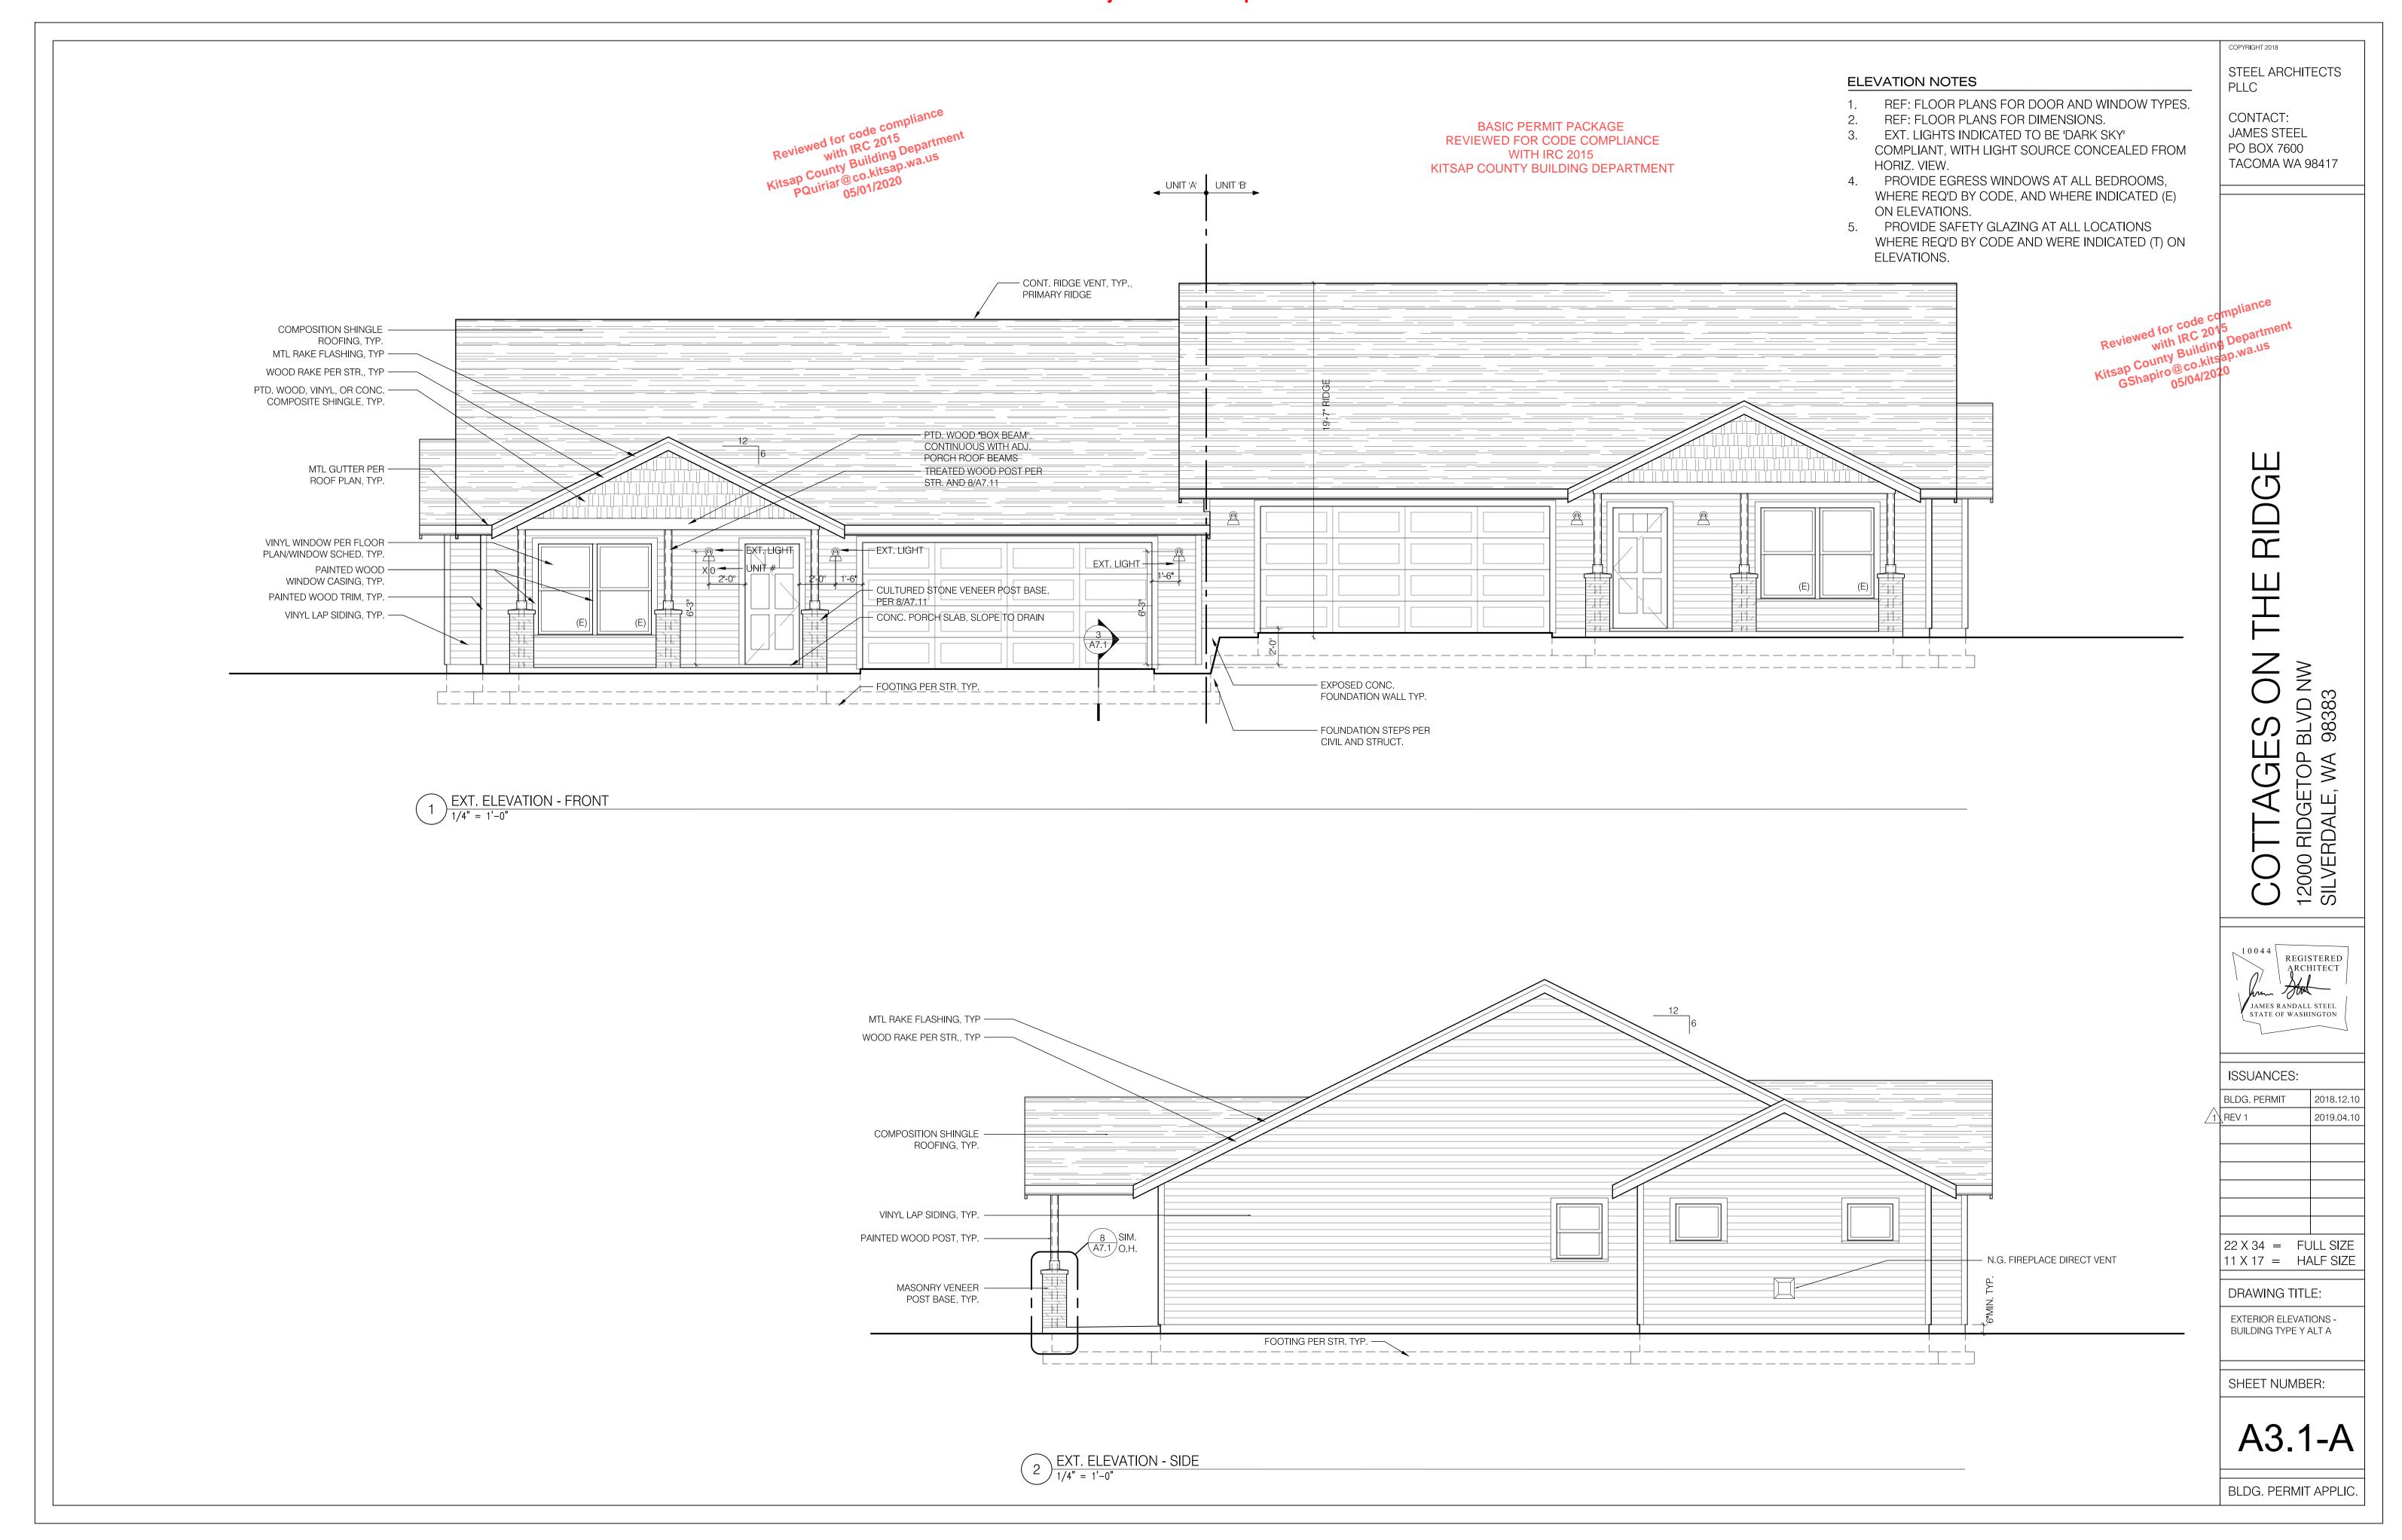


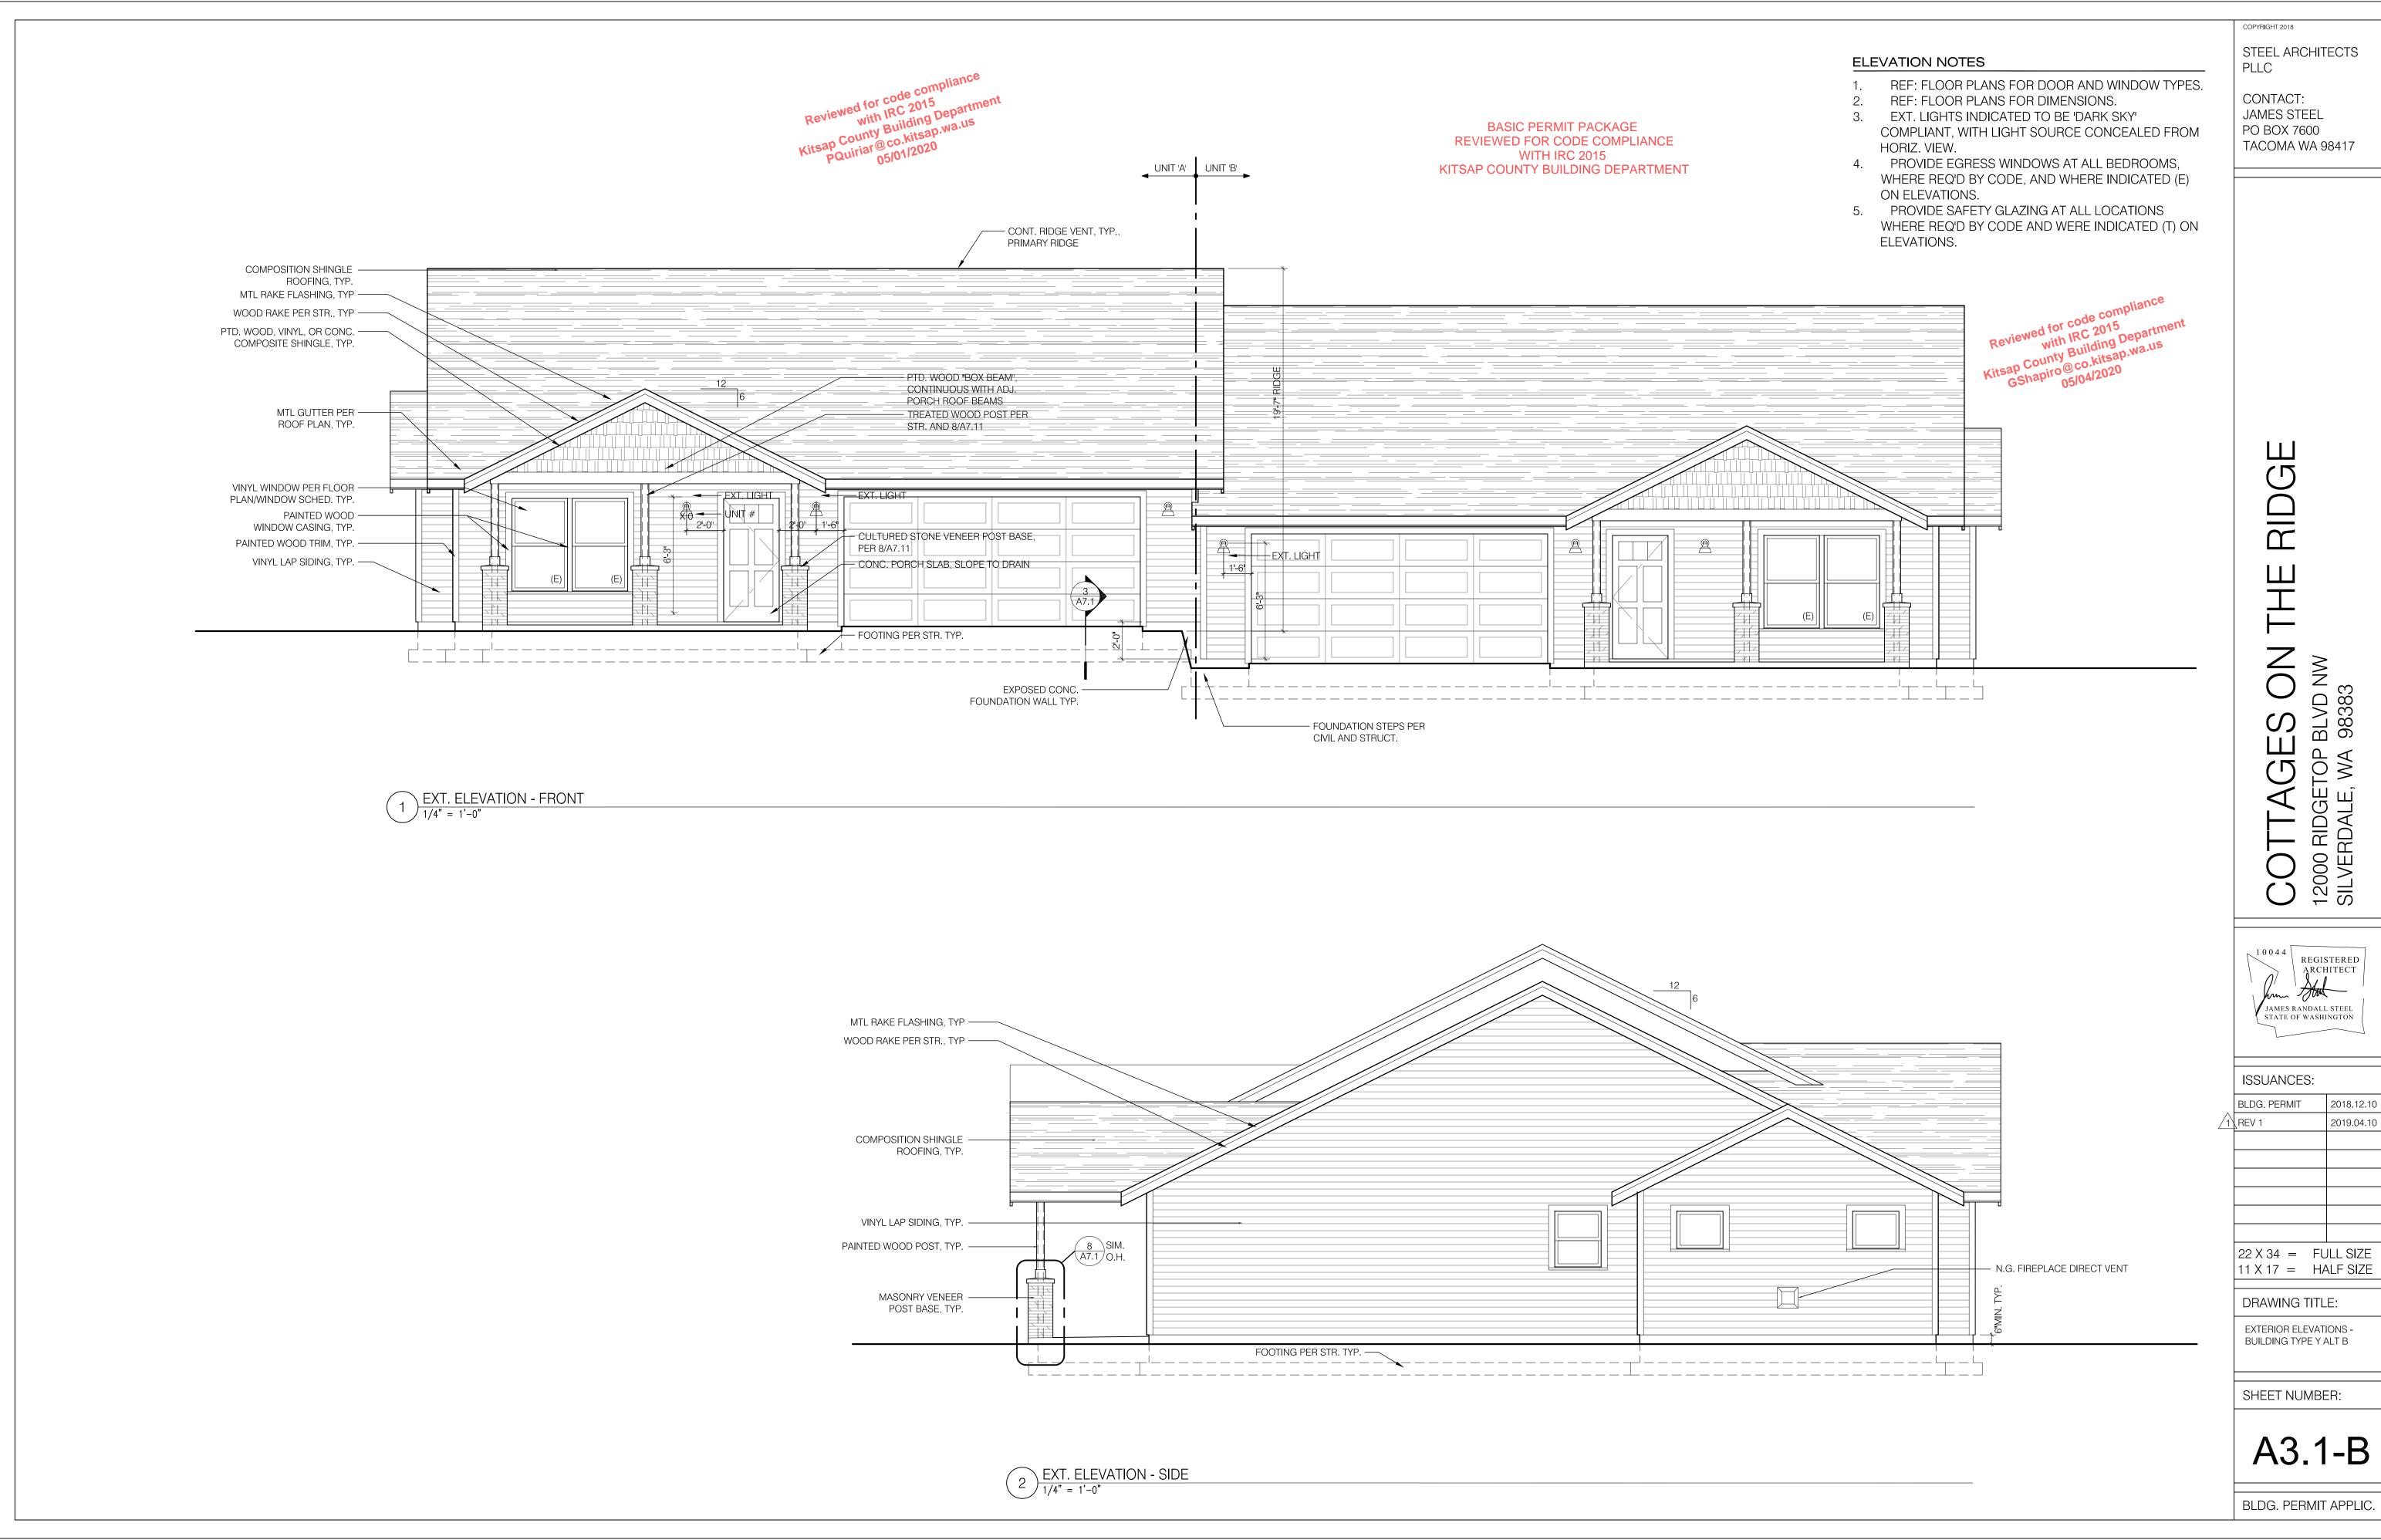



Permit Number: 20-01252

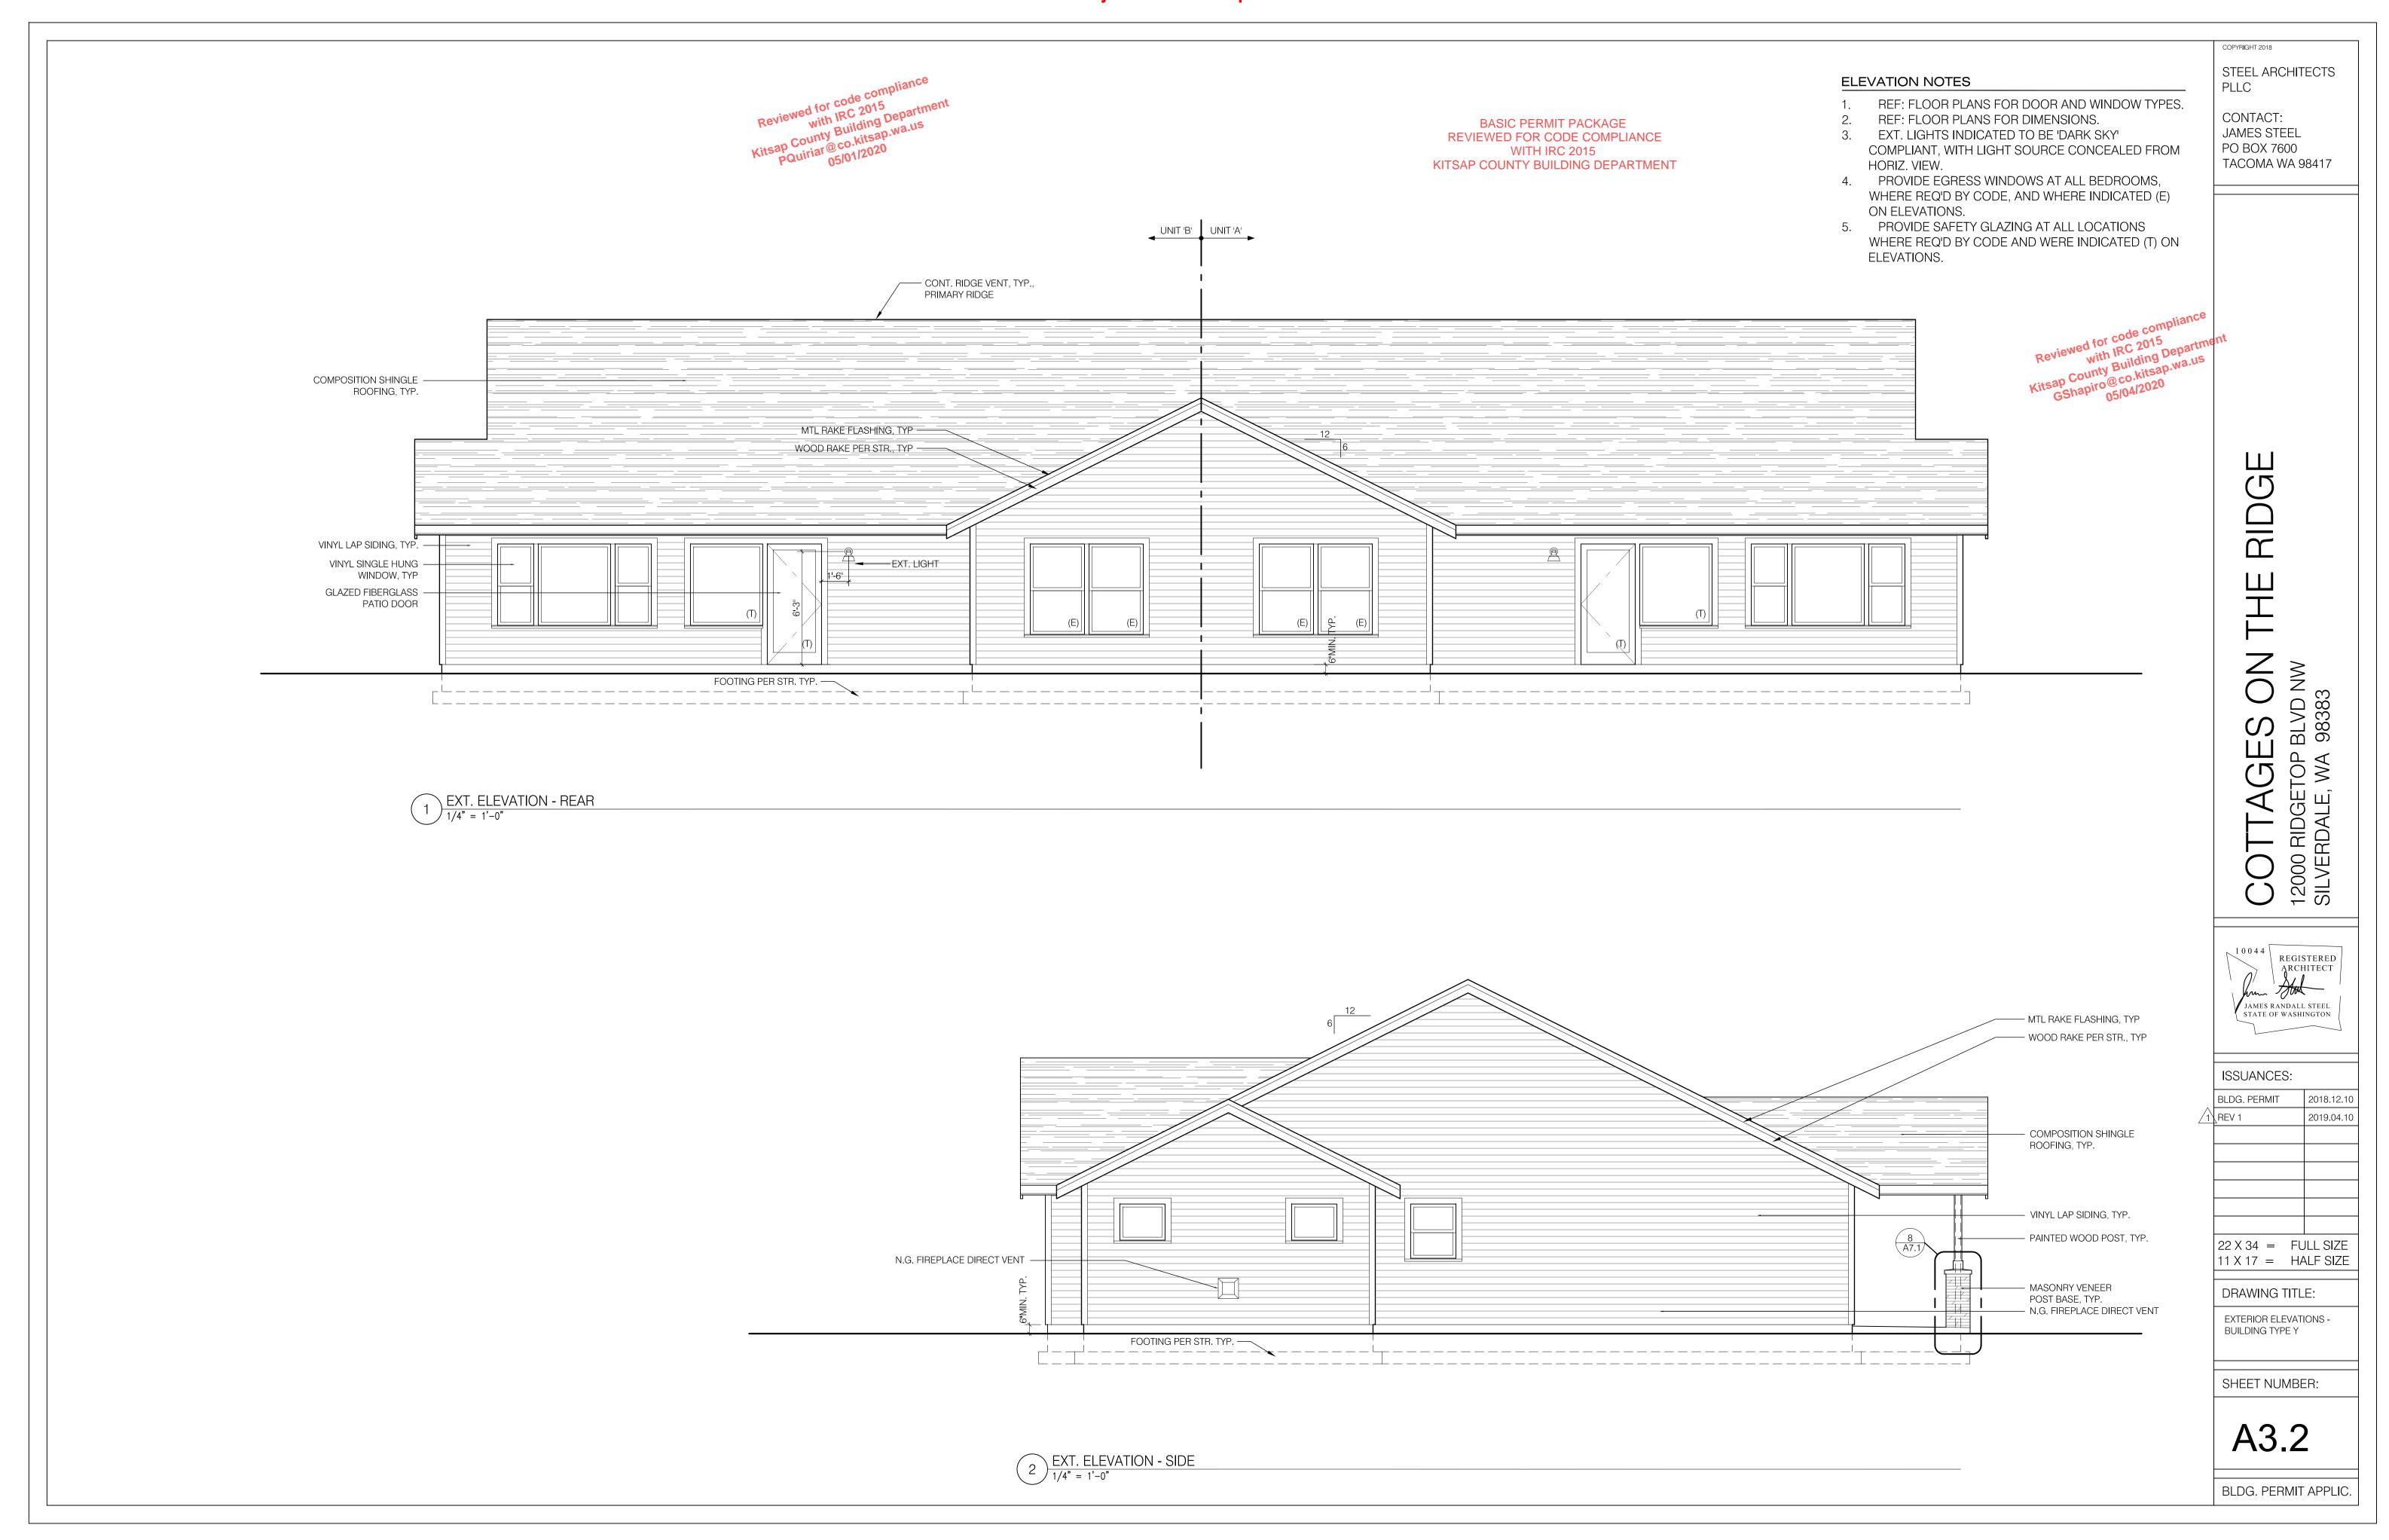


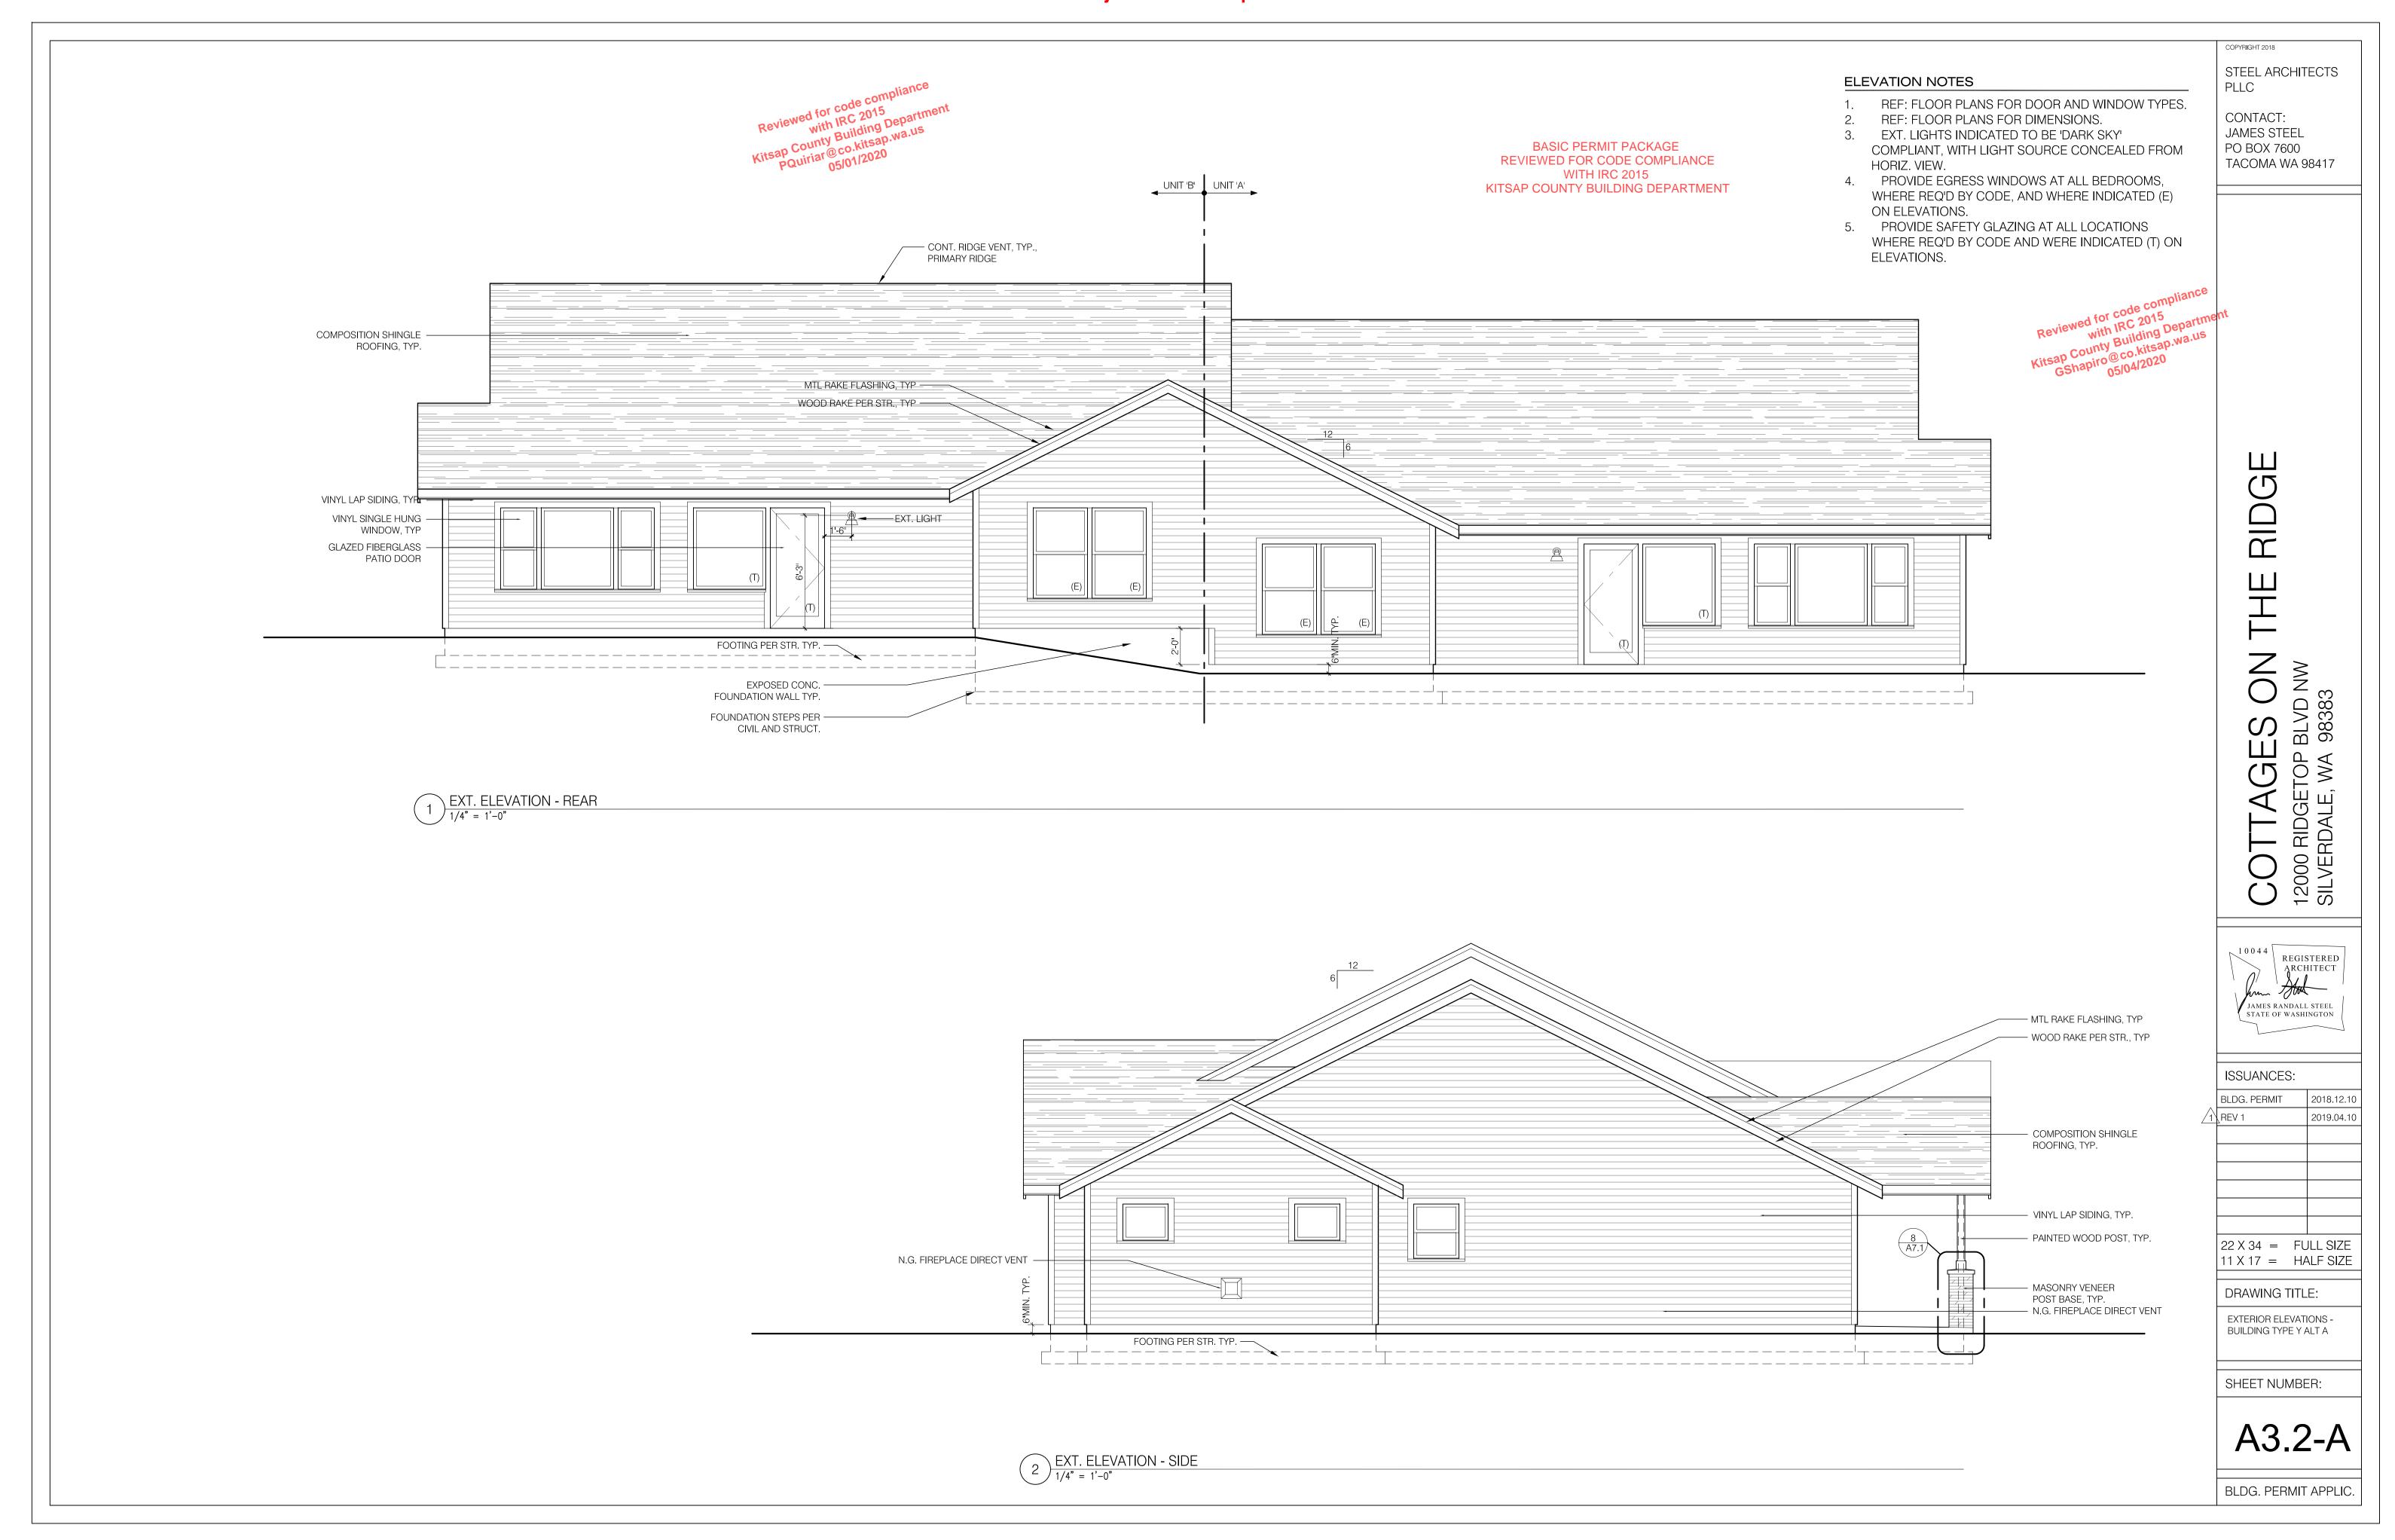

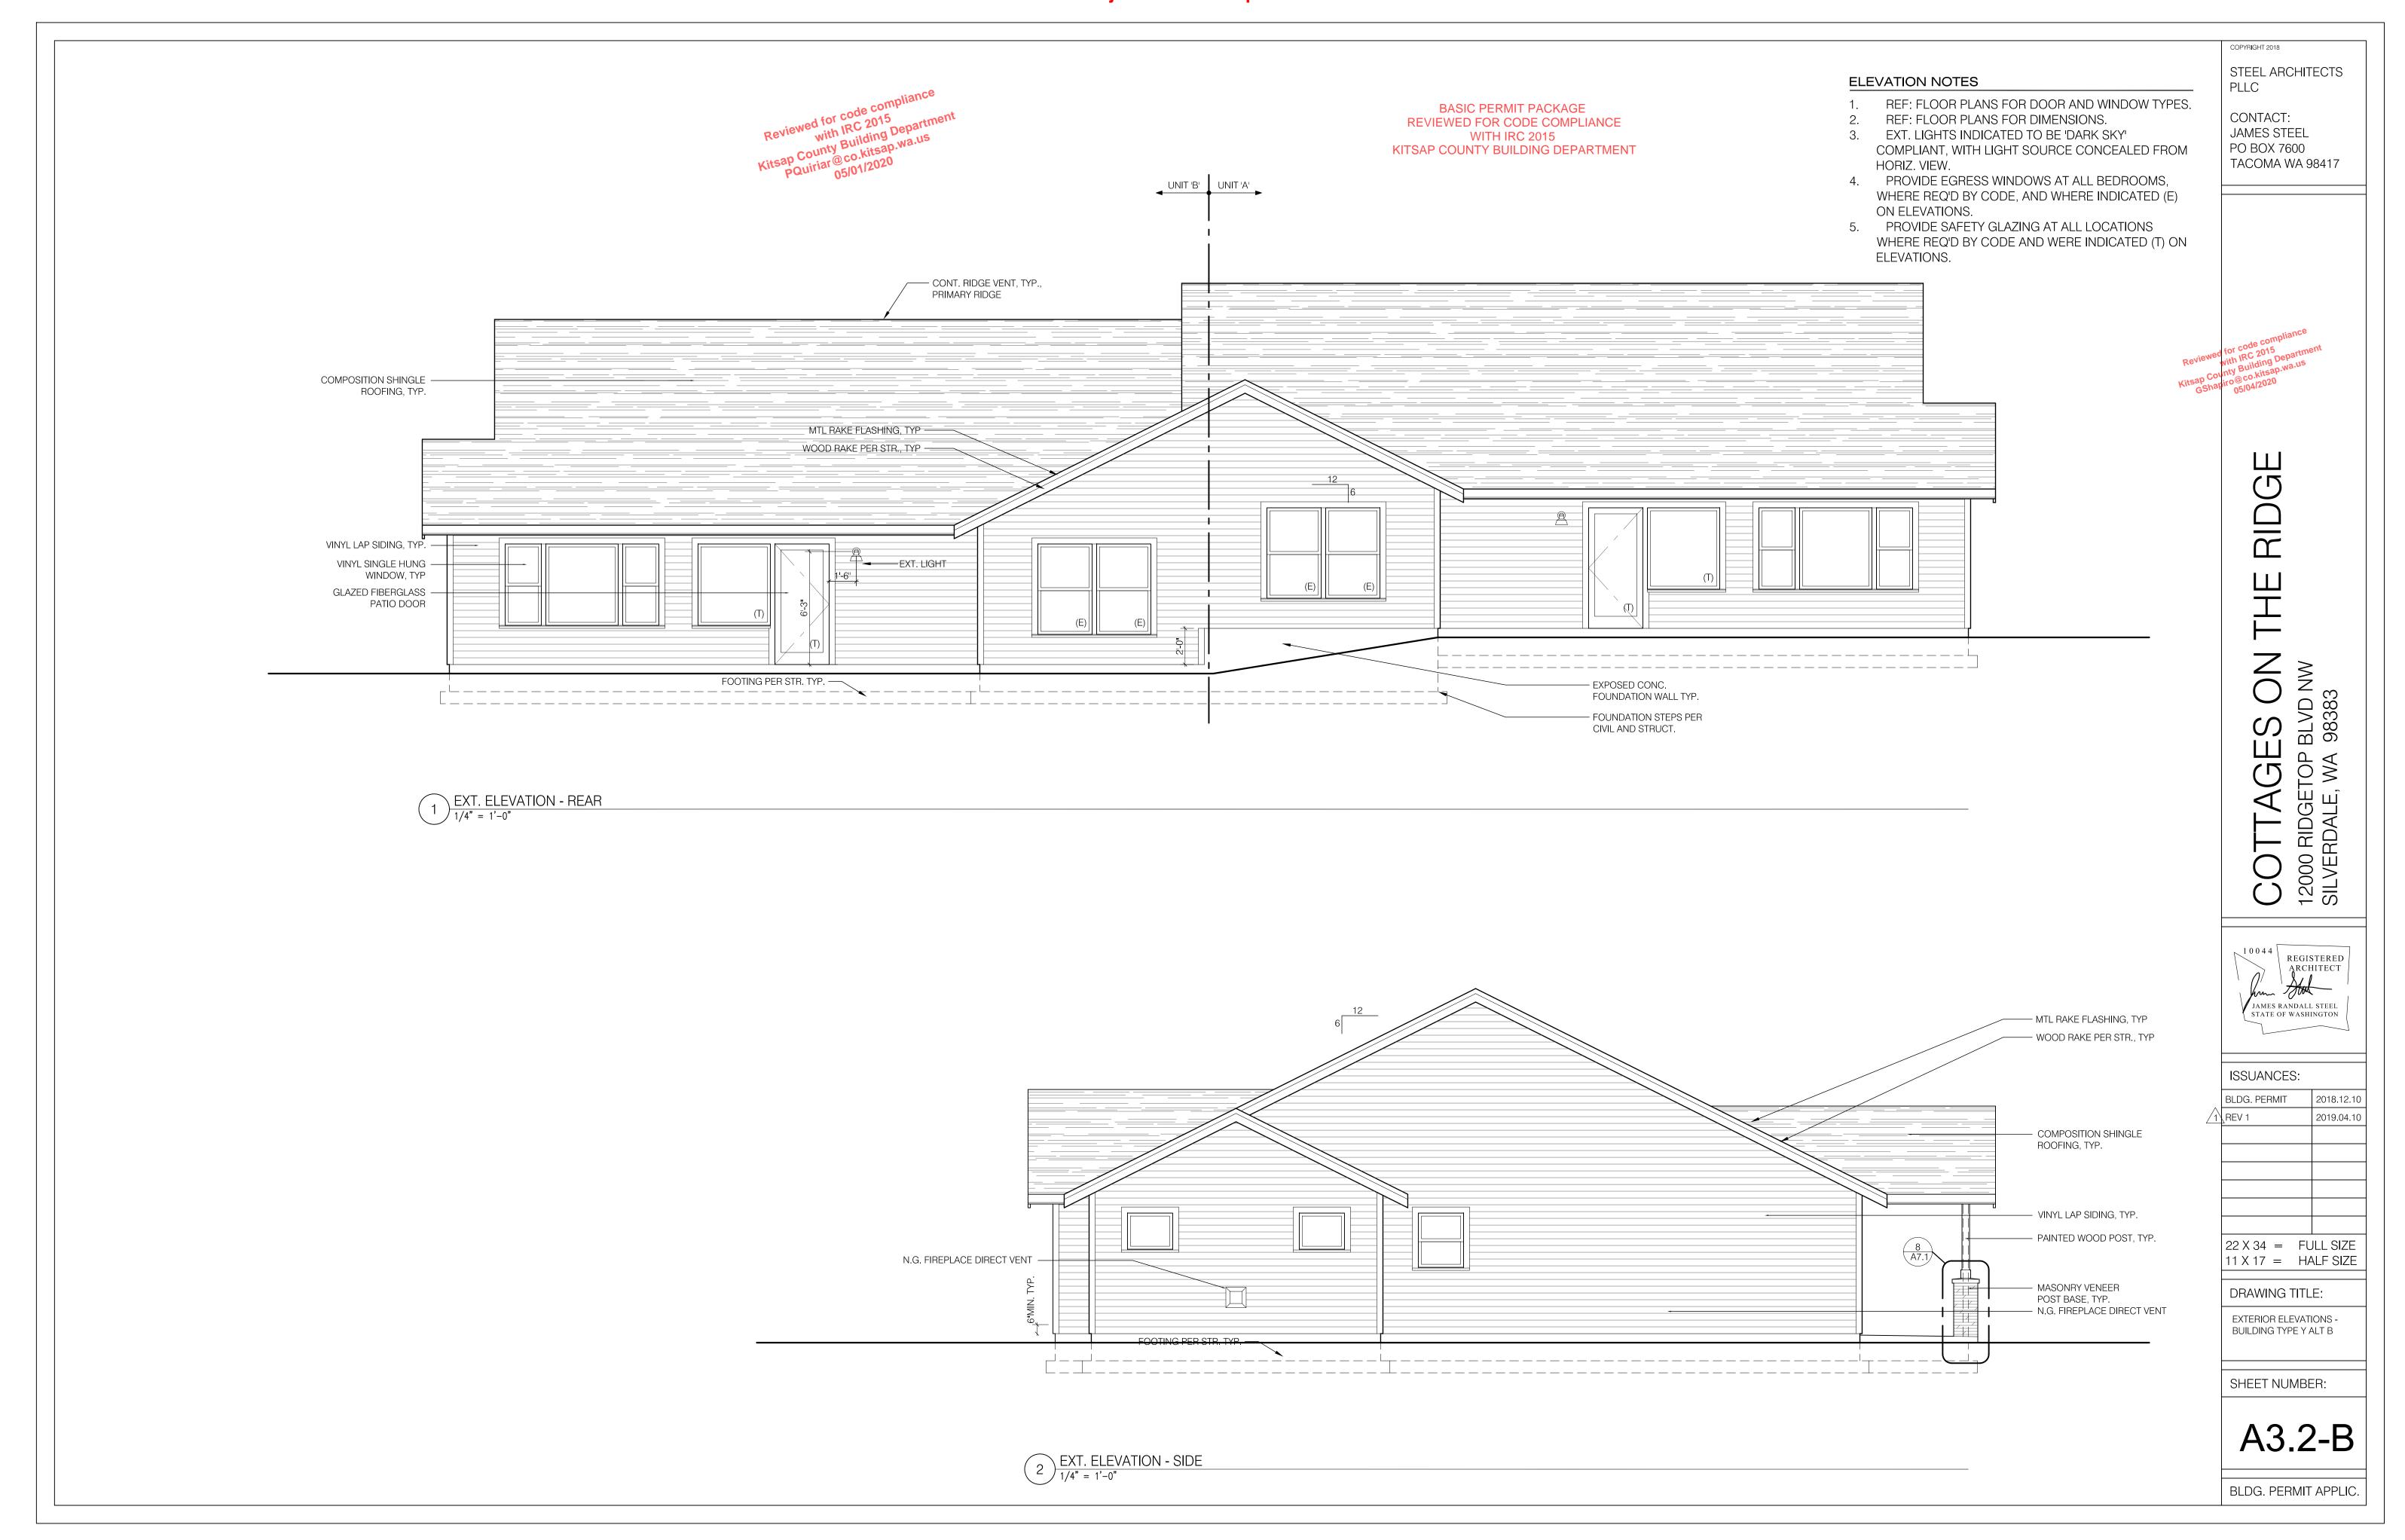

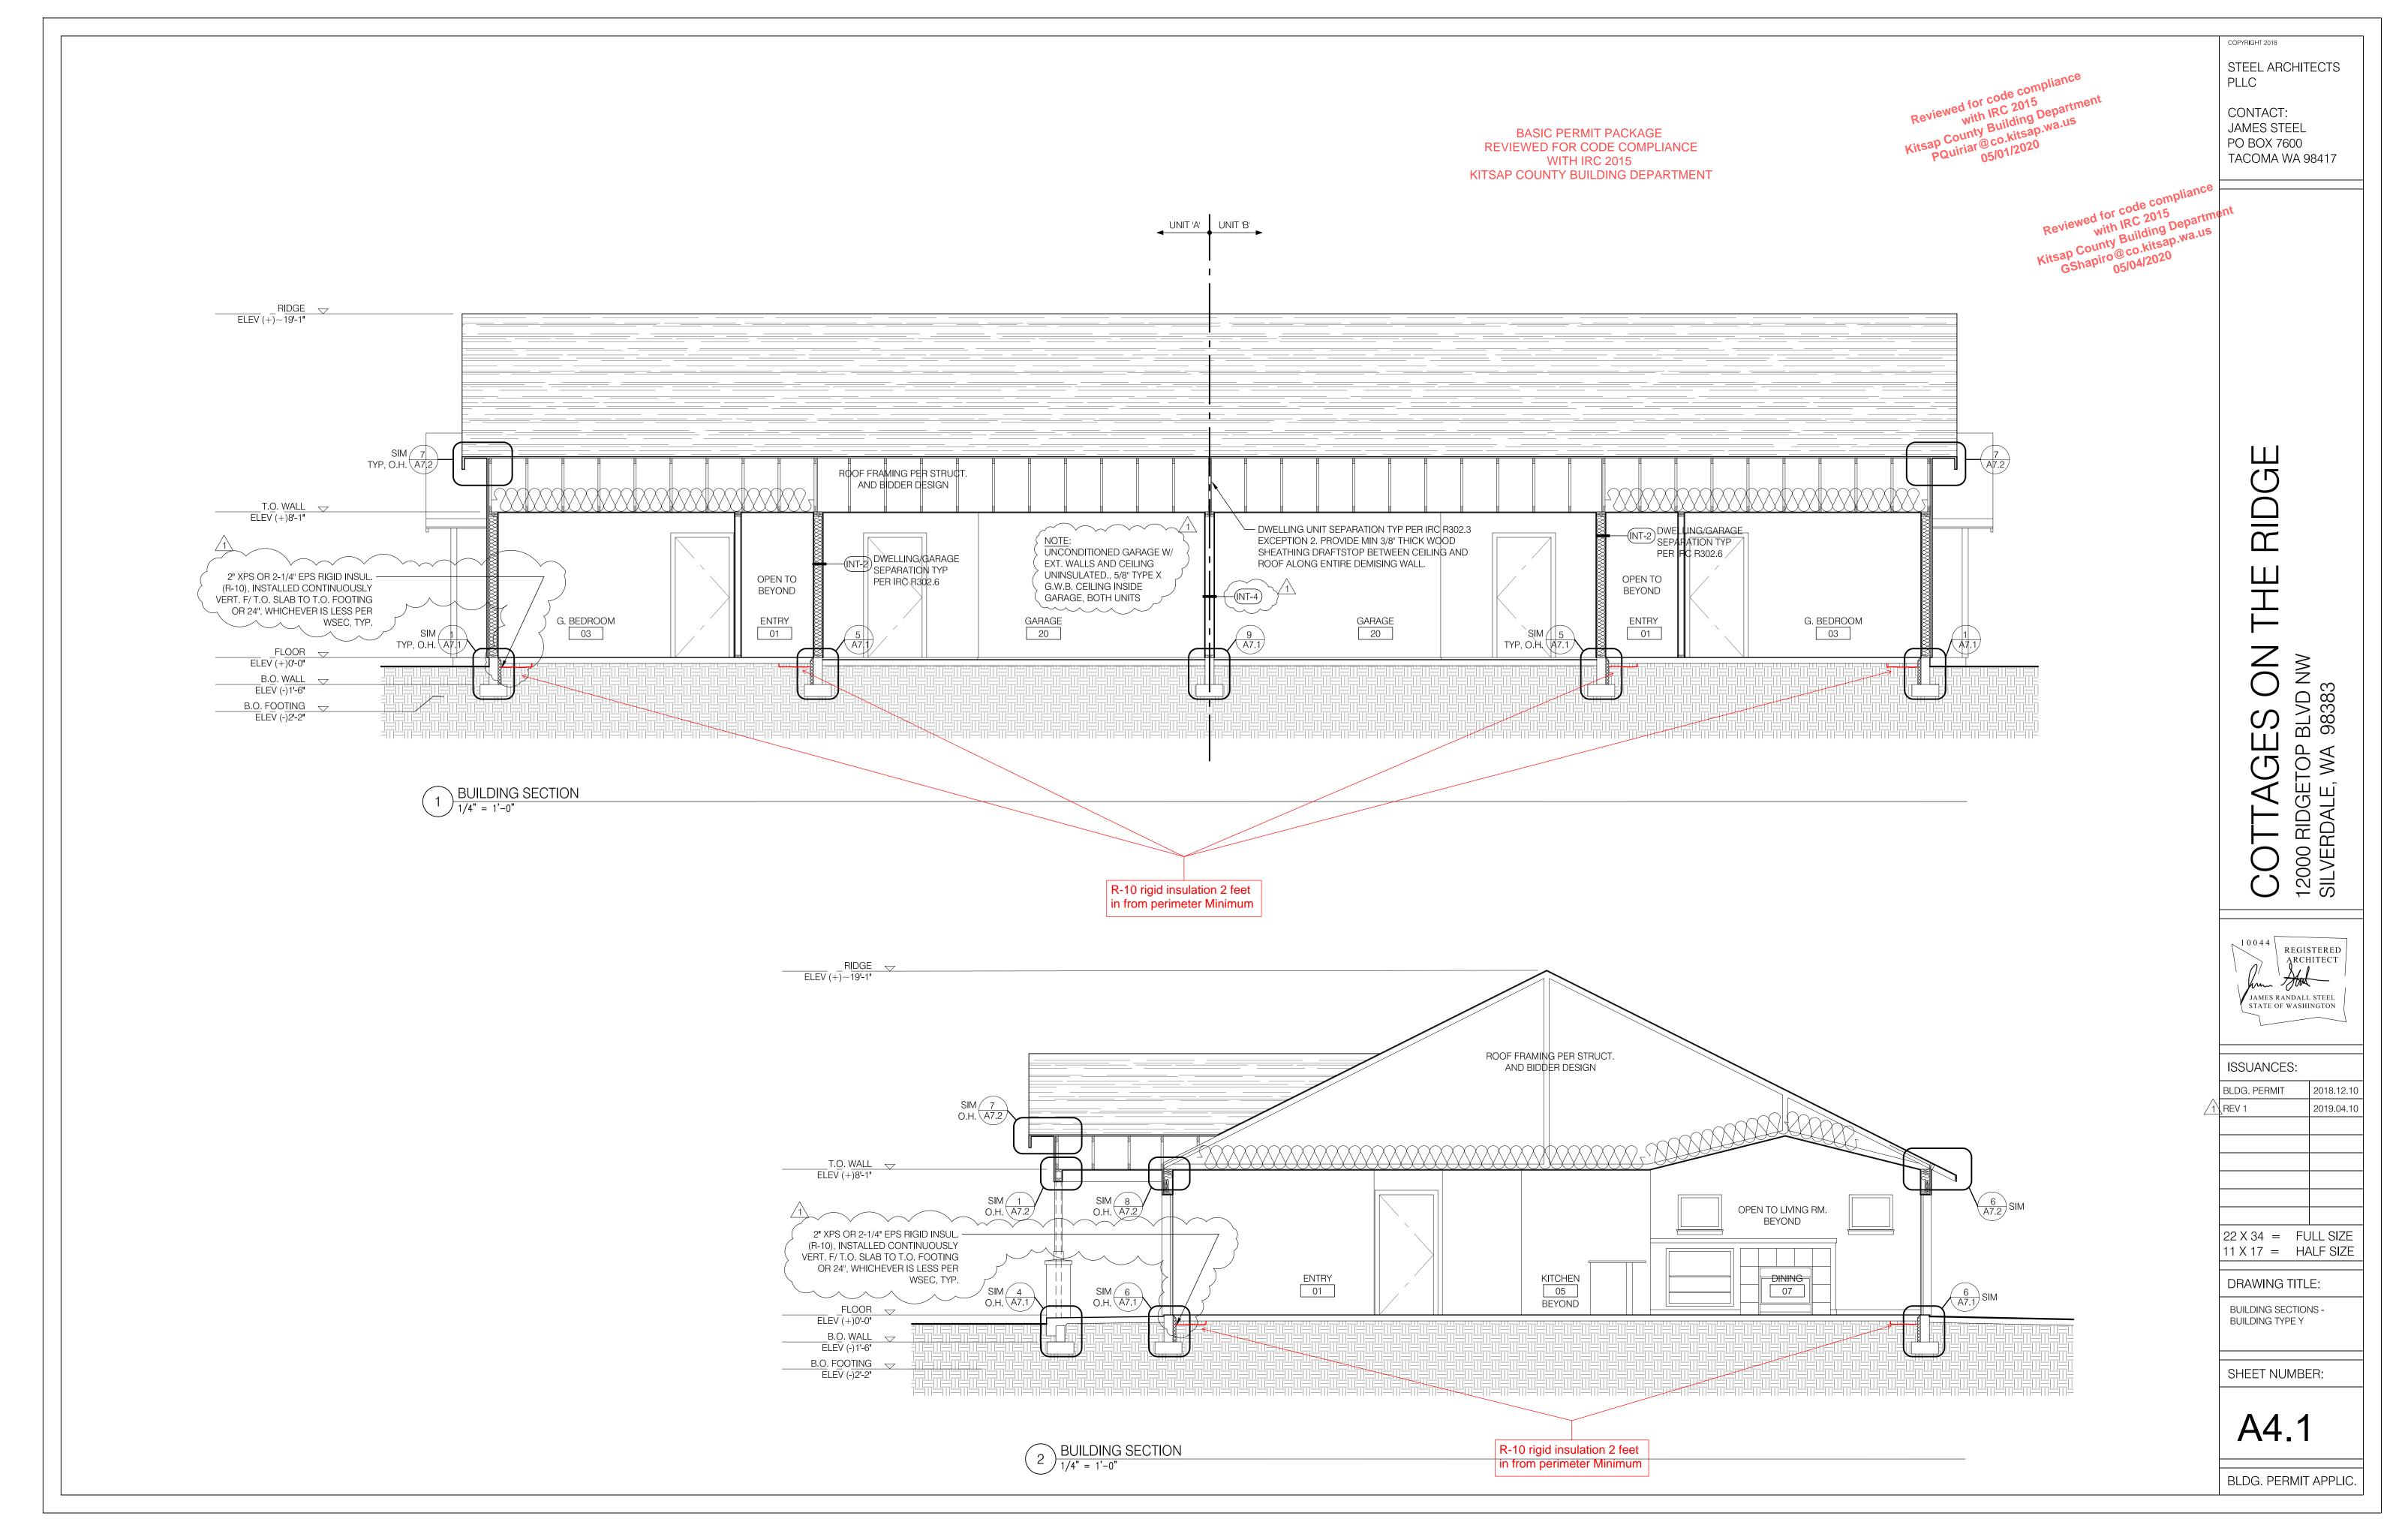

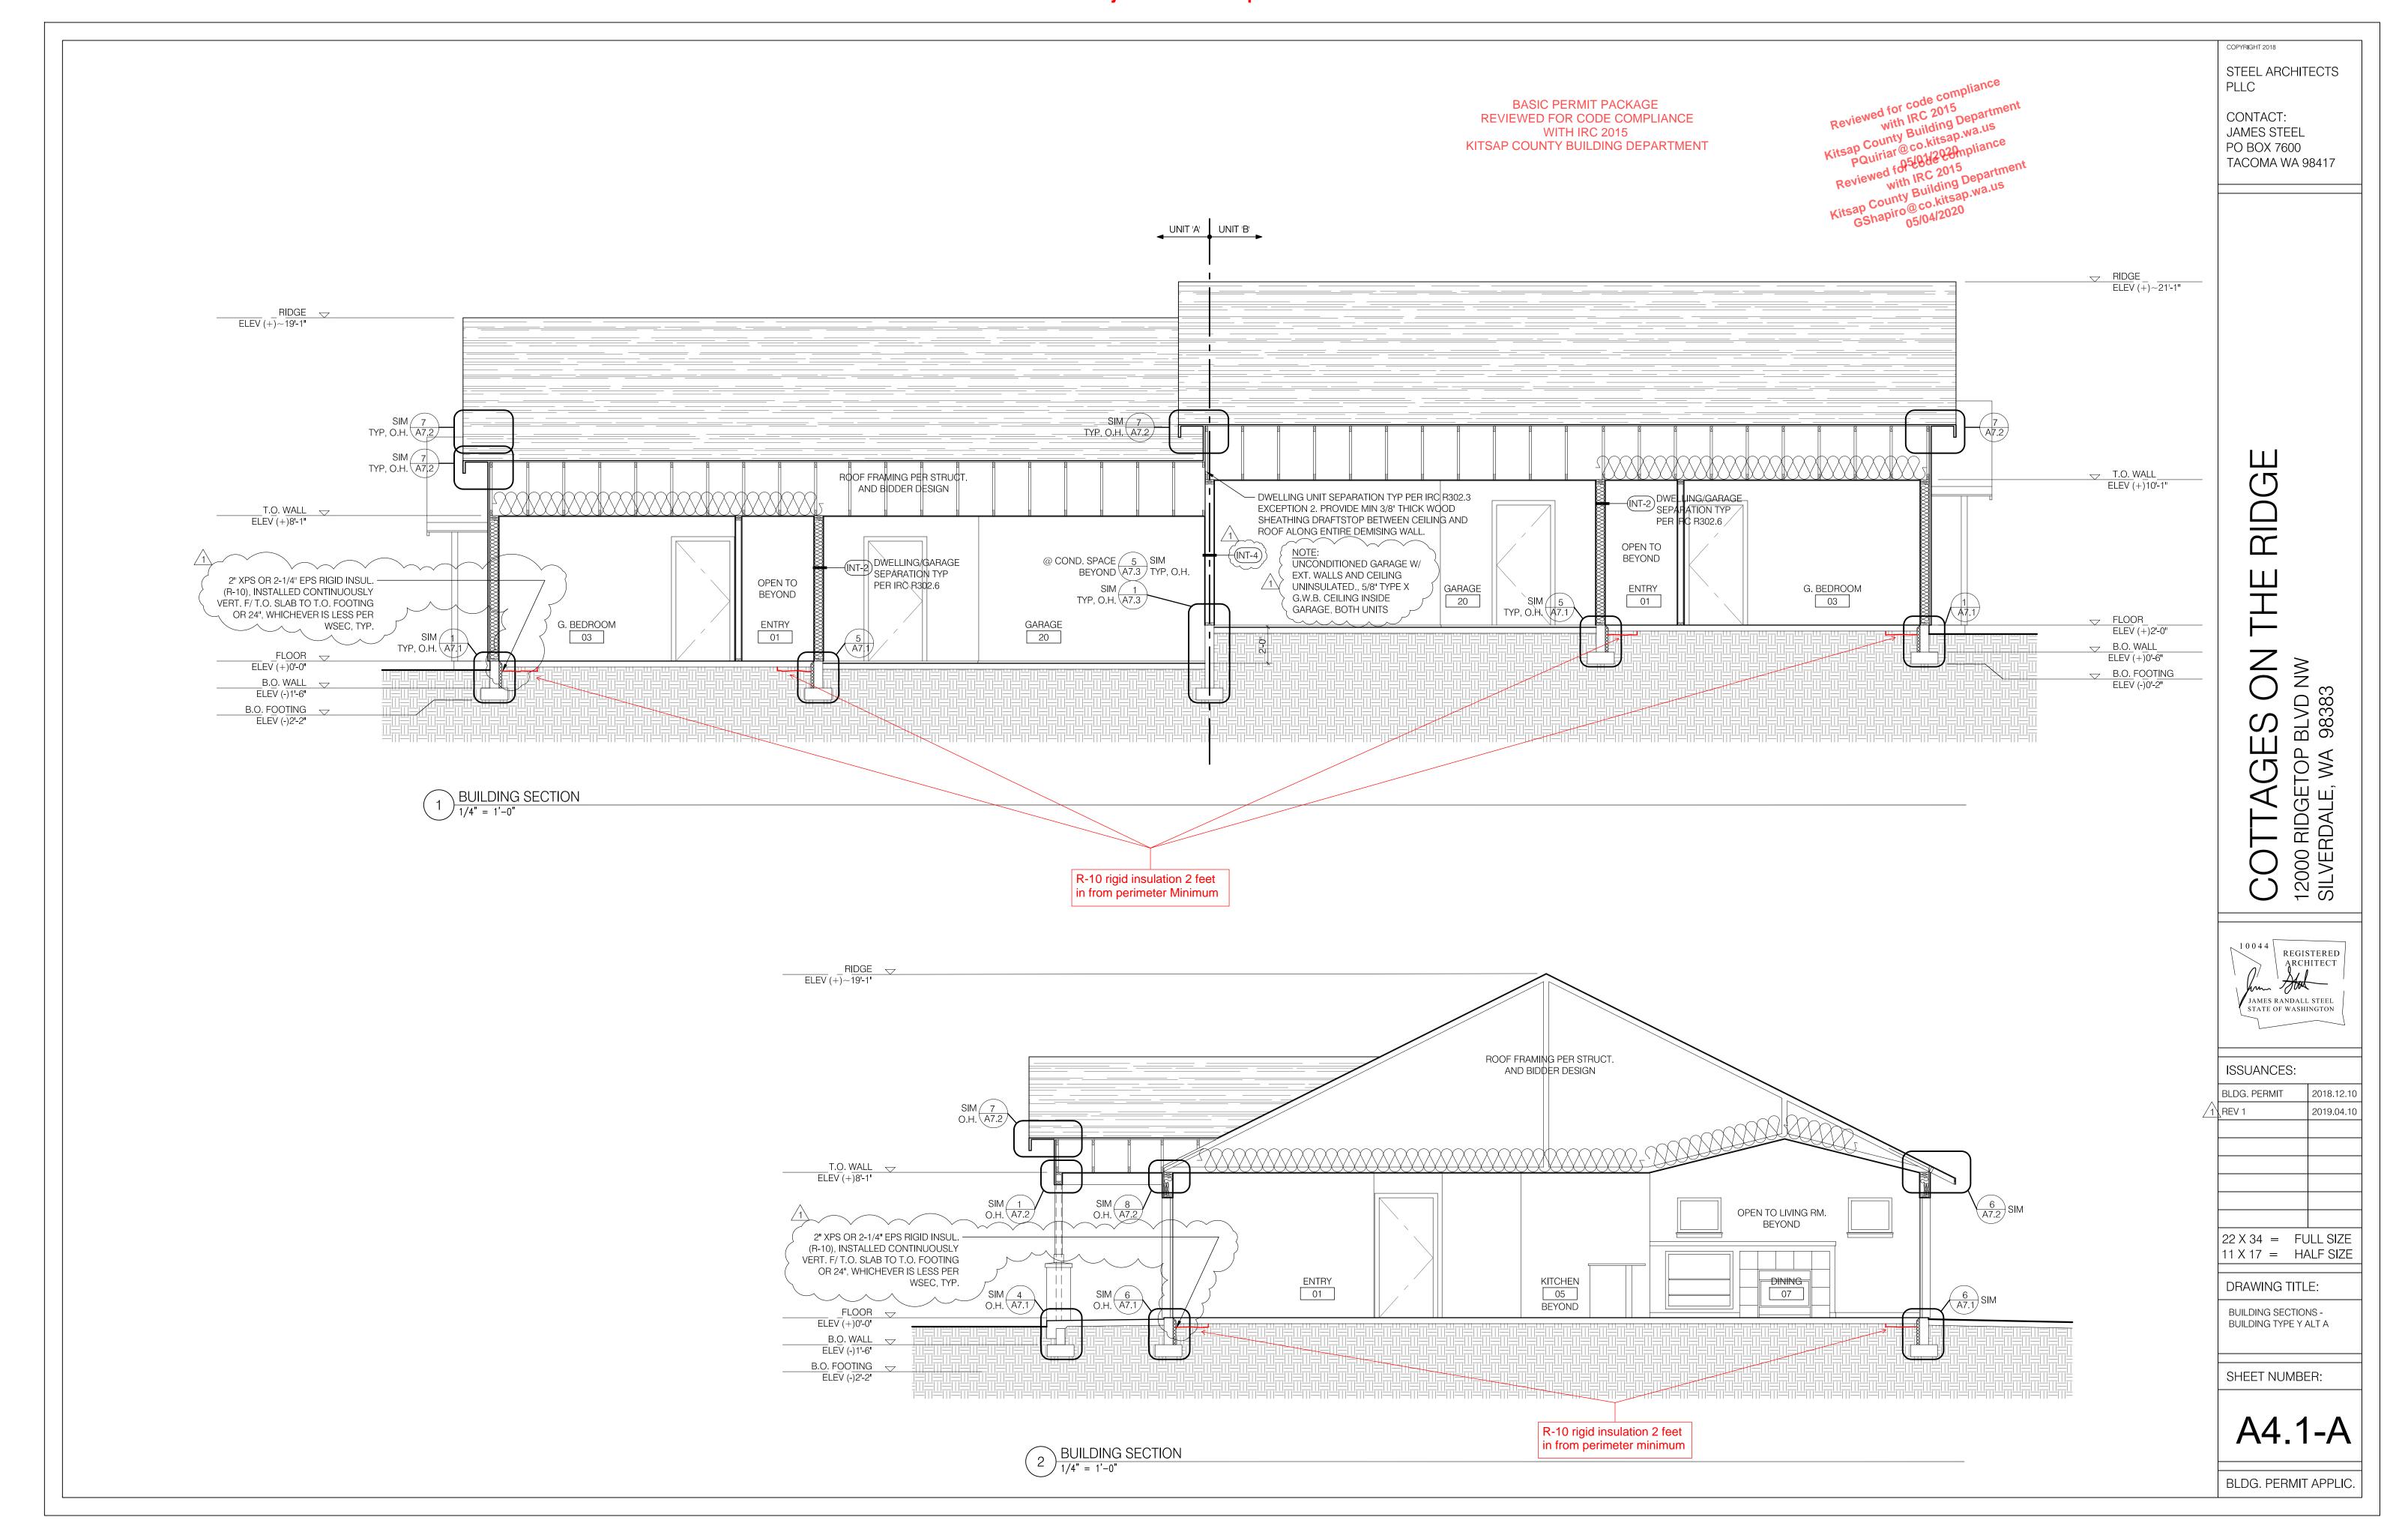

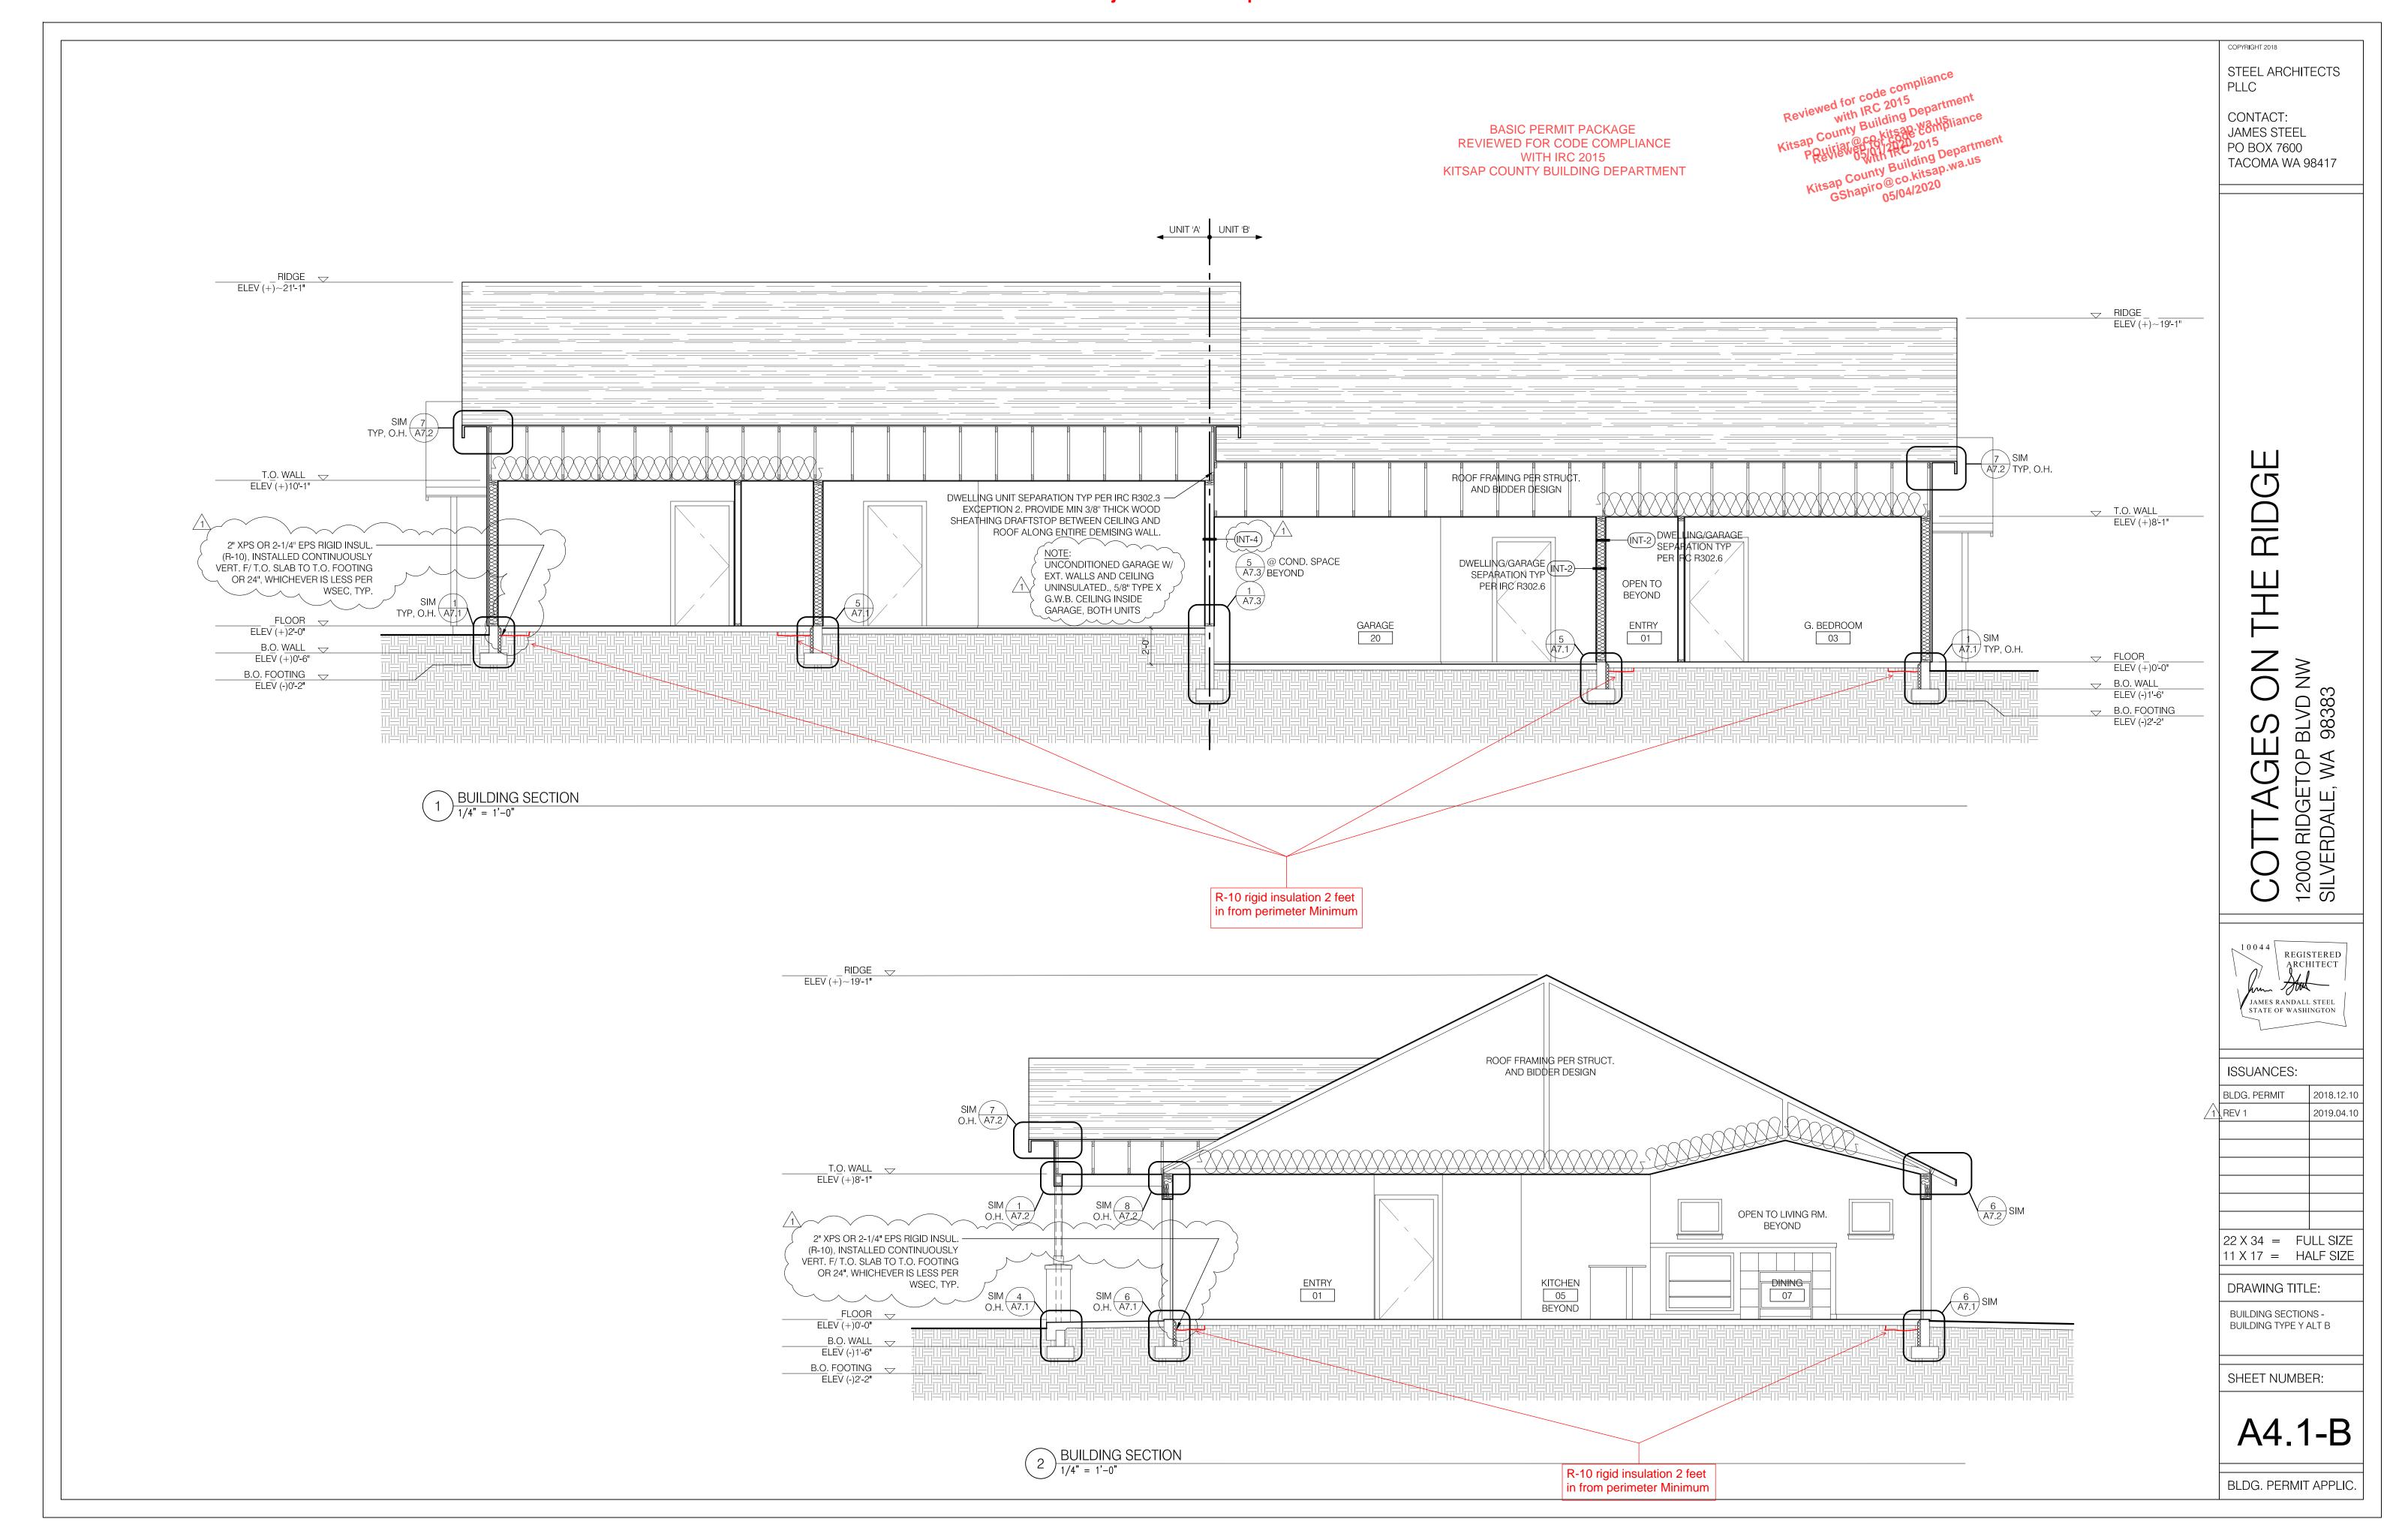

BASIC PERMIT PACKAGE
REVIEWED FOR CODE COMPLIANCE
WITH IRC 2015
KITSAP COUNTY BUILDING DEPARTMENT

Reviewed for code compliance
with IRC 2015
With IRC 2015
Kitsap County Building Department
Pourity Code kitsap wante
Reviewed for Code 2015
With IRC
with IRC
with IRC
titsap County Building Department
GShapiro@co.kitsap.wa.us
05/04/2020

DOOR NOTES:

1. DIMENSIONS SHOWN ARE DOOR SIZES. FRAMES AND REQ'D SHIM SPACE SHALL BE ACCOUNTED FOR IN R.O. SIZES

(NOT SHOWN).

2. PROVIDE IMPACT RESISTANT GLAZING (TEMPERED) WHERE INDICATED (T) ON DOOR SCHEDULE AND/OR ON EXTERIOR ELEVATIONS, AND WHERE REQ'D BY CODE.

3. VERIFY DOOR SIZES, TYPES, QUANTITIES, LOCATIONS AND SWING DIRECTIONS ON BUILDING TYPE FLOOR PLANS.

PO BOX 7600
TACOMA WA 98417

#### DOOR KEY

TYPE 1 EXTERIOR, IN-SWING - 'CRAFTSMAN' STYLE
TYPE 2 EXTERIOR, IN-SWING, SAFETY GLAZED
TYPE 3 EXTERIOR, SWING, PANEL, FIRE-RATED 20 MINUTE
TYPE 4 INTERIOR, SWING, 2-PANEL, SOLID CORE
TYPE 5 INTERIOR, SWING, 2-PANEL, HOLLOW CORE
TYPE 6 INTERIOR, BI-PASS, 2-PANEL, HOLLOW CORE
TYPE 7 AUTOMATIC OVERHEAD, GARAGE, 4 PANEL

#### FRAME KEY

TYPE 1 EXTERIOR, PRE-PRIMED WOOD
TYPE 2 INTERIOR, PRE-PRIMED WOOD
TYPE 3 NONE, GWB WRAP OPENING AND TRACK VALANCE


#### BULDING TYPE Y, UNIT 'A' - DOOR SCHEDULE

DOOR							FRAME					
NO.	LOCATION	TYPE	WIDTH	HEIGHT	THICK	MATL	TYPE	HEAD	JAMB	MATL	HDWR SET	REMARKS
A01A	ENTRY	1	3'-0"	6'-8"	1 3/4"	FG	1			WD	ENTRY/D.B.	
A02A	HALL	5	2'-6"	6'-8"	1 3/8"	WD	2			WD	PASSAGE	
A02B	HALL	5	2'-0"	6'-8"	1 3/8"	WD	2			WD	PASSAGE	
A03A	G. BEDROOM	4	3'-0"	6'-8"	1 3/8"	WD	2			WD	PASSAGE	
A03B	G. BEDROOM	6	5'-0"	6'-8"	1 3/8"	WD	3			WD	BYPASS	
A04A	G. BATHROOM	4	3'-0"	6'-8"	1 3/8"	WD	2			WD	PRIVACY	
A07A	DINING	2	3'-0"	6'-8"	1 3/4"	FG	1			WD	PATIO/D.B.	(T) SAFETY GLAZING
A08A	LAUNDRY	5	3'-0"	6'-8"	1 3/8"	WD	2			WD	PASSAGE	
A08B	LAUNDRY	5	2'-0"	6'-8"	1 3/8"	WD	2			WD	PASSAGE	
A08C	LAUNDRY	3	3'-0"	6'-8"	1 3/8"	MTL	1			WD	PASSAGE/D.B.	20 MIN RATED W/ SELF CLOSING DEVICE
A09A	HALL	5	2'-0"	6'-8"	1 3/8"	WD	2			WD	PASSAGE	
A10A	M. BEDROOM	4	3'-0"	6'-8"	1 3/8"	WD	2			WD	PASSAGE	
A11A	M. CLOSET	5	3'-0"	6'-8"	1 3/8"	WD	2			WD	PASSAGE	
A12A	M. BATHROOM	4	3'-0"	6'-8"	1 3/8"	WD	2			WD	PRIVACY	
A20A	GARAGE	7	16'-0"	7'-0"	1 3/4"	FG	1			WD	AUTOMATIC	

### BULDING TYPE Y, UNIT 'B' - DOOR SCHEDULE

LOCATION T				DOOR					FRAME					
	TYPE	WIDTH	HEIGHT	THICK	MATL	TYPE	HEAD	JAMB	MATL	HDWR SET	REMARKS			
NTRY	1	3'-0"	6'-8"	1 3/4"	FG	1			WD	ENTRY/D.B.				
ALL	5	2'-6"	6'-8"	1 3/8"	WD	2			WD	PASSAGE				
ALL	5	2'-0"	6'-8"	1 3/8"	WD	2			WD	PASSAGE				
BEDROOM	4	3'-0"	6'-8"	1 3/8"	WD	2			WD	PASSAGE				
BEDROOM	6	5'-0"	6'-8"	1 3/8"	WD	3			WD	BYPASS				
BATHROOM	4	3'-0"	6'-8"	1 3/8"	WD	2			WD	PRIVACY				
NING	2	3'-0"	6'-8"	1 3/4"	FG	1			WD	PATIO/D.B.	(T) SAFETY GLAZING			
UNDRY	5	3'-0"	6'-8"	1 3/8"	WD	2			WD	PASSAGE				
UNDRY	5	2'-0"	6'-8"	1 3/8"	WD	2			WD	PASSAGE				
UNDRY	3	3'-0"	6'-8"	1 3/8"	MTL	1			WD	PASSAGE/D.B.	20 MIN RATED W/ SELF CLOSING DEVICE			
ALL	5	2'-0"	6'-8"	1 3/8"	WD	2			WD	PASSAGE				
BEDROOM	4	3'-0"	6'-8"	1 3/8"	WD	2			WD	PASSAGE				
CLOSET	5	3'-0"	6'-8"	1 3/8"	WD	2			WD	PASSAGE				
BATHROOM	4	3'-0"	6'-8"	1 3/8"	WD	2			WD	PRIVACY				
ARAGE	7	16'-0"	7'-0"	1 3/4"	FG	1			WD	AUTOMATIC				
	LL BEDROOM BEDROOM BATHROOM ING INDRY INDRY INDRY INDRY INDRY INDRY LL BEDROOM CLOSET BATHROOM	L 5 BEDROOM 4 BEDROOM 6 BATHROOM 4 ING 2 INDRY 5 INDRY 5 INDRY 3 L 5 BEDROOM 4 CLOSET 5 BATHROOM 4	LL 5 2'-0" BEDROOM 4 3'-0" BEDROOM 6 5'-0" BATHROOM 4 3'-0" ING 2 3'-0" INDRY 5 3'-0" INDRY 5 2'-0" INDRY 3 3'-0" LL 5 2'-0" BEDROOM 4 3'-0" CLOSET 5 3'-0" BATHROOM 4 3'-0"	LL 5 2'-0" 6'-8"  BEDROOM 4 3'-0" 6'-8"  BEDROOM 6 5'-0" 6'-8"  BATHROOM 4 3'-0" 6'-8"  ING 2 3'-0" 6'-8"  INDRY 5 3'-0" 6'-8"  INDRY 5 2'-0" 6'-8"  INDRY 3 3'-0" 6'-8"  LL 5 2'-0" 6'-8"  BEDROOM 4 3'-0" 6'-8"  CLOSET 5 3'-0" 6'-8"  BATHROOM 4 3'-0" 6'-8"	L       5       2'-0"       6'-8"       1 3/8"         BEDROOM       4       3'-0"       6'-8"       1 3/8"         BEDROOM       6       5'-0"       6'-8"       1 3/8"         BATHROOM       4       3'-0"       6'-8"       1 3/8"         ING       2       3'-0"       6'-8"       1 3/4"         INDRY       5       3'-0"       6'-8"       1 3/8"         INDRY       5       2'-0"       6'-8"       1 3/8"         INDRY       3       3'-0"       6'-8"       1 3/8"         L       5       2'-0"       6'-8"       1 3/8"         BEDROOM       4       3'-0"       6'-8"       1 3/8"         CLOSET       5       3'-0"       6'-8"       1 3/8"         BATHROOM       4       3'-0"       6'-8"       1 3/8"	LL 5 2'-0" 6'-8" 1 3/8" WD BEDROOM 4 3'-0" 6'-8" 1 3/8" WD BEDROOM 6 5'-0" 6'-8" 1 3/8" WD BATHROOM 4 3'-0" 6'-8" 1 3/8" WD BATHROOM 5 3'-0" 6'-8" 1 3/4" FG BINDRY 5 3'-0" 6'-8" 1 3/8" WD BINDRY 5 2'-0" 6'-8" 1 3/8" WD BINDRY 3 3'-0" 6'-8" 1 3/8" WD BEDROOM 4 3'-0" 6'-8" 1 3/8" WD	L     5     2'-0"     6'-8"     1 3/8"     WD     2       BEDROOM     4     3'-0"     6'-8"     1 3/8"     WD     2       BEDROOM     6     5'-0"     6'-8"     1 3/8"     WD     3       BATHROOM     4     3'-0"     6'-8"     1 3/8"     WD     2       ING     2     3'-0"     6'-8"     1 3/4"     FG     1       INDRY     5     3'-0"     6'-8"     1 3/8"     WD     2       INDRY     5     2'-0"     6'-8"     1 3/8"     WD     2       INDRY     3     3'-0"     6'-8"     1 3/8"     MTL     1       L     5     2'-0"     6'-8"     1 3/8"     WD     2       BEDROOM     4     3'-0"     6'-8"     1 3/8"     WD     2       CLOSET     5     3'-0"     6'-8"     1 3/8"     WD     2       BATHROOM     4     3'-0"     6'-8"     1 3/8"     WD     2	LL 5 2'-0" 6'-8" 1 3/8" WD 2 BEDROOM 4 3'-0" 6'-8" 1 3/8" WD 2 BEDROOM 6 5'-0" 6'-8" 1 3/8" WD 3 BATHROOM 4 3'-0" 6'-8" 1 3/8" WD 2 ING 2 3'-0" 6'-8" 1 3/4" FG 1 INDRY 5 3'-0" 6'-8" 1 3/8" WD 2 INDRY 5 2'-0" 6'-8" 1 3/8" WD 2 INDRY 3 3'-0" 6'-8" 1 3/8" WD 2 BEDROOM 4 3'-0" 6'-8" 1 3/8" WD 2	LL 5 2'-0" 6'-8" 1 3/8" WD 2 3EDROOM 4 3'-0" 6'-8" 1 3/8" WD 2 3EDROOM 6 5'-0" 6'-8" 1 3/8" WD 3 3EDROOM 4 3'-0" 6'-8" 1 3/8" WD 2 3EDROOM 4 3'-0" 6'-8" 1 3/8" WD 2 3EDROOM 5 3'-0" 6'-8" 1 3/4" FG 1 3/4" FG 1 3/5" WD 2 3EDROOM 5 3'-0" 6'-8" 1 3/8" WD 2 3EDROOM 5 2'-0" 6'-8" 1 3/8" WD 2 3EDROOM 5 2'-0" 6'-8" 1 3/8" WINDOW TYPE ELEVATIONS ALL PLUI DINOS

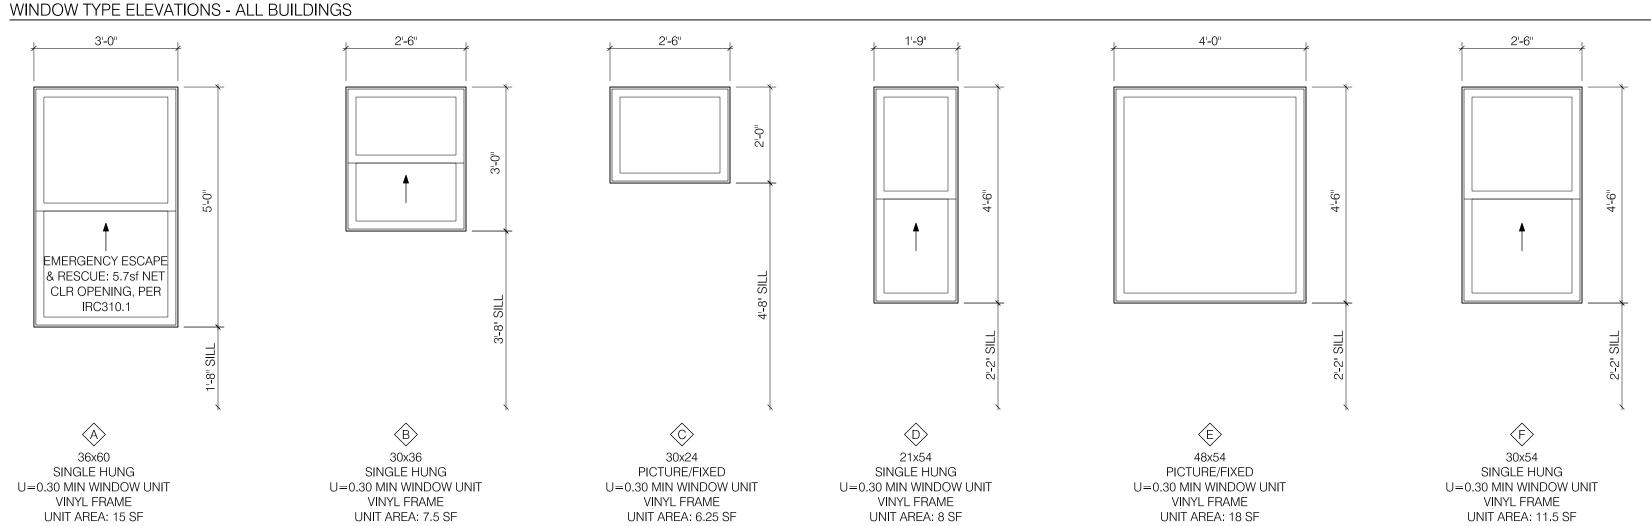

#### WINDOWS NOTES

ALL UNITS DRAWN AS VIEWED FROM THE EXTERIOR.
 DIMENSIONS SHOWN ARE WINDOW SIZES. REQ'D SHIM SPACE SHALL BE ACCOUNTED FOR IN R.O. SIZES (NOT SHOWN).
 PROVIDE IMPACT RESISTANT GLAZING (TEMPERED) WHERE REQ'D BY CODE.

REQ'D BY CODE.

4. VERIFY WINDOW SIZES, TYPES, QUANTITIES, AND LOCATIONS ON BUILDING TYPE FLOOR PLANS.

STEEL ARCHITECTS

STEEL ARCHITECTS PLLC

CONTACT:

JAMES STEEL

SES ON THE RIDGE

REGISTERED ARCHITECT

JAMES RANDALL STEEL STATE OF WASHINGTON

COTTA 12000 RIDGE SILVERDALE

ISSUANCES:

BLDG. PERMIT 2018.12.10

2019.04.10

22 X 34 = FULL SIZE 11 X 17 = HALF SIZE


DRAWING TITLE:


DOOR SCHEDULES -BLDGS X,Y,Z WINDOW SCHEDULE - ALL


SHEET NUMBER:


A6.1


BLDG. PERMIT APPLIC.

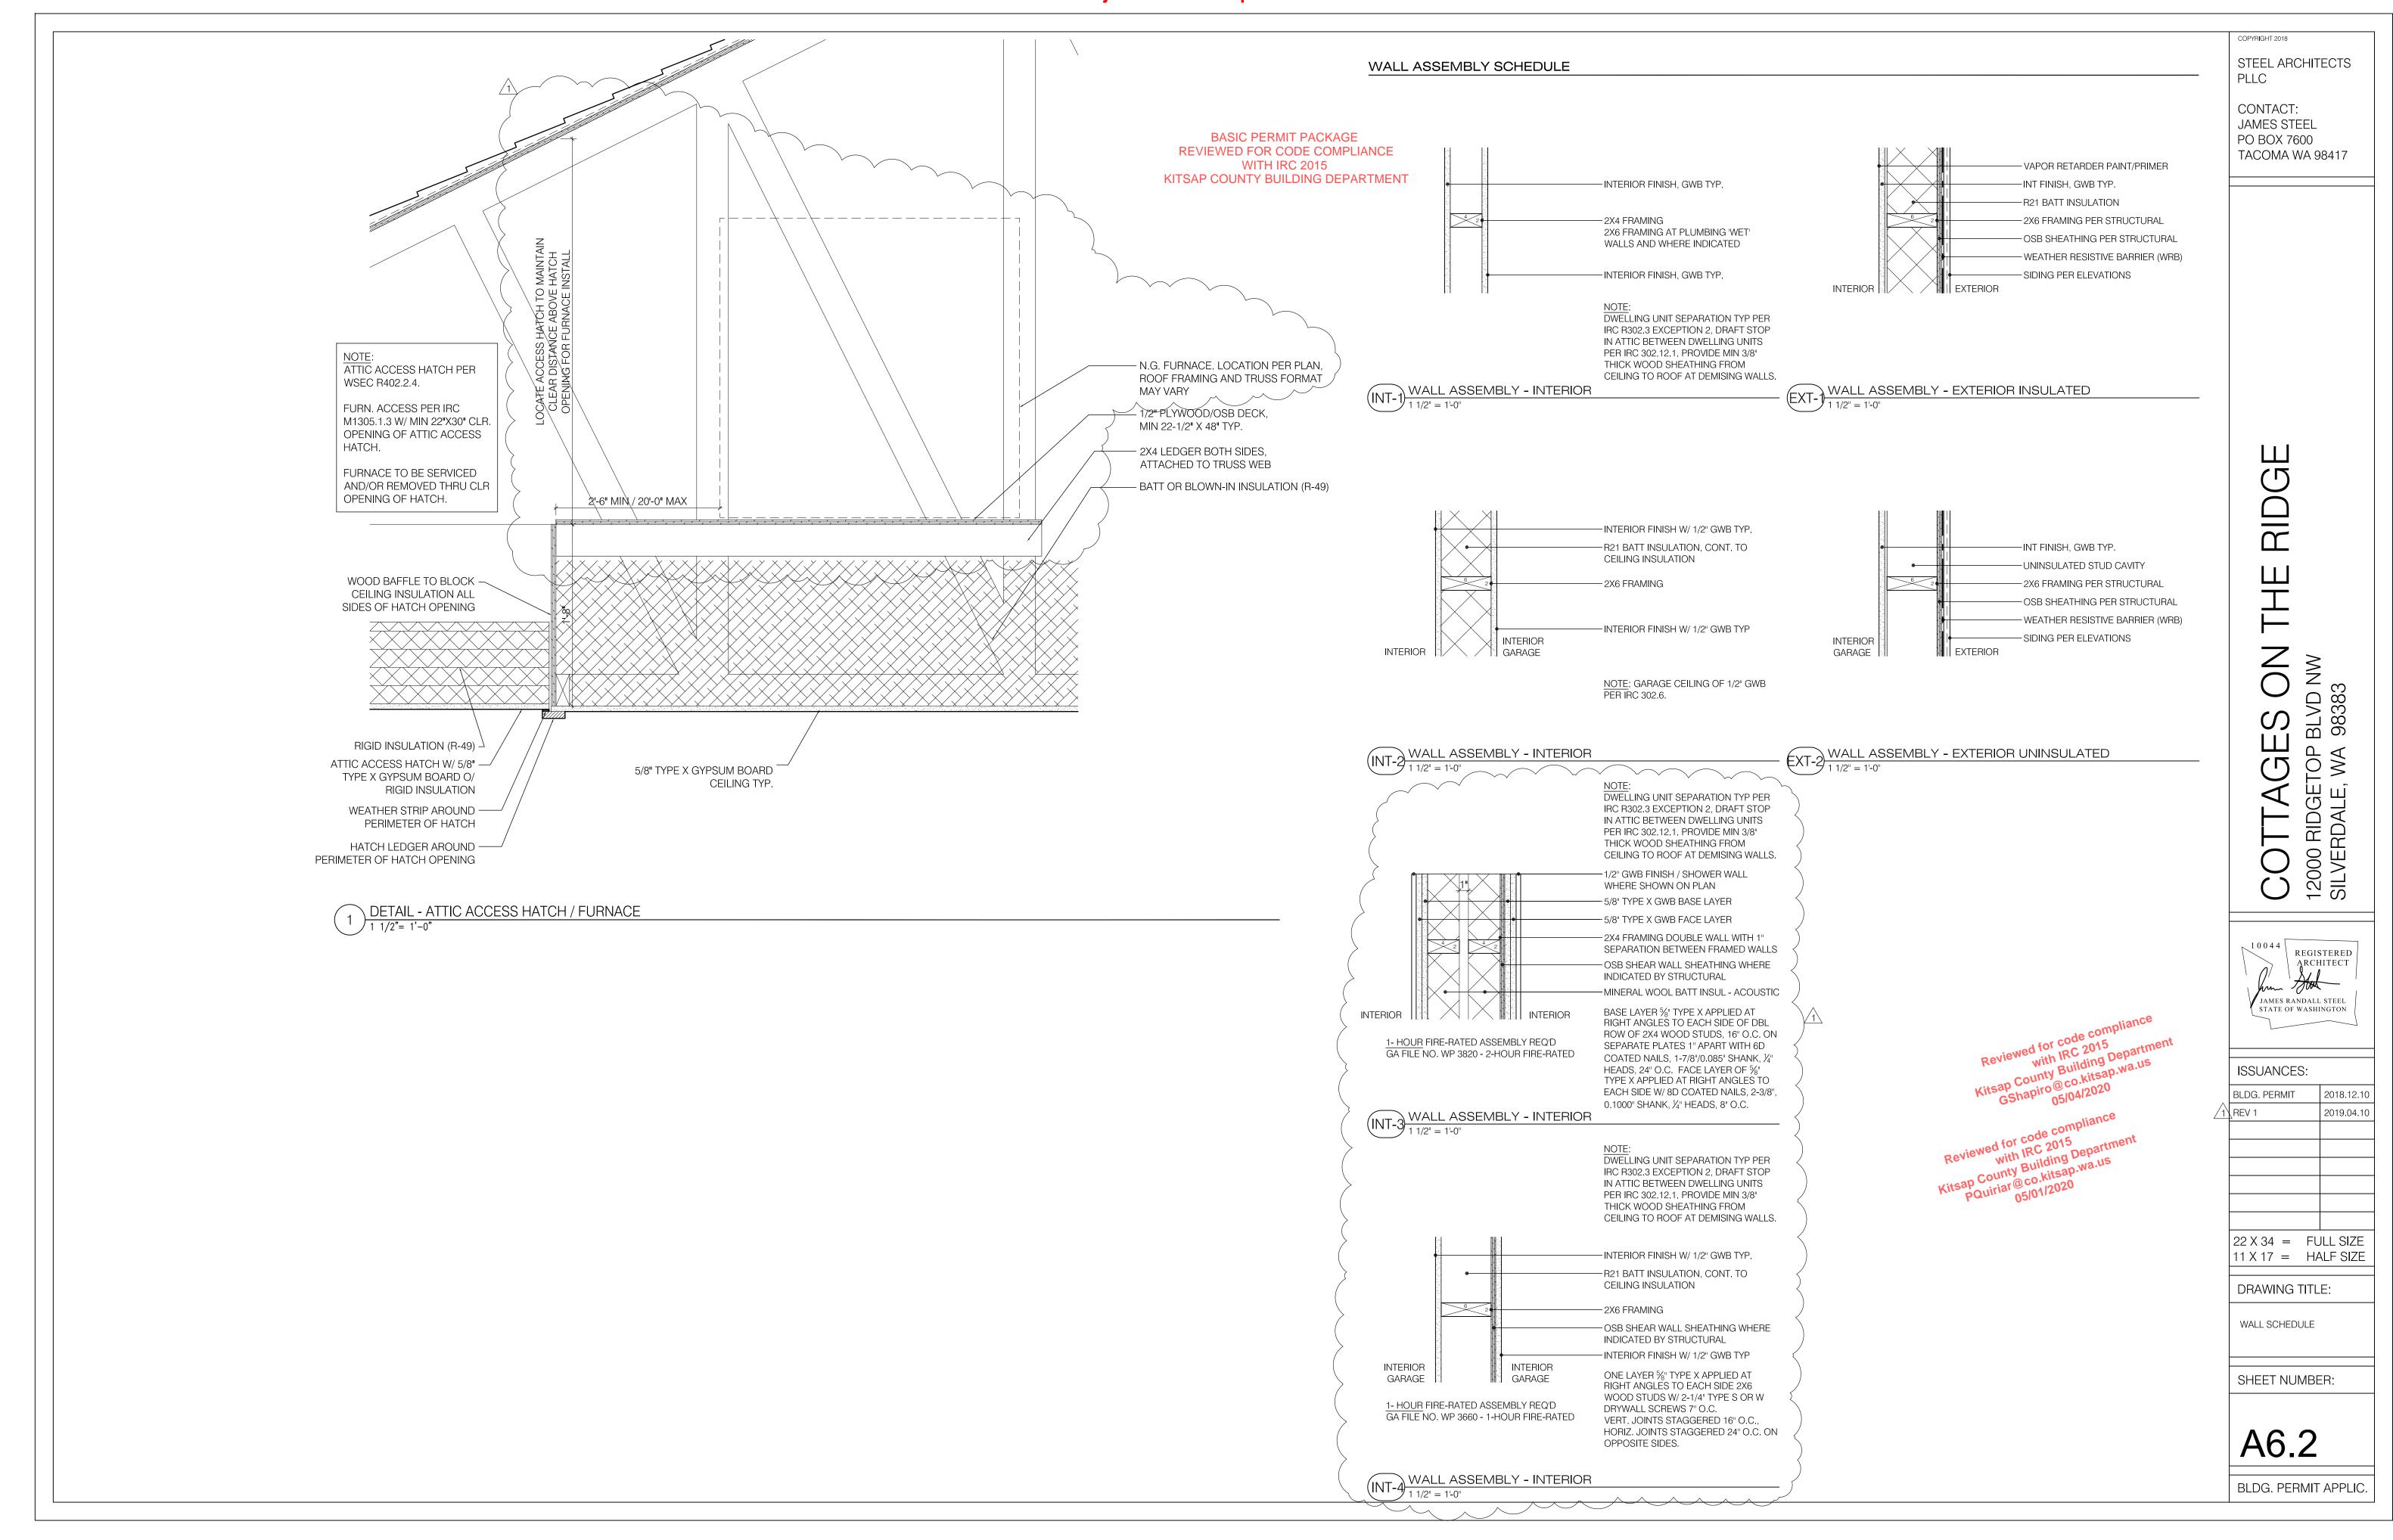


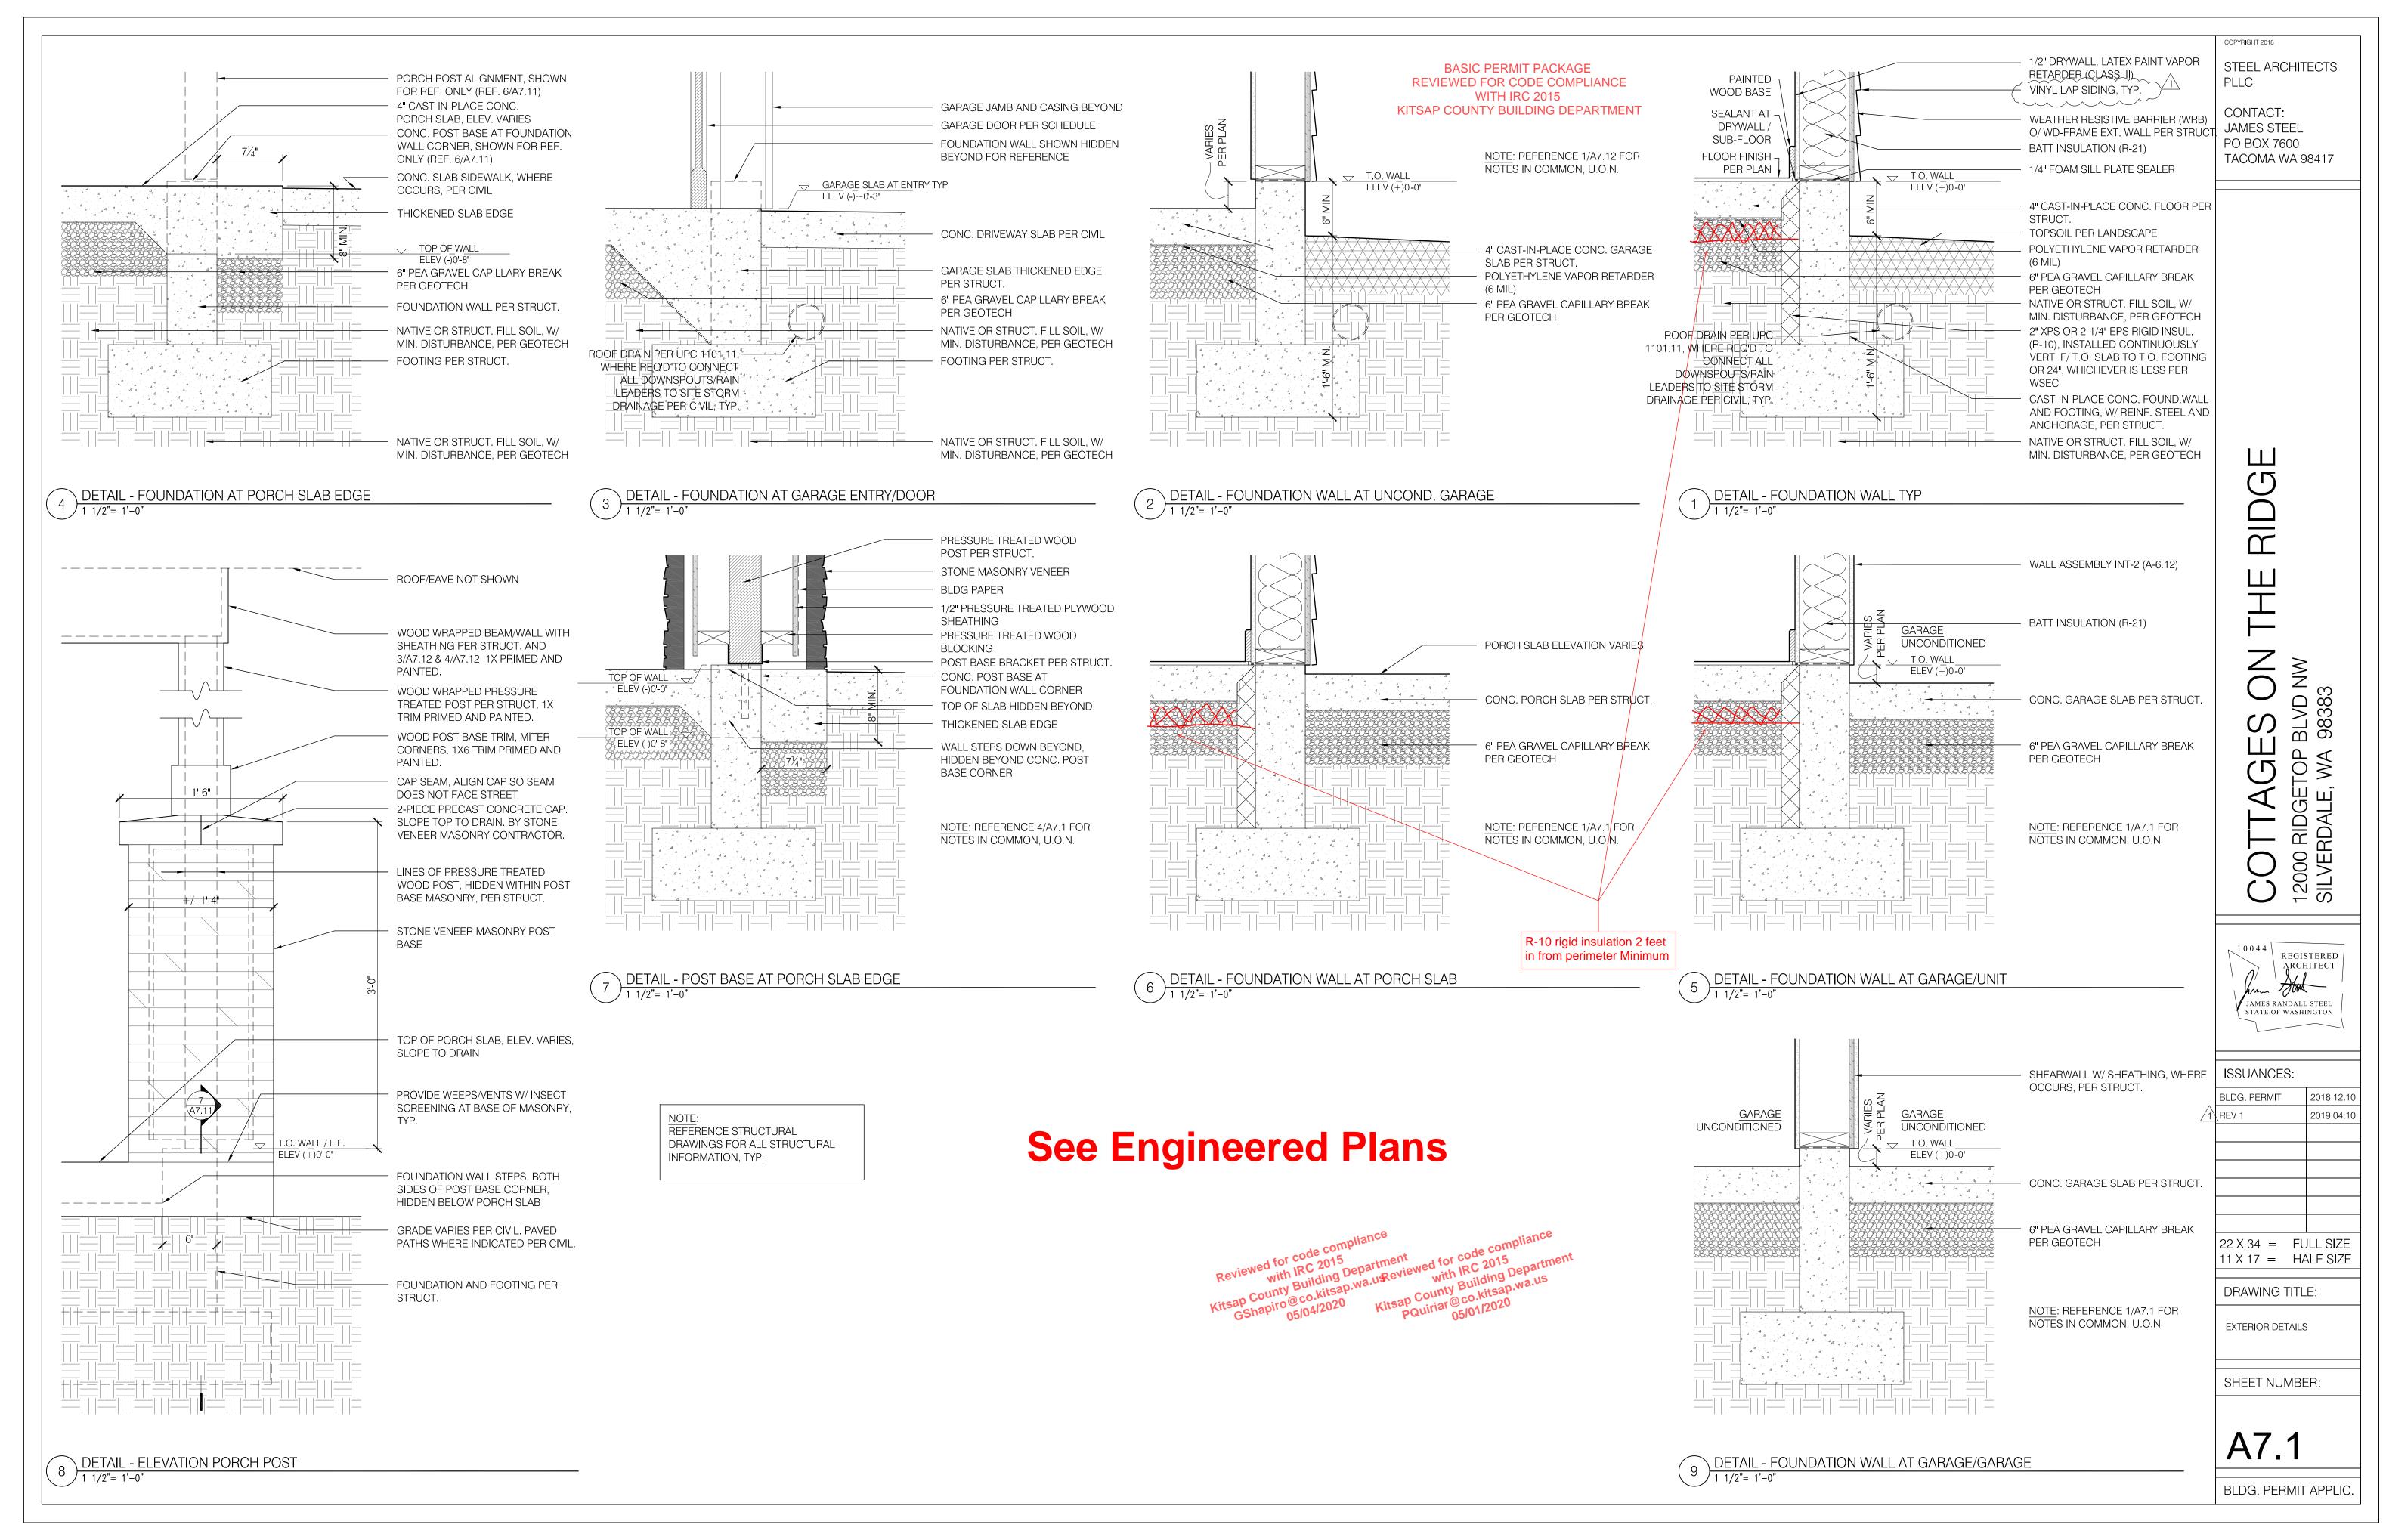

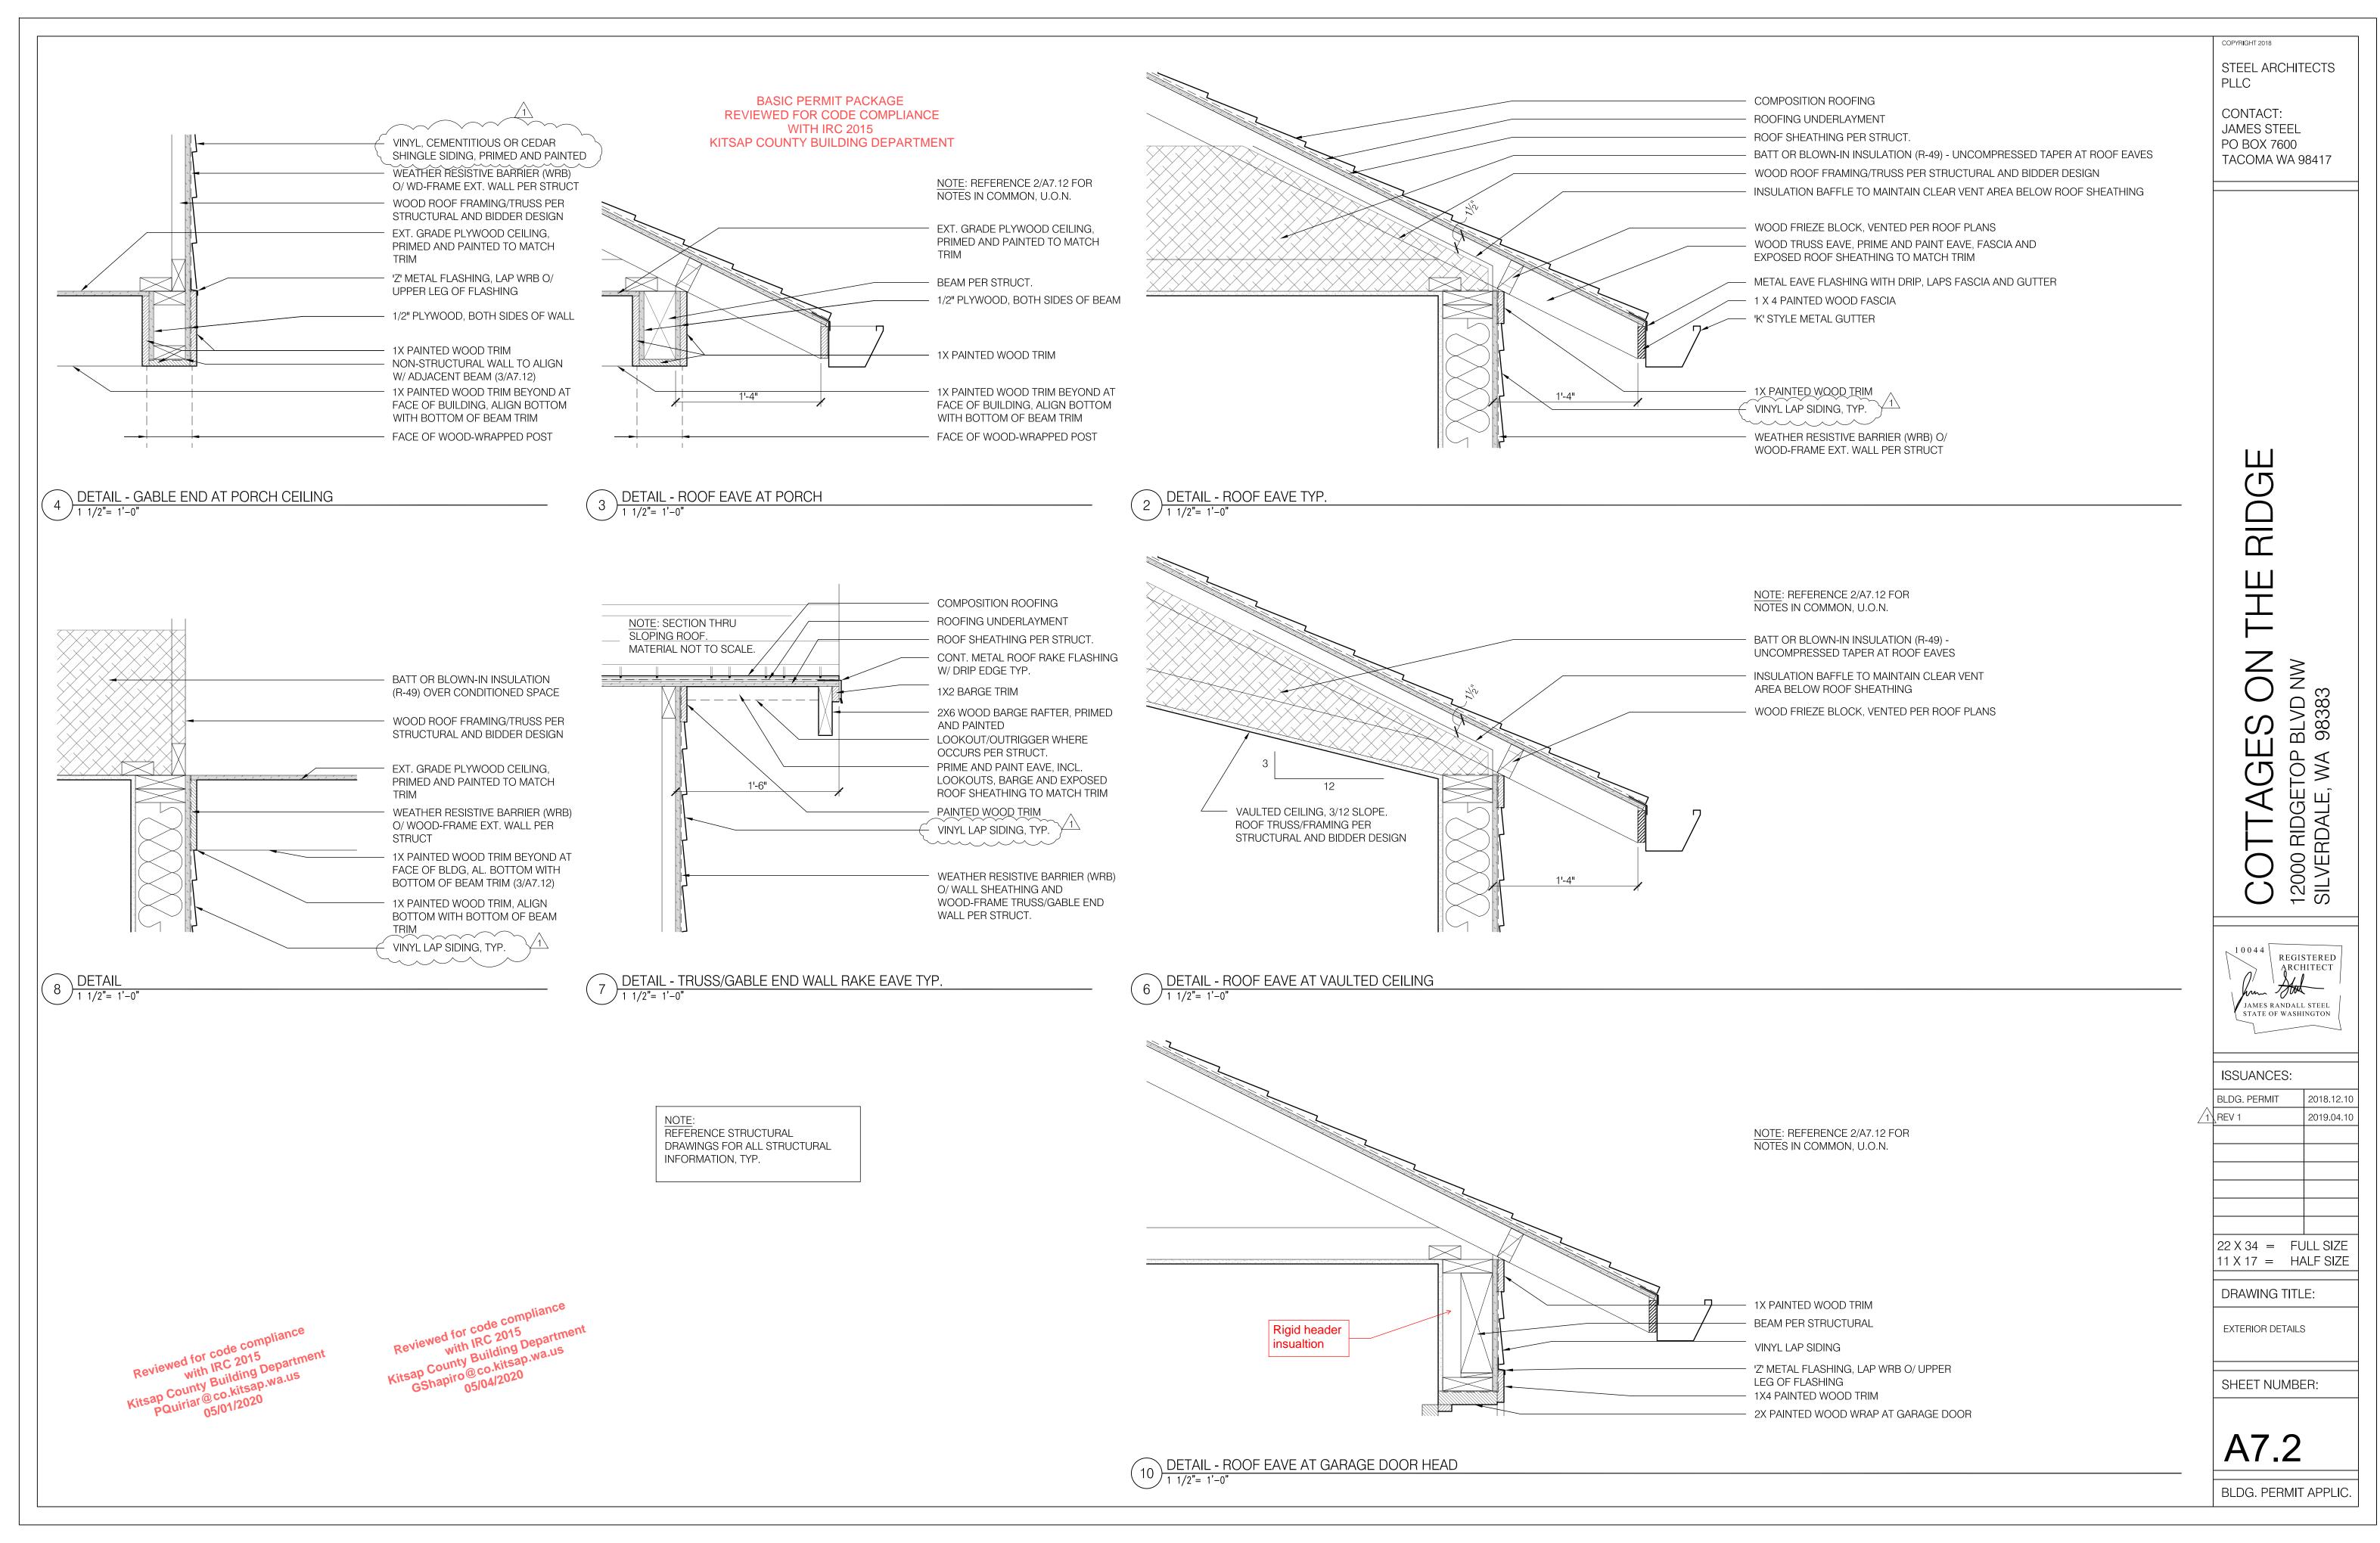

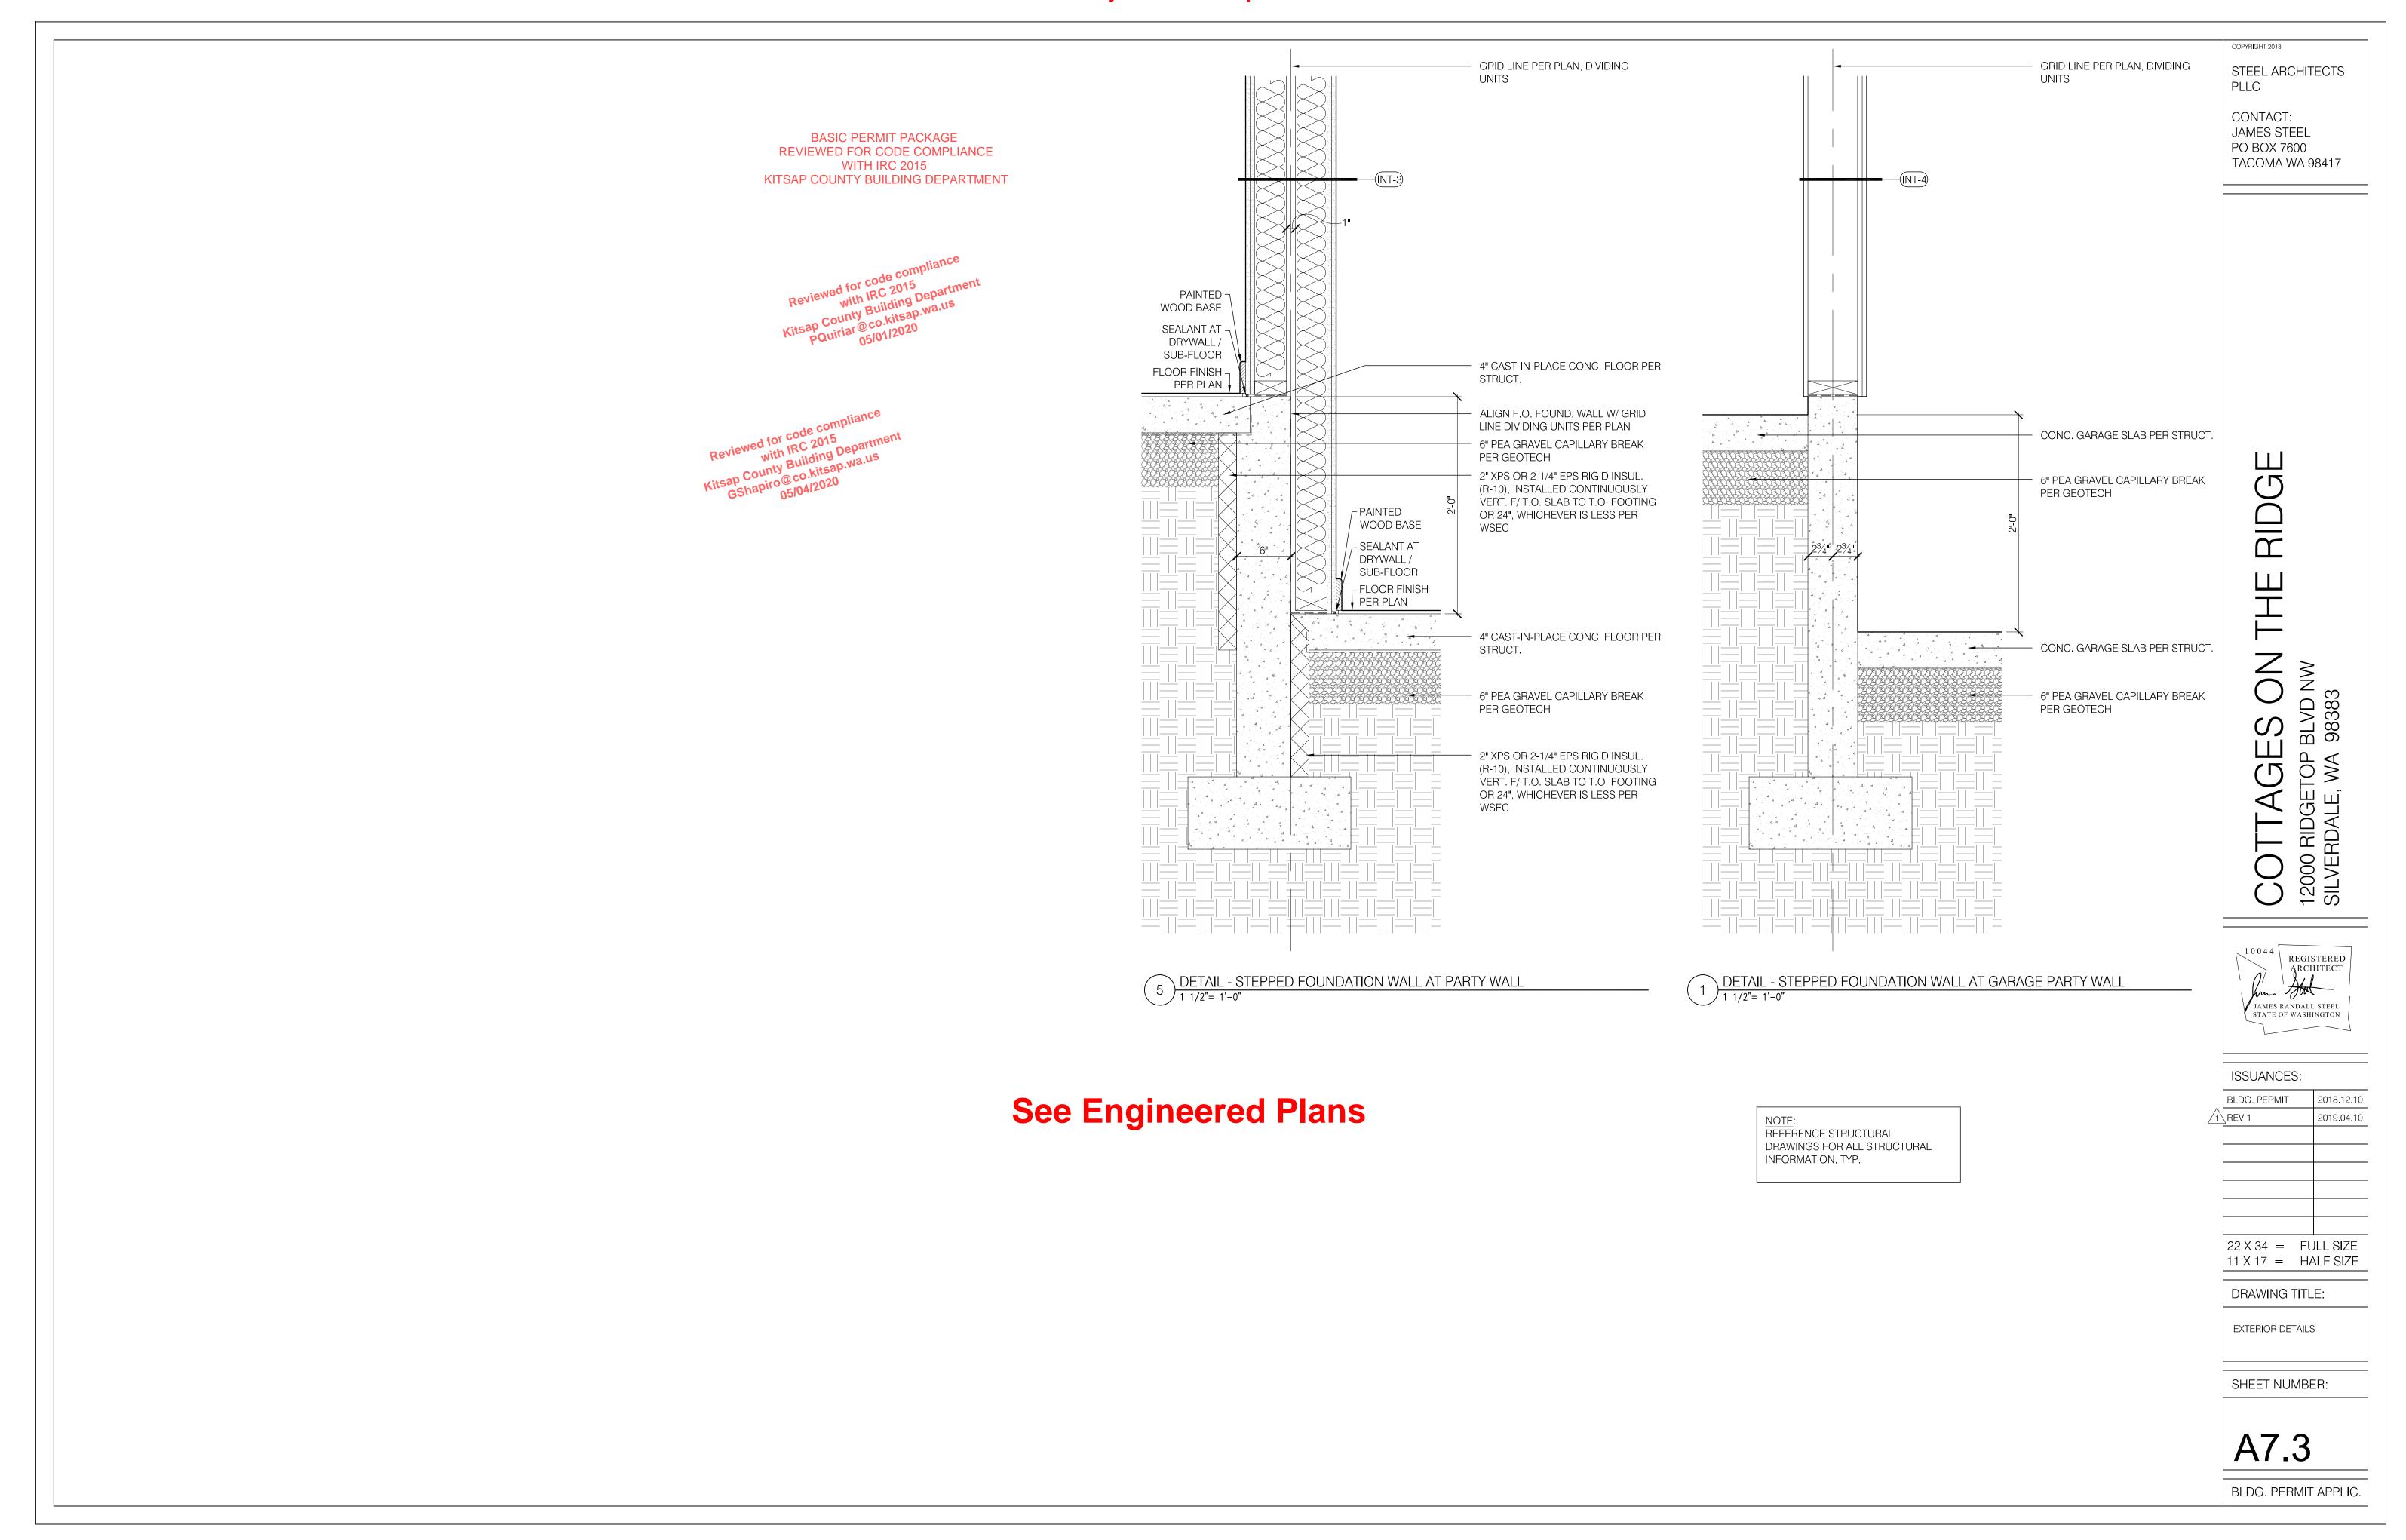

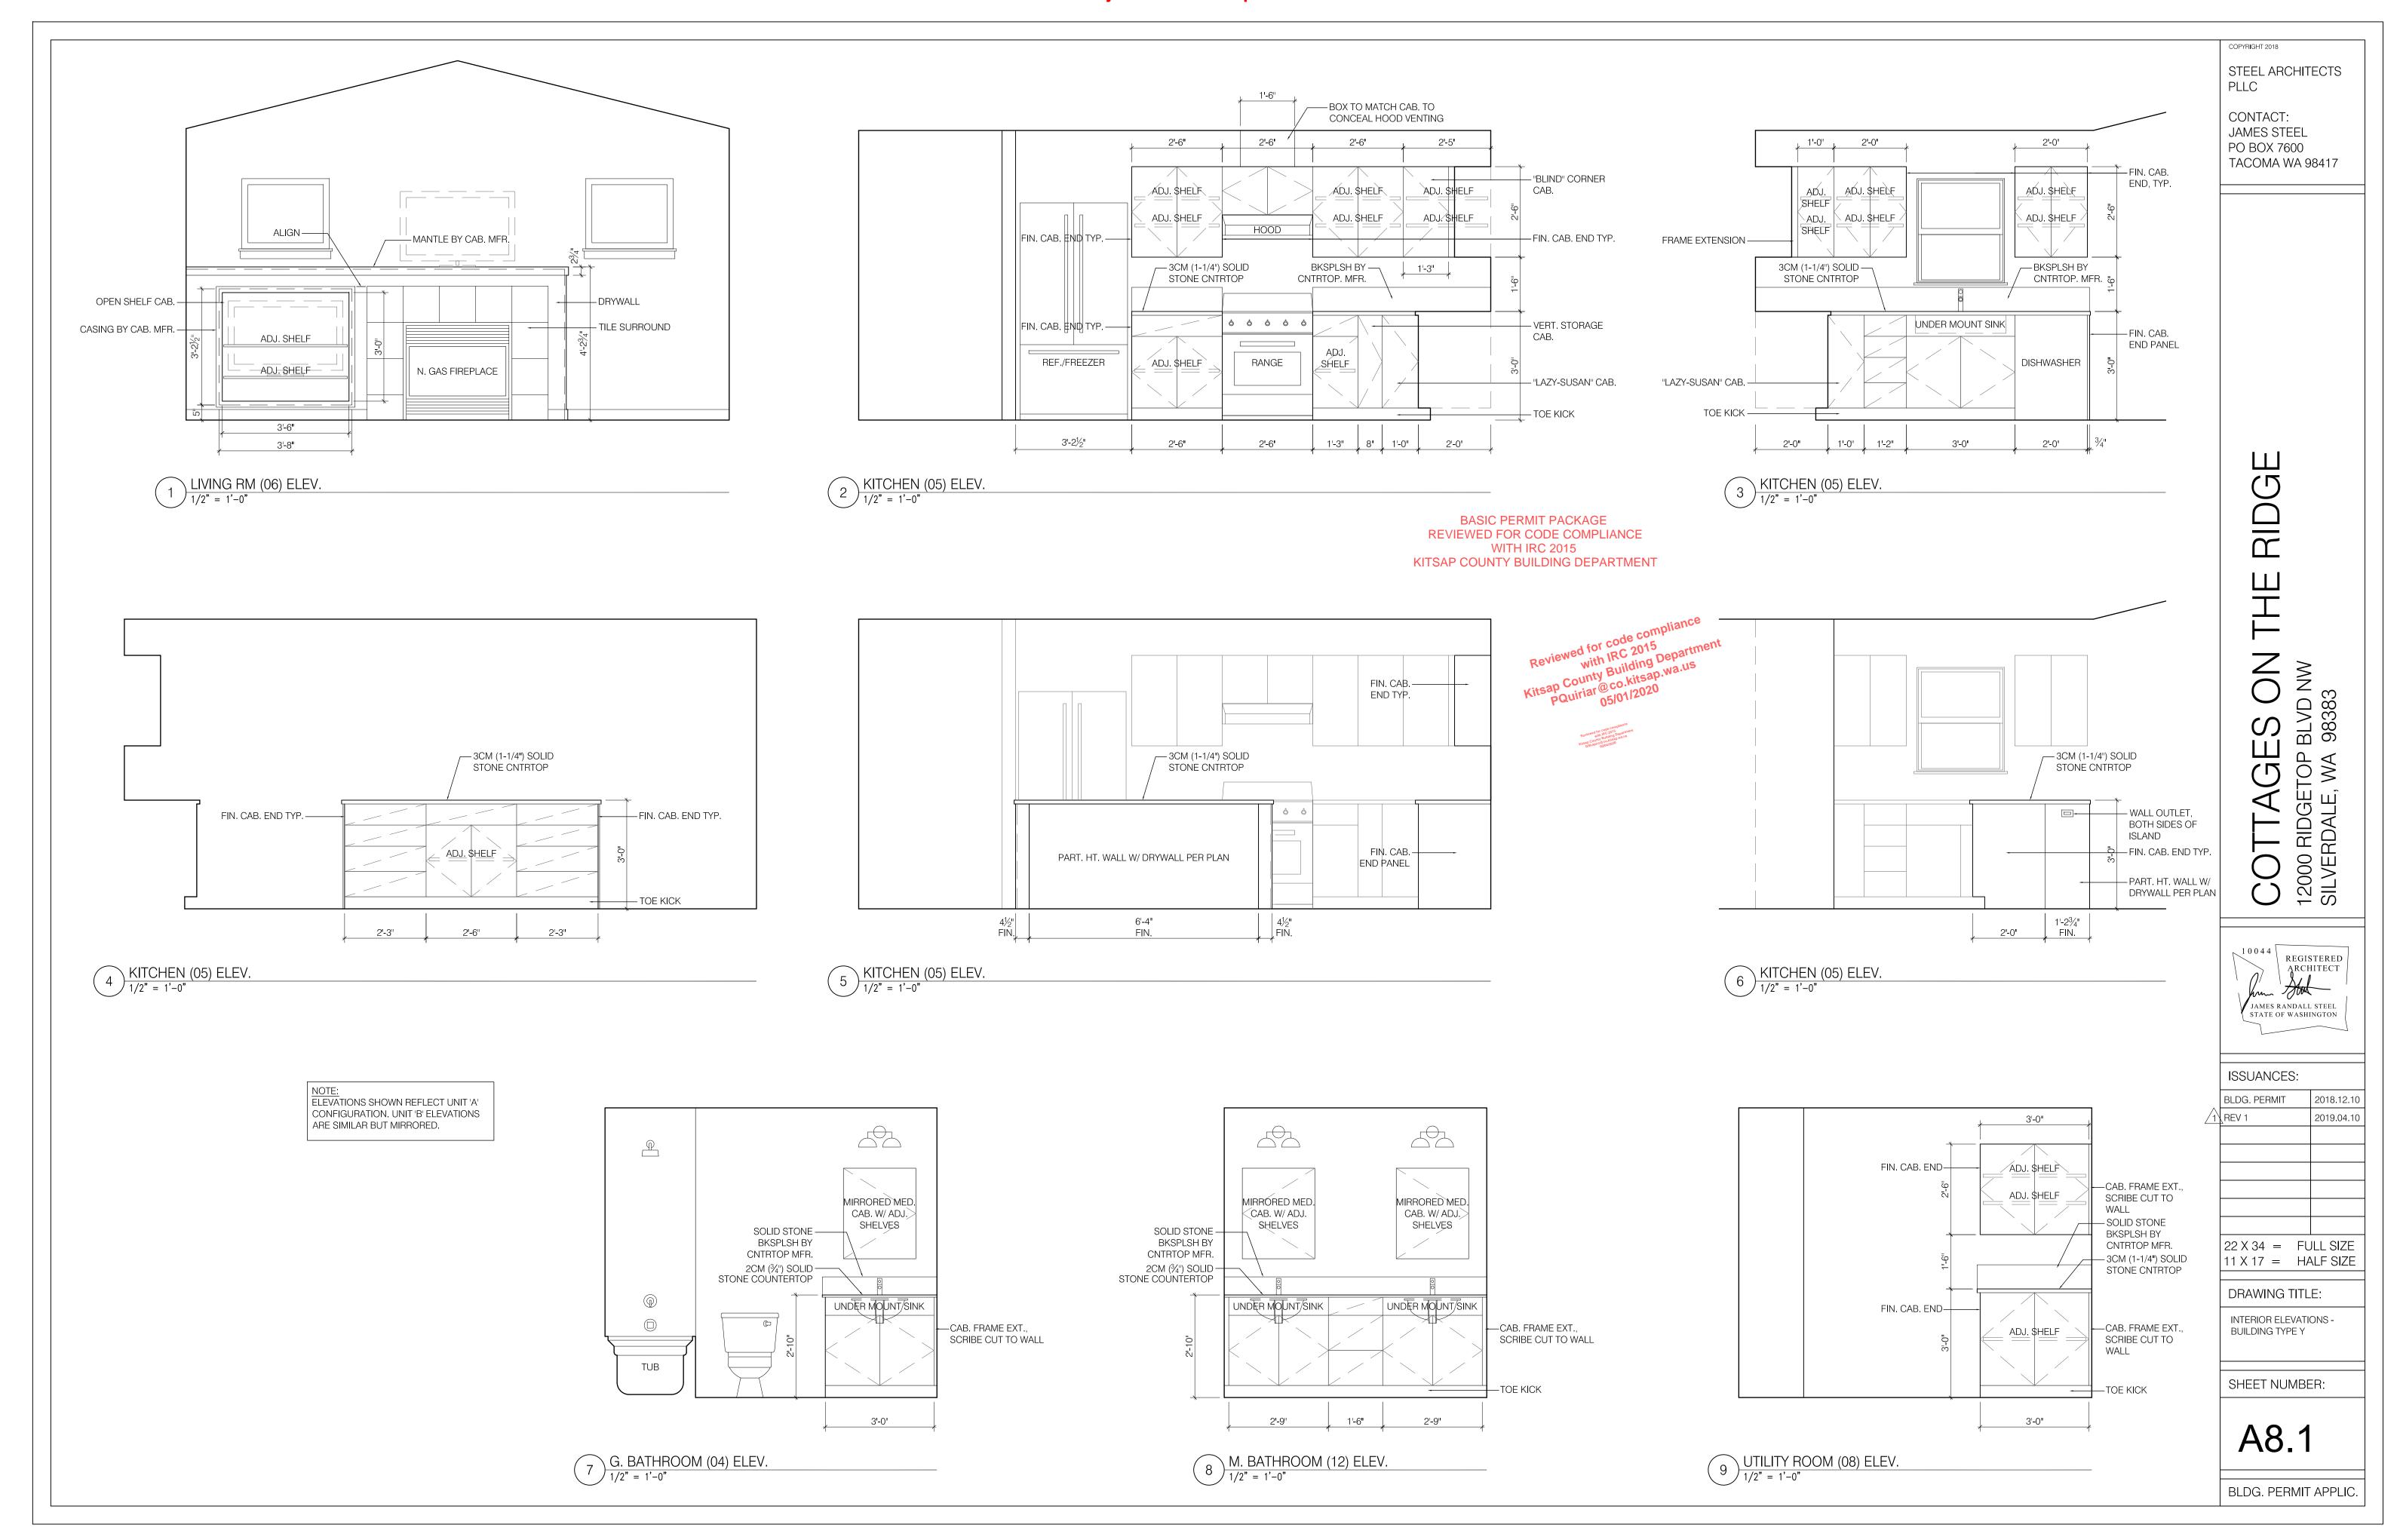

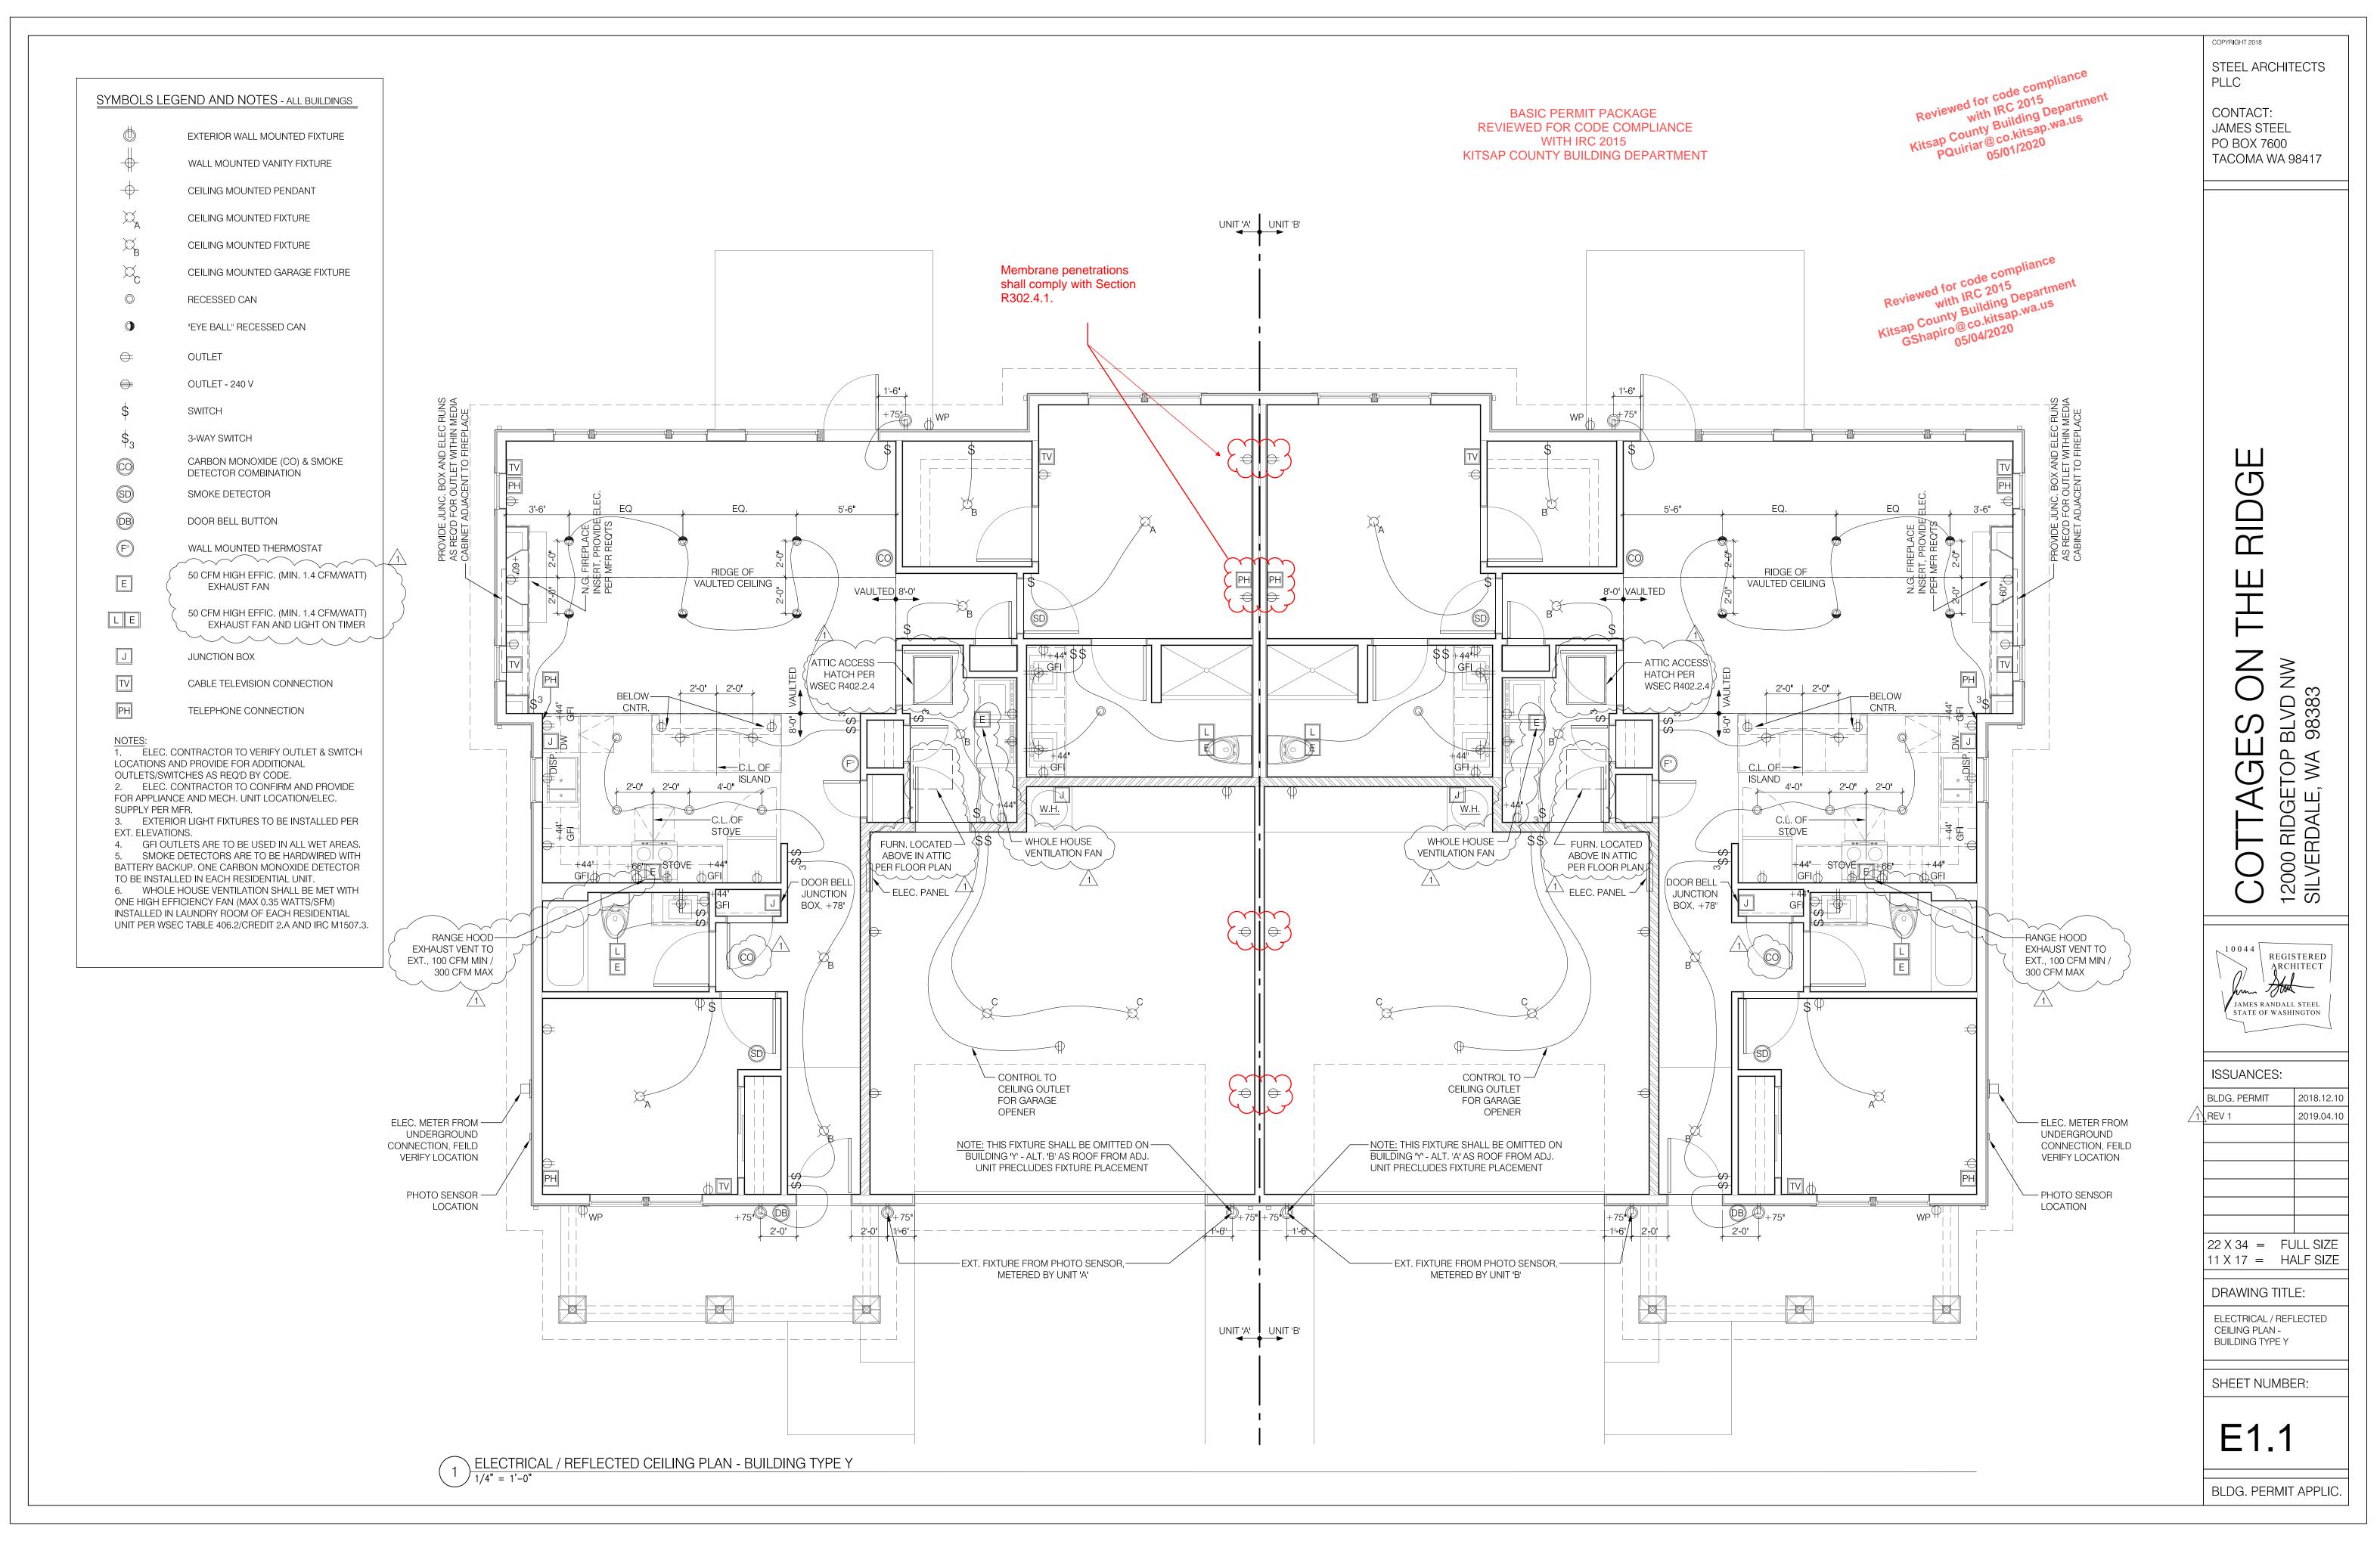

Permit Number: 20-01252