

[illegible]





Rueppell

Home Design

 ~~$[A^{-1}A]$~~

Permit Number: 20-04006



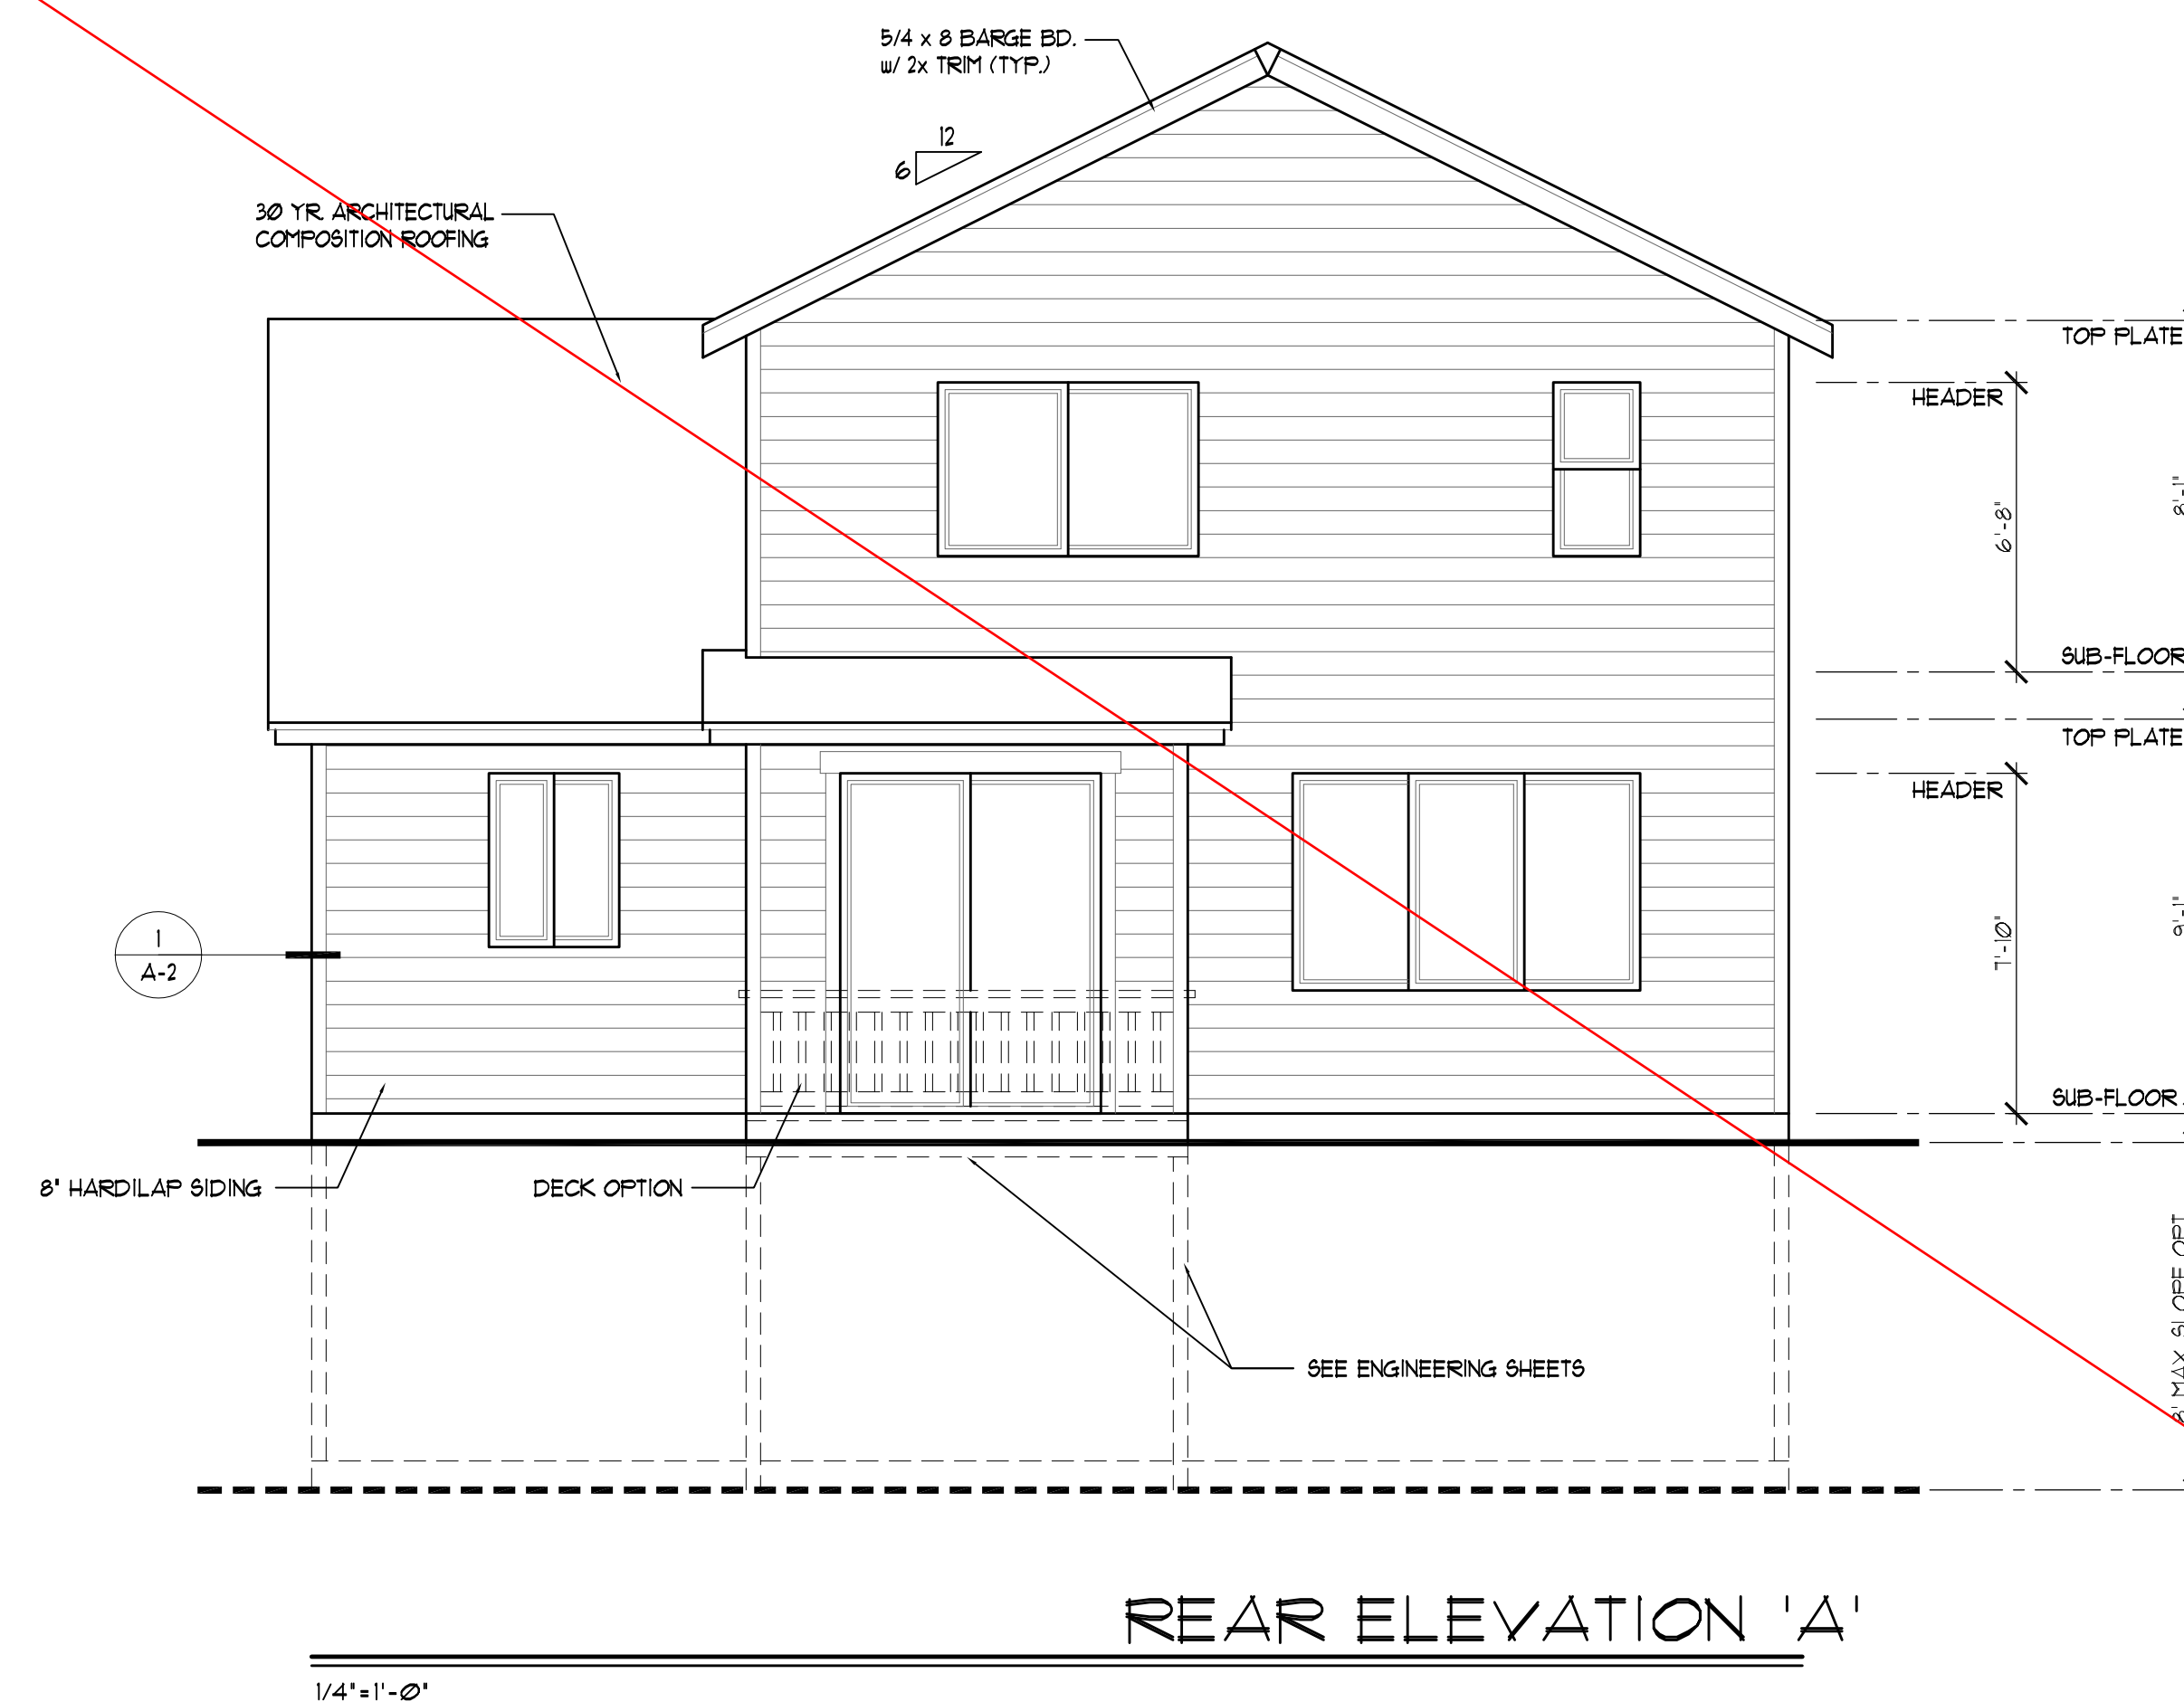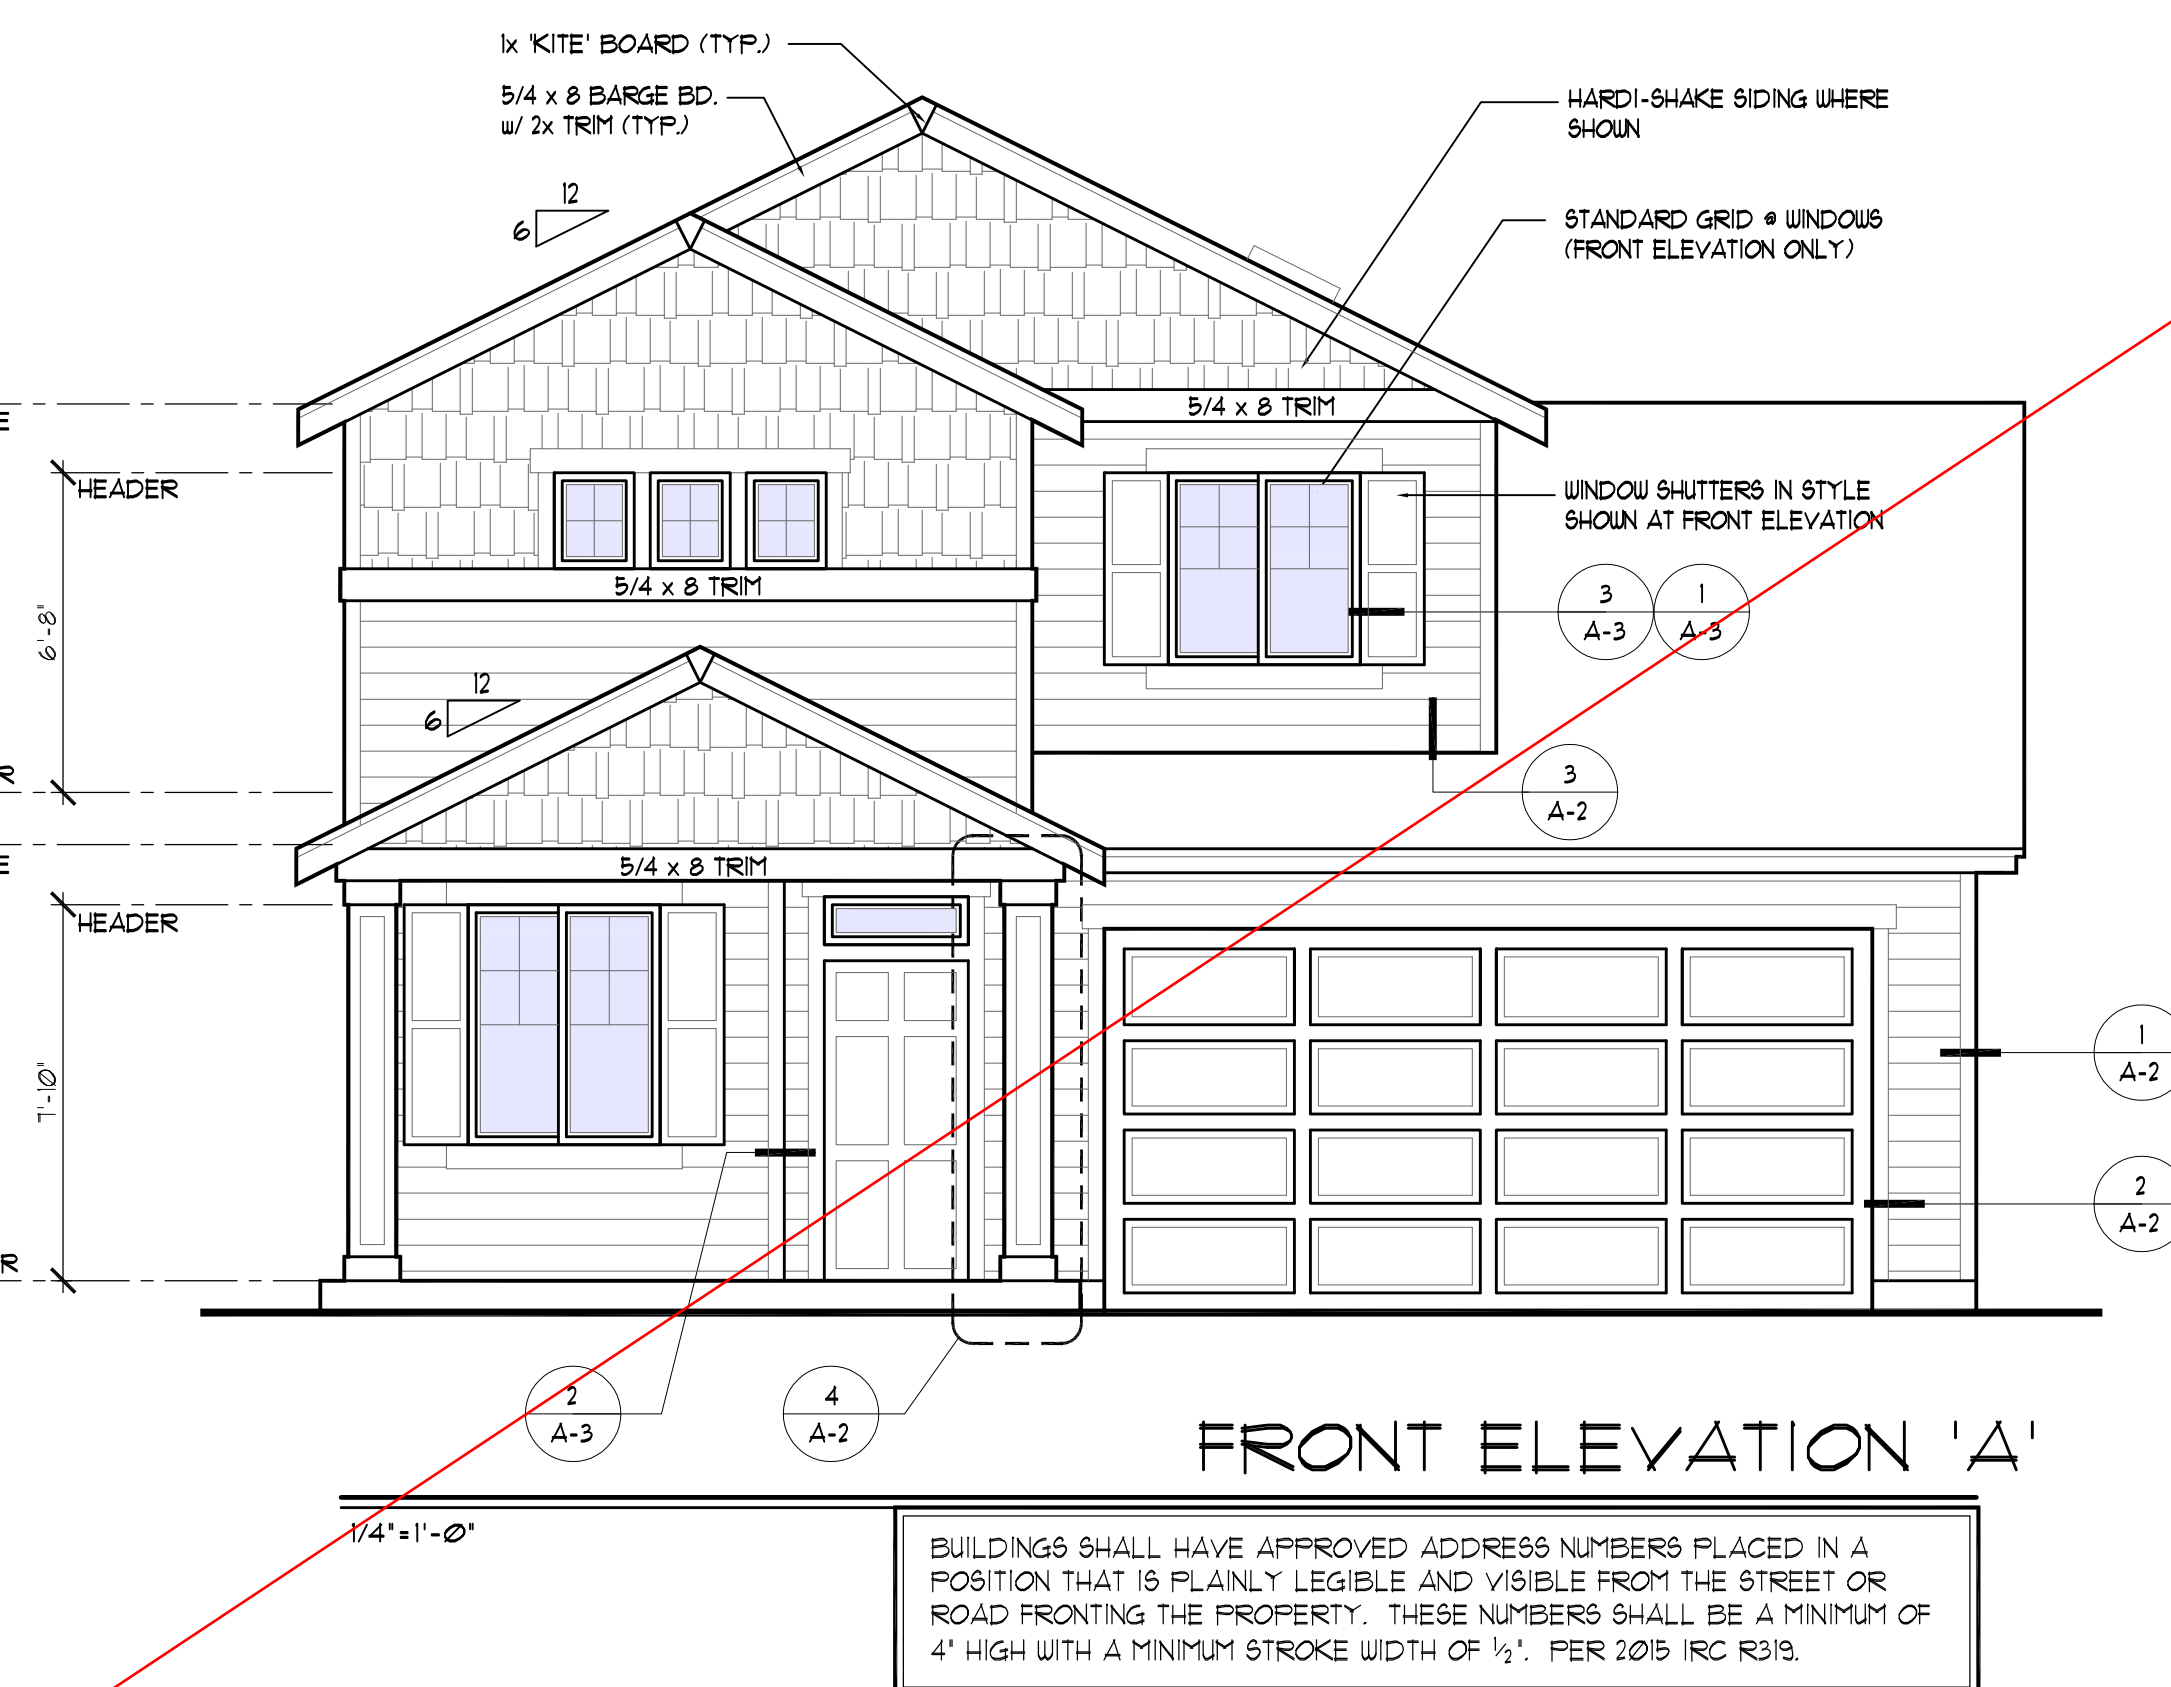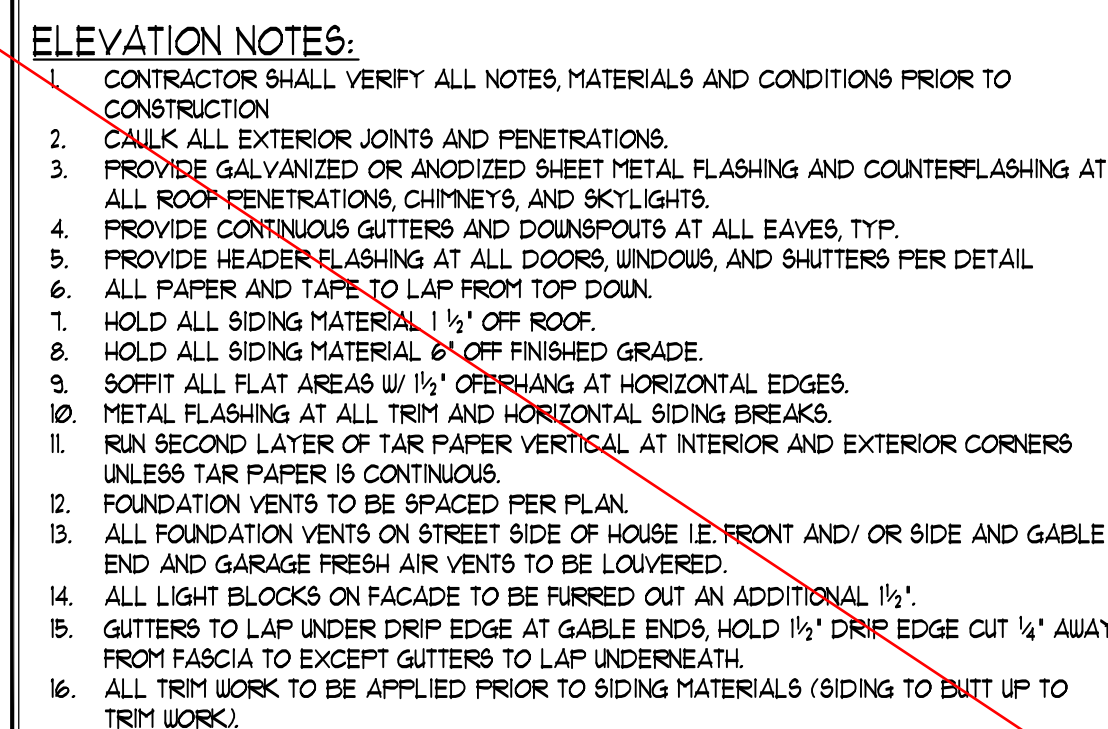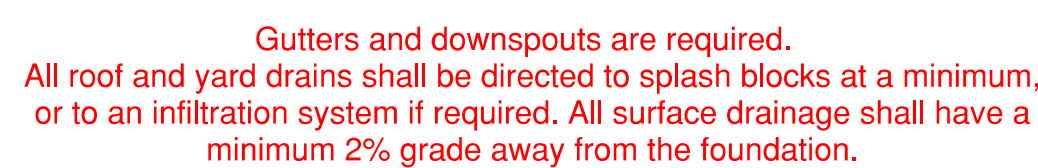

Home Design

~~[A-3A]~~

Subject To Field Inspection

Copyright © 2019, Rueppell, Inc.

העבר

[A-1B]

OPENINGS SUCH AS DOORS AND ATTIC ACCESSES SHALL BE 1-3/8" SOLID CORE DOORS, OR A 20-MINUTE RATED ASSEMBLY AND SHALL BE SELF CLOSING AND SELF LATCHING.

LOWER FLOOR PLAN 'B'

5 MIN. AIR EXCHANGE CEILING FANS PER PLAN (●)
110 VOLT SMOKE DETECTOR HARD WIRED (S)
INTERCONNECTED WITH BATTERY BACK-UP (C)
CARBON MONOXIDE DETECTOR (T)
TEMPERED/SAFETY GLASS (*)
PROVIDE 1' UNDERCUT ON ALL BEDROOM DOORS

DECK OPTION
10'-0"

FAMILY
13'-0" x 13'-8"

DINING
9'-0" x 14'-6"

KITCHEN
10'-2" x 13'-6"

FOYER
4'-10" x 14'-0"

DEN
8'-7" x 9'-8"

GARAGE
19'-2" x 20'-2"

COVD PORCH
14'-0" x 4'-4"

Notes:

- Manufacturer's installation instructions and specs shall be on site at time of inspection
- Range hood exhaust cannot exceed 400 CFM or additional measures must be taken per IRC
- PROVIDE STAIRWAY ILLUMINATION PER SECTION R302.3.1 IRC
- PROVIDE 1 3/8" SOLID CORE DOOR OR 20 MIN. FIRE DOOR WITH SELF-CLOSING DEVICE.
- 1/2" TYPE 'X' GYP. BD. @ CLG. 1/2" GLB. @ ALL WALLS. DUCTS THROUGH WALL OR CEILING COMMON TO HOUSE MIN. 26 GA. STEEL. NO DUCT OPENINGS IN GARAGE.


MAIN FLOOR PLAN 'B'

5 MIN. AIR EXCHANGE CEILING FANS PER PLAN (C)
110 VOLT SMOKE DETECTOR HARD WIRED (S)
INTERCONNECTED WITH BATTERY BACK-UP (C)
CARBON MONOXIDE DETECTOR (T)
TEMPERED/SAFETY GLASS (*)
PROVIDE 1' UNDERCUT ON ALL BEDROOM DOORS



Home Design

Plan: 1572 AB
Job#: Kitsap Base Plan
Date: 04/08/20
Revision Date:
Drawn by:
Phone: (253) 297-8040

[A-2B]

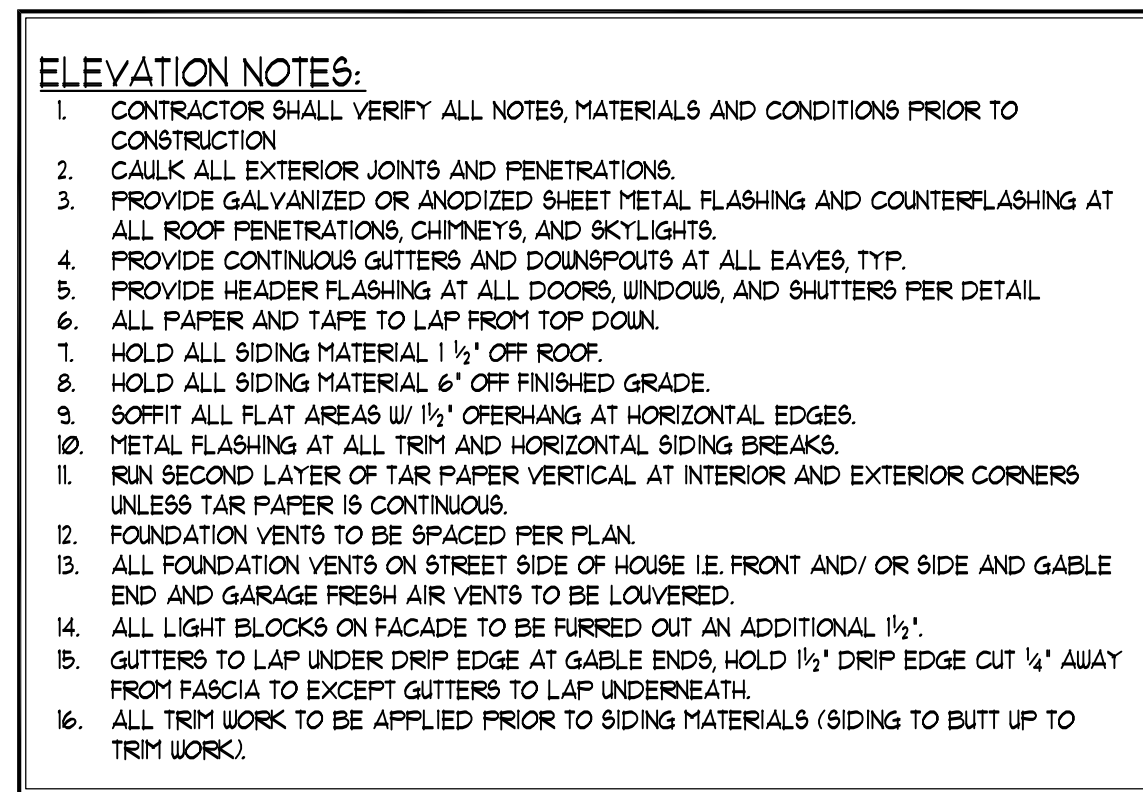


**CHANGES
MUST Be Approved Prior
To Performing Work**

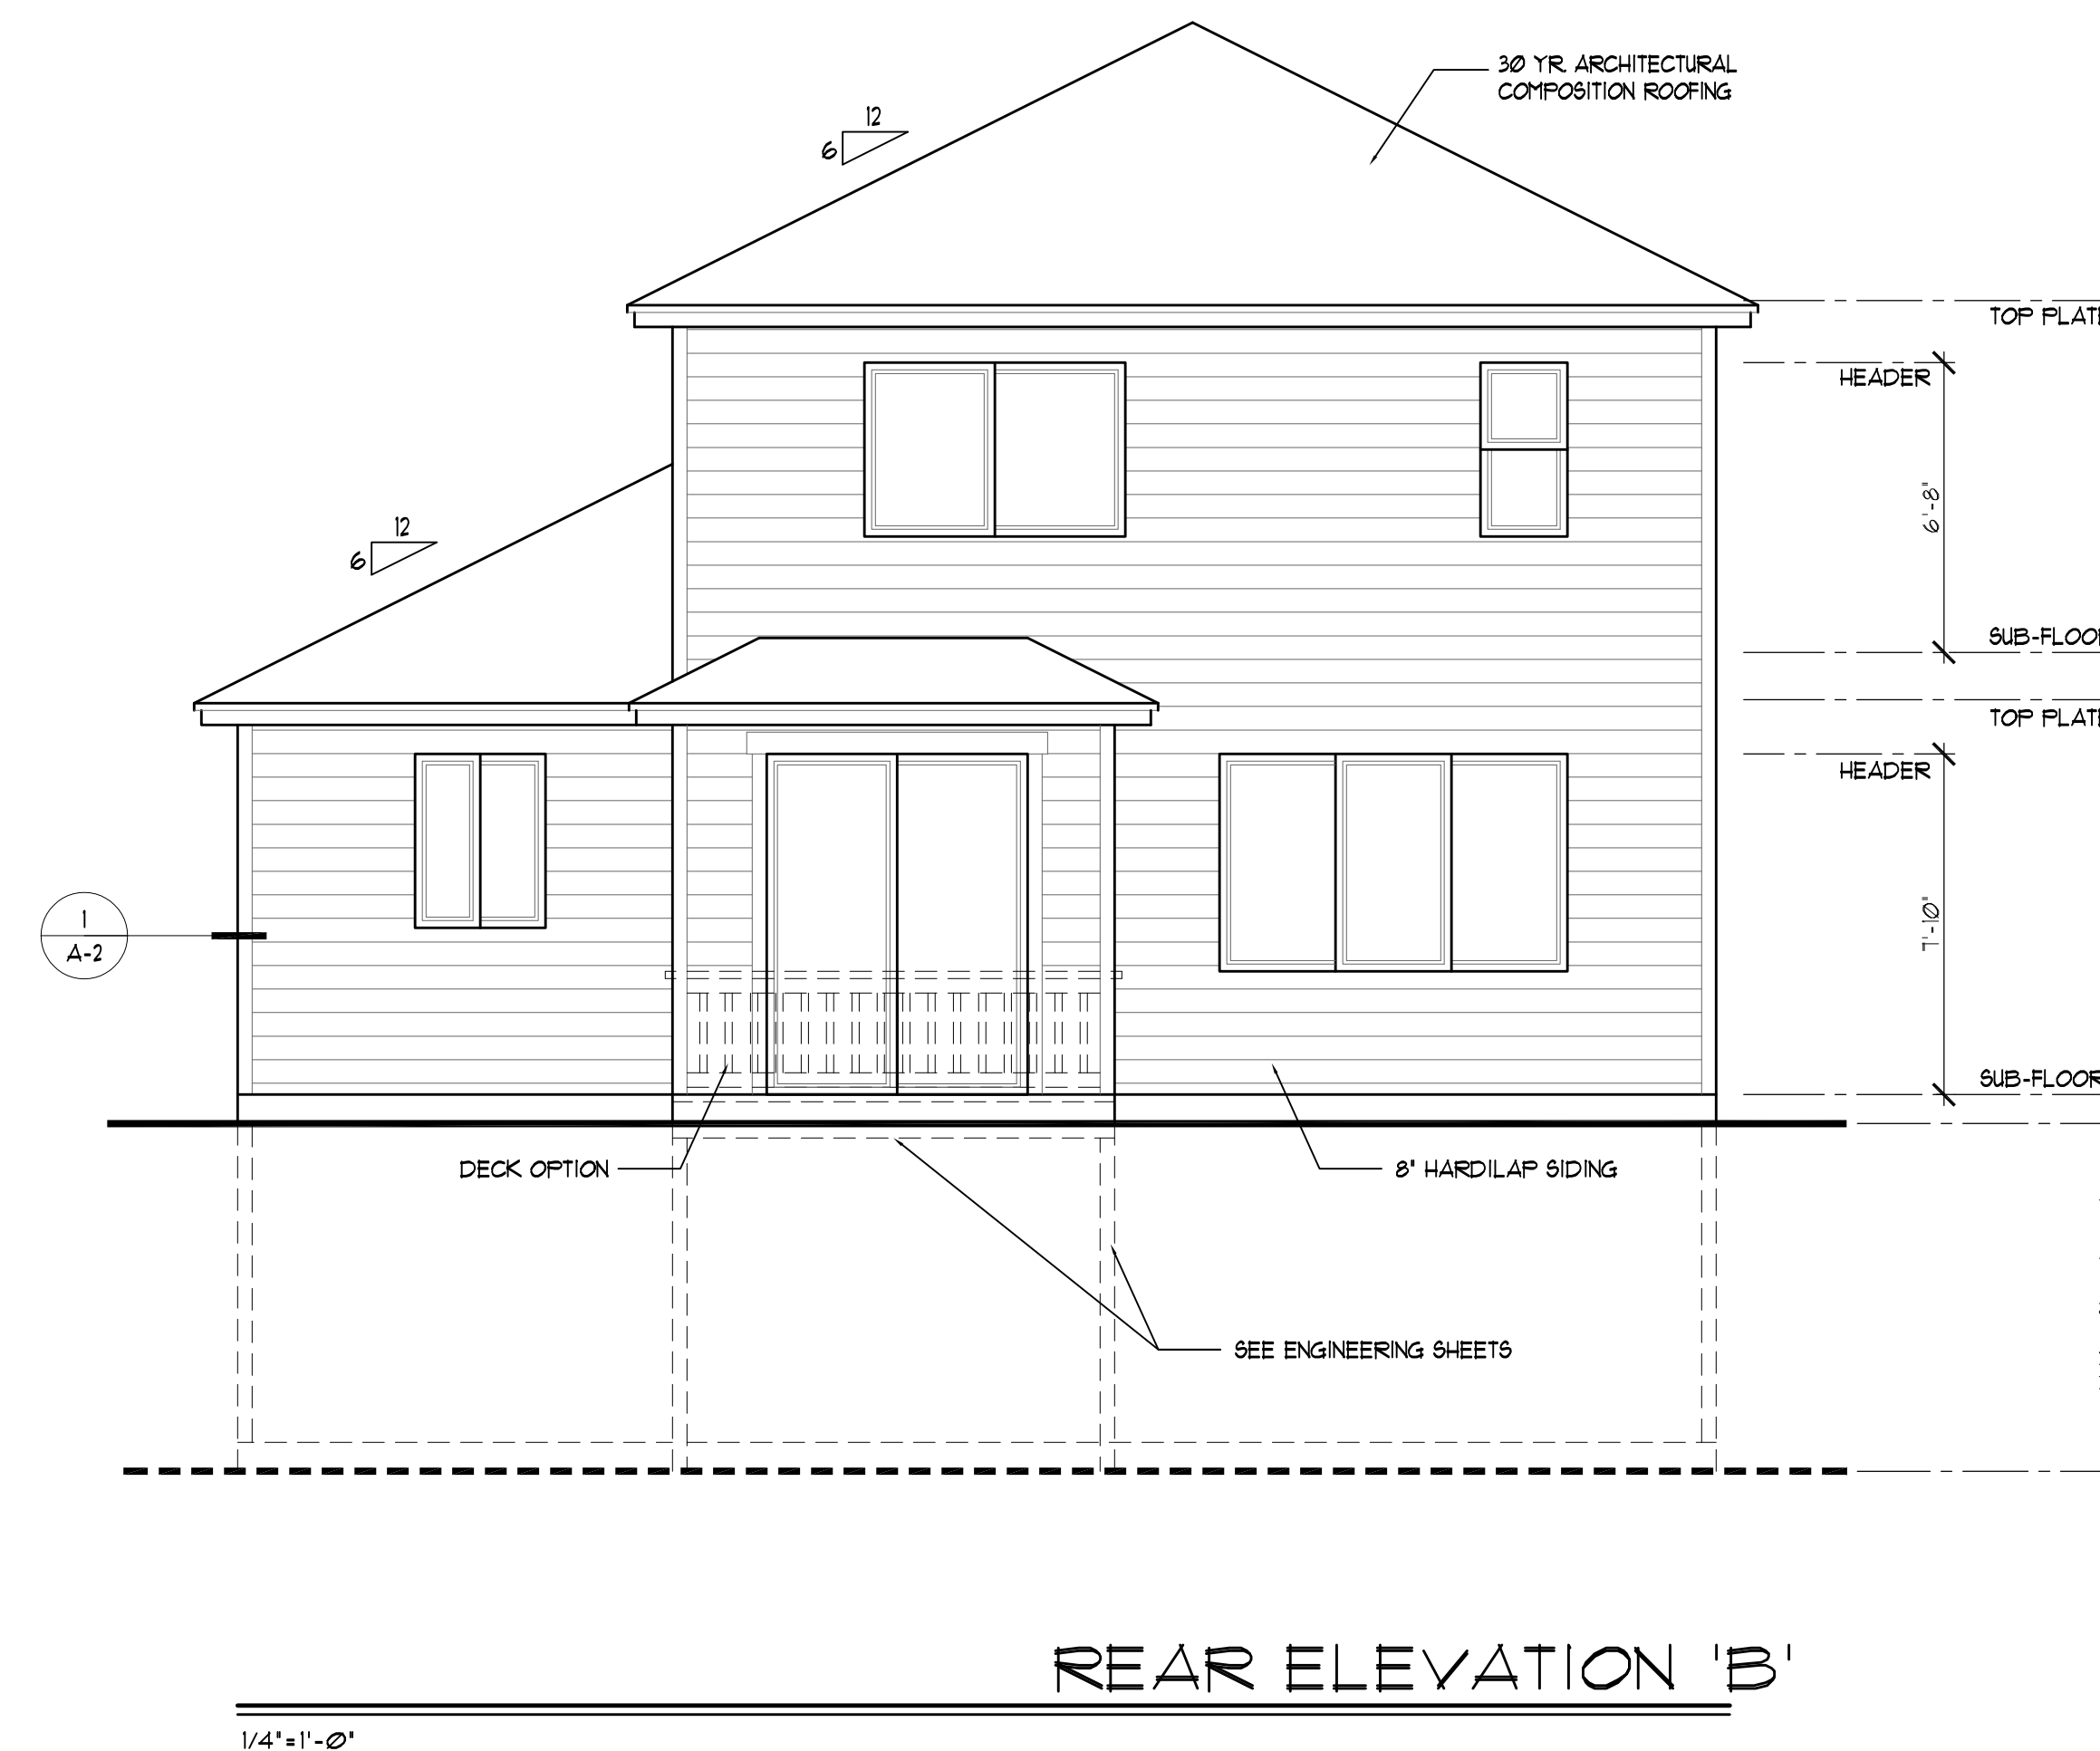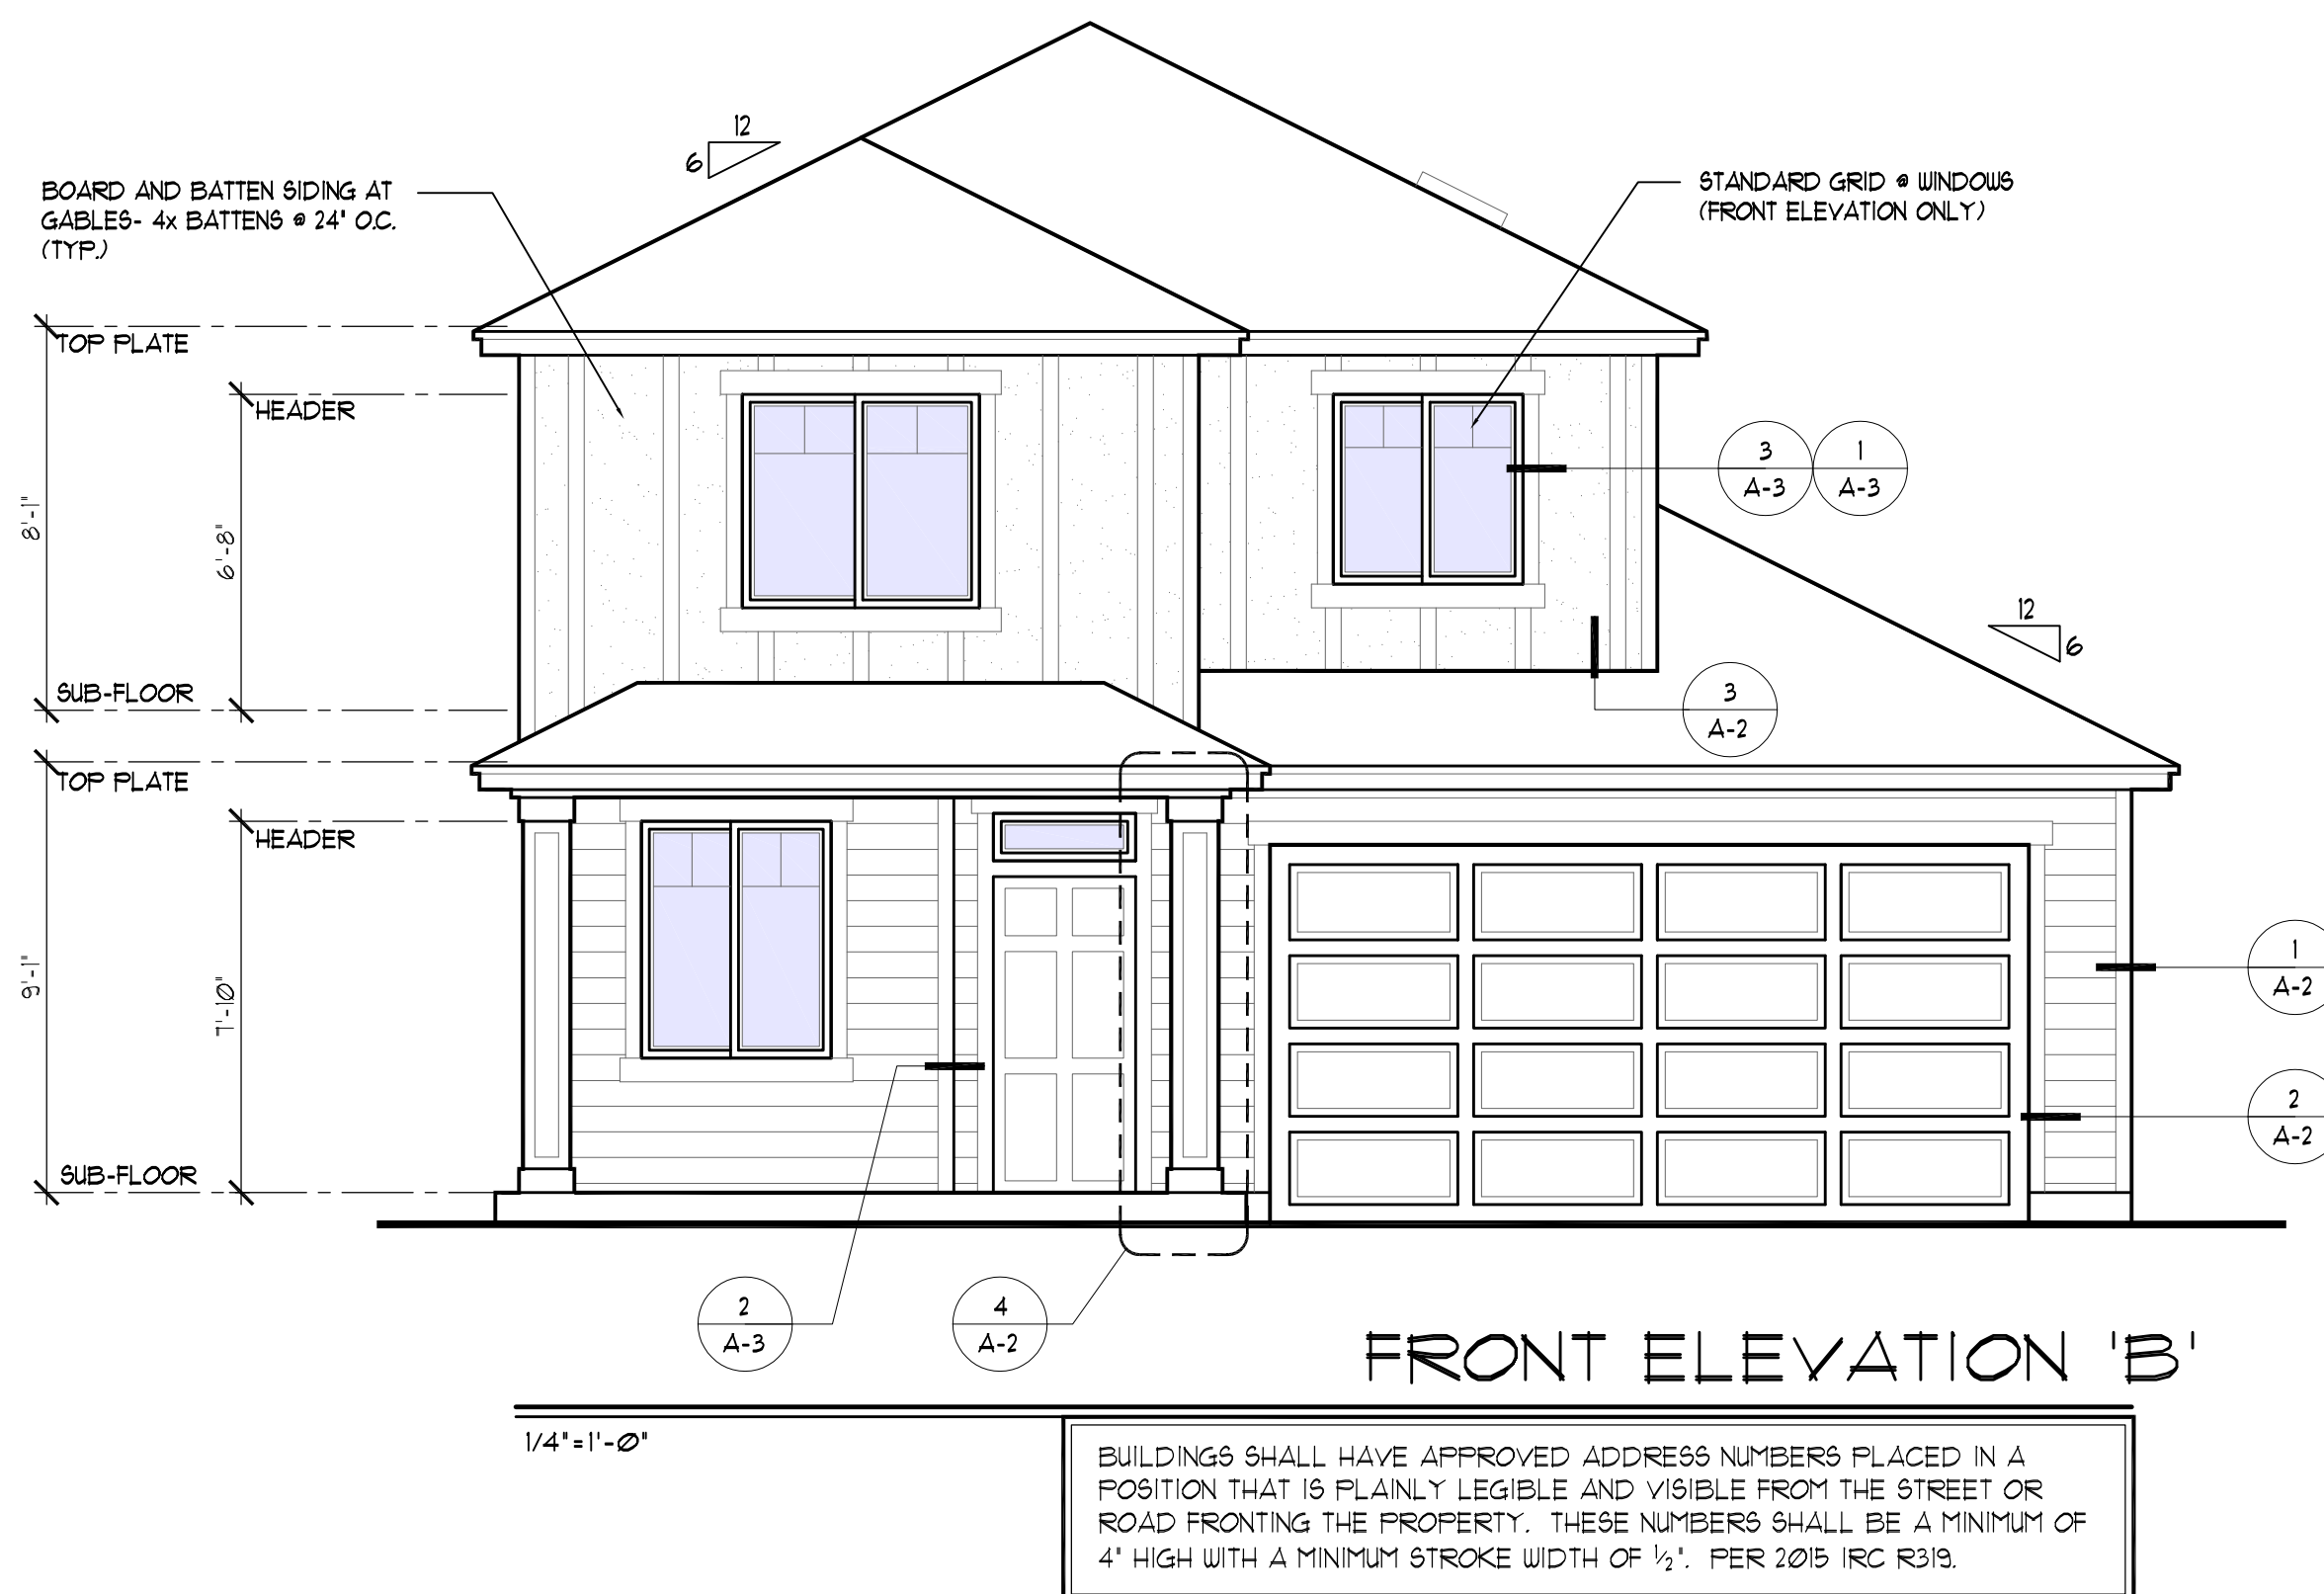

Copyright © 2019, Rueppell, Inc.

Rueppell
Home Design


[A-3B]

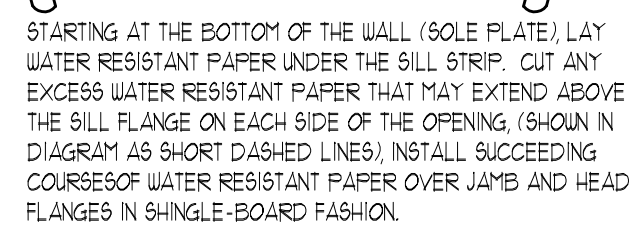


Reviewed for code compliance
with IRC 2015
Kitsap County Building Department
lasmith@co.kitsap.wa.us
10/02/2020

A diagram of a rectangular frame. The top horizontal bar is labeled 1×6 . The bottom horizontal bar is also labeled 1×6 . The left vertical bar is labeled 1×4 . The right vertical bar is also labeled 1×4 .

NOTE: ALL FRONT EXTERIOR TRIM FIN.
ARE TO BE MDO (MEDIUM DENSITY OVERLAY).

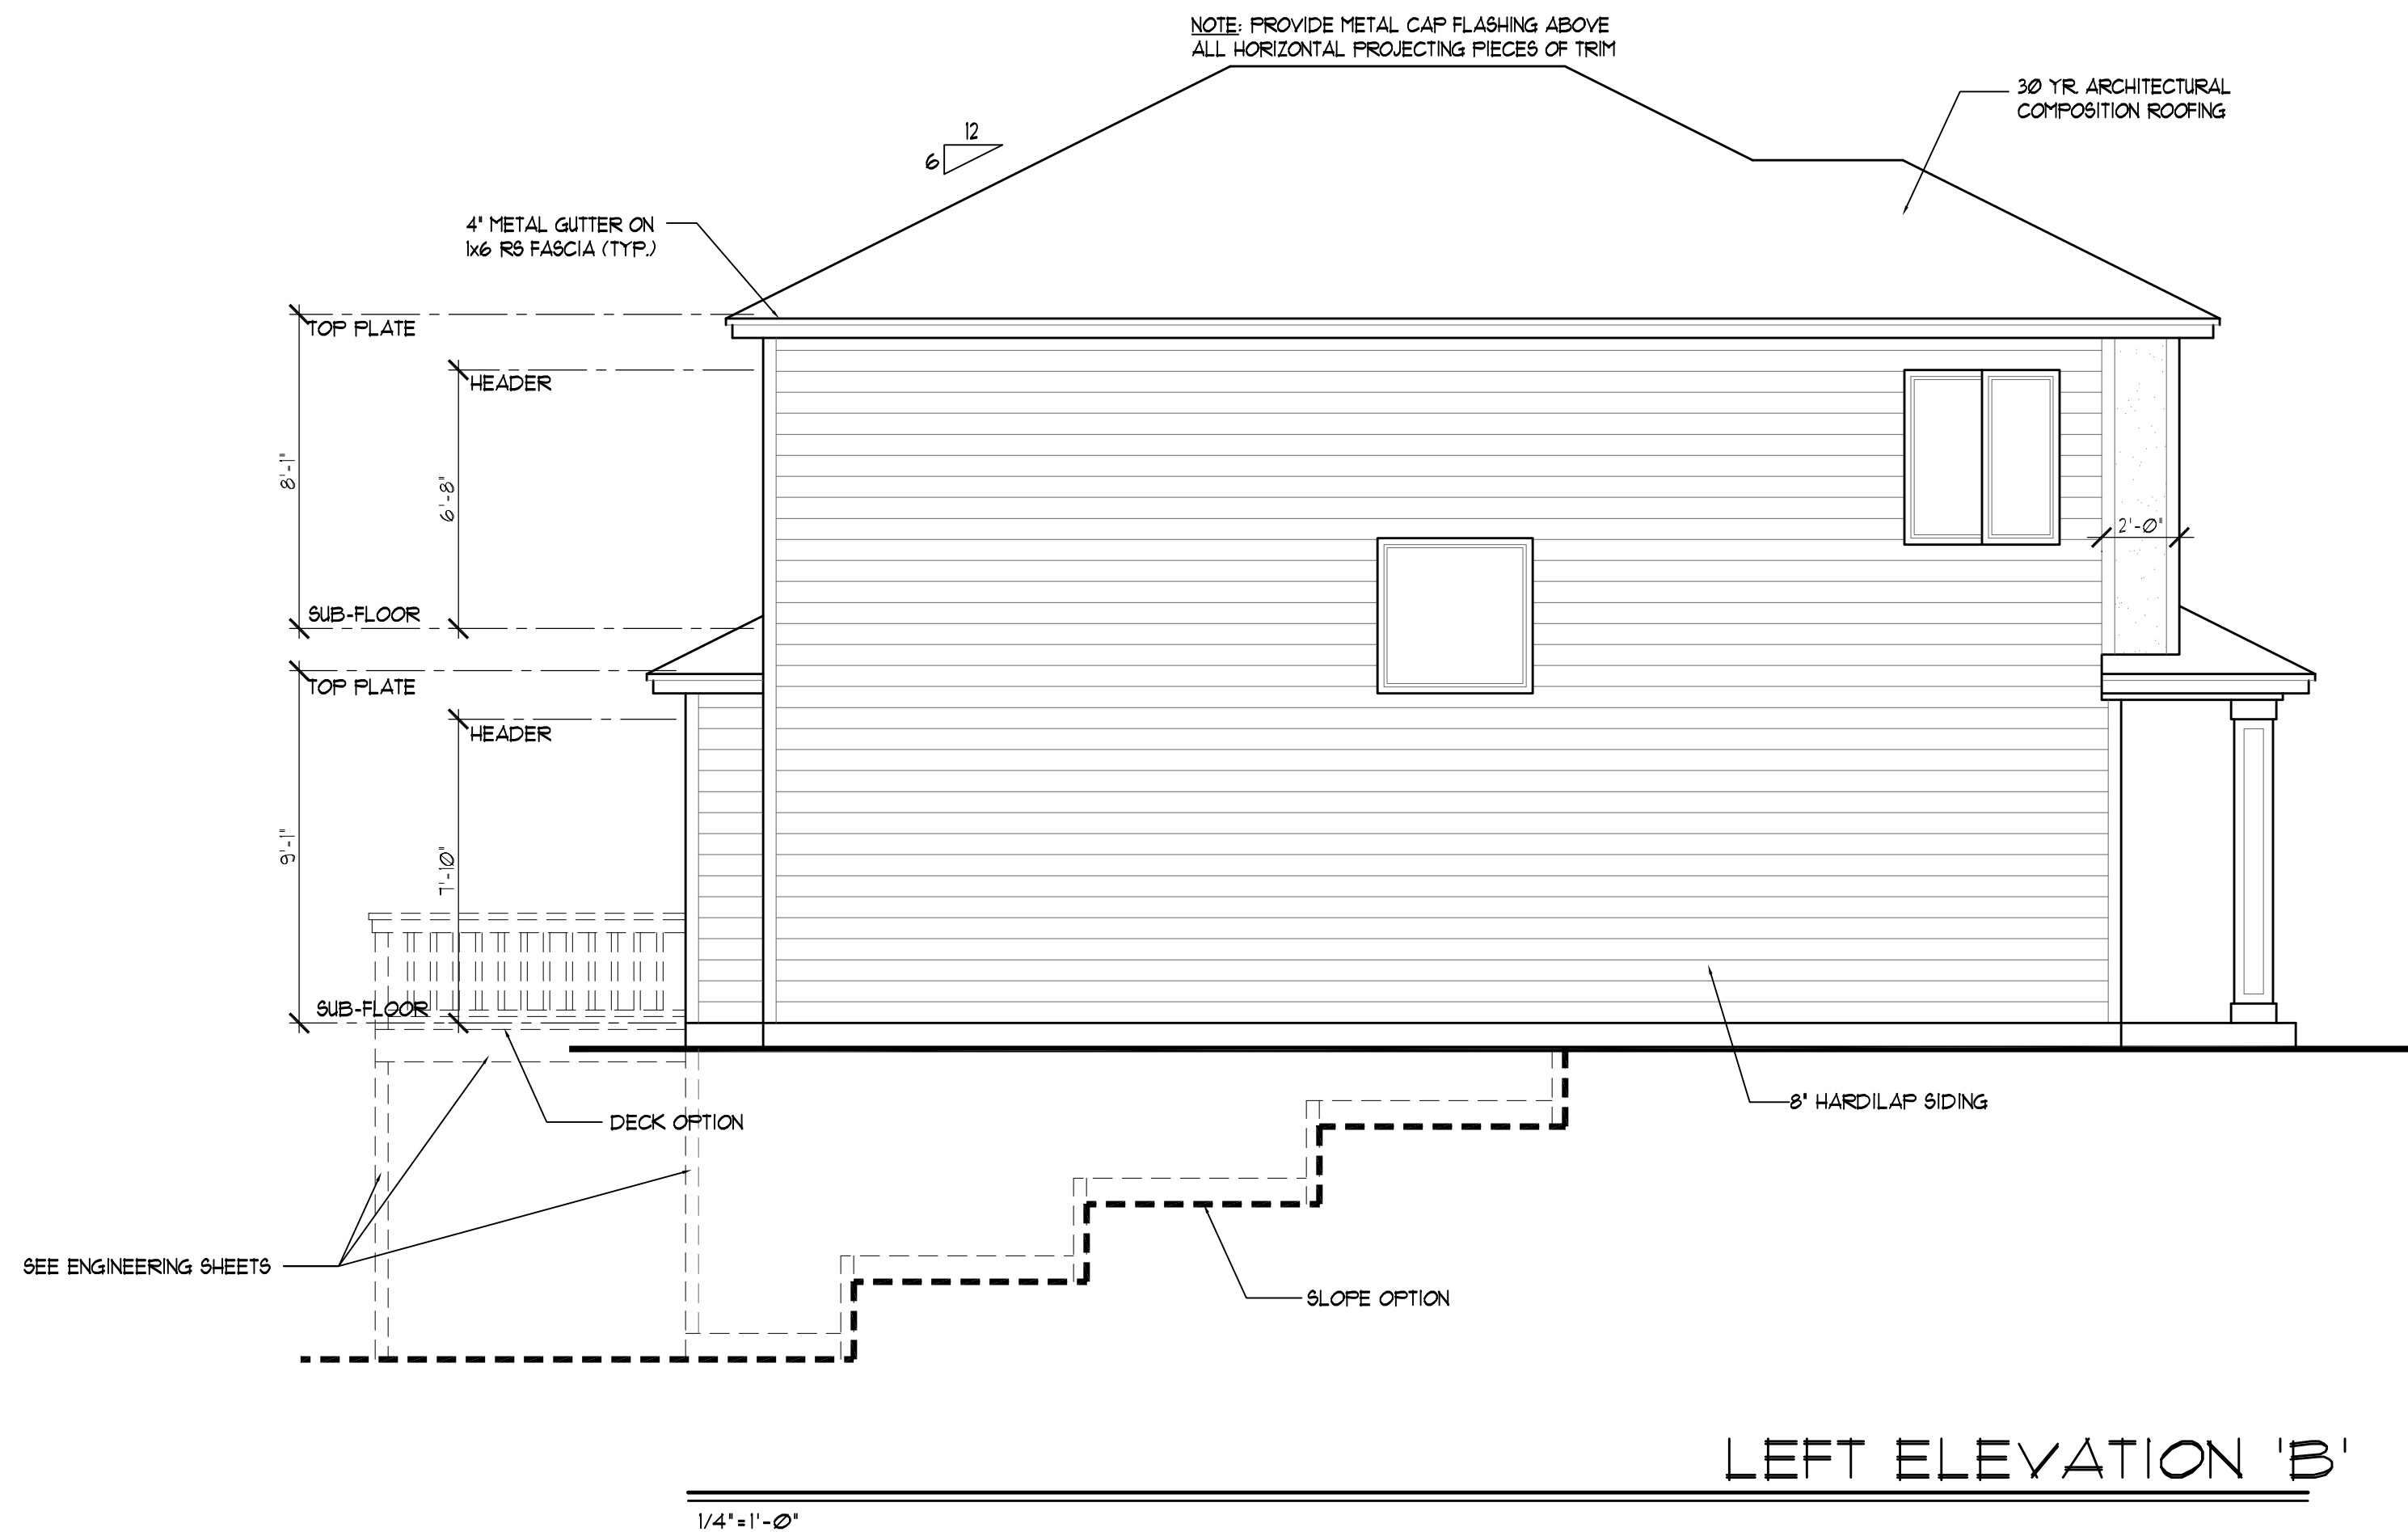

LEFT ELEVATION 'B'

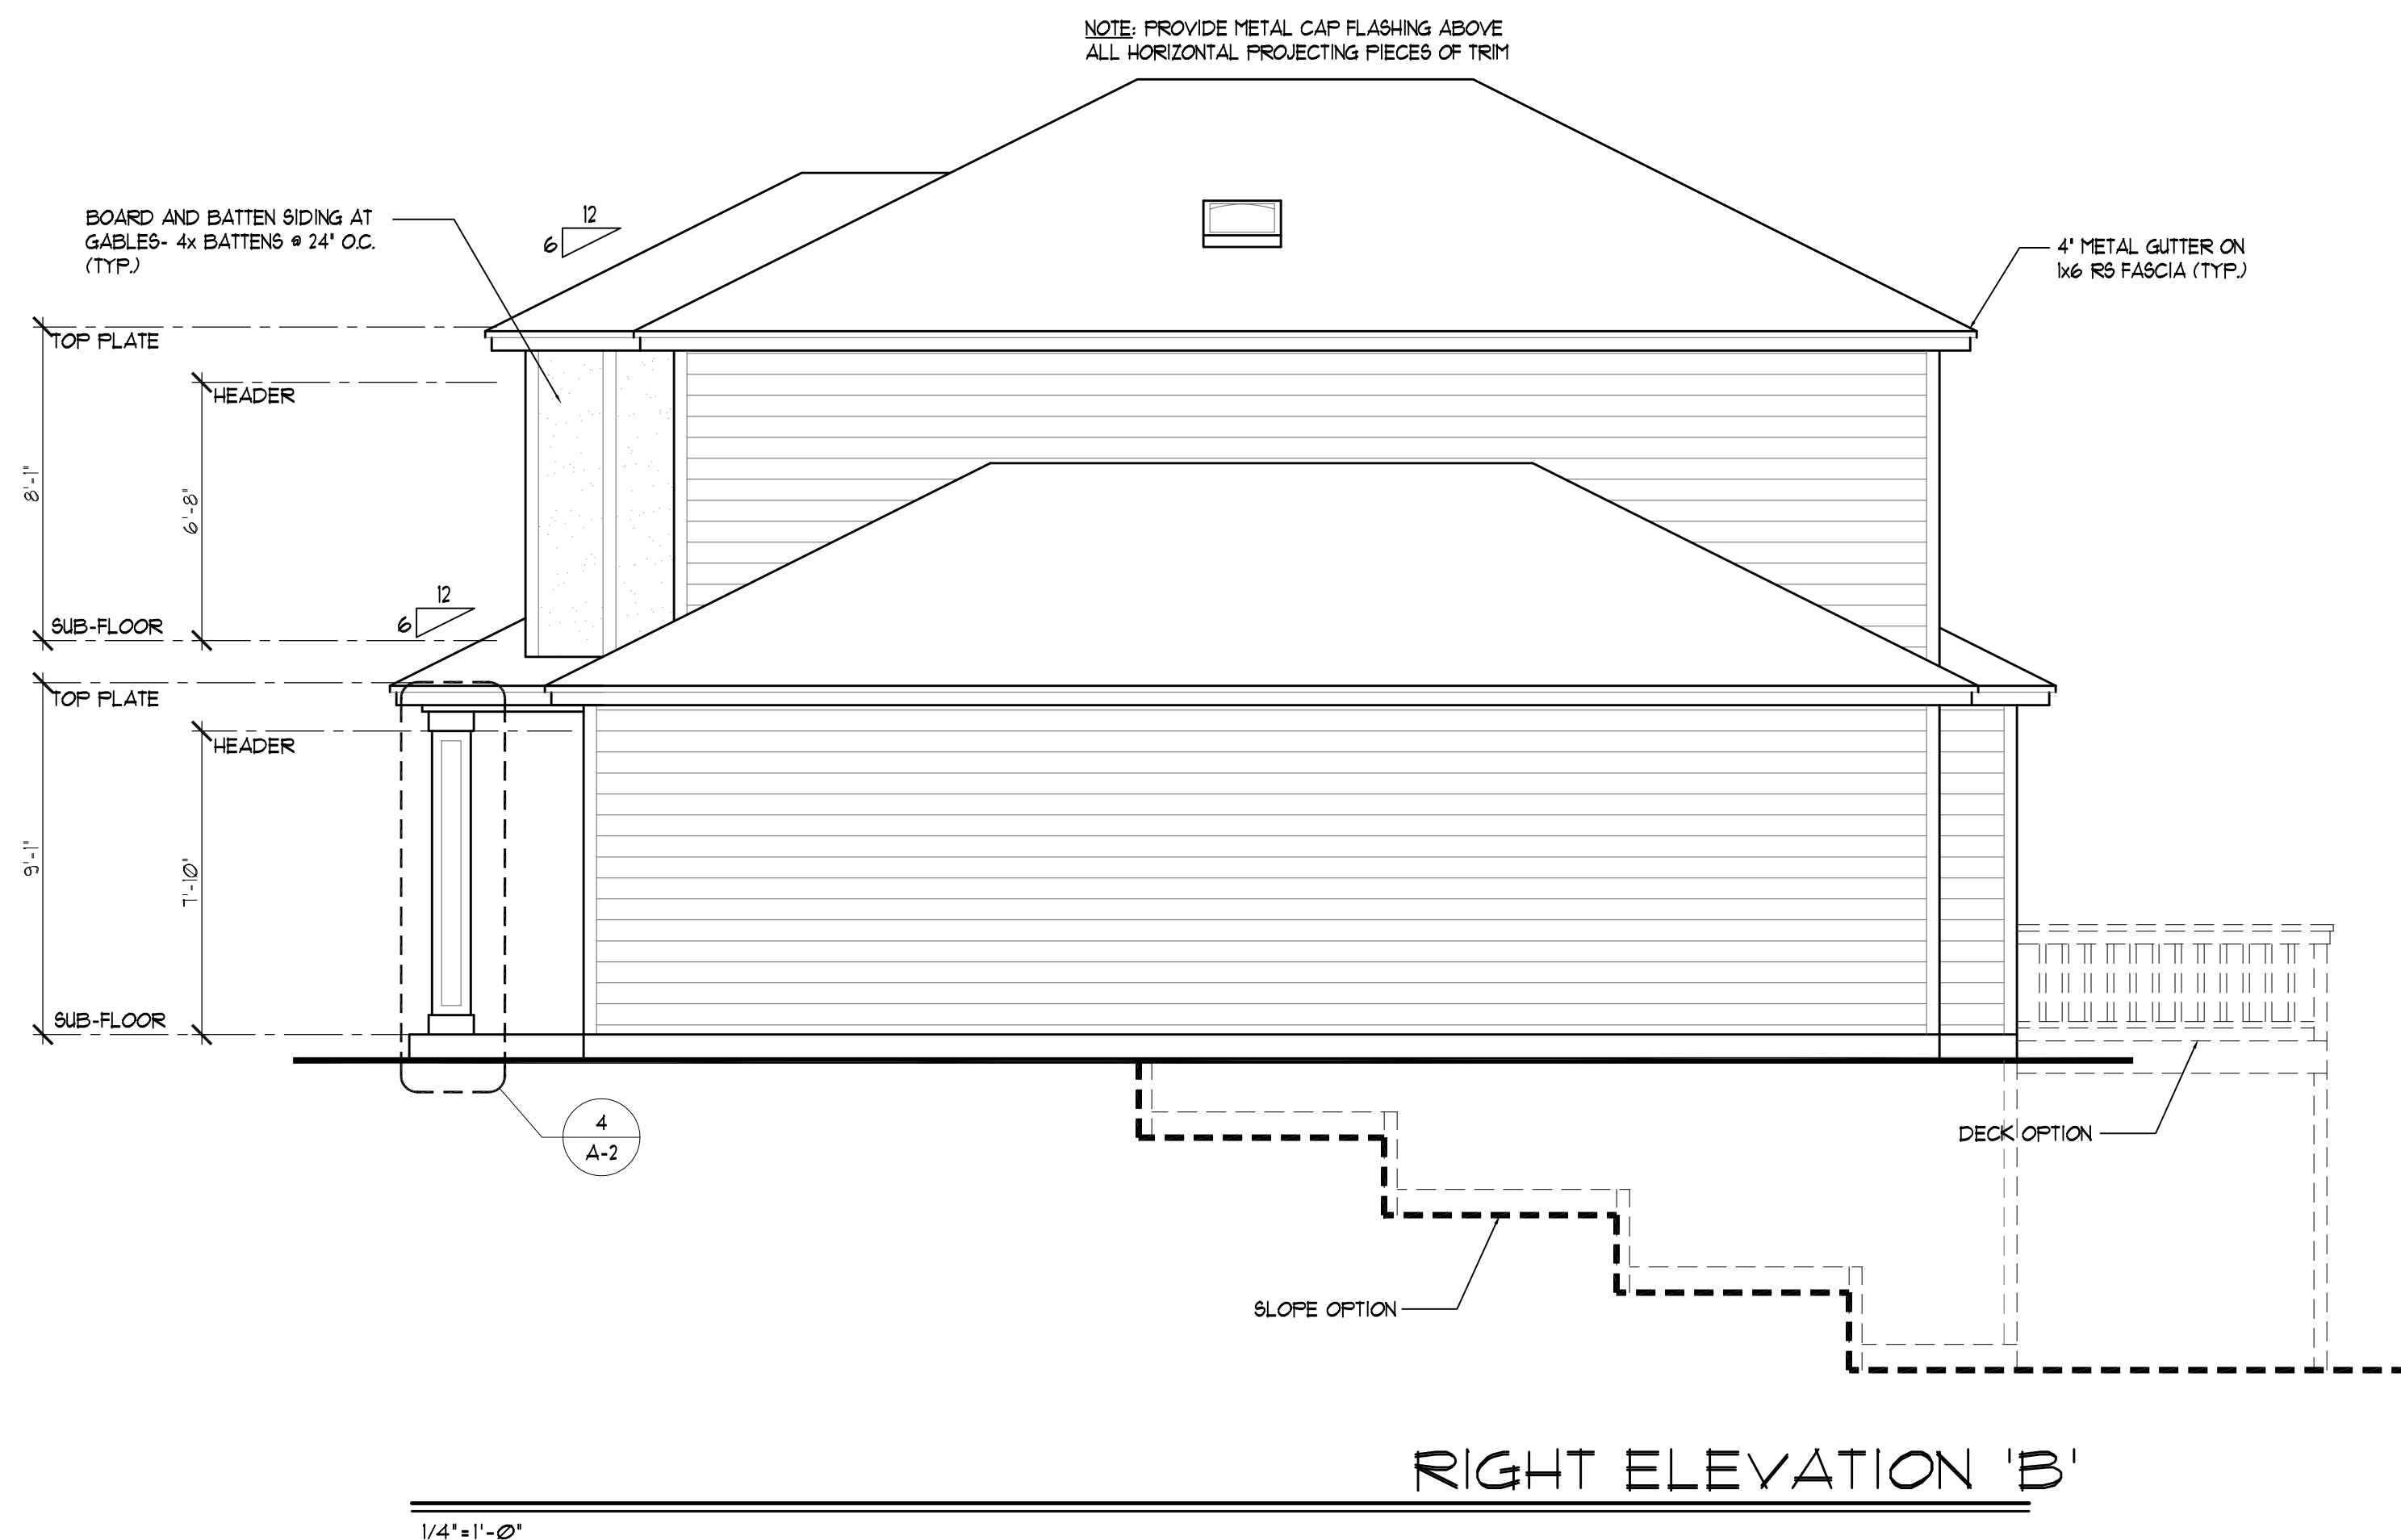


RIGHT ELEVATION 'B'


STAIR AND GUARDRAIL NOTES:

ILLUMINATION NOTES: PER IRC SECTION 303.6, R310.1 ALL INTERIOR AND EXTERIOR STAIRWAYS SHALL BE PROVIDED WITH A MEANS TO ILLUMINATE THE STAIR INCLUDING LANDINGS & TREADS. INTERIOR STAIRWAYS SHALL BE PROVIDED WITH AN ARTIFICIAL LIGHT SOURCE LOCATED IN THE IMMEDIATE VICINITY OF THE LANDING OF THE STAIRWAYS. EXTERIOR STAIRWAYS SHALL BE PROVIDED WITH A LIGHT SOURCE LOCATED IN THE IMMEDIATE VICINITY OF THE TOP OF THE LANDING OF THE STAIRWAY. LIGHTING CONTROLS SHALL BE ACCESSIBLE AT THE TOP & BOTTOM OF EACH STAIRWAY WITHOUT TRAVERSING ANY STEPS.


4" OR MORE RISERS TO HAVE AT LEAST ONE HANDRAIL RUNNING CONT. THRU FULL LENGTH OF STAIR. 34" MIN. HT. 38" MAX. HT. END SHALL RETURN TO WALL OR NEEL POST OR VOLUTE. HANDRAIL MUST BE STRONG ENOUGH TO RESIST A 200 LB. FT. LOAD IN ANY DIRECTION. HANDRAIL TO BE PRESENT ON AT LEAST ONE SIDE OF STAIR. HANDGRIP PORTION OF HANDRAILS SHALL HAVE A CIRCULAR CROSS SECTION OF 1 1/4" MIN. & 2 3/4" MAX. EDGES SHALL HAVE A MIN. RADIUS OF 1/8". ALL REQ. GUARDRAILS TO BE 36" MIN. IN HEIGHT. HANDRAILS WITH A CIRCULAR CROSS SECTION SHALL HAVE AN OUTSIDE DIAMETER OF AT LEAST 1 1/4 INCHES (32 MM) AND NOT GREATER THAN 2 INCHES (51 MM). IF THE HANDRAIL IS NOT CIRCULAR IT SHALL HAVE A PERIMETER DIMENSION OF AT LEAST 4 INCHES (102 MM) AND NOT GREATER THAN 6 1/4 INCHES (160 MM) WITH A MAXIMUM CROSS SECTION OF 2 1/4 INCHES (57 MM).

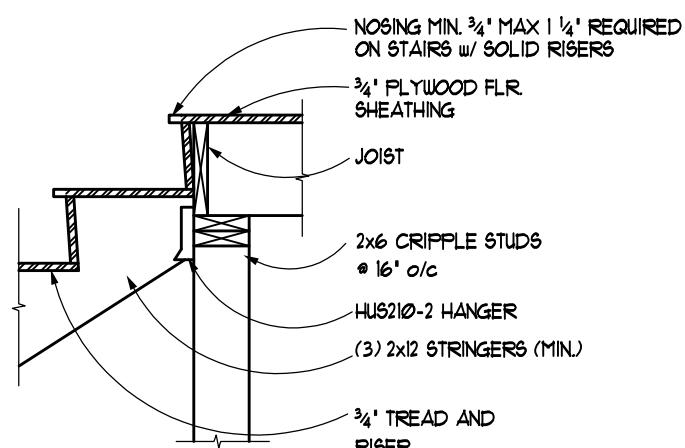


STAIR AT FLOOR CONNECTIONS

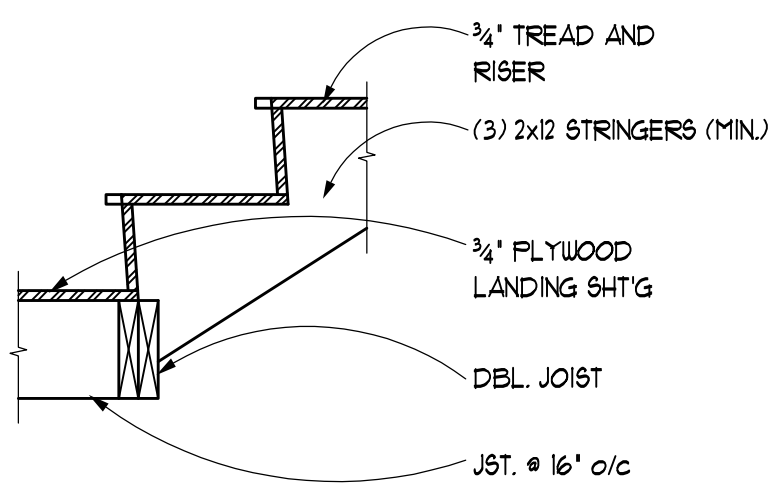


STAIR AT LANDING CONN.

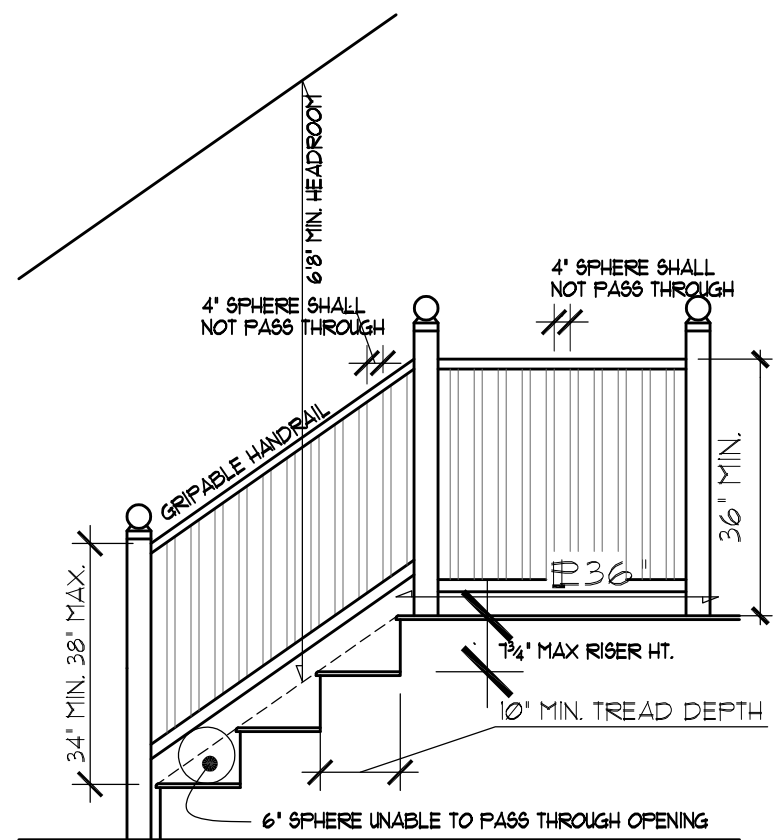

GUARD & STAIR REQUIREMENTS

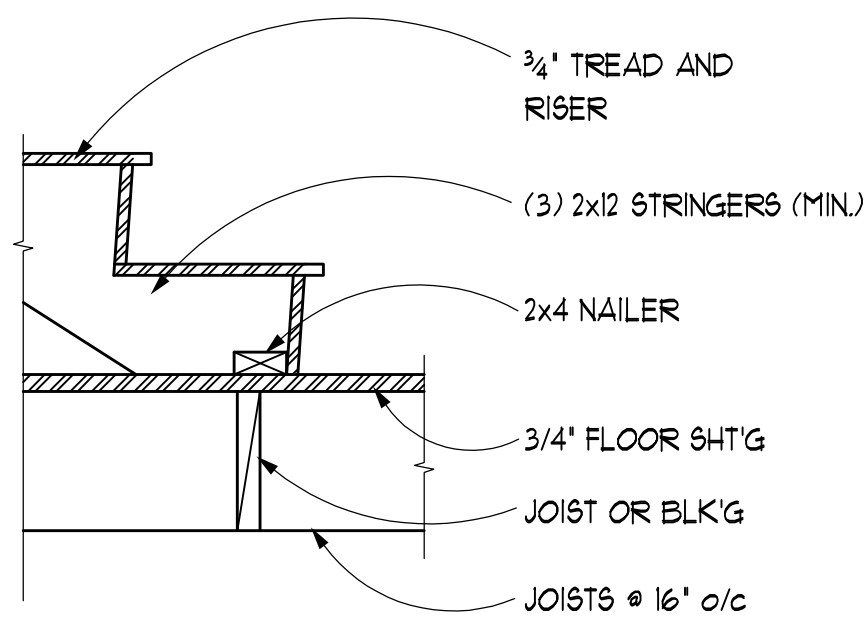

STAIR AT WOOD FLOOR CONN.

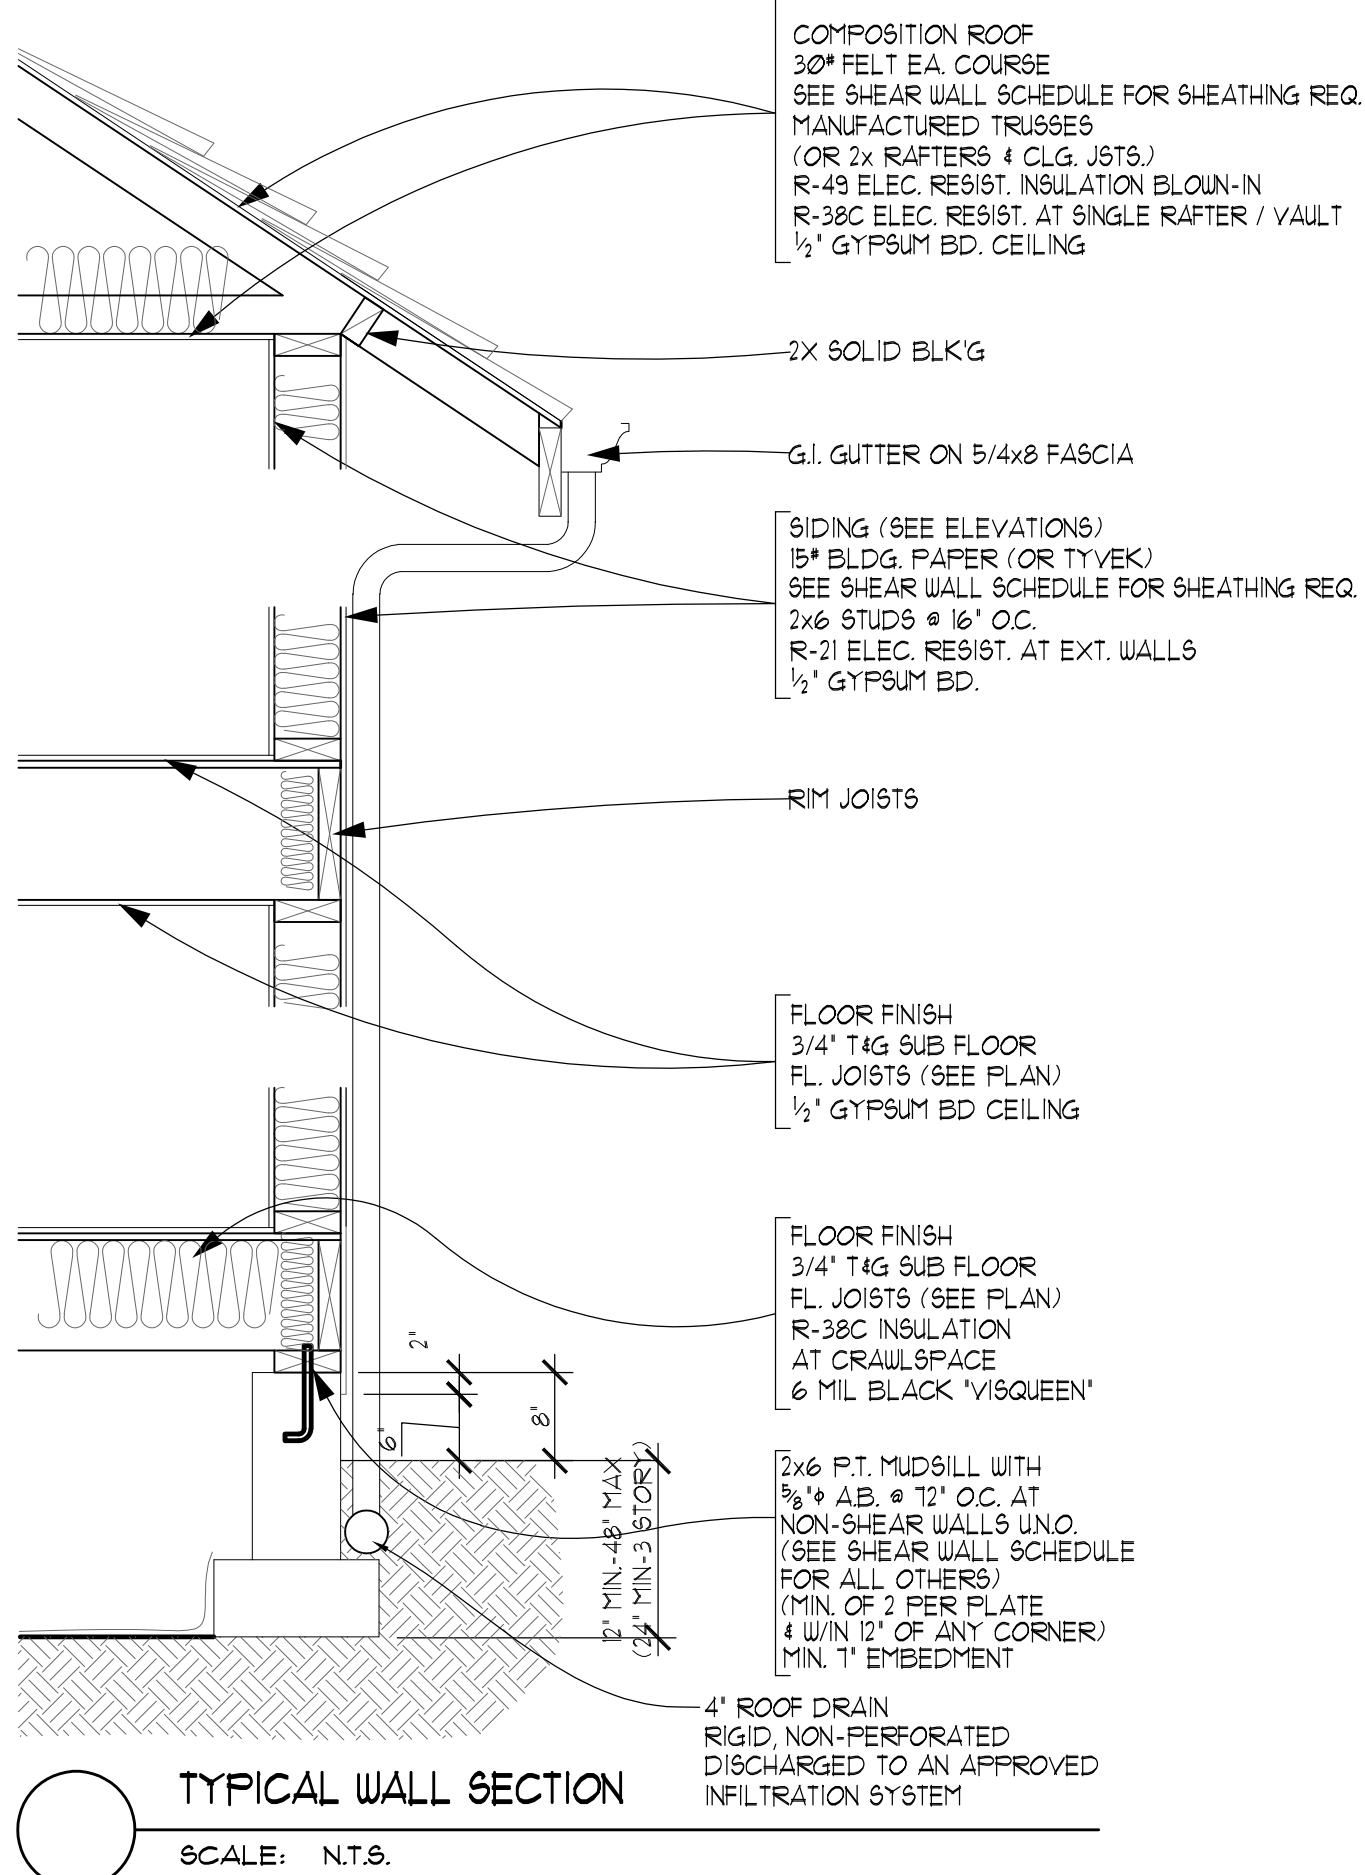




TYPICAL WALL SECTION

SCALE: N.T.S.

Reviewed for code compliance
with IRC 2015
Kitsap County Building Department
lasmith@co.kitsap.wa.us
10/02/2020

Subject To Field Inspection

CHANGES
MUST Be Approved Prior
To Performing Work

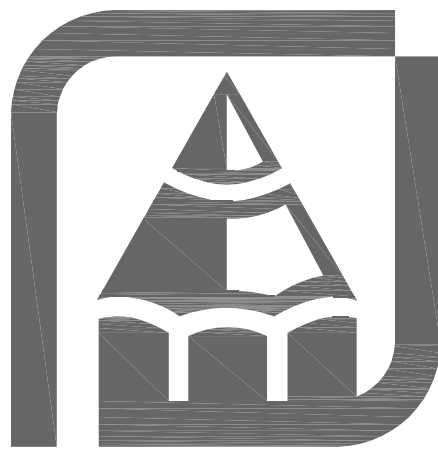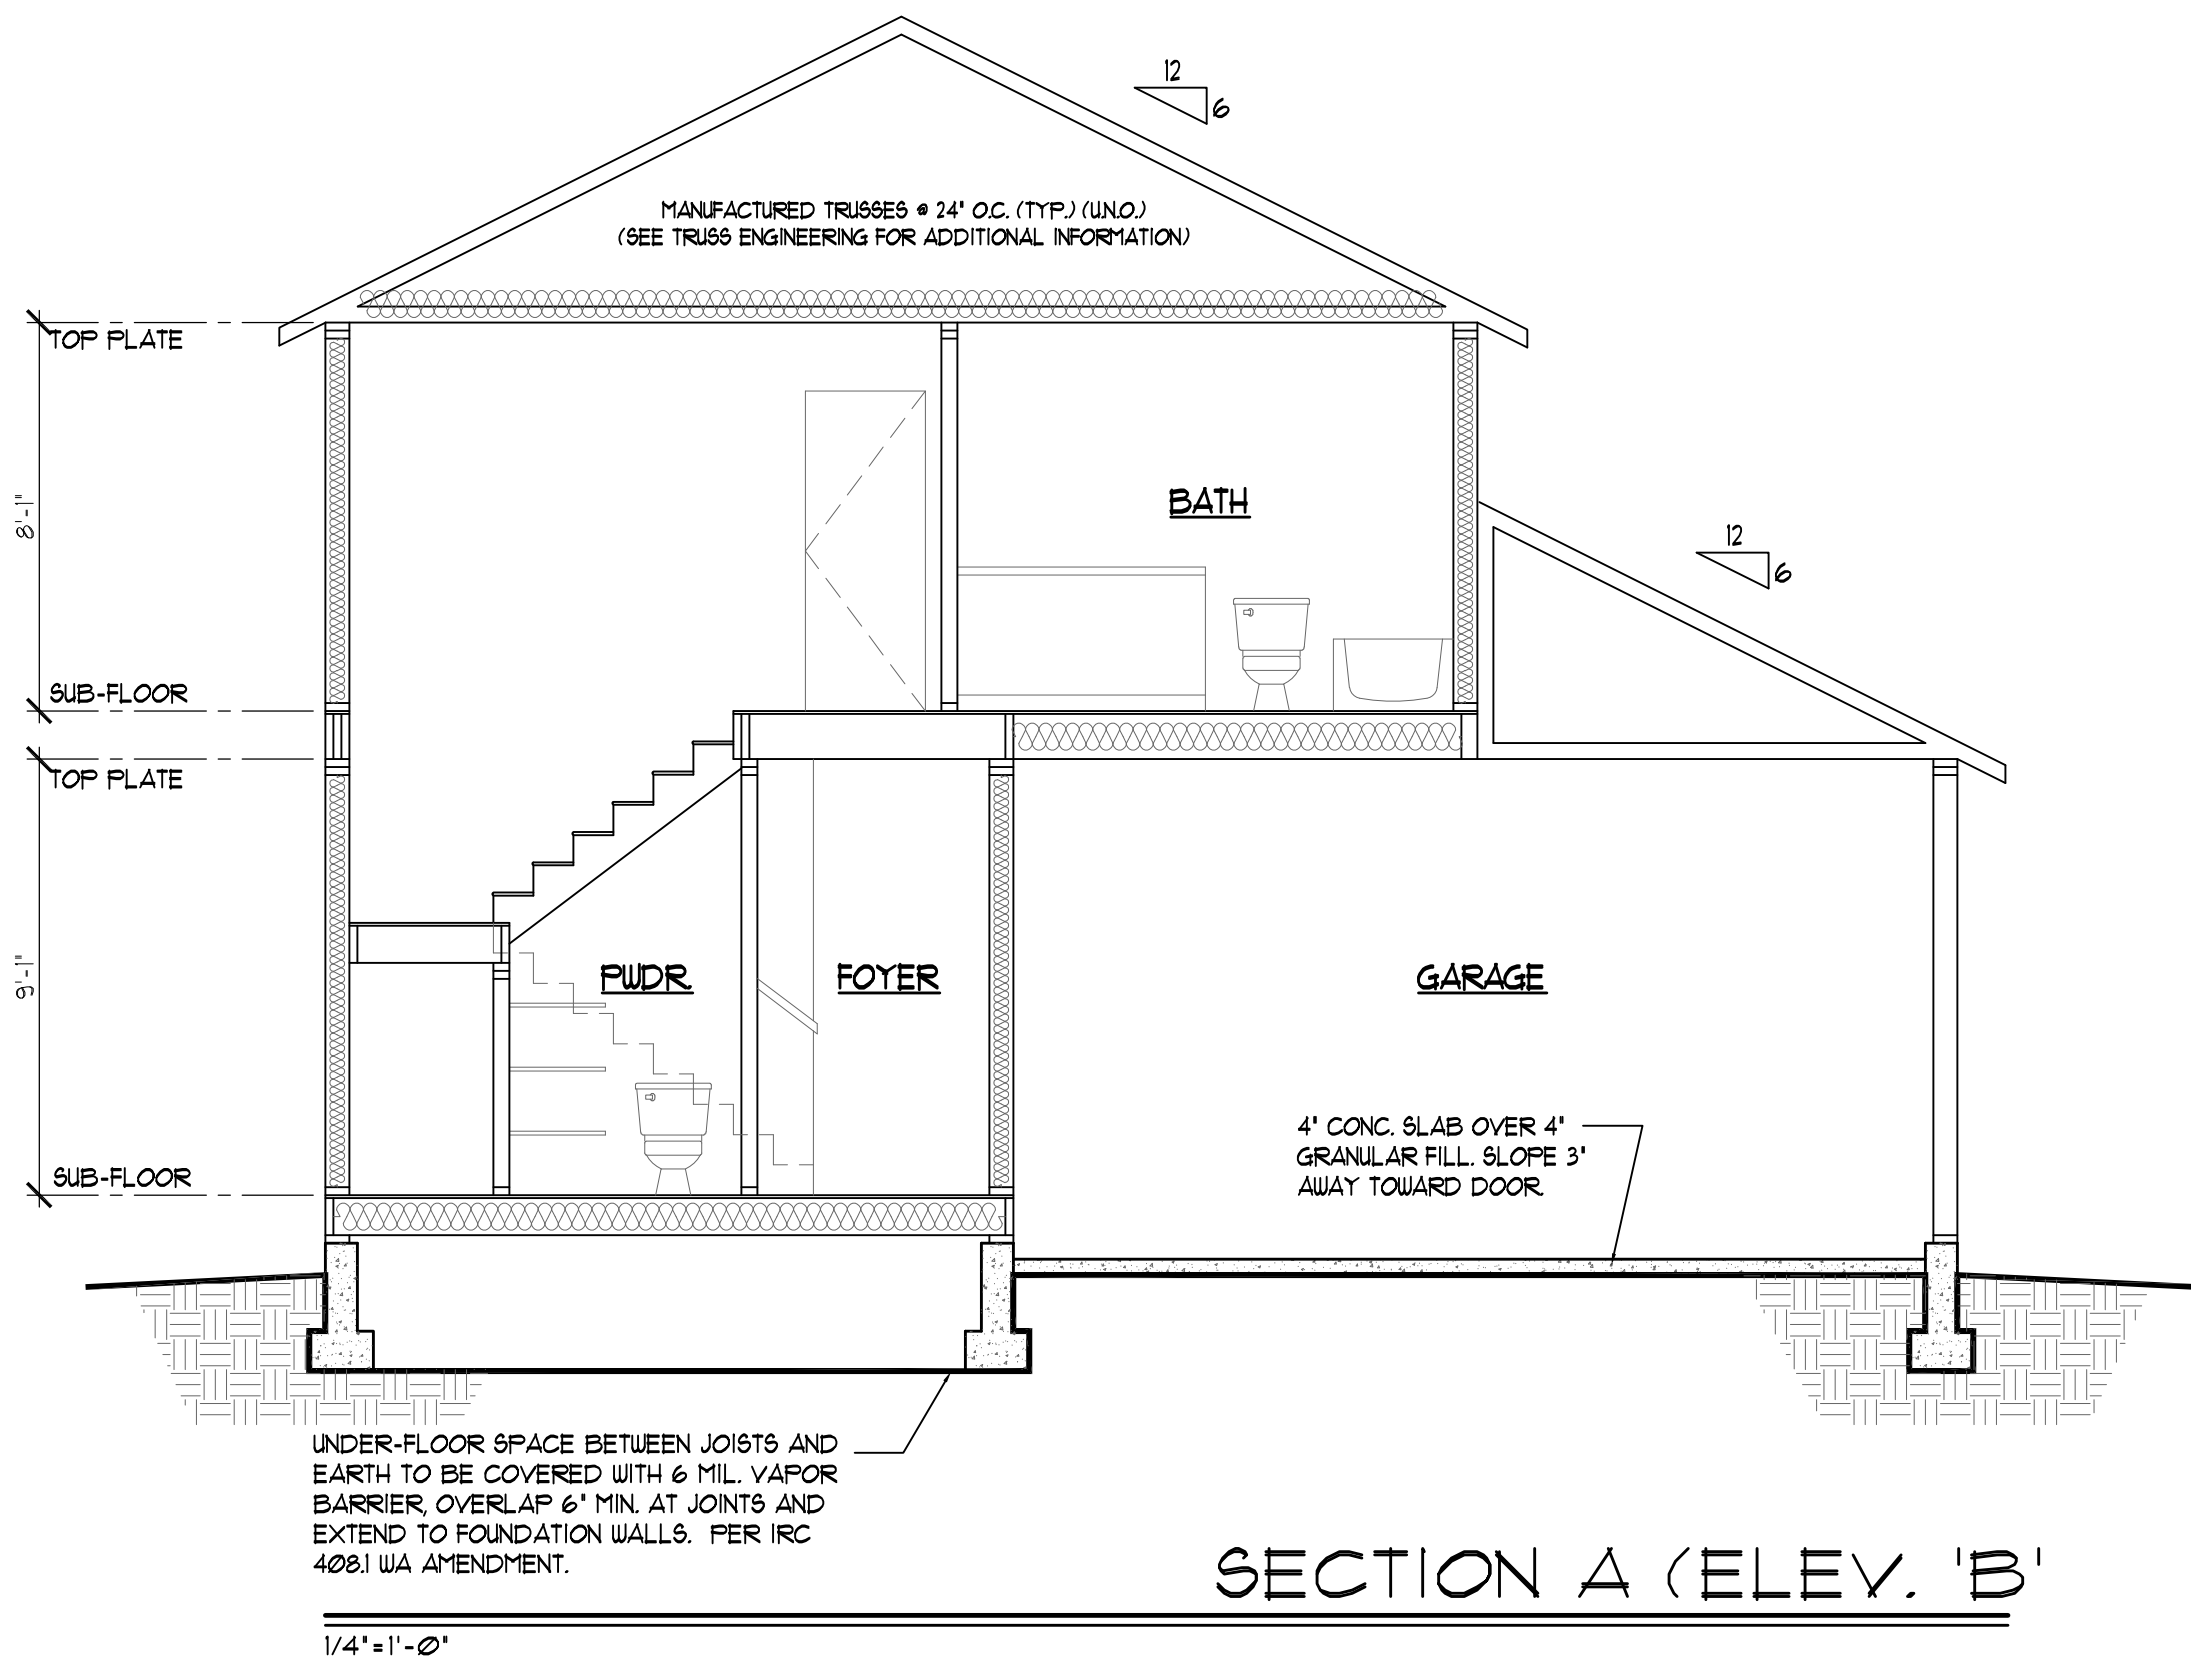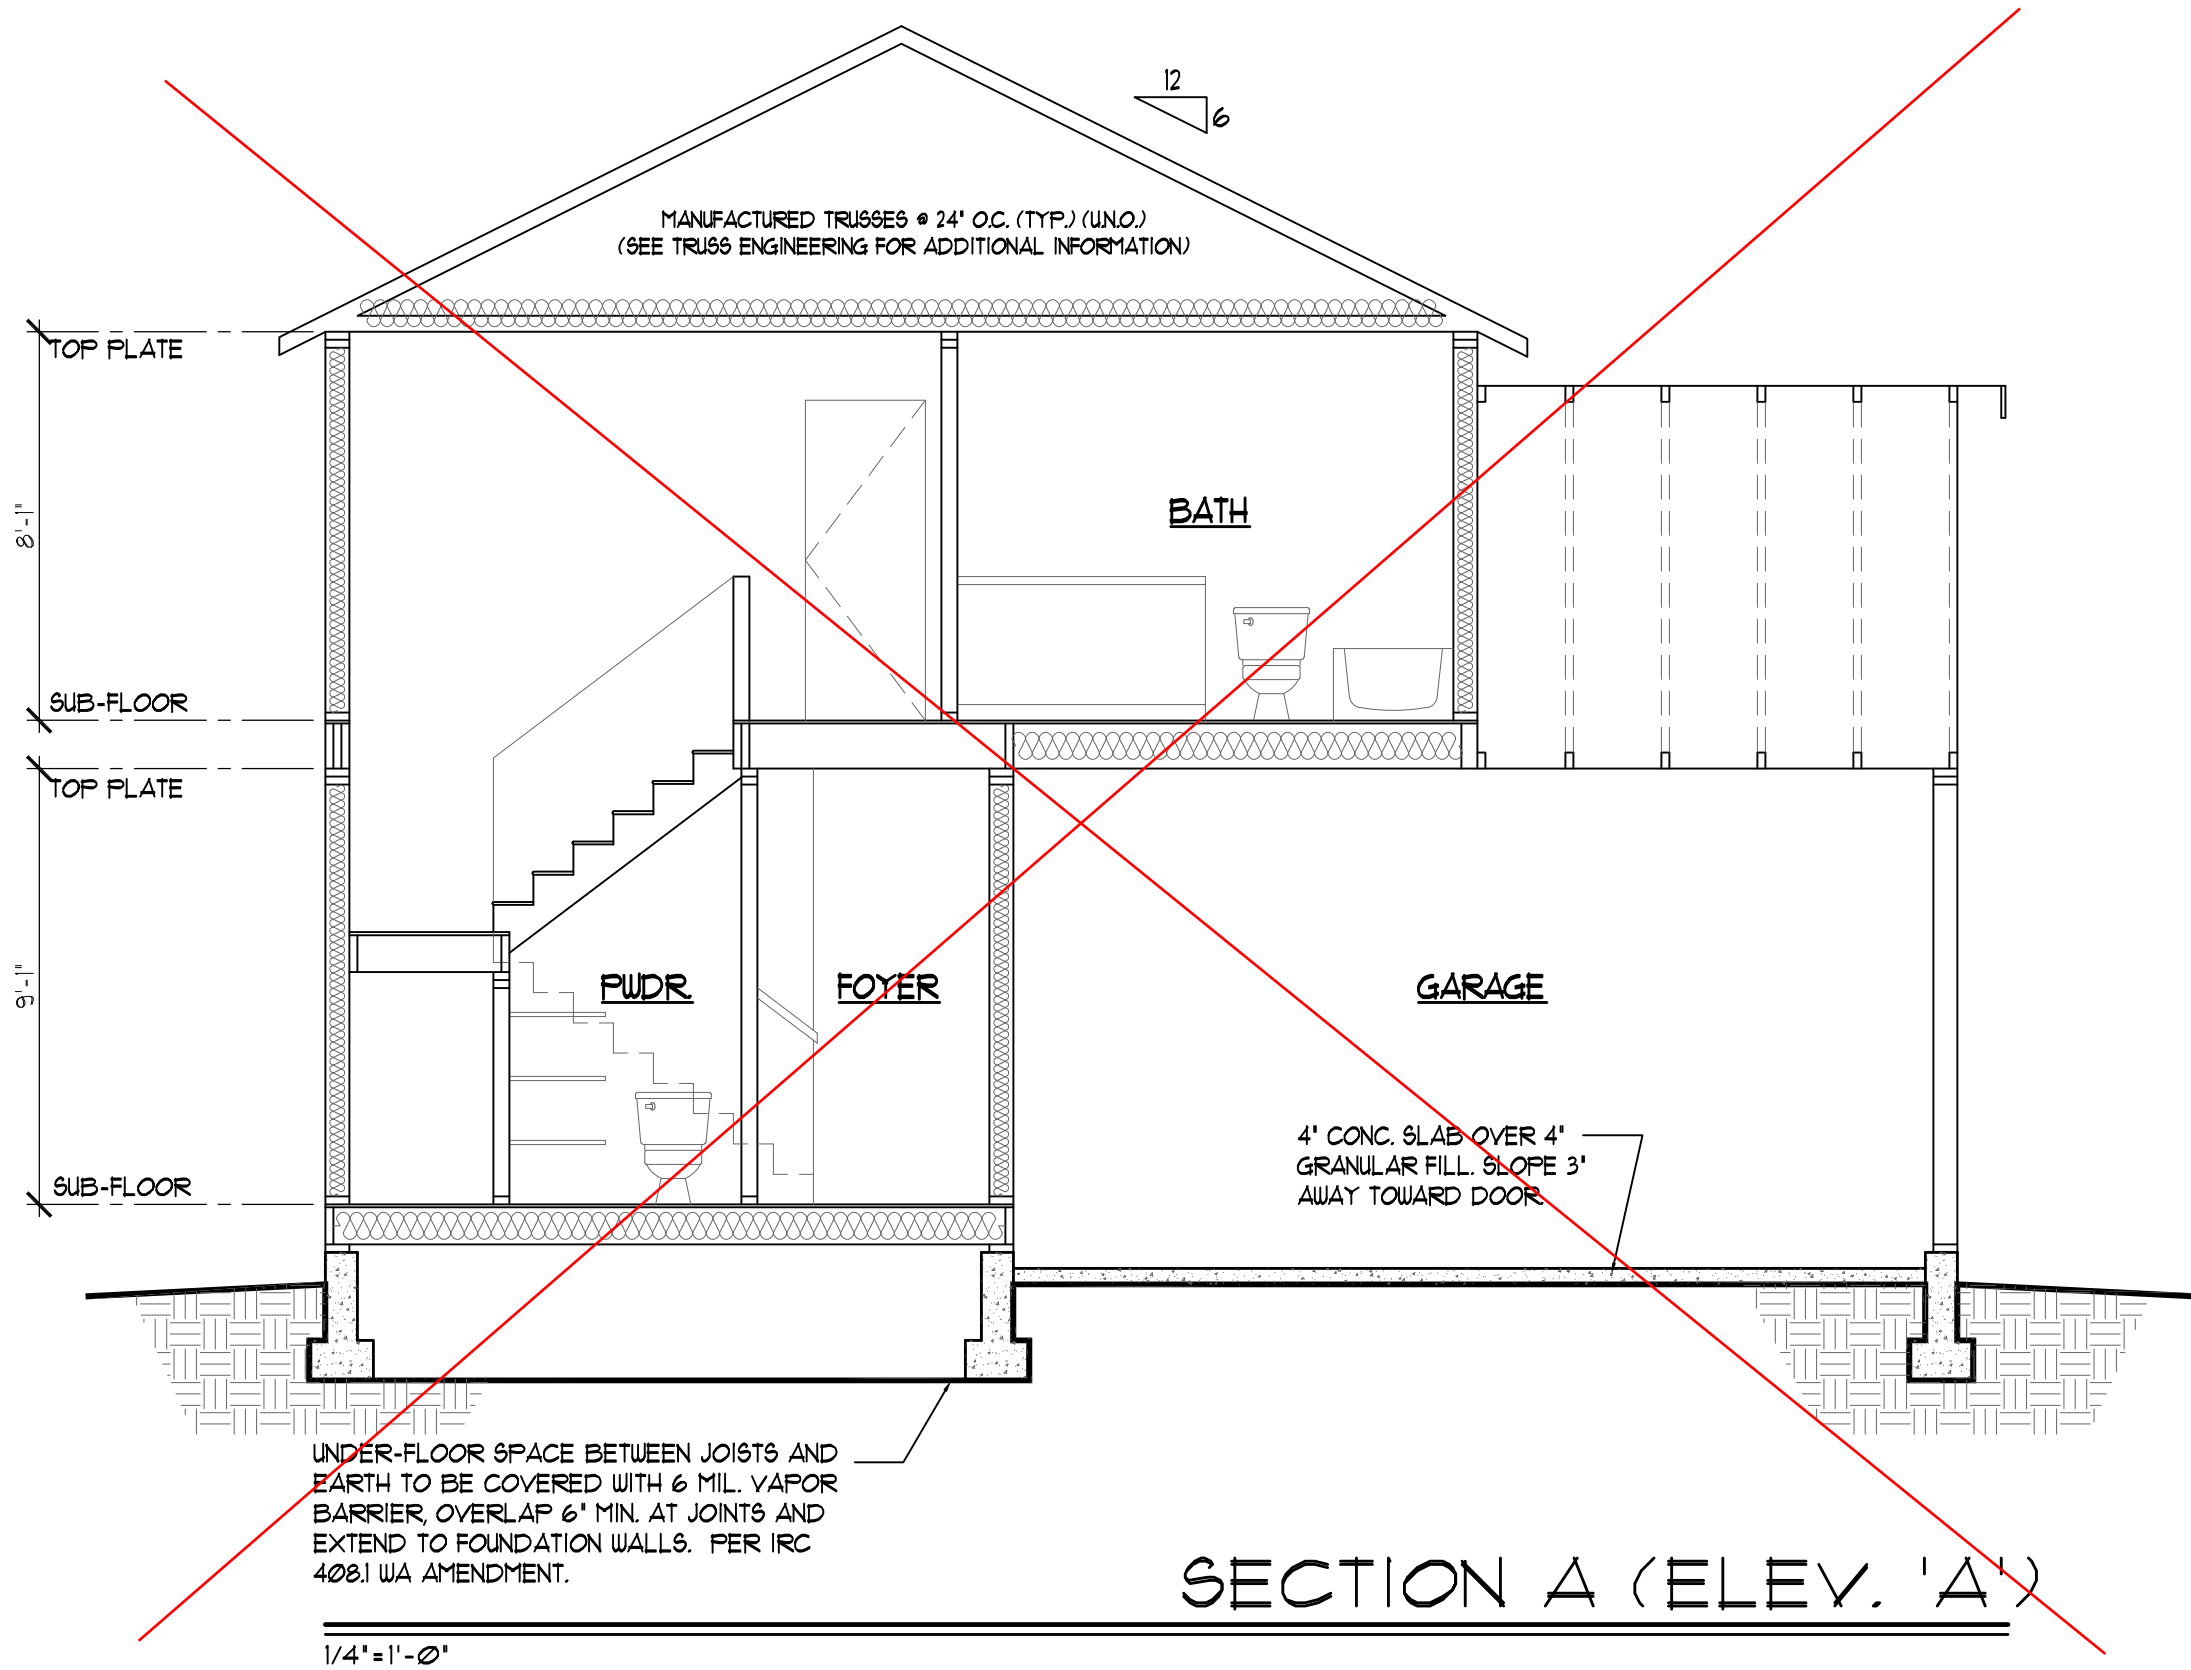

CONTAINING OR BEING ACCESSED BY THE CUSTOMER, USE OF ANY PART OF THE DRAWING BY ANY PARTY OTHER THAN THE CUSTOMER IS STRICTLY PROHIBITED. THE DRAWING IS THE PROPERTY OF RUEPPELL, INC. AND SHALL BE RETURNED TO RUEPPELL, INC. UPON COMPLETION OF THE PROJECT. IN ADDITION, THE CUSTOMER SHALL BE RESPONSIBLE FOR OBTAINING ALL NECESSARY PERMITS AND INSURANCE. RUEPPELL, INC. IS NOT RESPONSIBLE FOR ANY DAMAGE TO OR LOSS OF ANY PROPERTY OR PERSONS. THE CUSTOMER SHALL BE RESPONSIBLE FOR OBTAINING ALL NECESSARY PERMITS AND INSURANCE. RUEPPELL, INC. IS NOT RESPONSIBLE FOR ANY DAMAGE TO OR LOSS OF ANY PROPERTY OR PERSONS. THE CUSTOMER SHALL BE RESPONSIBLE FOR OBTAINING ALL NECESSARY PERMITS AND INSURANCE. RUEPPELL, INC. IS NOT RESPONSIBLE FOR ANY DAMAGE TO OR LOSS OF ANY PROPERTY OR PERSONS.

Copyright © 2019, Rueppell, Inc.

Rueppell
Home Design


Plan: 1572 AB
Job#: Kitsap Base Plan
Date: 04/08/20
Revision Date:
Drawn by:
Phone: (253) 297-8040

[A-4]

Permit Number: 20-04006

Reviewed for code compliance
with IRC 2015
Kitsap County Building Department
lasmith@co.kitsap.wa.us
10/02/2020

**CHANGES
MUST Be Approved Prior
To Performing Work**

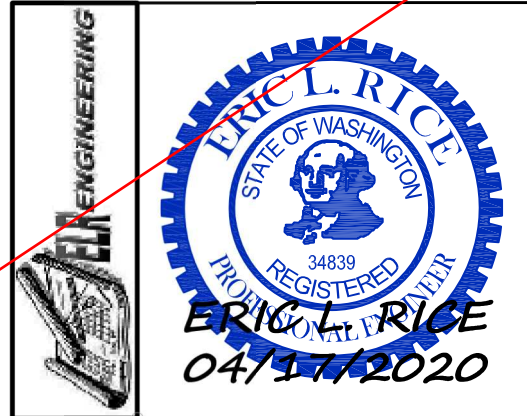

Copyright © 2019, Rueppell, Inc.


[illegible]

Rueppell

Home Design

Plan: 1572 AB
Job#: Kitsap Base Plan
Date: 04/16/20
Revision Date:
Drawn by:
Phone: (253) 297-8040

~~[S-1A]~~

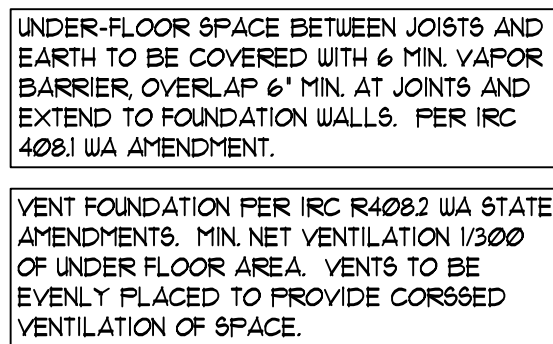

MAIN FLOOR FRAMING/END. PLAN 'A'

ALL CONNECTIONS TO SPECIFIED AND/ OR VERIFIED BY JOIST MANUFACTURER.
NOTE: ALL SOLID SAWN BEAMS TO BE DRY OR BETTER.

FOUNDATION VENT CALCULATIONS

8"x16" SCREENED FOUNDATION VENTS TO BE A MINIMUM OF 3'-0" FROM THE CORNERS PER IRC R408.2


VENTS = 50 SQ. IN. FREE AREA

$196/300 = 2.65 \text{ SQ. IN. / } 0.52 = 51 \text{ -OR- } 6 \text{ VENTS - (8) VENTS REQ'D.}$

Corrosion Resistant Fasteners:
Fasteners for pressure preservative and fire-retardant treated wood shall be of hot-dipped galvanized steel, stainless steel, silicon bronze or copper.
Exception: Half inch diameter or greater steel bolts



Manufactured joist specs shall be on-site for inspection

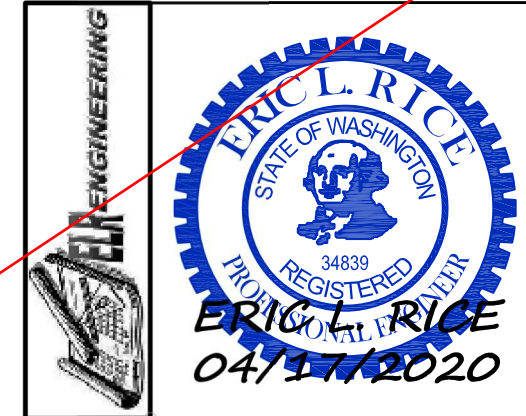


CONTRACTOR'S ACCEPTANCE OF THE PLANS IS LIMITED TO THE INFORMATION PROVIDED HEREON. THE CONTRACTOR SHALL BE RESPONSIBLE FOR OBTAINING ALL NECESSARY PERMITS, EXCEPT ON QUANTITY. THE CUSTOMER, BY THEIR PURCHASE, ACCEPTS THE PLANS AS SHOWN AND RELEASES THE CONTRACTOR FROM ANY LIABILITY FOR ANY DAMAGE TO ANY PROPERTY, INCLUDING CONSTRUCTION AND REMEDIATION, ARISING FROM THE PLANS, WHETHER CAUSED BY THE CONTRACTOR'S NEGLIGENCE OR OTHERWISE. THE CONTRACTOR SHALL BE RESPONSIBLE FOR OBTAINING ALL NECESSARY PERMITS, EXCEPT ON QUANTITY. THE CUSTOMER, BY THEIR PURCHASE, ACCEPTS THE PLANS AS SHOWN AND RELEASES THE CONTRACTOR FROM ANY LIABILITY FOR ANY DAMAGE TO ANY PROPERTY, INCLUDING CONSTRUCTION AND REMEDIATION, ARISING FROM THE PLANS, WHETHER CAUSED BY THE CONTRACTOR'S NEGLIGENCE OR OTHERWISE.

Copyright © 2019, Rueppell, Inc.

Plan: 1572 AB
Job#: Kitsap Base Plan
Date: 04/16/20
Revision Date:
Drawn by:
Phone: (253) 297-8040

~~[S-2A]~~

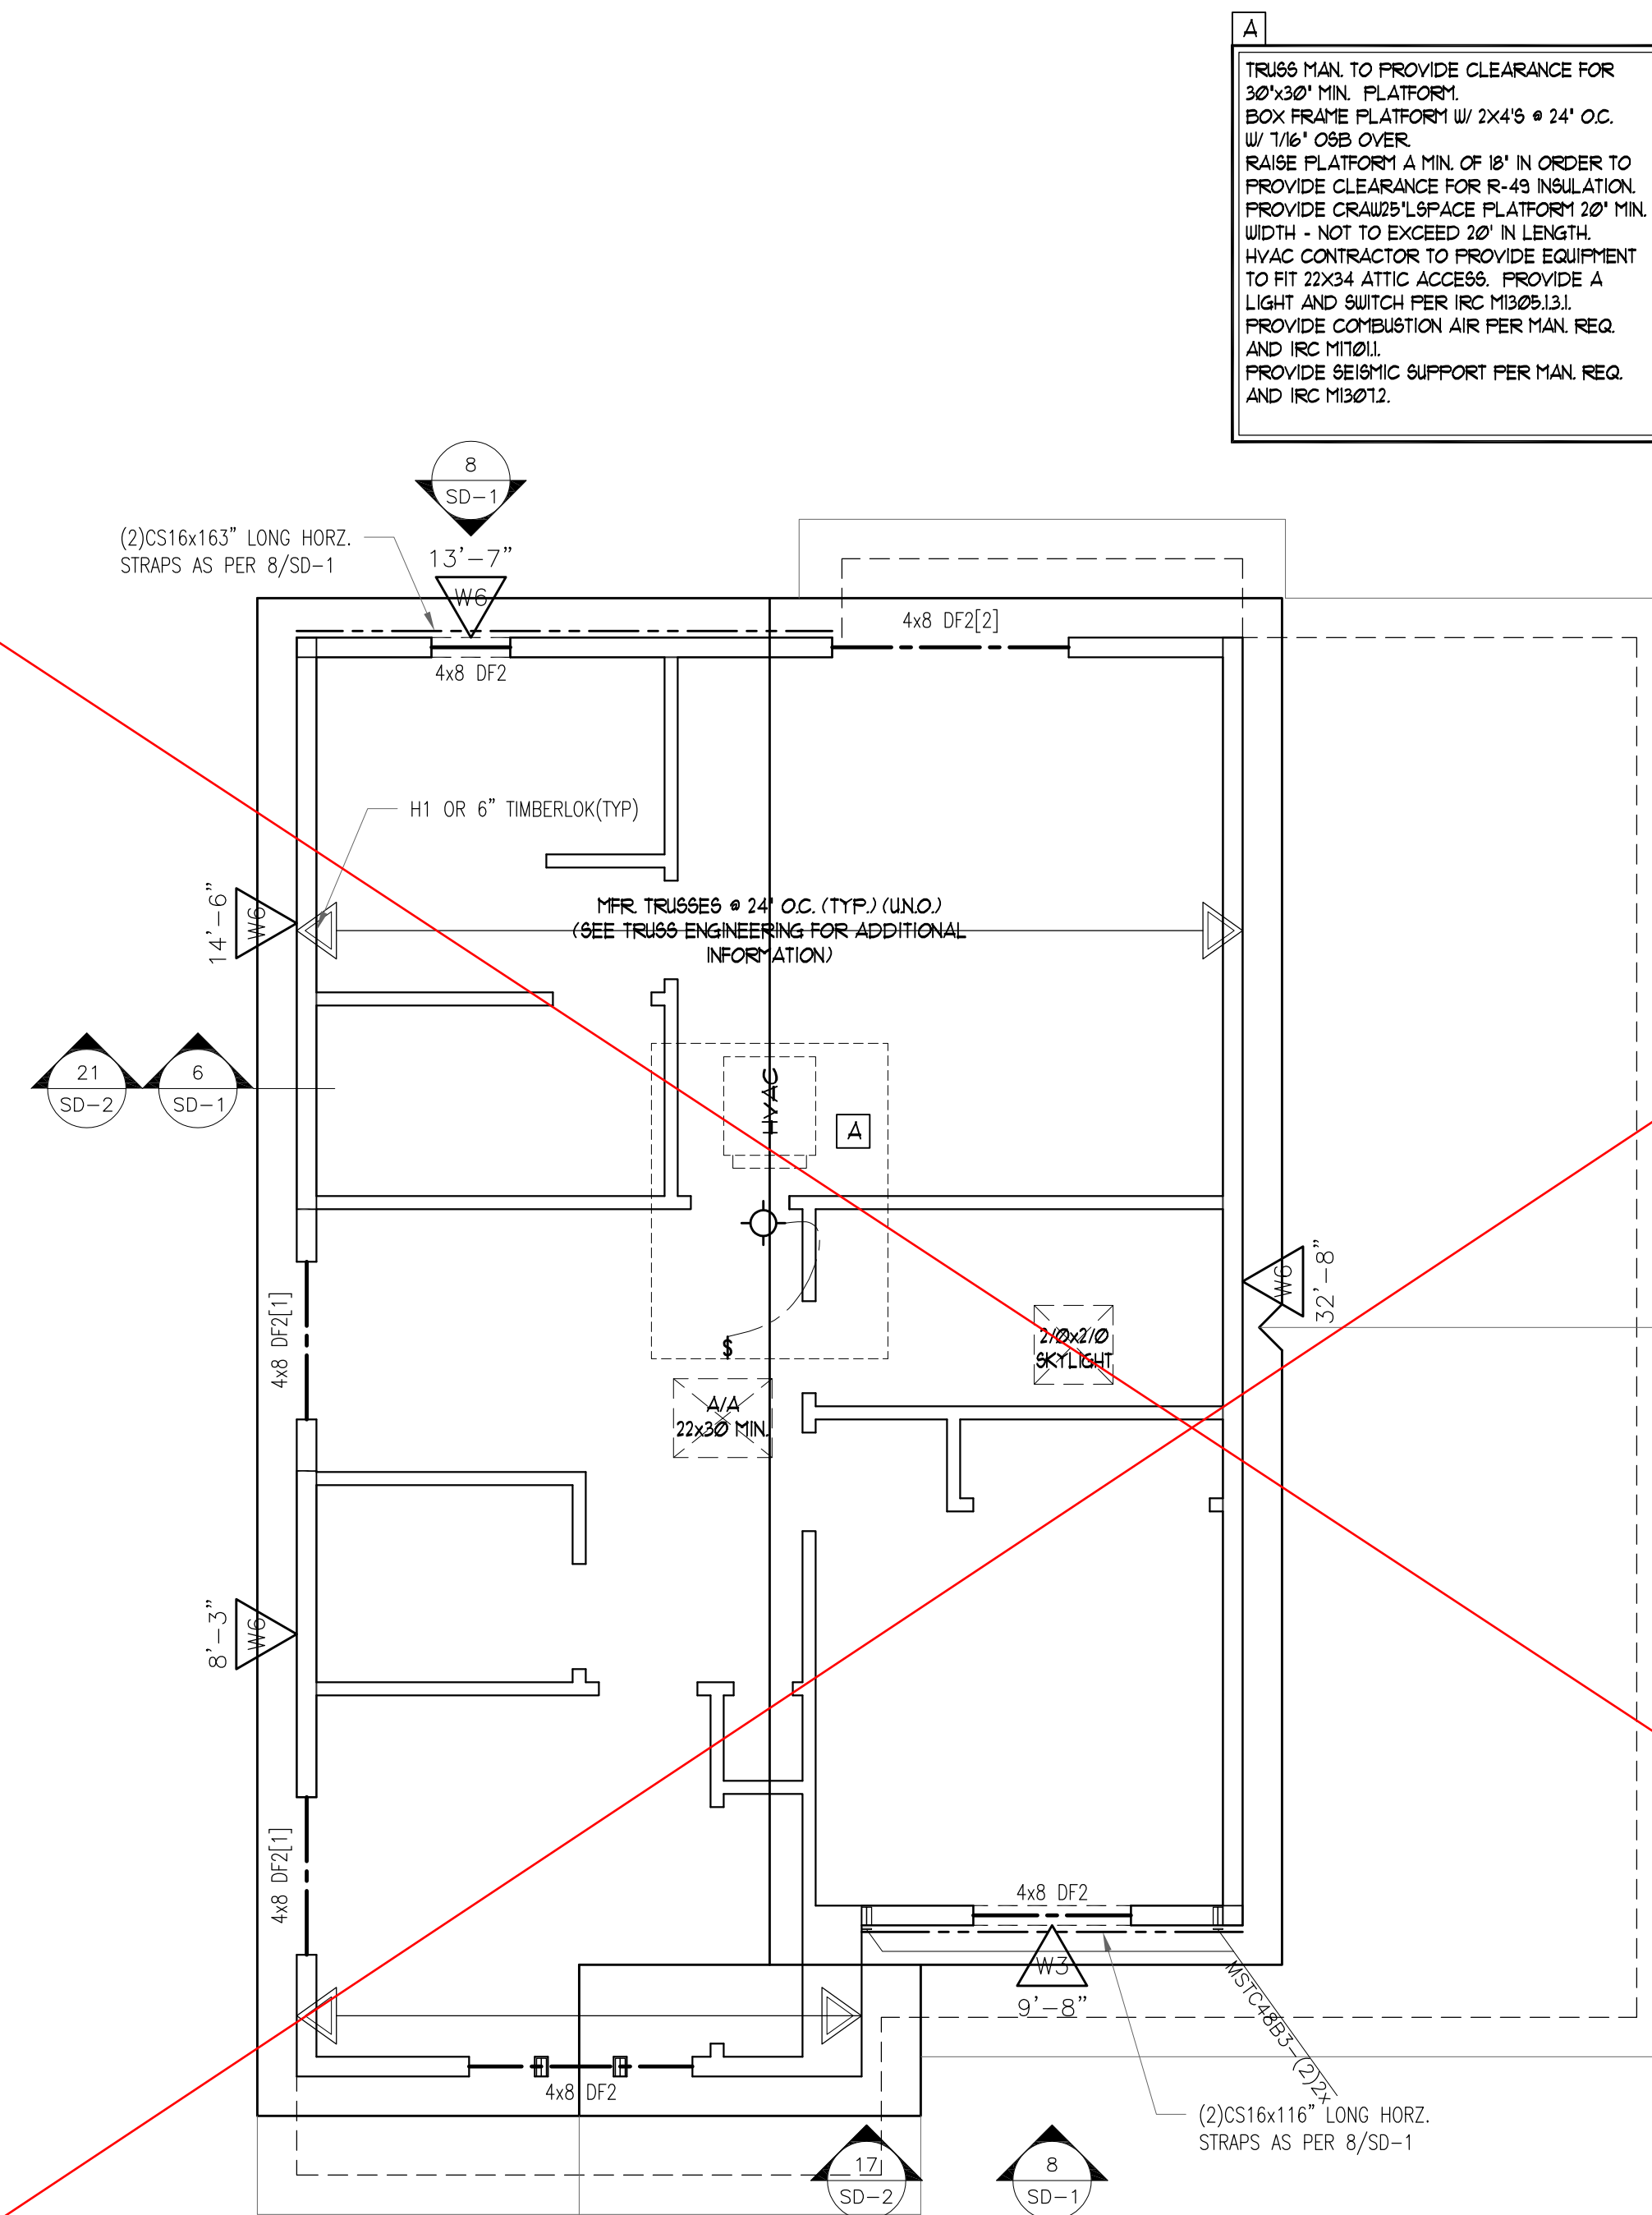

ROOF FRAMING/UPPER FLOOR SW PLAN 'A'



NOTE: ALL OVERFRAMED RAFTERS TO BE 2x6-24" O.C. FOR SPANS UP TO 8'-0", 2x8-24" O.C. FOR SPANS UP TO 11'-0", 2x10-24" O.C. FOR SPANS UP TO 14'-0".
ALL CONNECTIONS TO SPECIFIED AND/ OR VERIFIED BY TRUSS MANUFACTURER.
NOTE: ALL SOLID SAWN BEAMS TO BE DFI#2 OR BETTER.
NOTE: ENGINEERING FOR SUPPORT OF ROOF FRAMING IS BASED ON THE PROVIDED ROOF TRUSS LAYOUT. VERIFY CONSISTENCY WITH TRUSS MANUFACTURER'S ENGINEERING/ LAYOUT WHEN AVAILABLE.

$$1/4' = 1' - \emptyset'$$

**CHANGES
MUST Be Approved Prior
To Performing Work**

Subject To Field Inspection

STRUCTURAL ONLY

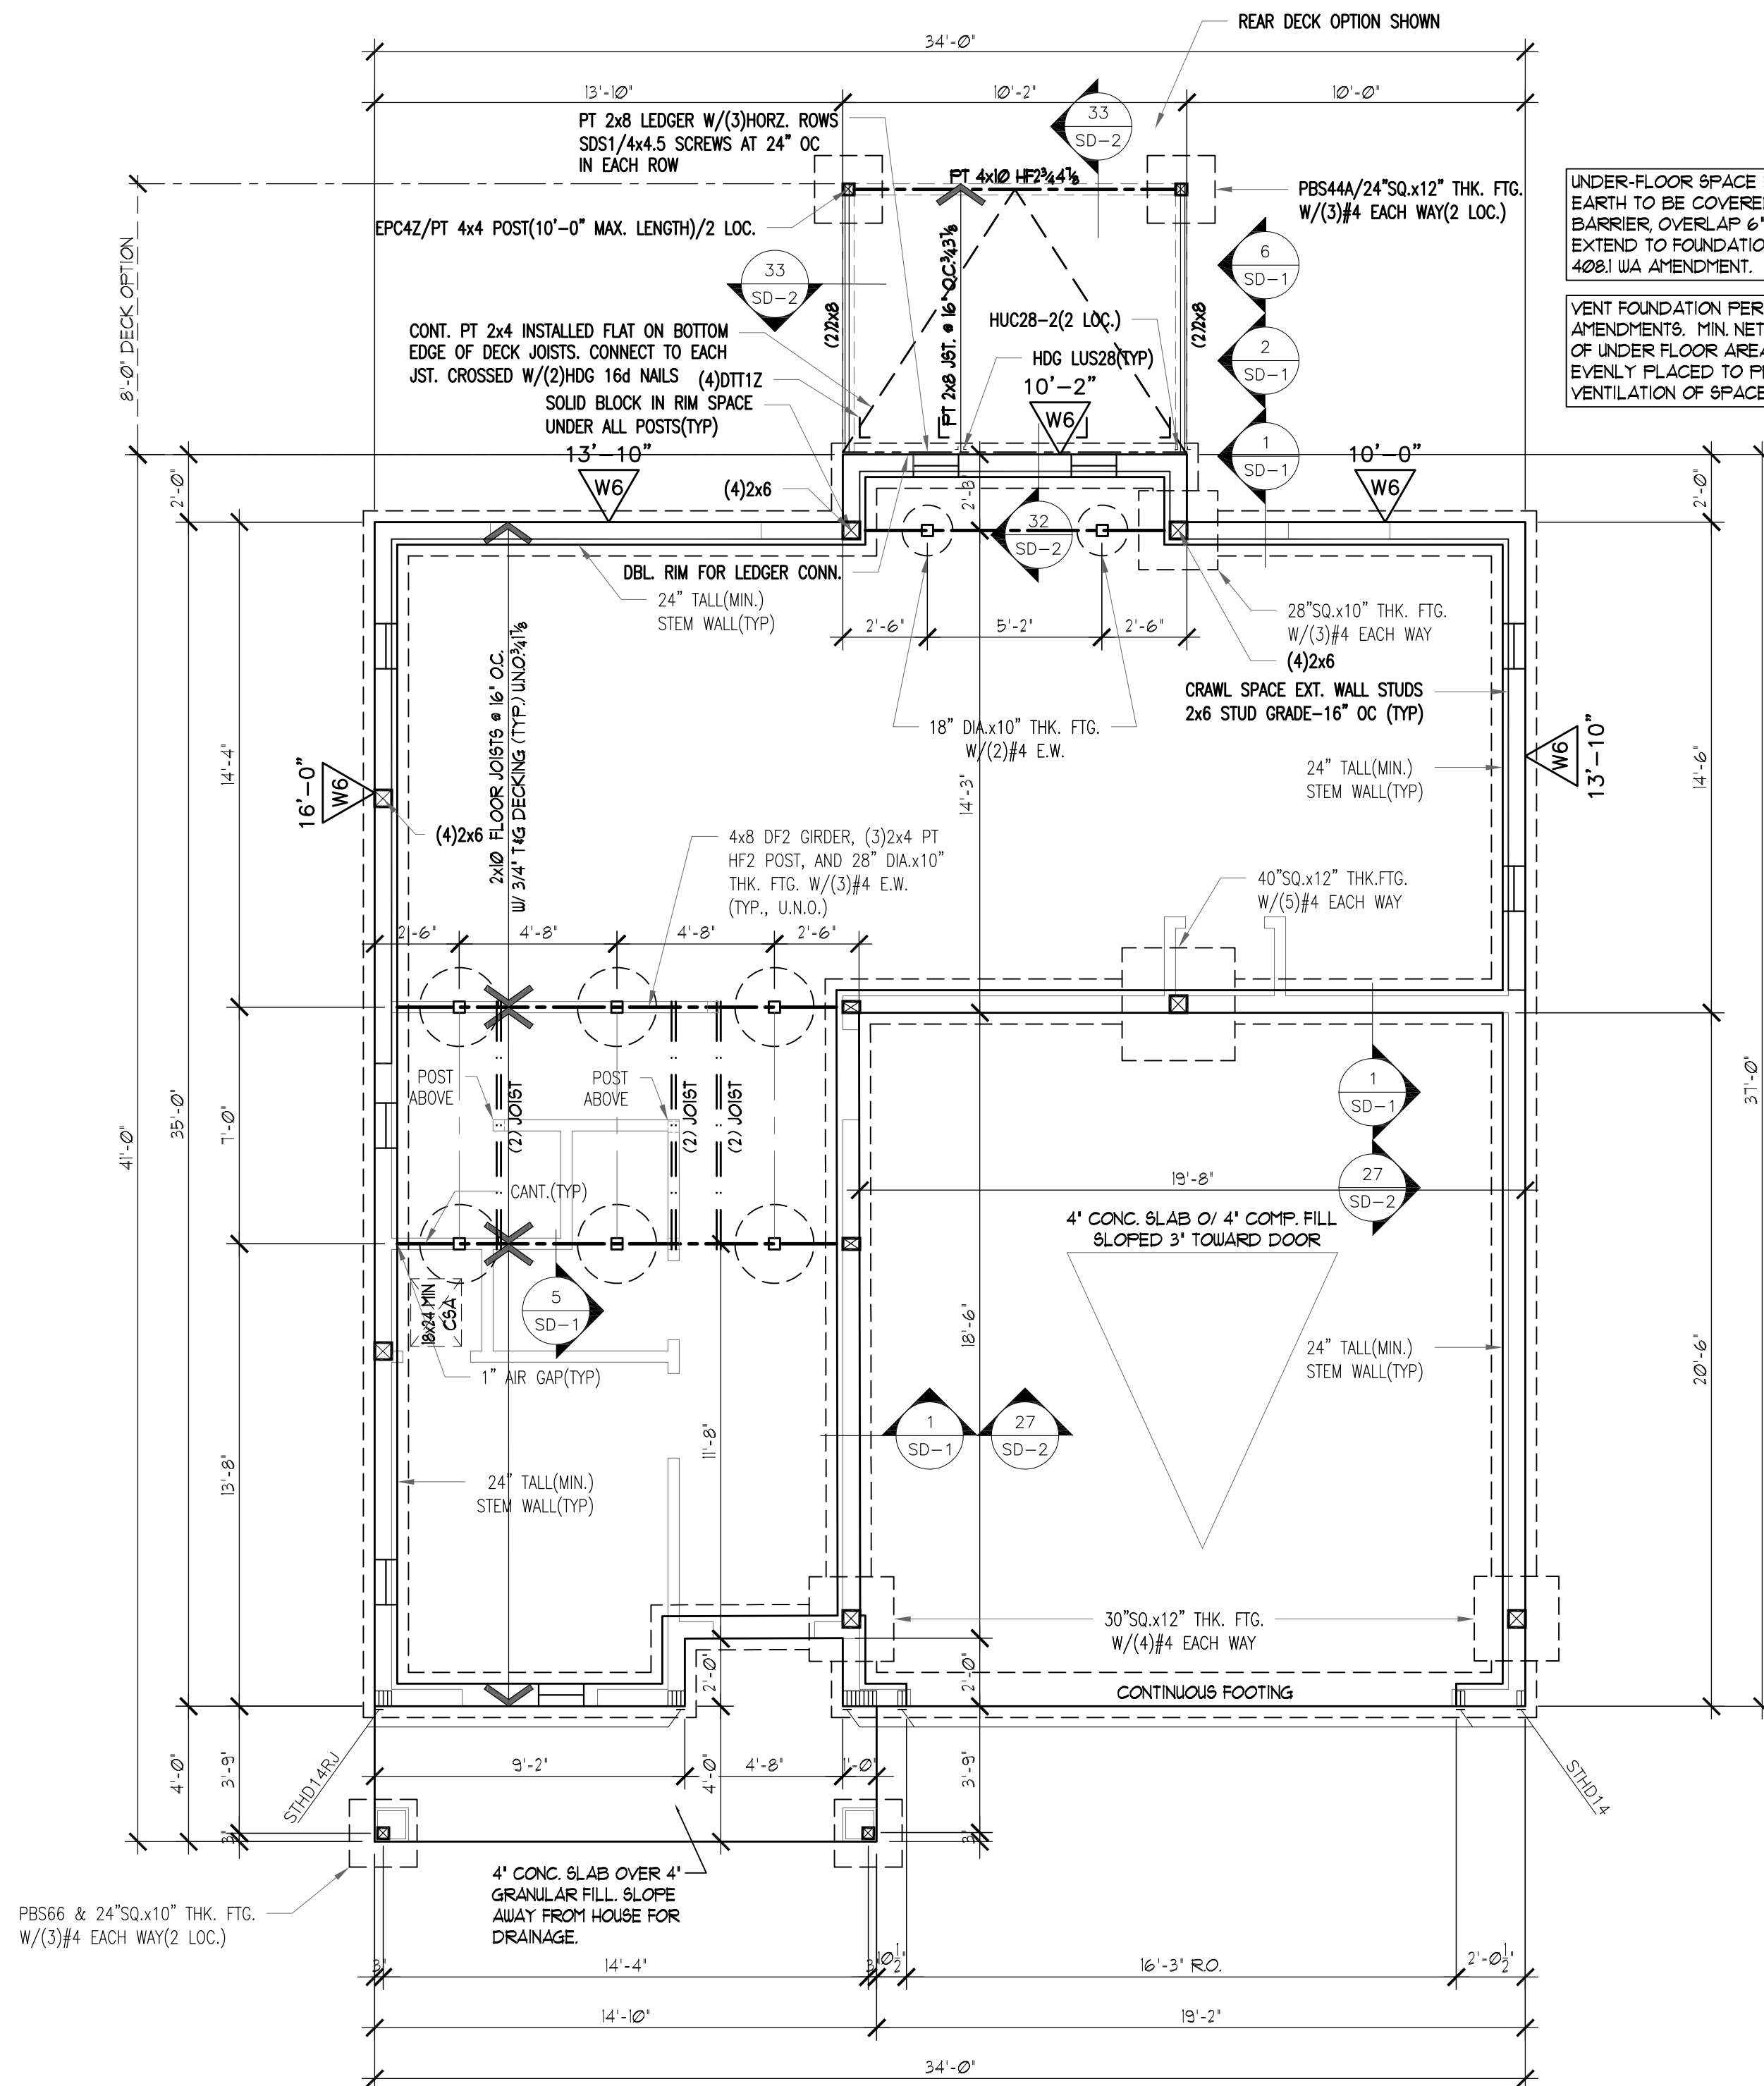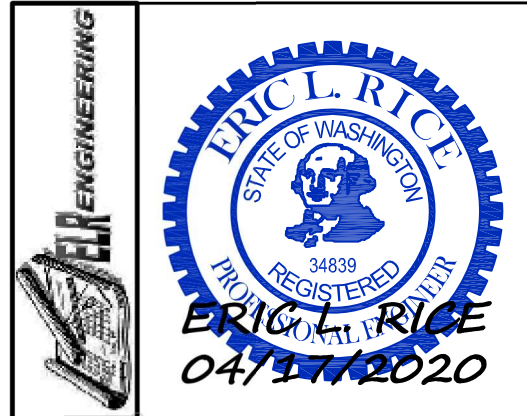


MAIN FLOOR FRAMING/END. PLAN 'B'

ALL CONNECTIONS TO SPECIFIED AND/ OR VERIFIED BY JOIST MANUFACTURER.
NOTE: ALL SOLID SAWN BEAMS TO BE DF#2 OR BETTER.

FOUNDATION VENT CALCULATIONS
8"x16" SCREENED FOUNDATION VENTS TO BE A MINIMUM OF 3'-0" FROM THE CORNERS PER IRC R408.2
VENTS = 50 SQ. IN. FREE AREA
 $196/300 = 265 \text{ SQ. IN.} / 0.52 = 51$ -OR- 6 VENTS - (8) VENTS REQ'D.

Corrosion Resistant Fasteners:
Fasteners for pressure preservative and fire-retardant treated wood shall be of hot-dipped galvanized steel, stainless steel, silicon bronze or copper.
Exception: Half inch diameter or greater steel bolts

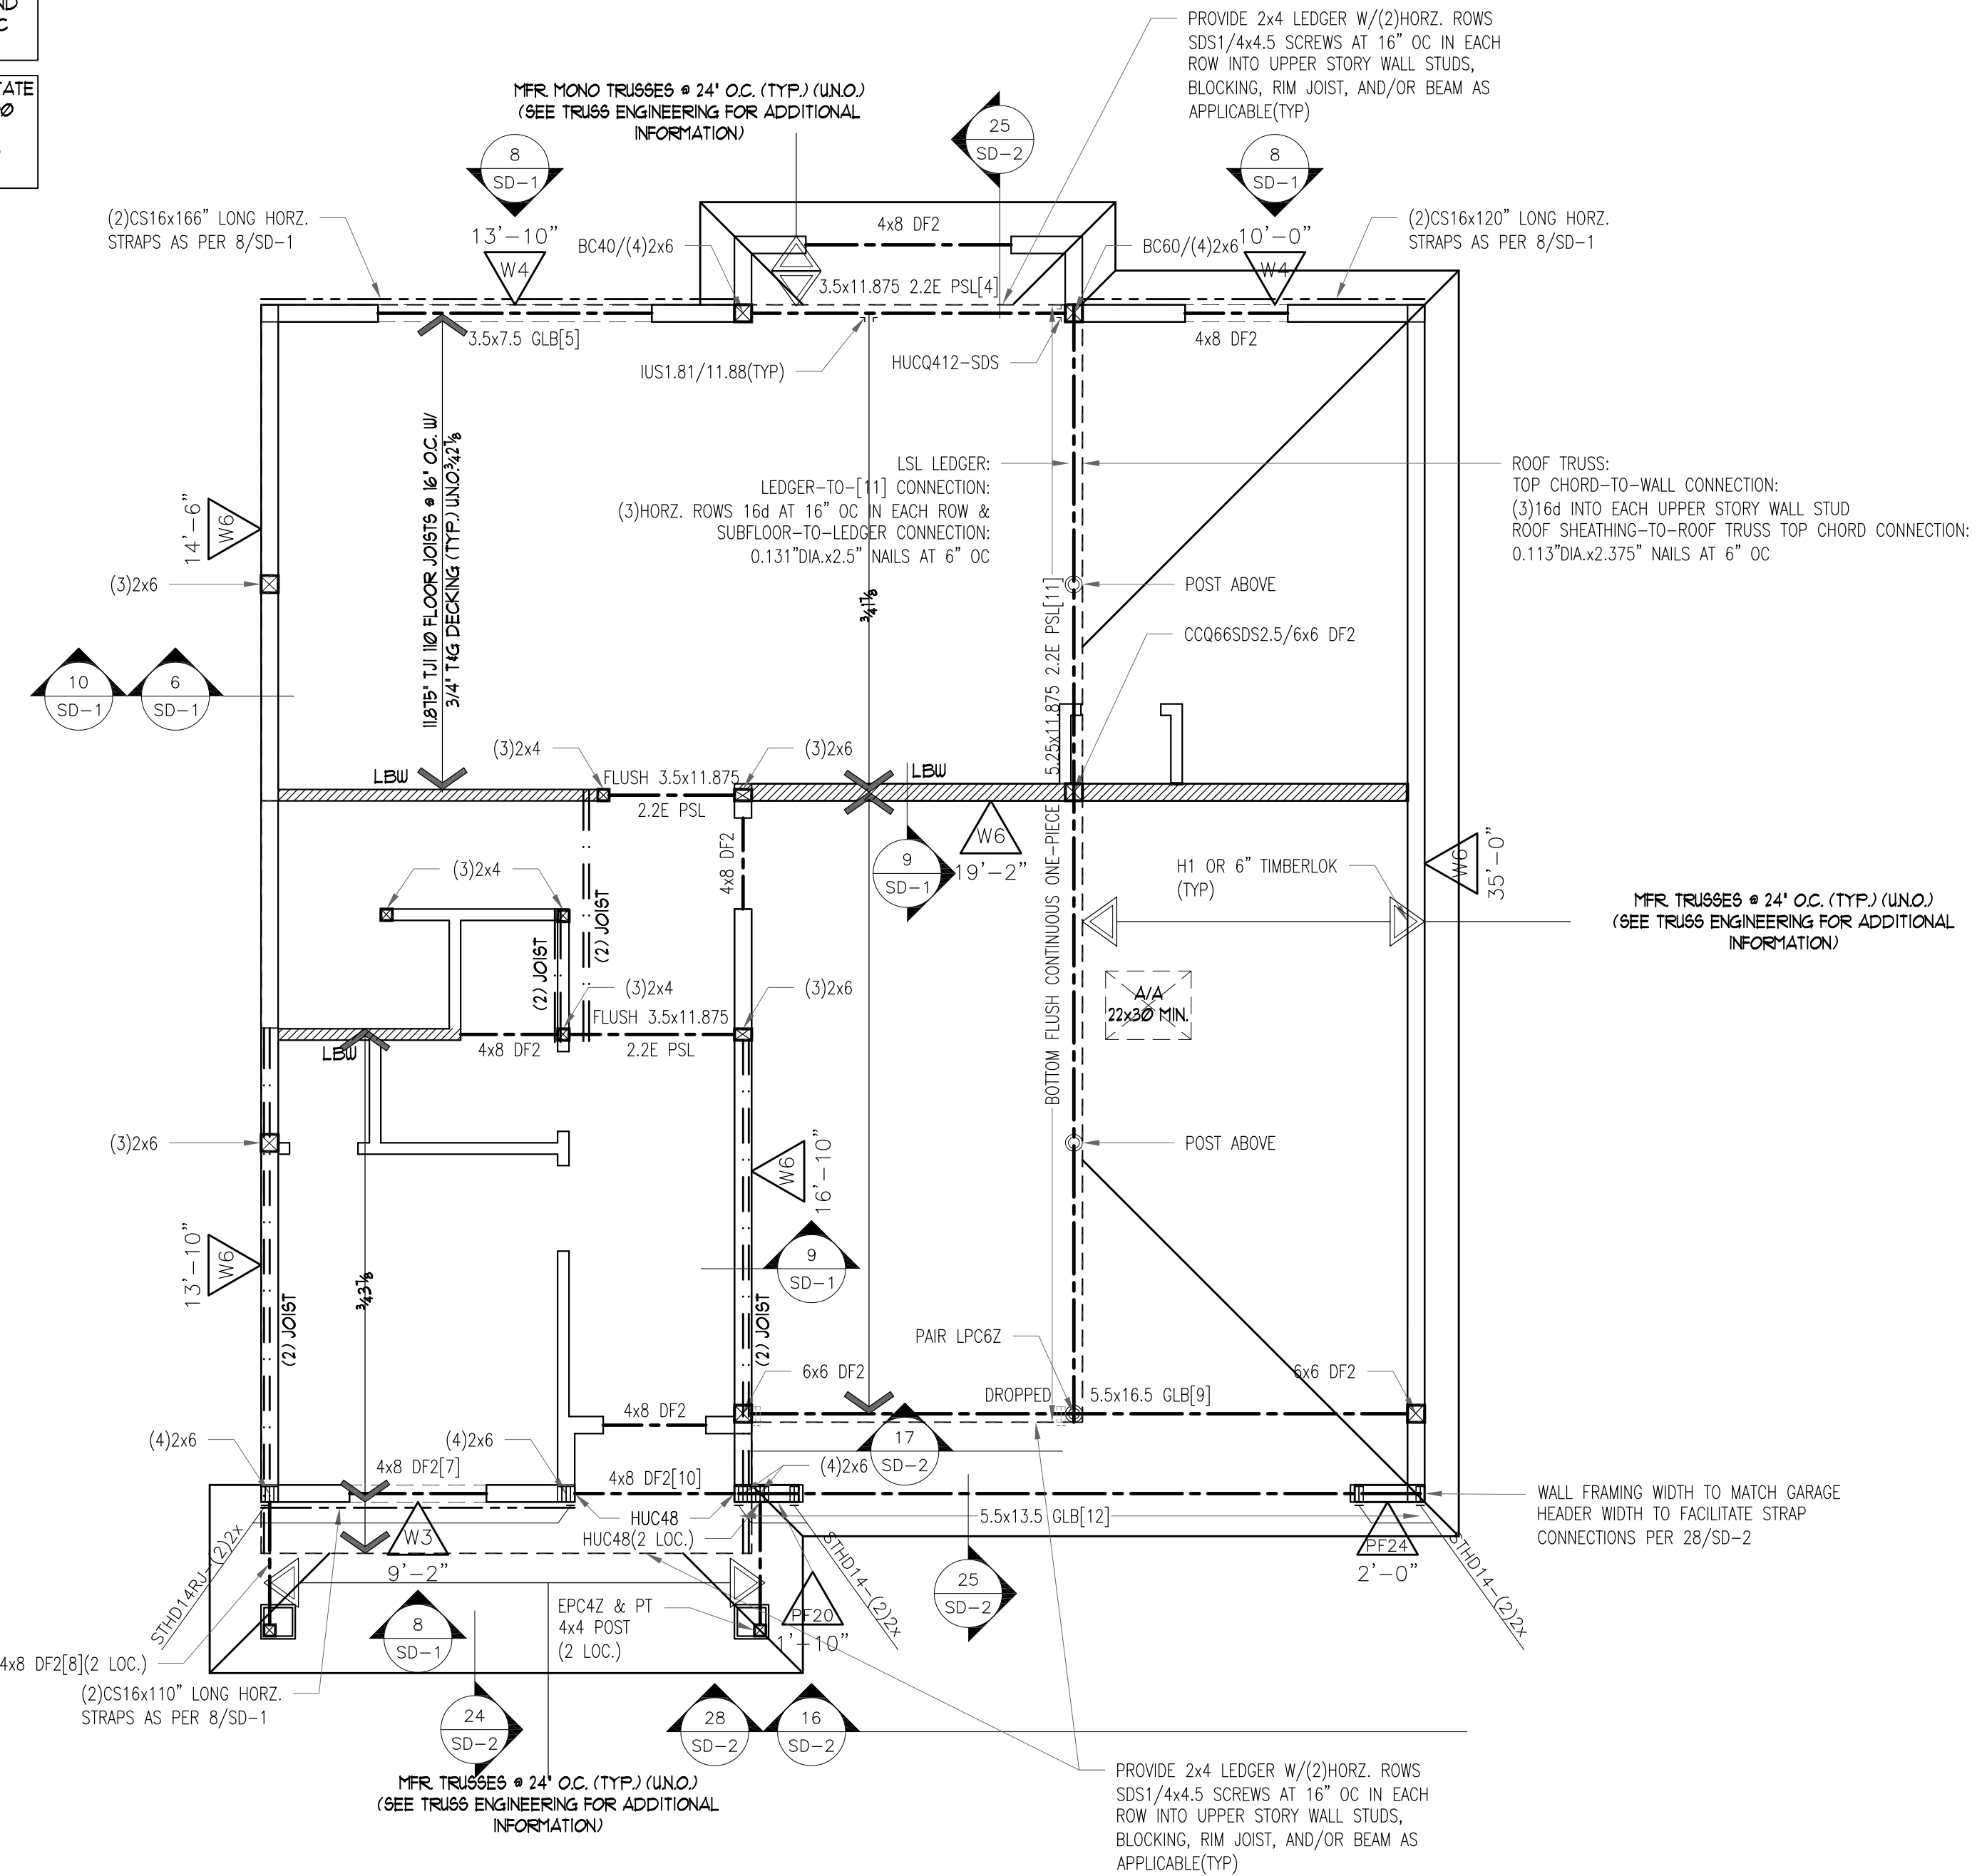

UPPER FLOOR FRAMING/MAIN FLOOR SW PLAN 'B'

ALL CONNECTIONS TO SPECIFIED AND/ OR VERIFIED BY JOIST MANUFACTURER.
NOTE: ALL SOLID SAWN BEAMS TO BE DF#2 OR BETTER.

Manufactured joist specs shall be on-site for inspection

Plan: 1572 AB
Job#: Kitsap Base Plan
Date: 04/16/20
Revision Date:
Drawn by:
Phone: (253) 297-8040

Copyright © 2019, Rueppell, Inc.

Rueppell
Home Design

[S-1B]

Reviewed for code compliance
with IRC 2015
Kitsap County Building Department
lasmith@co.kitsap.wa.us
10/02/2020

Subject To Field Inspection

**CHANGES
MUST Be Approved Prio
To Performing Work**


Copyright © 2019, Rueppell, Inc.

[illegible]

Home Design

Plan: 1572 AB
Job#: Kitsap Base Plan
Date: 04/16/20
Revision Date:
Drawn by:
Phone: (253) 297-8040

[S-2B]



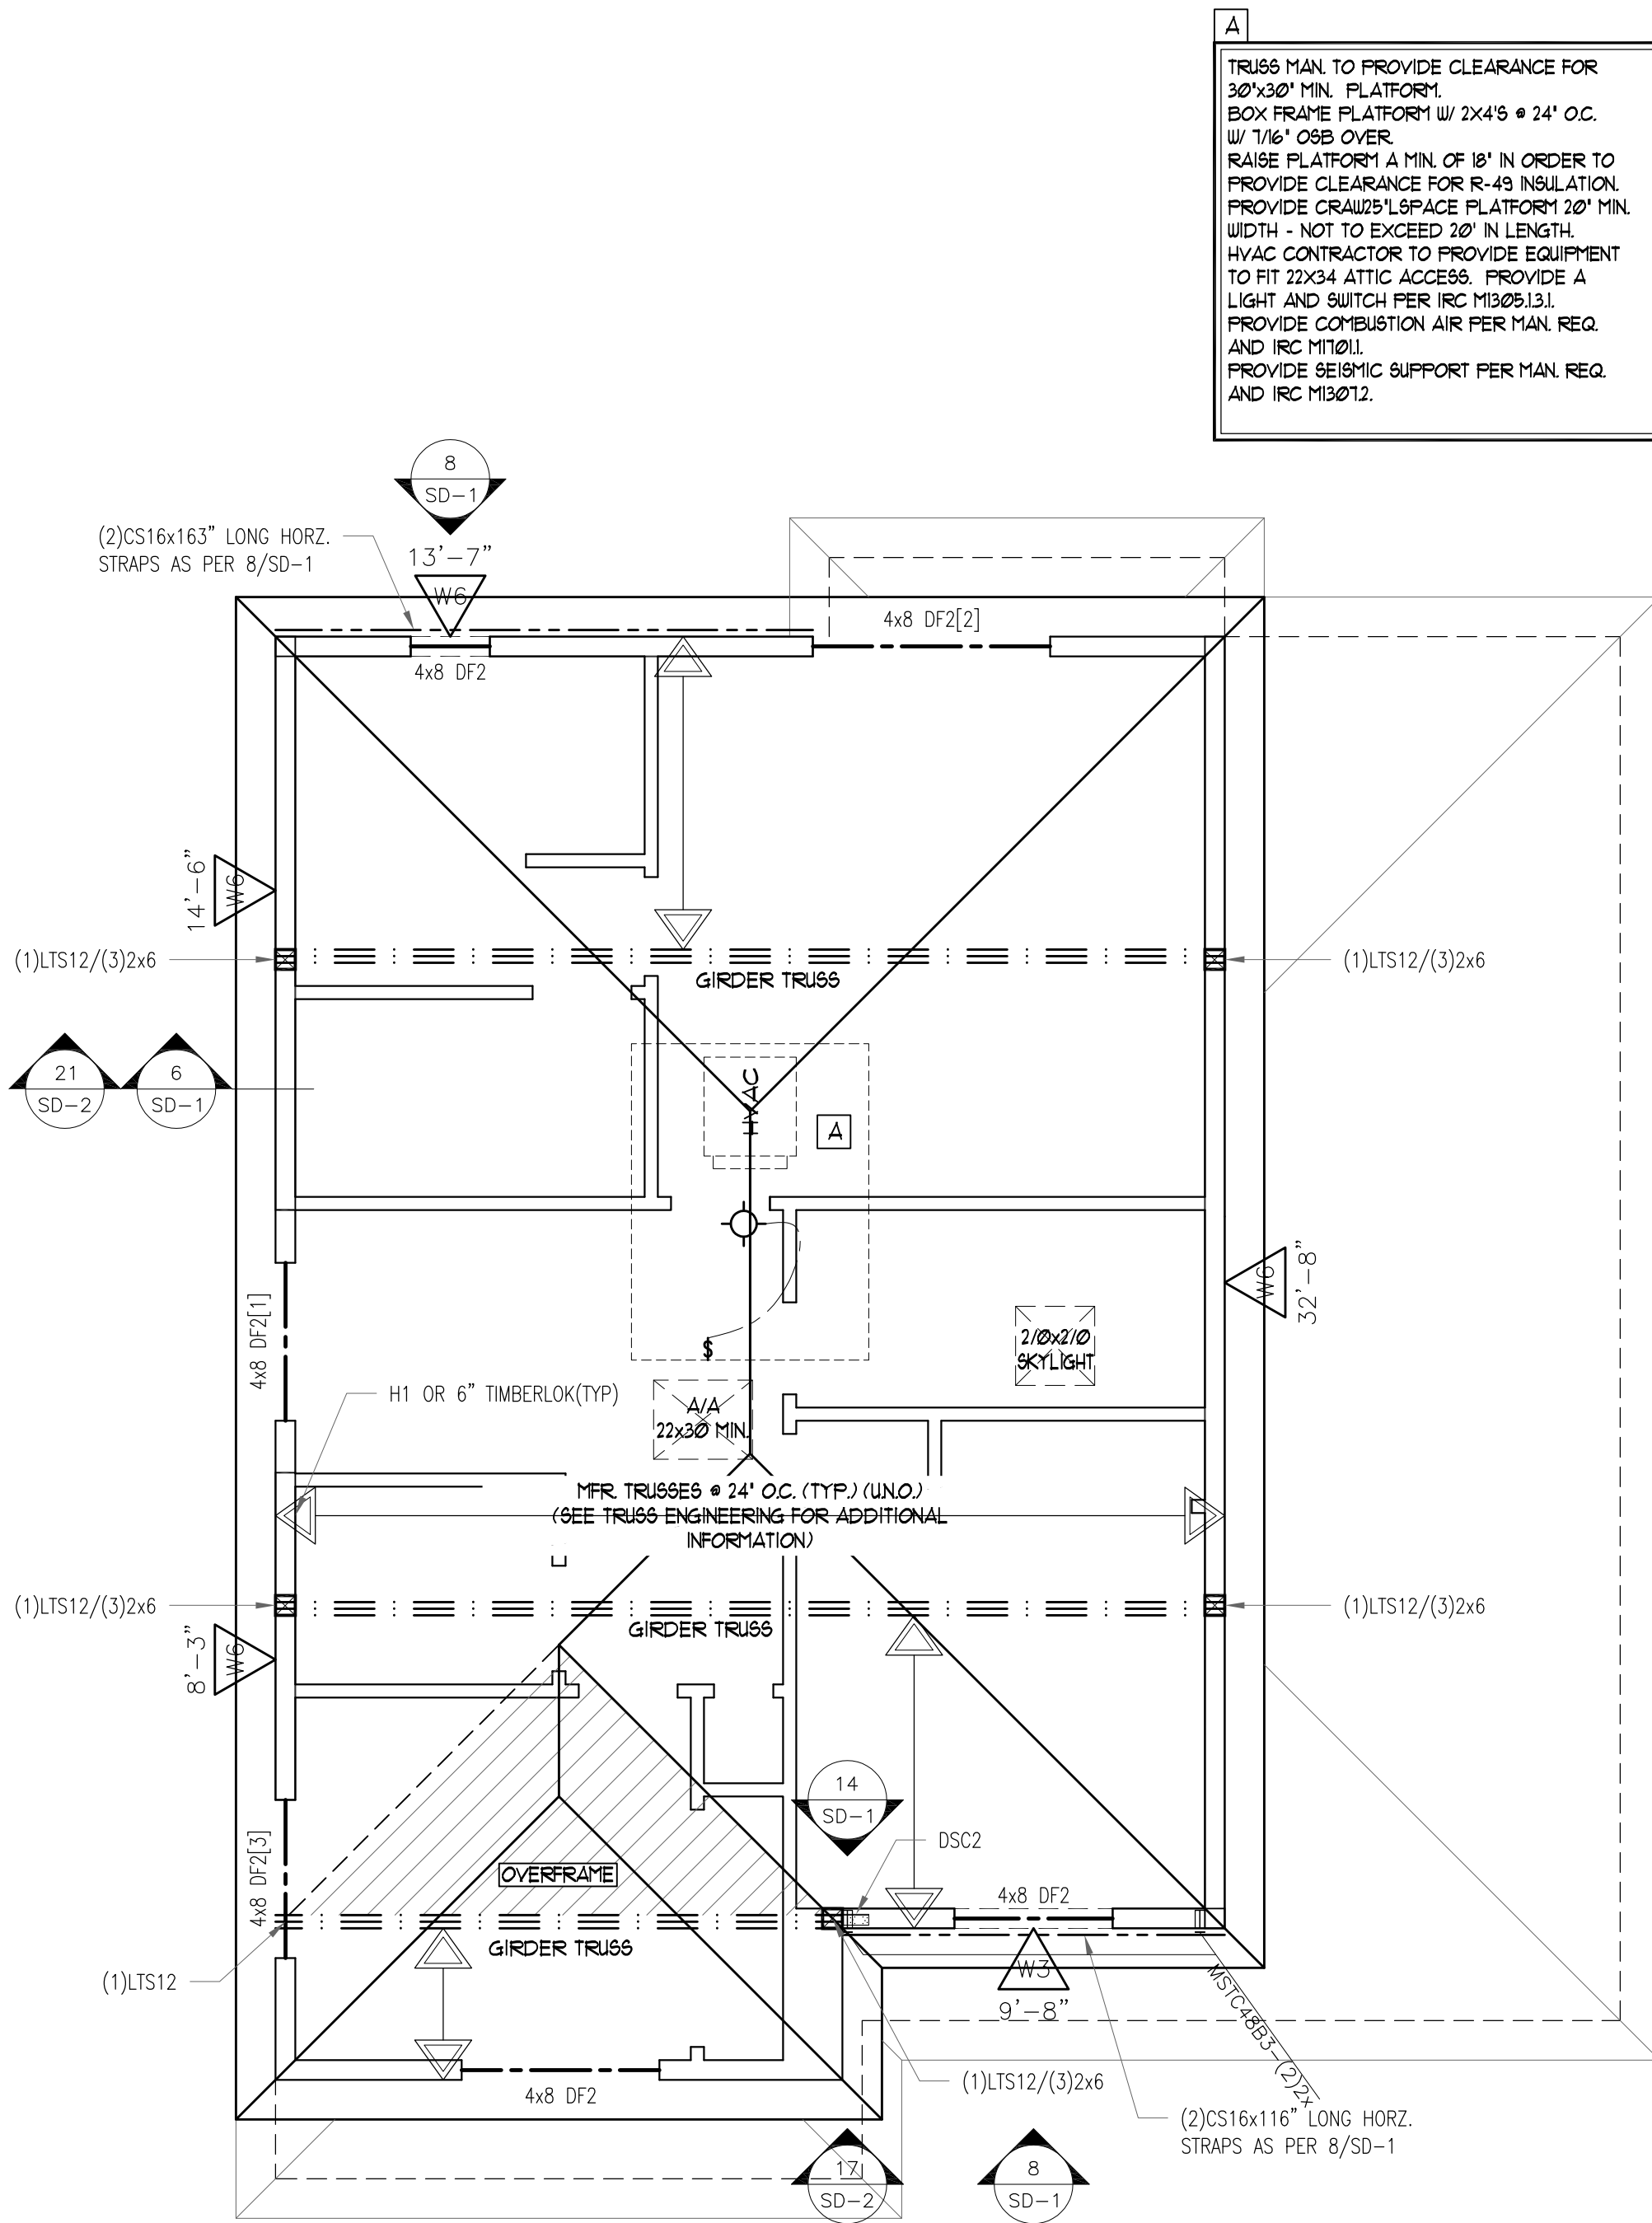


Full manufactured truss engineering shall be available on-site at framing inspection

ROOF FRAMING/UPPER FLOOR SW PLAN 'B

NOTE: ALL OVERFRAMED RAFTERS TO BE 2x6-24" O.C. FOR SPANS UP TO 8'-0", 2x8-24" O.C. FOR SPANS UP TO 11'-0"
2x10-24" O.C. FOR SPANS UP TO 14'-0".
NOTE: ALL CONNECTIONS TO SPECIFIED AND/ OR VERIFIED BY TRUSS MANUFACTURER
NOTE: ALL SOLID SAWN BEAMS TO BE DP2 OR BETTER
NOTE: ENGINEERING FOR SUPPORT OF ROOF FRAMING IS BASED ON THE PROVIDED ROOF TRUSS LAYOUT. VERIFY
CONSISTENCY WITH TRUSS MANUFACTURER'S ENGINEERING/ LAYOUT WHEN AVAILABLE.

$$1/4' = 1' - \emptyset'$$









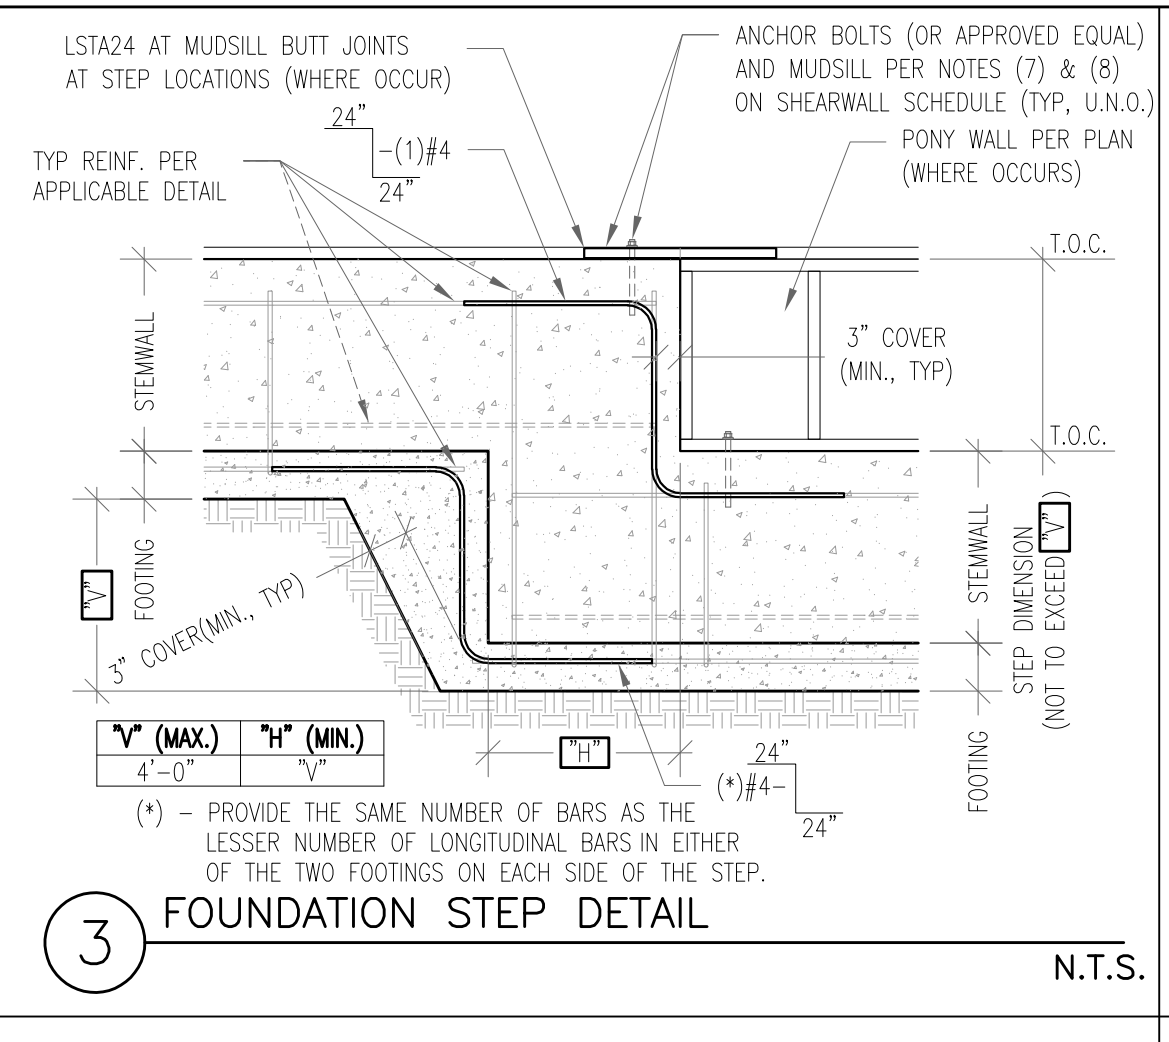
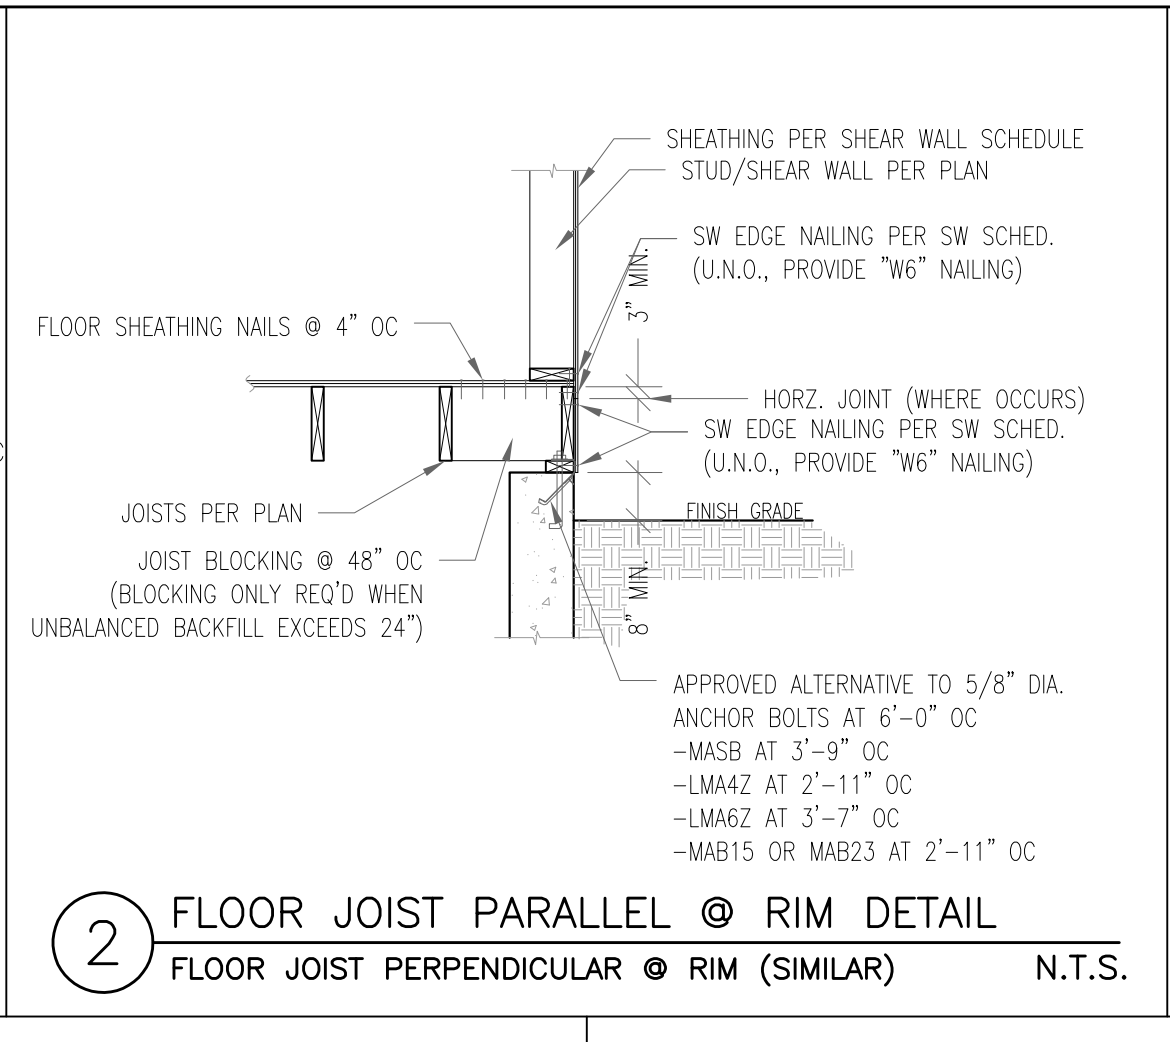
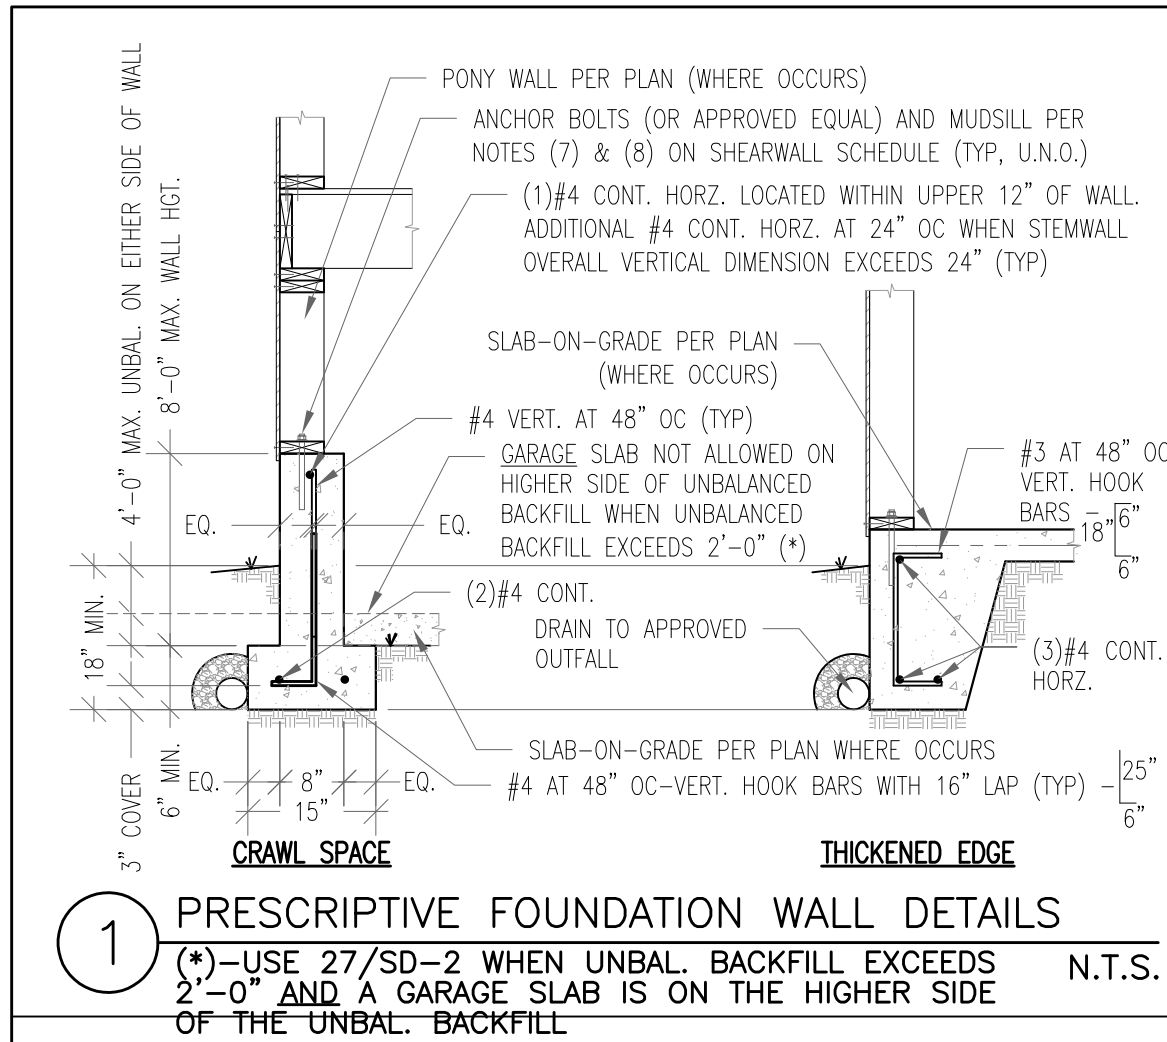


**BASIC PERMIT PACKAGE
 REVIEWED FOR CODE COMPLIANCE
 WITH IRC 2015
 KITSAP COUNTY BUILDING DEPARTMENT**

*Reviewed for code compliance
 with IRC 2015
 Kitsap County Building Department
 lasmith@co.kitsap.wa.us
 10/02/2020*

Subject To Field Inspection

**CHANGES
 MUST Be Approved Prior
 To Performing Work**

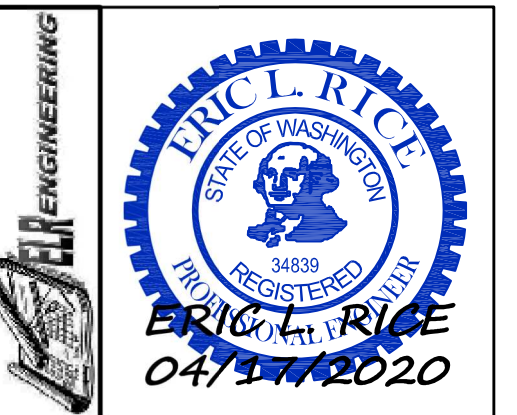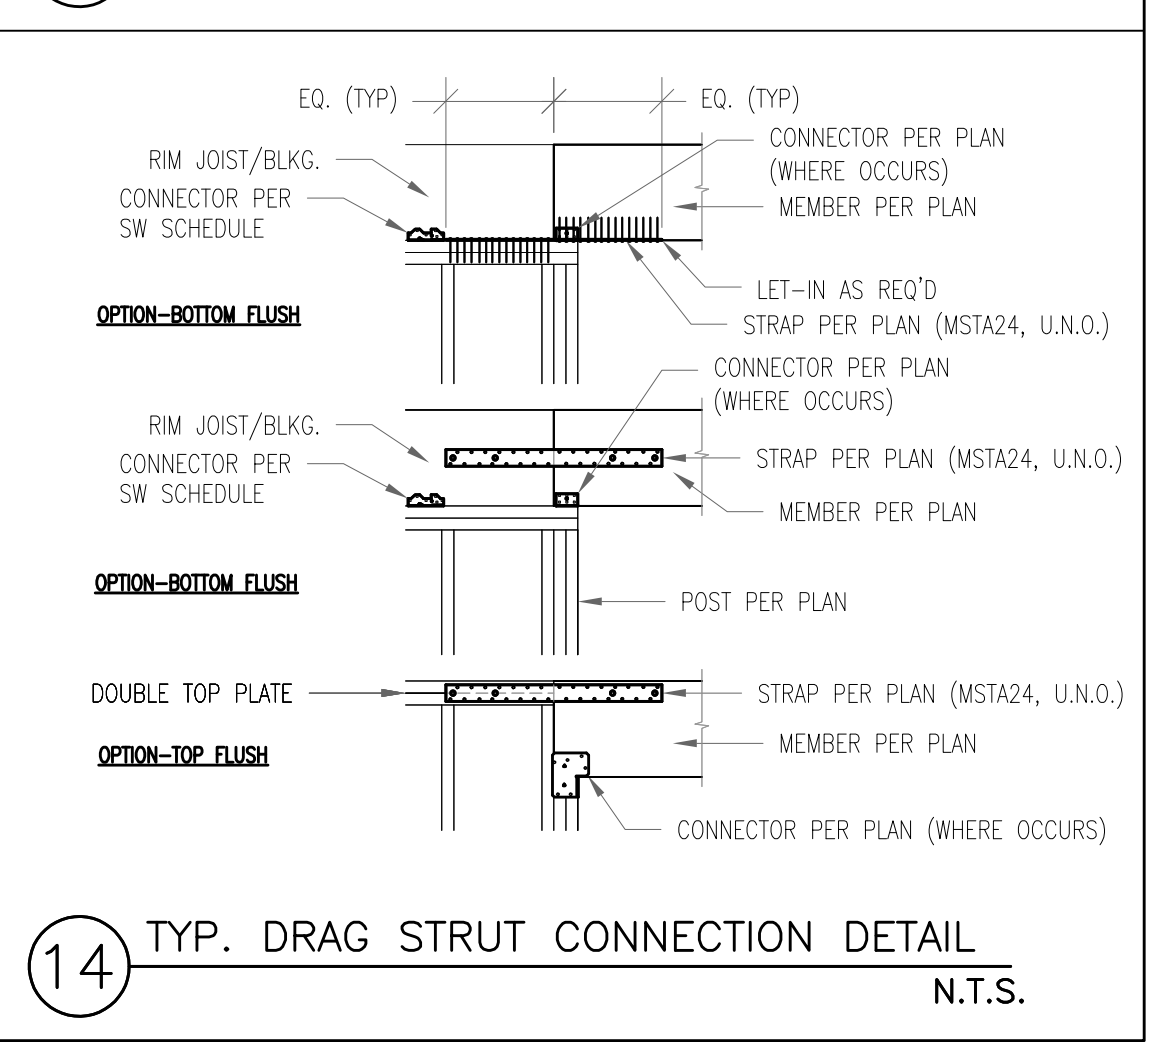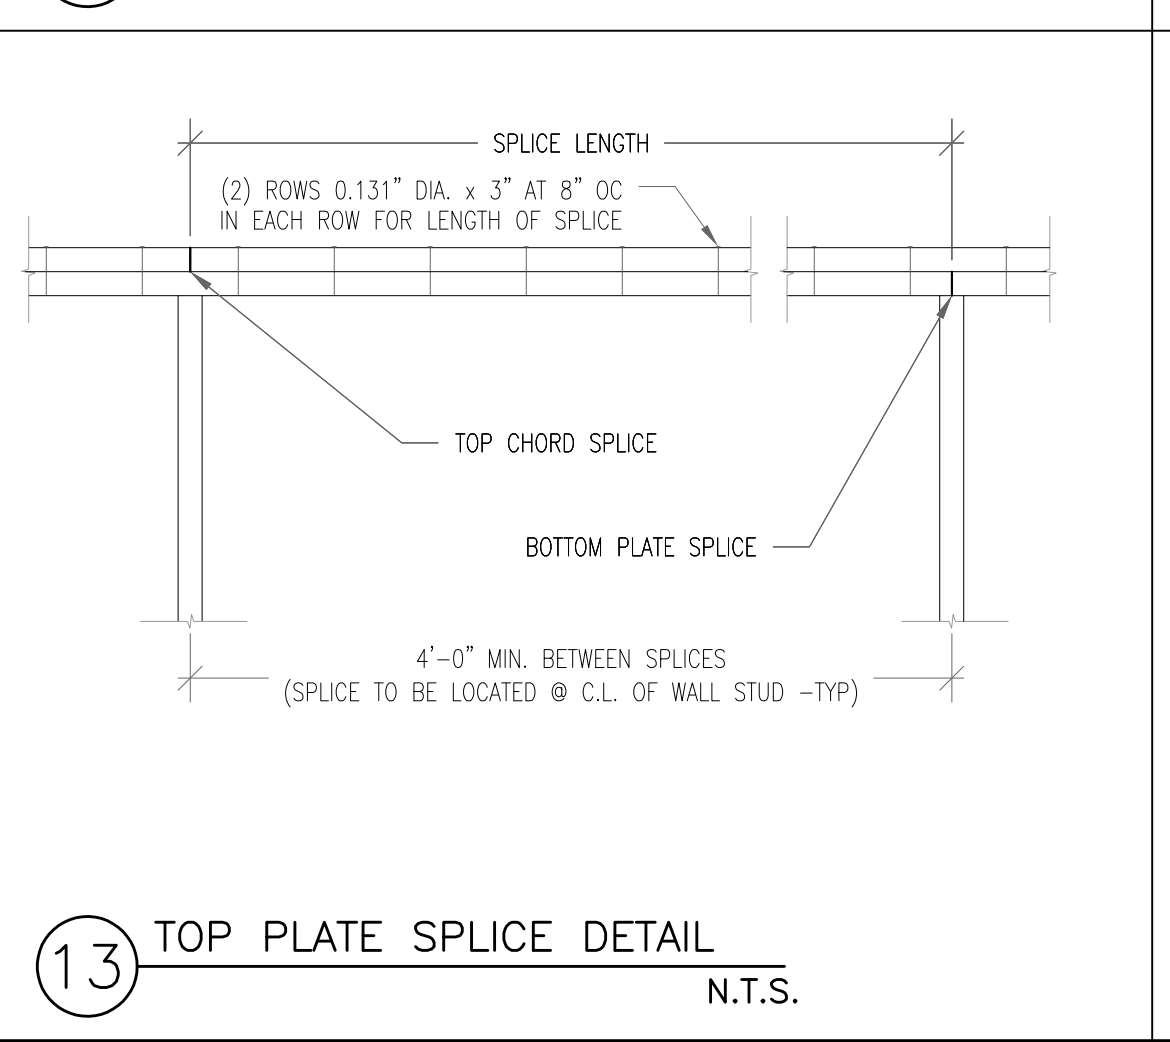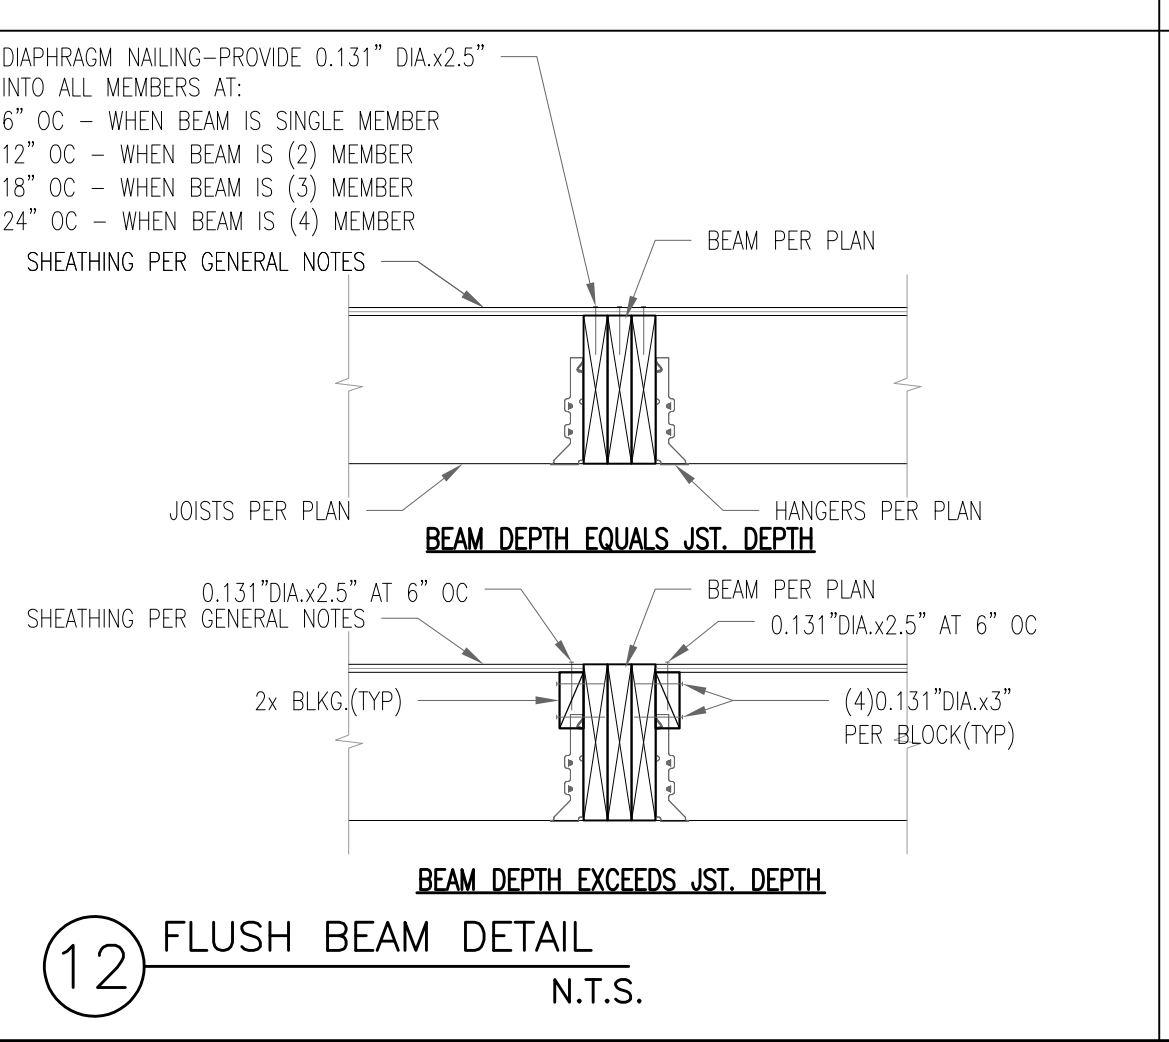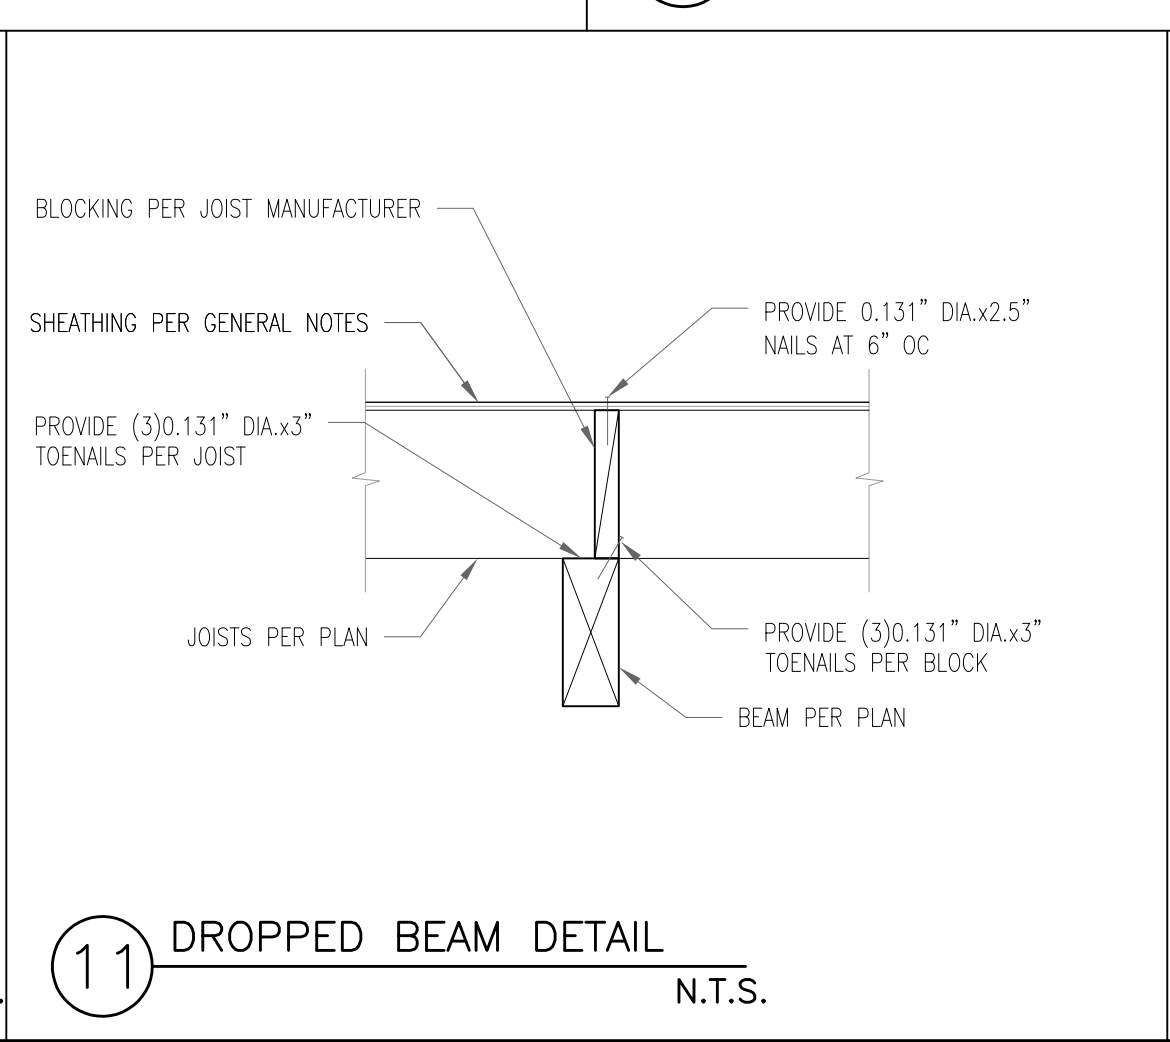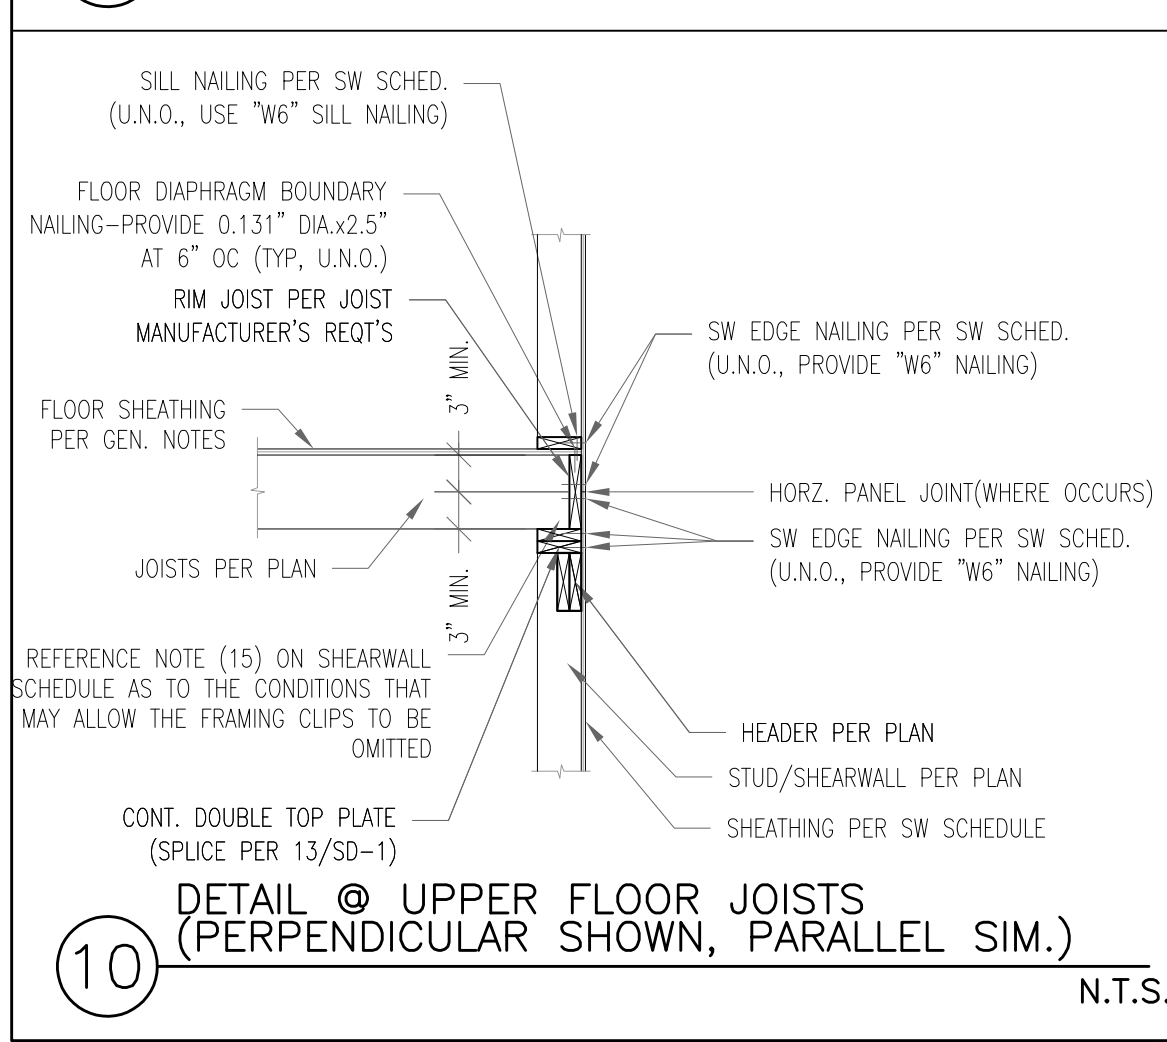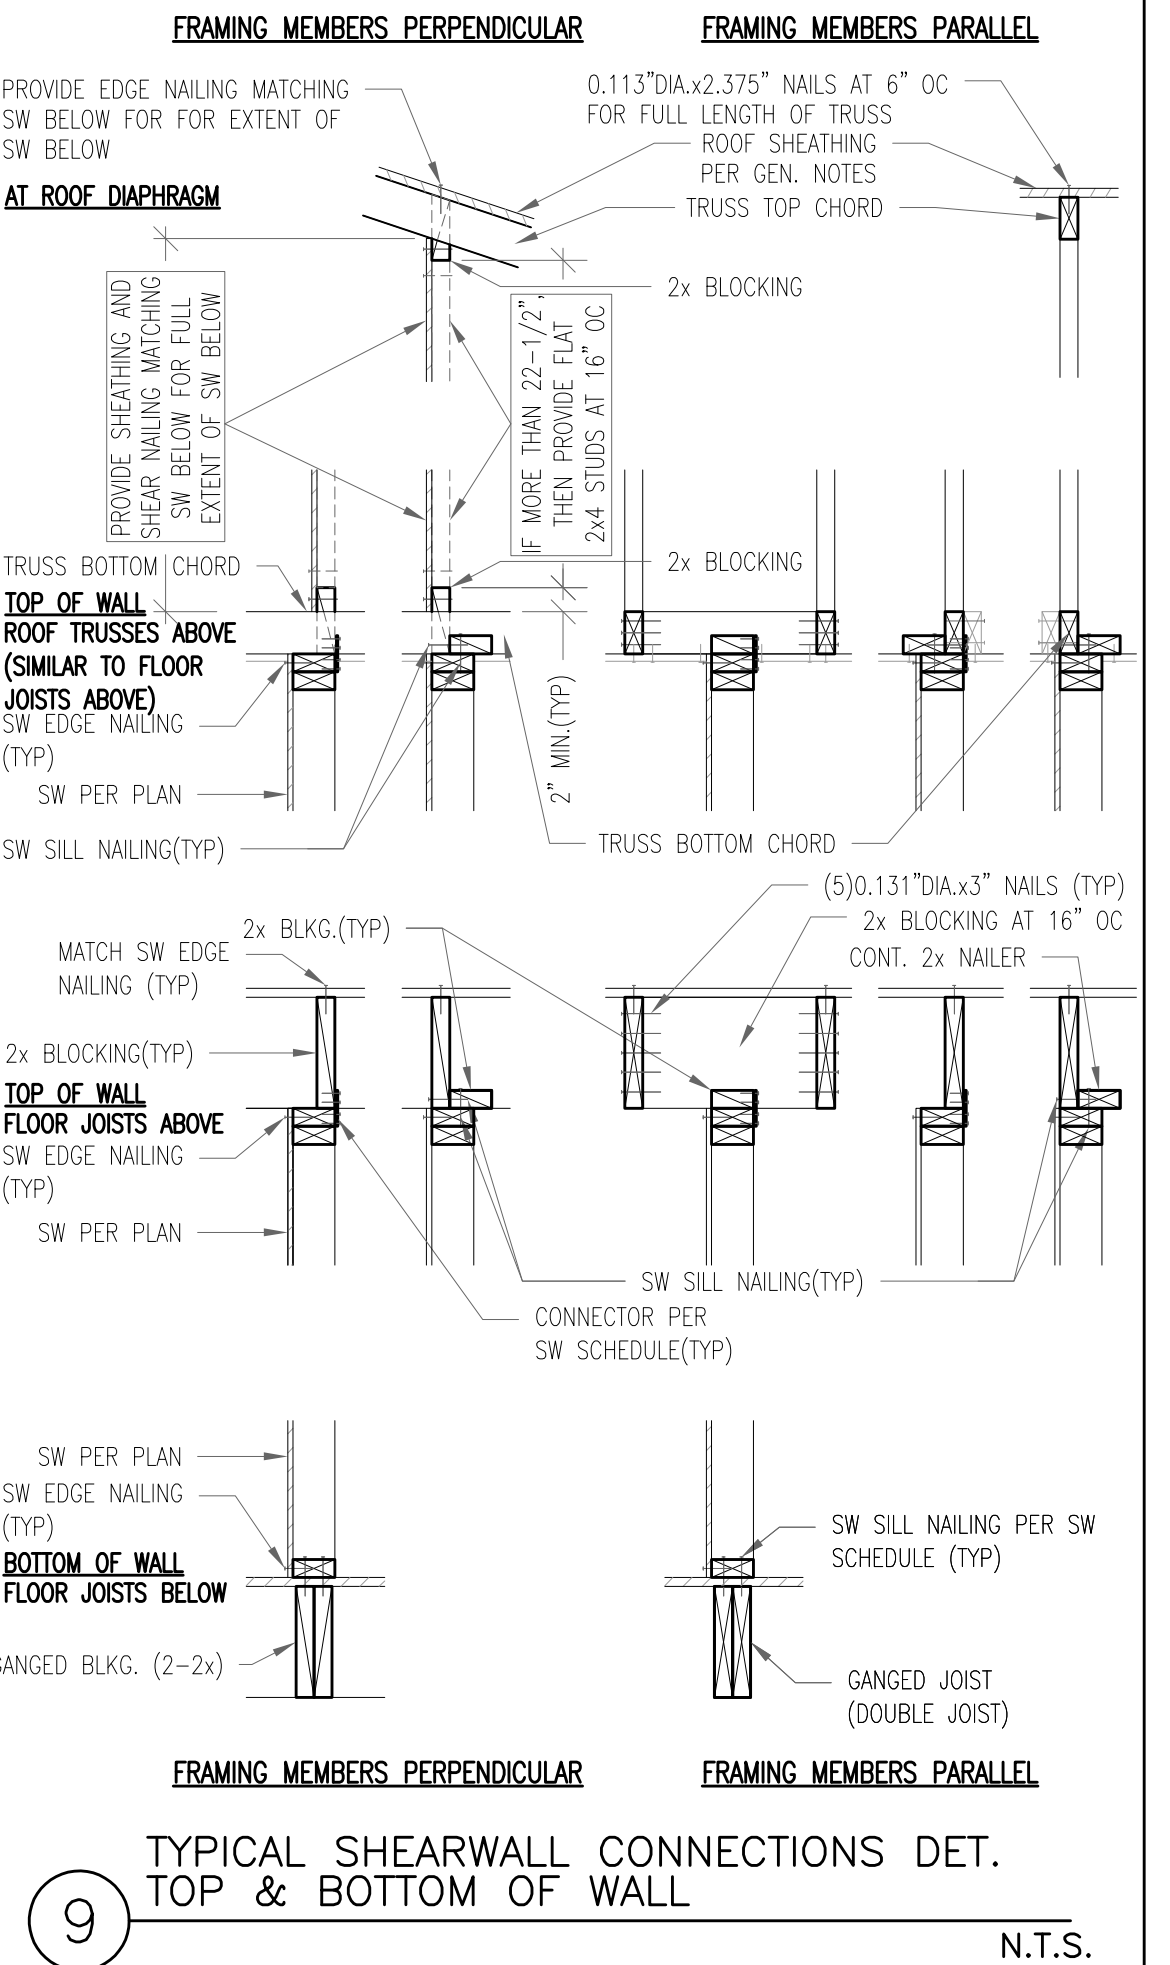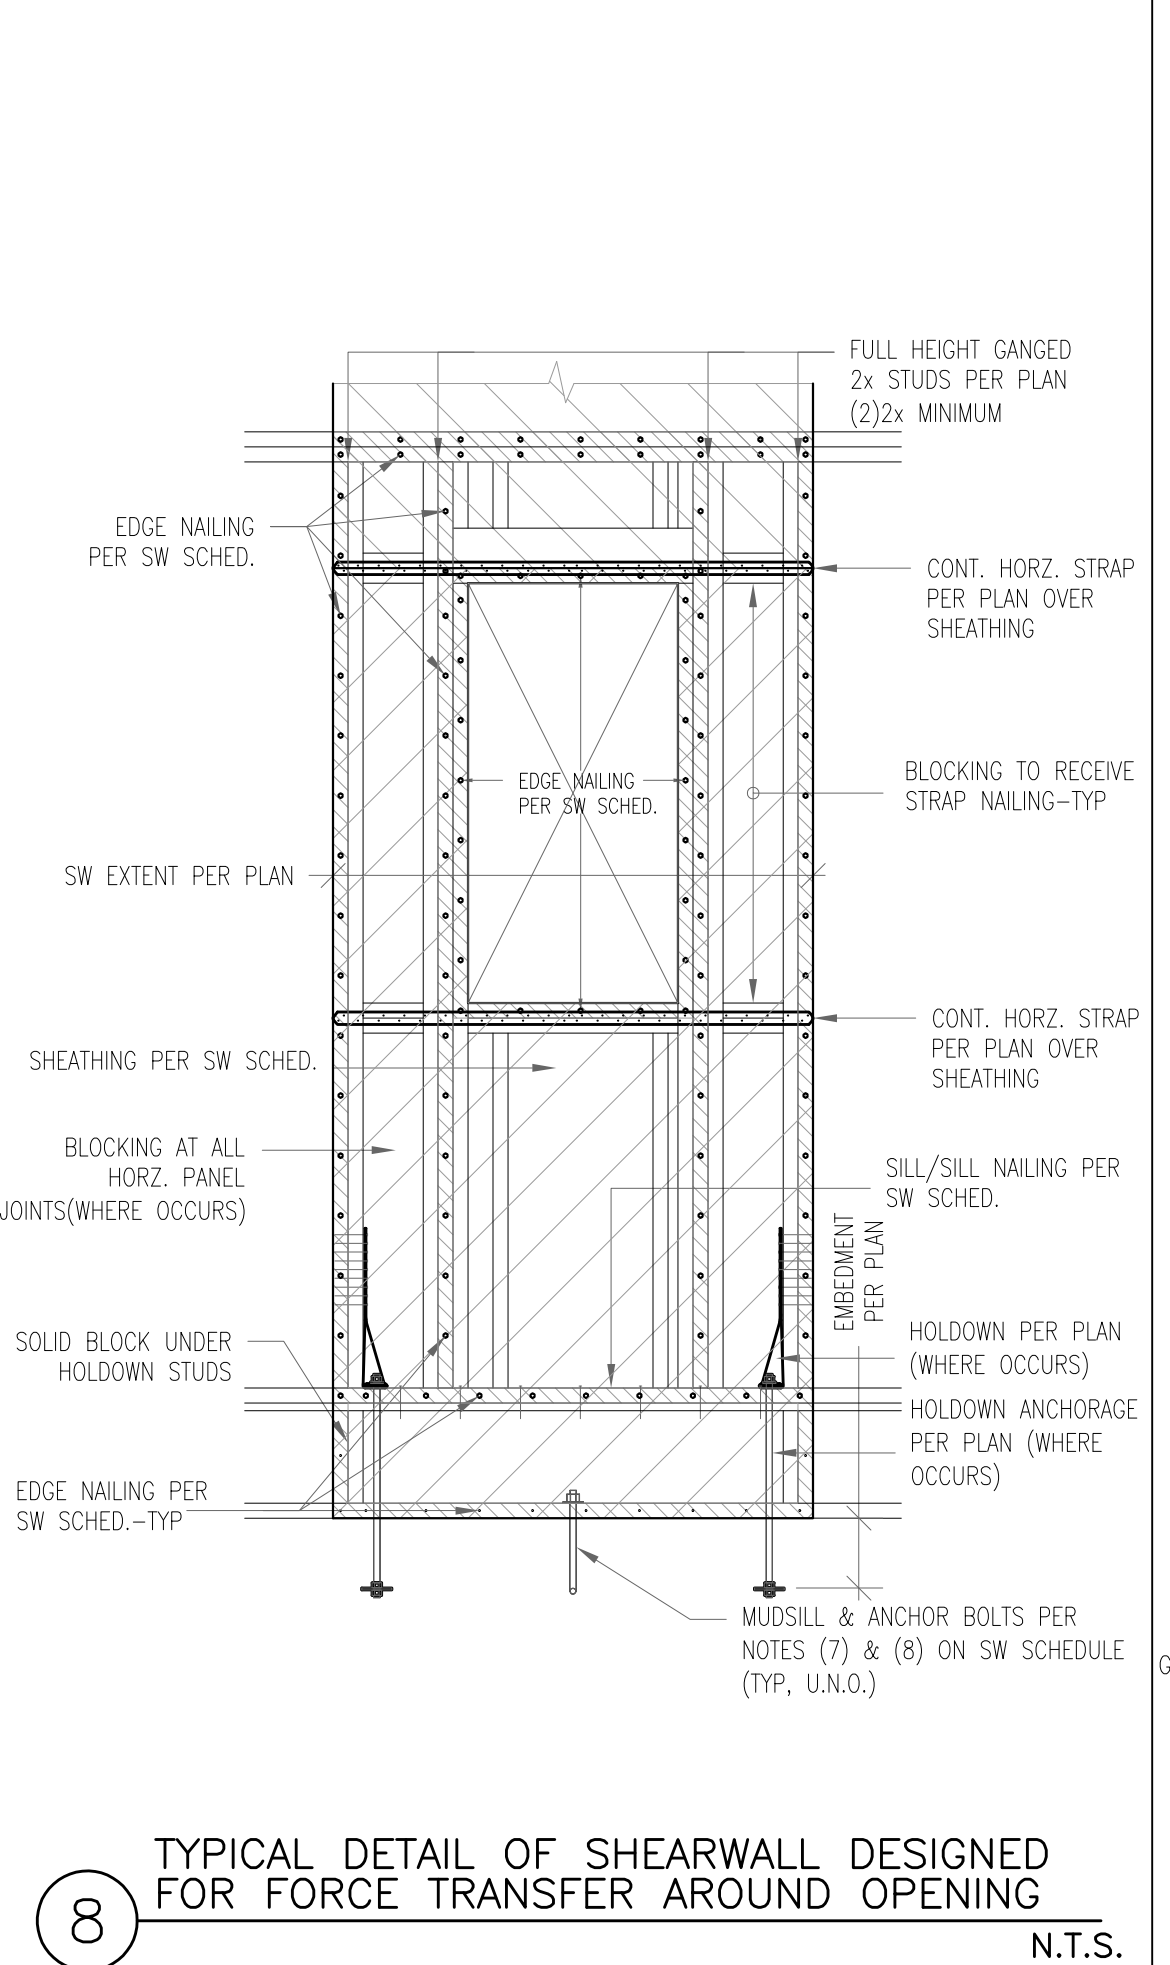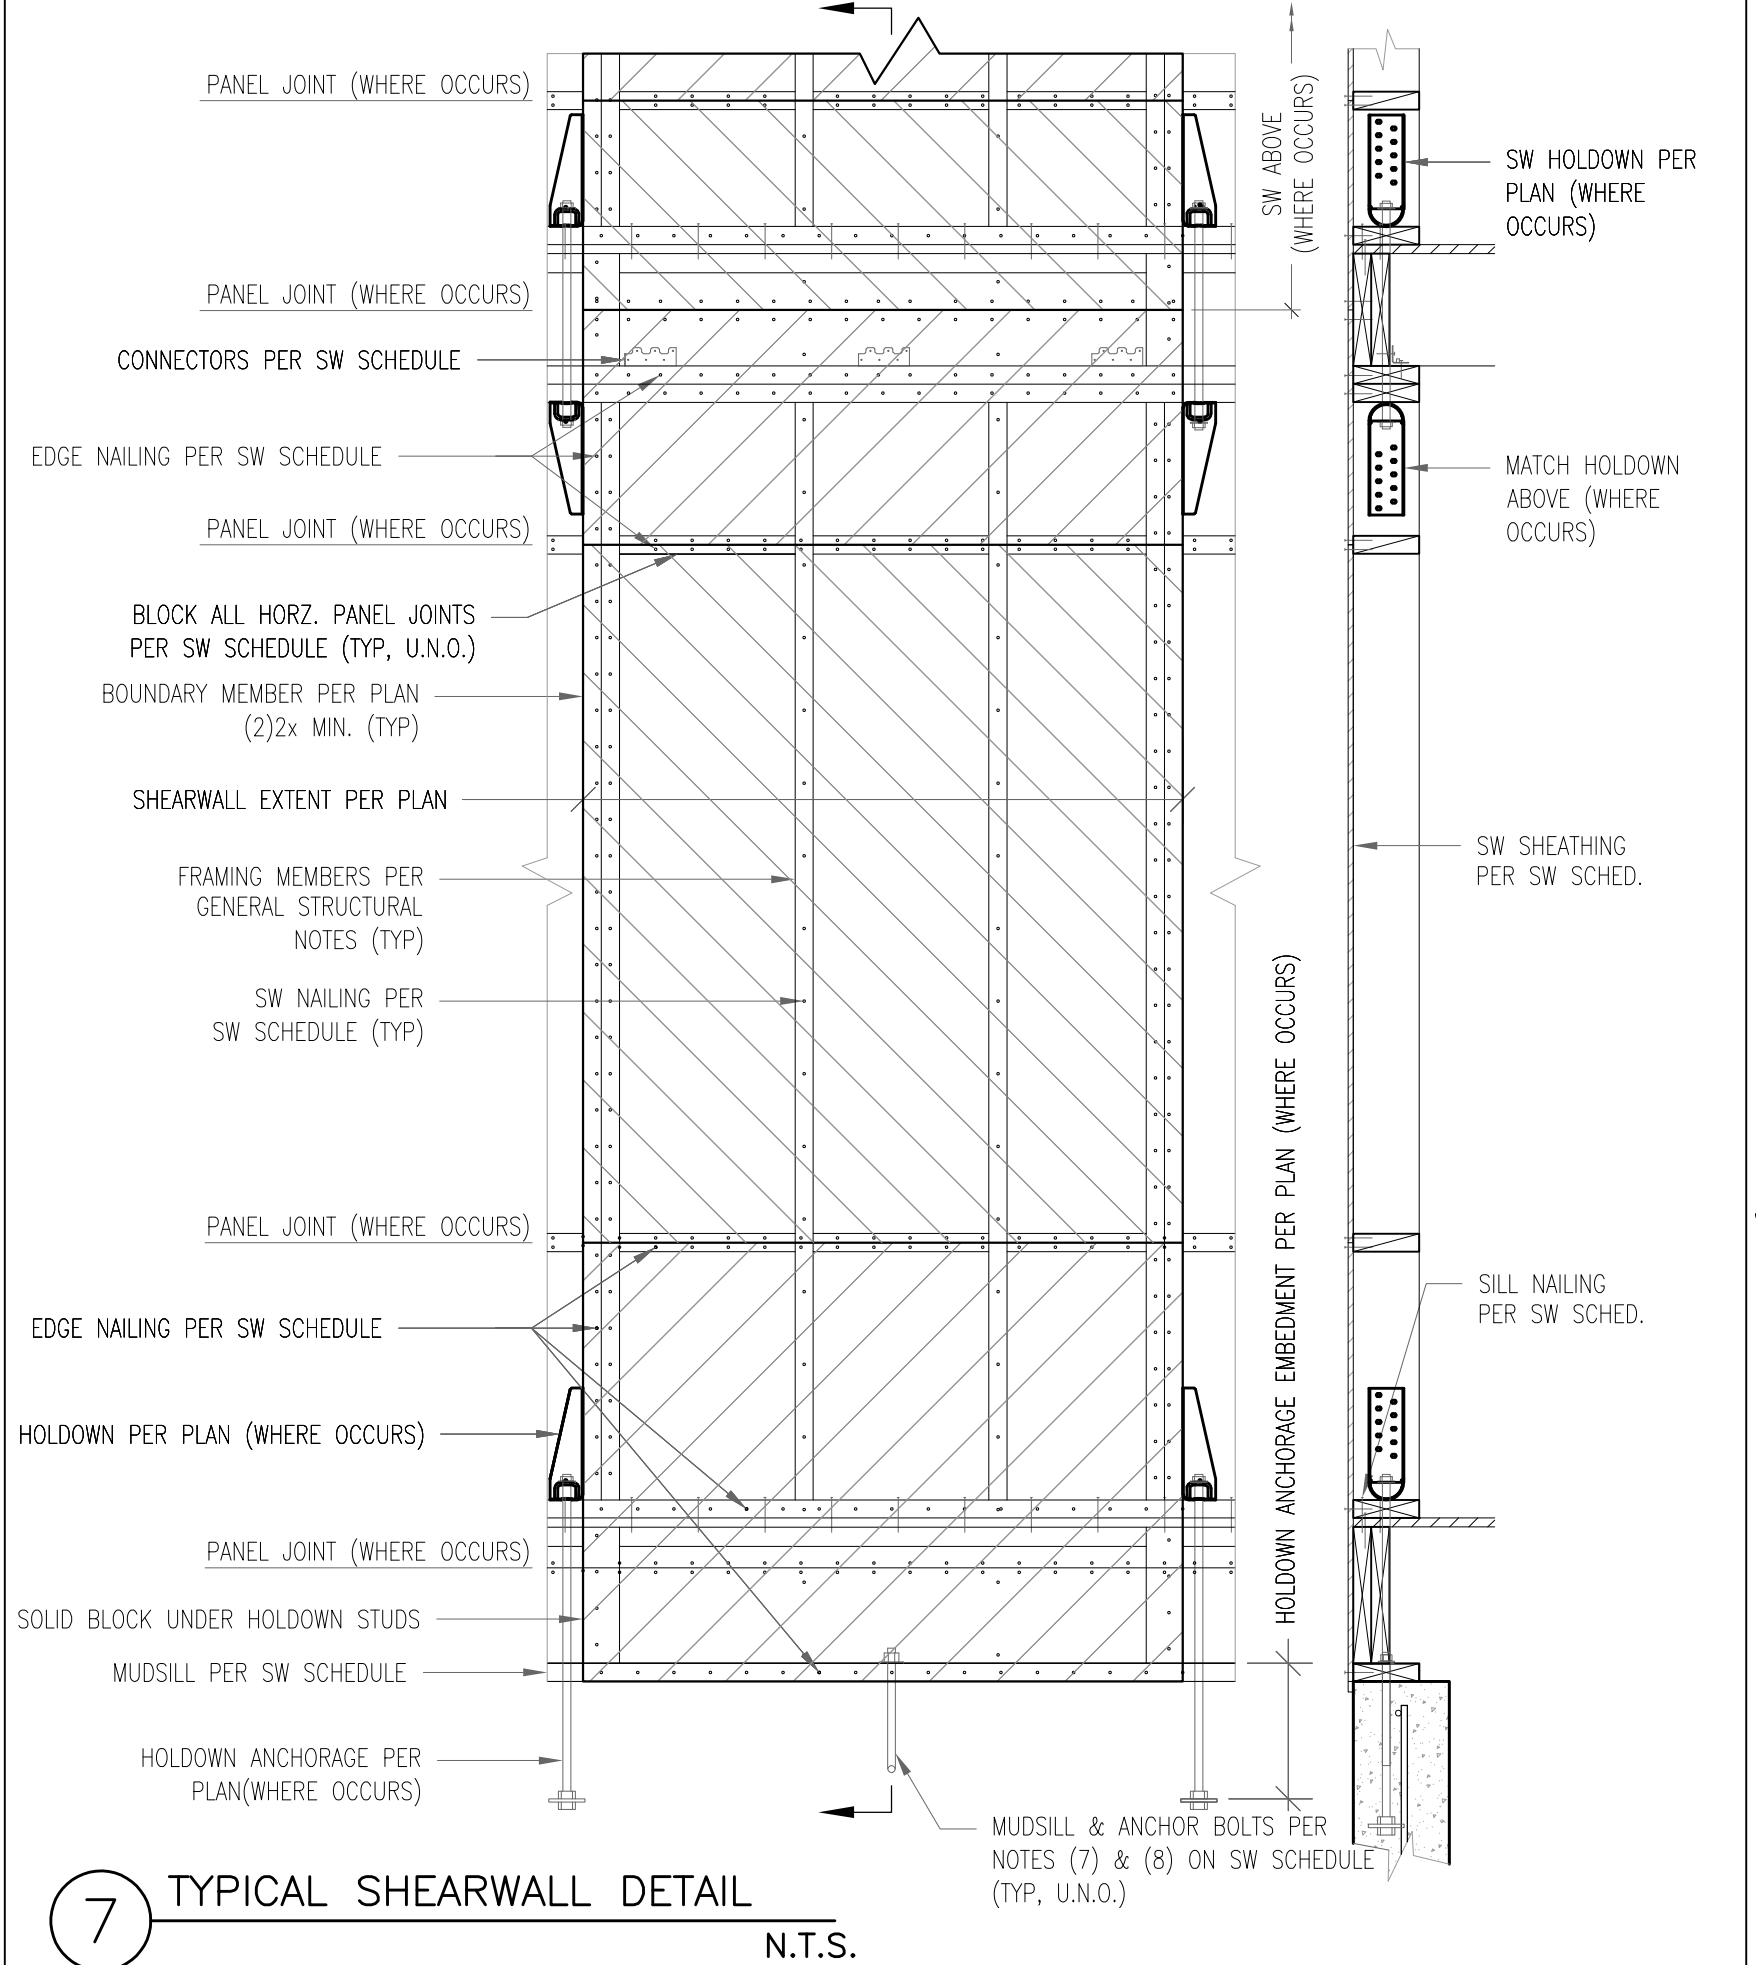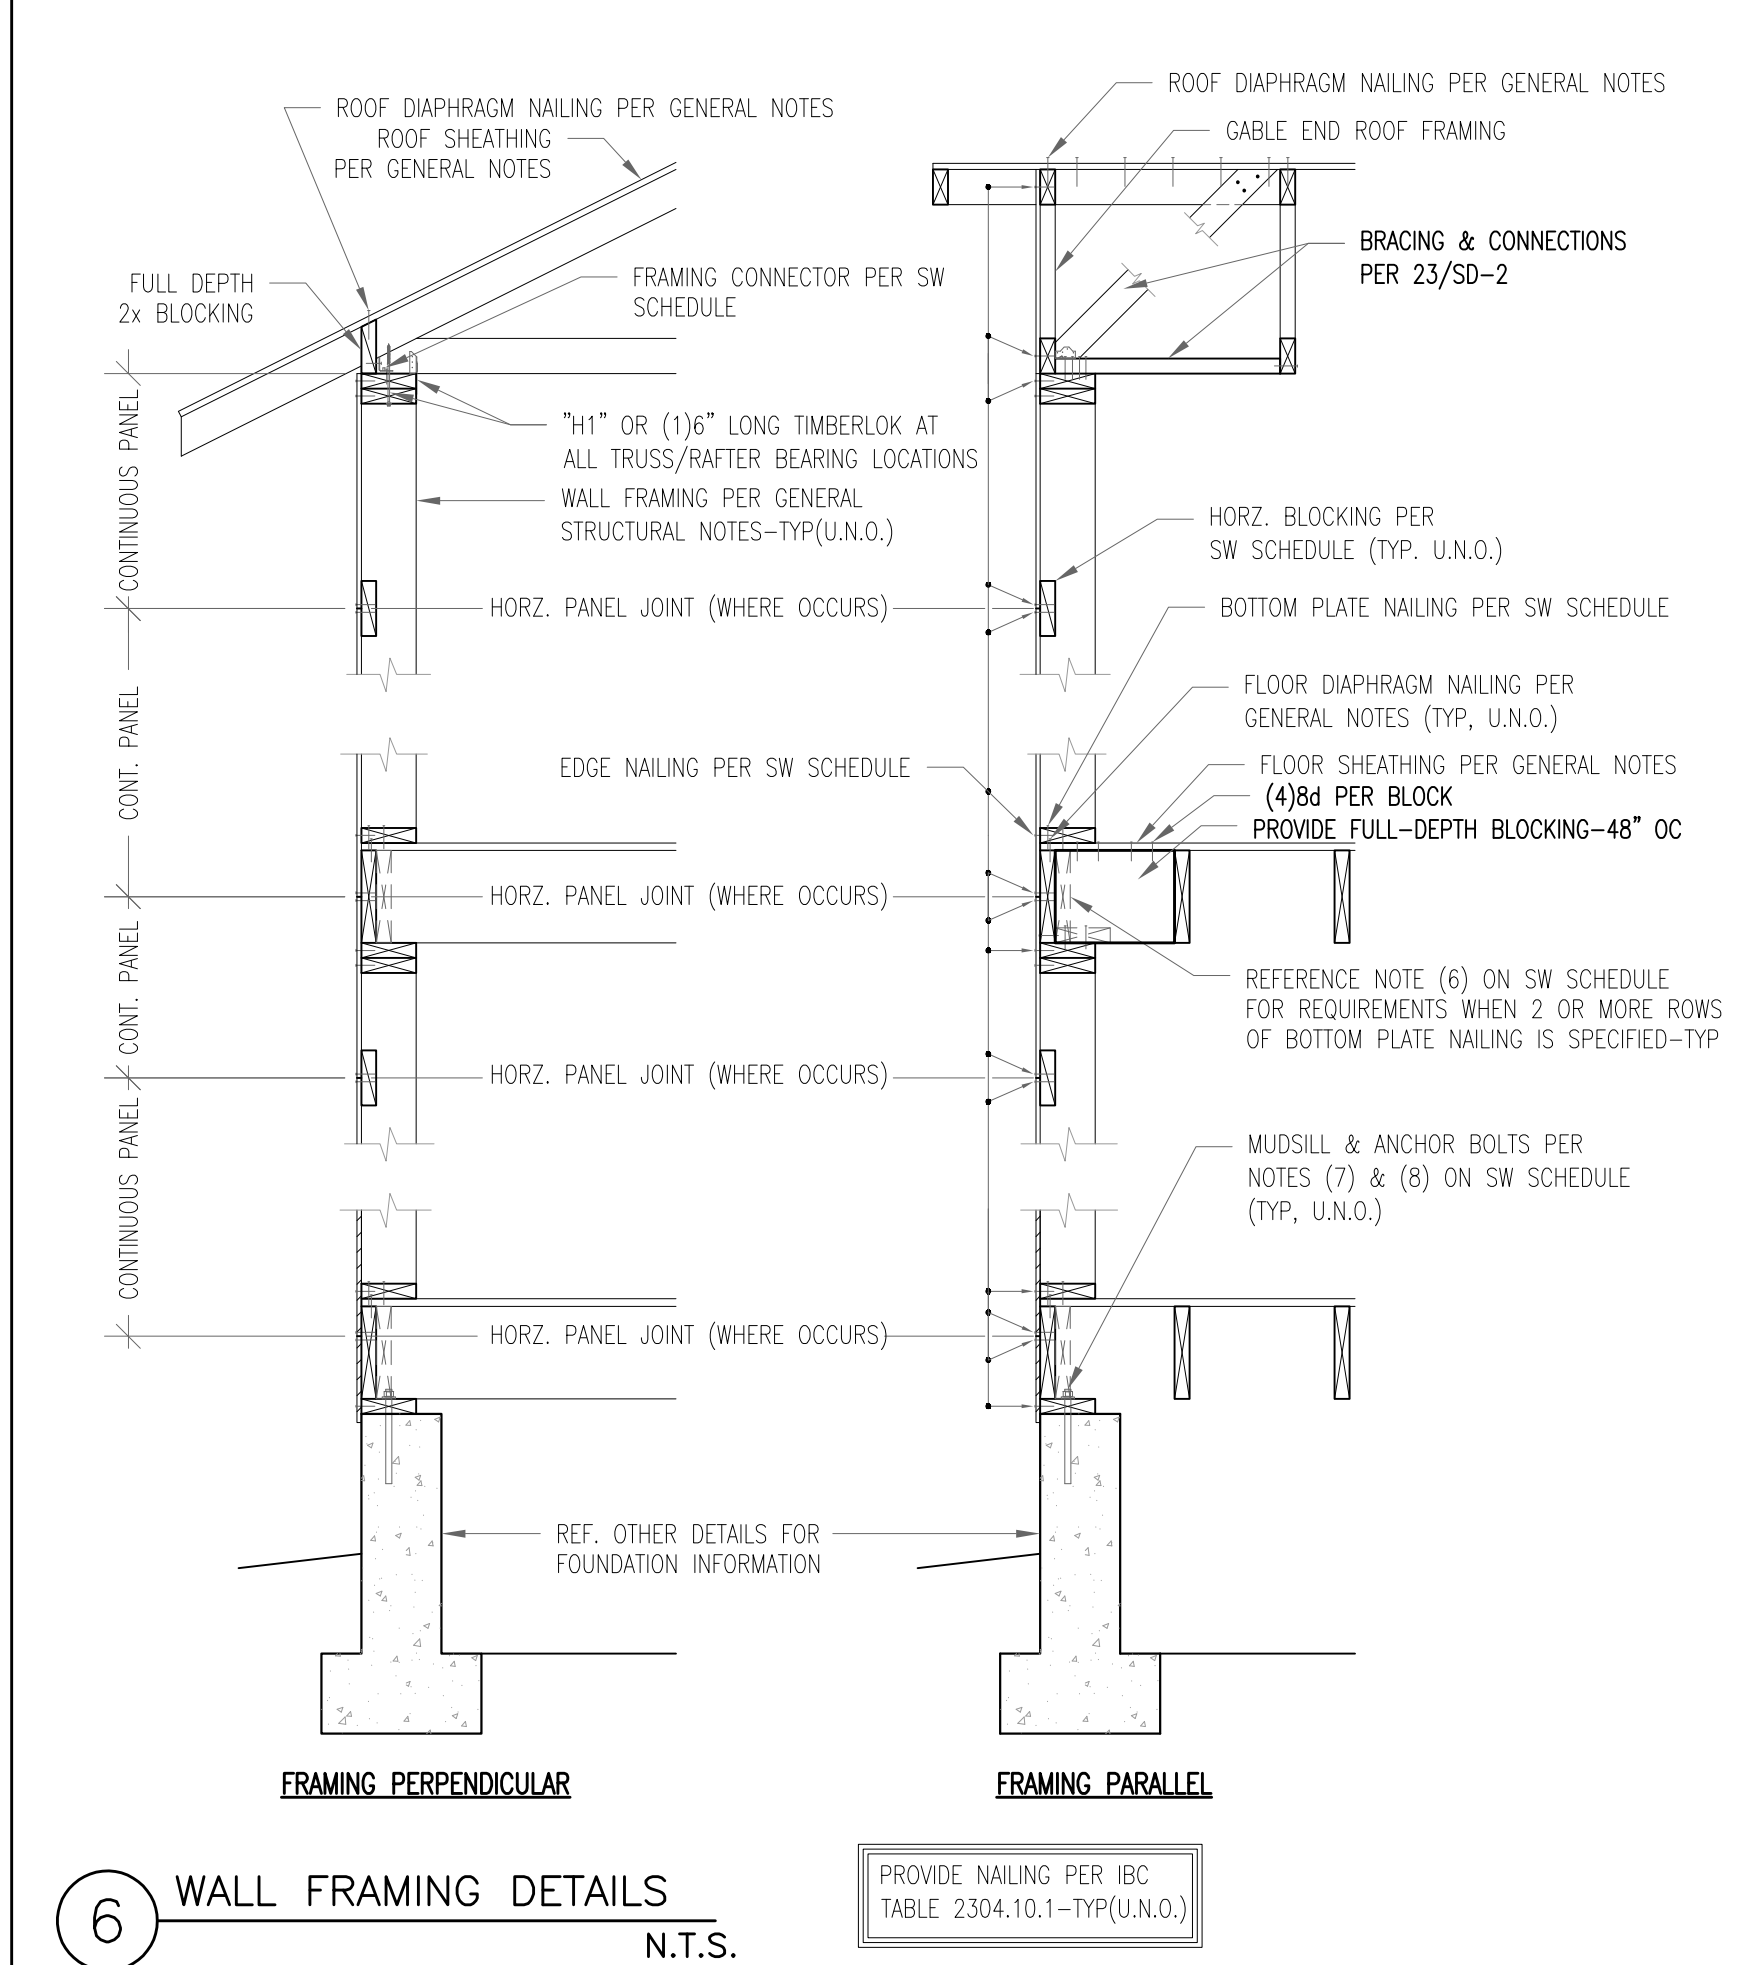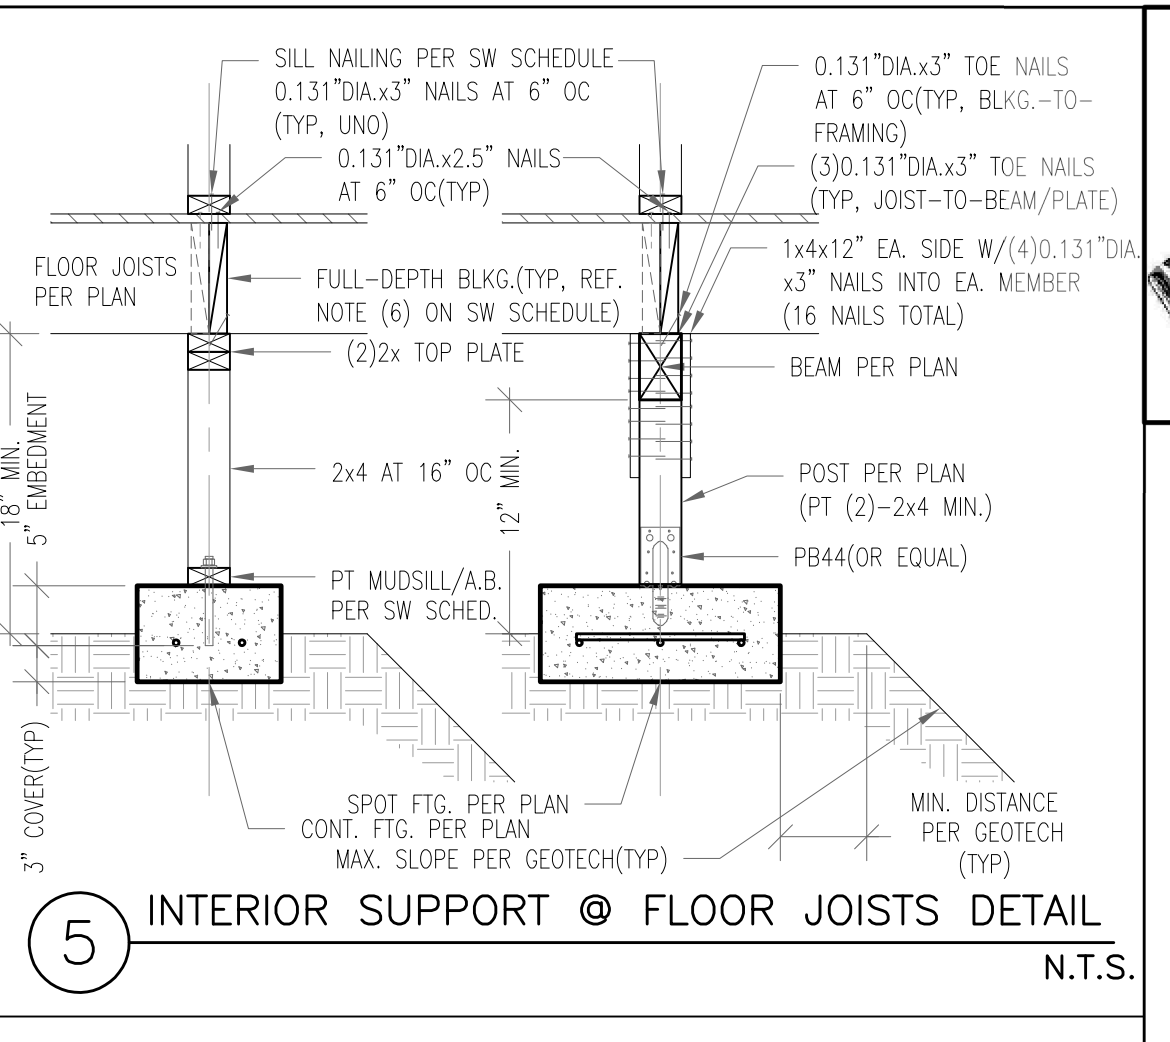




Copyright © 2020, Rueppell, Inc.

Rueppell
 Home Design

Plan: 1572 AB
 Job#: Kitsap Base Plan
 Date: 04/16/20
 Revision Date:
 Drawn by:
 Phone: (253) 297-8040

[SD-1]

Subject To Field Inspection

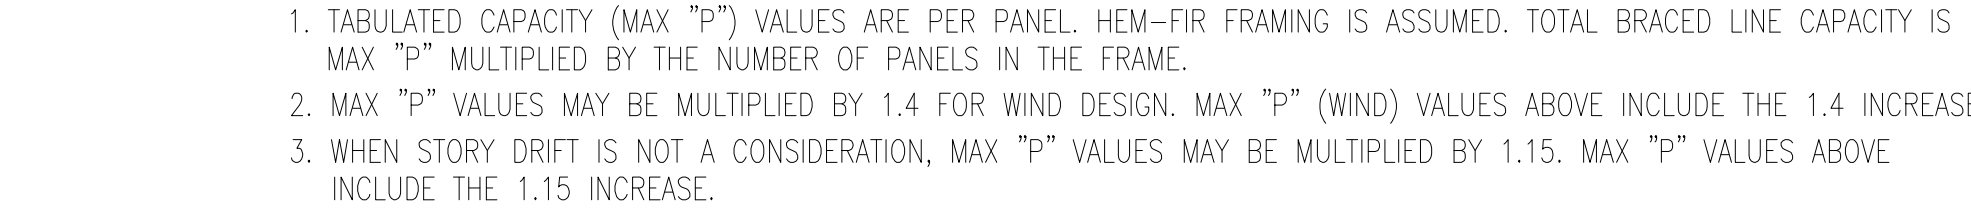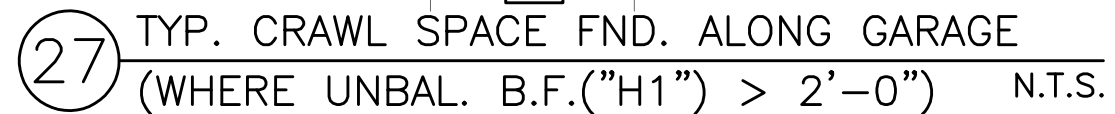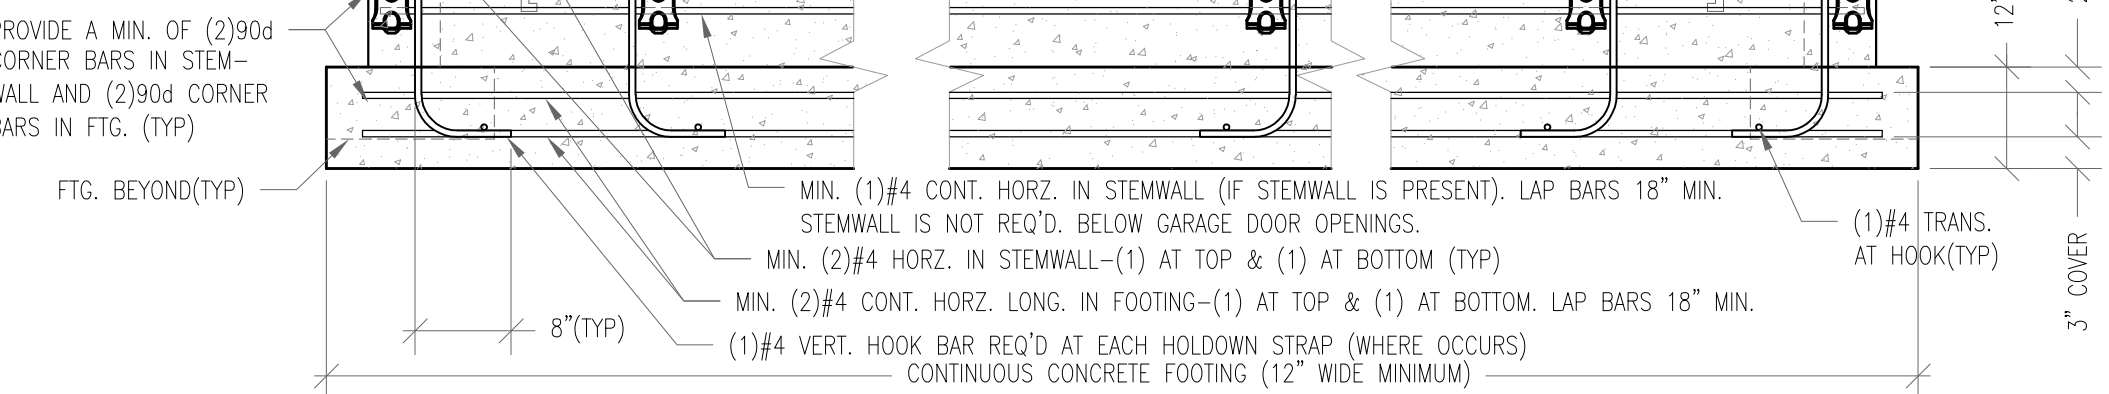

28 TYPICAL DETAIL FOR PORTAL FRAME FOR ENGINEERED APPLICATIONS N.T.S.

