

			ABBRE'	VIATIONS			
(FO)	MNER FURNISH, CONTRAC ANTRACTOR FURNISH, CON MIER FURNISH, OWNER I AND AT CENTER LINE DIAMETER OR ROUND PERPENDICULAR POUND OR NUMBER ABOVE ACOUSTICAL ACO	NTRACTOR NOTALL PLAT. (PETL) PL	DOUBLE DEPARTMENT DETAIL DIAMETER DIMENSION DOUMENT(S) DOWN DOOR DOWNSPOUT DRAWING EAST EMENSION JOINT ELEVATION ELECTRICAL ELEVATOR EACH SIDE ENCLOSURE ELECT. PANEL BOARD EQUAL EQUIPMENT EXISTING EXPOSED EXTERIOR FILEOR DRAIN FIRE EXTINGUISER FIRE HYDRANT FINISH	HILL WAS P. D. W. S. L.	HOSE BIBB HOLLOW CORE HOLLOW CORE HOLLOW CORE WOOD DOOR HANDICAPPED HARDWOOD HARDWARE HANGER HOLLOW METAL HORIZONTAL HOUR HEIGHT INTERNATIONAL BLDG CODE INSIDE/INTERIOR DIMENSION INFORMATION INSTALLATION INSTALLATION INTERIOR INTL RESIDENTIAL CODE LAMINATED POUND LOCATION LINEAR FEET LANDSCAPE MATERIAL MAXIMUM MANUFACTURER MANUALE MINIMUM MISCELLANEOUS MOUNTED	S. S	SOUTH SOLID CORE SOLID CORE WOOD DOOR SCHEDULE STRUCTURAL ENGINEER SECTION SHEET SHEATHING SHOWER SIMILAR SPECIFICATION SQUARE SHELF & ROD STATION STANDARD STEEL STORAGE STRUCTURAL SUSPENDED STAIN & VARNISH SERVICE SYMMETRICAL TREAD TOP OF CURB TELEPHONE TEMPERED (T) TONGUE & GROOVE THICK / THICKNESS TOP OF PAVEMENT TOP OF PLATE TYPICAL TOP OF WALL
BM. BRG.	BEAM BEARING	FE. FH.	FIRE EXTINGUISER FIRE HYDRANT	MIN. MISC.	MINIMUM MISCELLANEQUS	T/PL TYP.	TOP OF PLATE TYPICAL
CAR CATTR CO. CON. CONSTR. CONT. CAT. CTR. CTSK.	CLEAR COUNTER CLEAN OUT COLUMN CONCRETE CONNECTION CONSTRUCTION CONTINUOUS CERAMIC TILE CENTER COUNTERSUNK	GA. GALV. GL. GND. GR. (GRD.) GWB. GYP.	GALVANIZED GLASS GRAND GRADE GYPSUM WALL BOARD GYPSUM	PL. PL.YWD. PP. R. RAD. REG. REG. REGNTS. REGMTS.	PLATE PLYWOOD POWER POLE RISER / RADIUS RADIUS RADIUS ROOF DRAIN RECOMMENDED RETERENCE REINFORCED REQUIRED REQUIREMENTS ROOM	W. W./ W.D. W/D. W/M. W/O WP WR. WSCT. WT.	WEST WITH WATER CLOSET (TOILET) WOOD WASHER / DRYER WINDOW WATER HEATER WITHOUT WATERPROOF WATER RESISTANT WAINSCOT WEICHT WELDED WIRE FABRIC

PROJECT TEAM

<u>CLIENT / OWNER :</u>

ENVISION NW, LLC 19819 NE 68TH ST. SUITE B KIRKLAND, WA 98099 INFOGENVISIONNORTHWEST COM \$106-614-7888 DESIGNER/ARCHITECT

ADM ARCHITECTURE 5819 NE MINDER RD. STE. C POULSBO, WA. 98370 PH: 360-881-0181 INFO@ADM-ARCHITECTURE COM

WWW.ADM-ARCHITECTURE.COM STRUCTURAL ENGINEER:

PACIFIC NORTHWEST STRUCTURAL GROUP, LLC 6/33 NE MALBON CT. KINGSTON, WA 98346 PH: 360-303-1803 E: distarkel@msn.com

SHEET INDEX

ARCHITECTURAL SHEETS A-10 COVER SHEET, SYMBOLS & APPREVIATIONS

A-12 ARCHITECTURAL GENERAL NOTES

A-1.3 WSEC & IMC CODE COMPLIANCE NOTES A-1.4 ARCHITECTURAL CODE COMPLIANCE NOTES - GENERAL CONSTRUCTION

A-15 ARCHITECTURAL CODE COMPLIANCE NOTES - INTERIORS & HVAC A-16 ARCHITECTURAL CODE COMPLIANCE NOTES - PLIMBING & ELECTRICAL

A-2.1 DUPLEX FLOOR PLANS - FIRST FLOOR A-22 DUPLEX FLOOR PLANS - SECOND FLOOR A-2.3 DUPLEX FLOOR PLANS - THIRD FLOOR

A-2.4 DUPLEX ROOF PLAN - DESIGN OPTION "A" (GABLED) A-2.5 DUPLEX ROOF PLAN - DESIGN OPTION """ (HIPPED)

A-34 EXTERIOR ELEVATIONS OPT. "B" - REAR & LEFT

A-3.| EXTERIOR ELEVATIONS OPT. "A" - FRONT & RIGHT A-32 EXTERIOR ELEVATIONS OPT. "A" - REAR & LEFT A-3.3 EXTERIOR ELEVATIONS OPT. """ - FRONT & RIGHT

A-4. BUILDING CROSS SECTION & PARTY WALL / FIRE ASSEMBLY NOTES A-42 BUILDING LONGITUDINAL SECTION

A-5.| DETAILS - WALL & FLOOR & ROOF TYPICAL ASSEMBLIES A-5.2 DETAILS - TYPICAL CONSTRUCTION DETAILS

A-5.3 DETAILS - TYPICAL CONSTRUCTION DETAILS A-54 DETAILS - TYPICAL CONSTRUCTION DETAILS

A-55 DETAILS - TYP. AREA SEPARATION WALLS SECTION DETAIL A-56 DETAILS - TYPICAL WINDOW WRAP / FLASH / INSTALL INFO.

STRUCTURAL SHEETS 5-10 STRUCTURAL NOTES & SCHEDULES 5-1.1 STRUCTURAL NOTES & SCHEDULES

5-20 Plans - SHEAR WALLS 5-2. PLANS - FOUNDATION / FLOOR FRAMING

5-12 Plans - 2ND FLOOR FRAMING 5-2.4 PLANS - UPPER ROOF FRAMING (VERIFY "A" OR "B" DESIGN DWGS.)

S-3. DETAILS S-32 DETAILS S-3.3 DETAILS S-34 DETAILS

REVISIONS

INT. DATE REV

DESIGNER: \emptyset

PROJECT NO: 19198

SHEET NO:

Ø5/17/18

DRAFTER:

DATE:

Established Basic Permit # 19-03650

MUST Be Approved Prior

To Performing Work

7. LOWERED WINDOWS AND JALOUSIES COMPLYING WITH THE FOLLOWING: REGULAR, FLOAT, WIRED OR PATTERNED

EDGES. LONGITUDINAL EDGES MAY NOT HAVE EXPOSED WIRE. 8. MIRRORS AND OTHER GLASS PANELS MOUNTED OR HUNG ON A SURFACE THAT PROVIDES A CONTINUOUS BACKING

9. SAFETY GLAZING IN HAZARDOUS LOCATIONS, ITEMS 10 AND 11 IS NOT REQUIRED WHERE: 9.1 THE SIDE OF A STAIRWAY, LANDING OR RAMP HAS A GUARDRAIL OR HANDRAIL, INCLUDING BALLISTERS OR

GLAGS SHALL BE NO THINNER THAN NOMINAL 3/8-INCH AND NO LONGER THAN 48 INCHES WITH SMOOTH EXPOSED

IN-FILL PANELS, COMPLYING WITH THE PROVISIONS OF SECTIONS 1012 AND 1607.7 OF THE 2012 1.13C; AND 92 THE PLANE OF THE GLASS IS GREATER THAN 18 INCHES FROM THE RALING.

FASTENERS AND ANCHORAGES: PROVIDE NAILS, SCREWS AND OTHER ANCHORING DEVICES OF TYPE, SIZE, MATERIAL AND FINISH SUITABLE FOR INTENDED USE AND REQUIRED TO PROVIDE SECURE ATTACHMENT, CONCEALED WHERE POSSIBLE. HOT-DIP GALVANIZED FASTENERS FOR WORK EXPOSED TO EXTERIOR AND HIGH HUMIDITIES TO COMPLY WITH ASTM A 153.

STANDING AND RUNNING TRIM: INSTALL WITH MINIMUM NUMBER OF JOINTS POSSIBLE, USING FULL-LENGTH PIECES FROM MAXIMUM LENGTH OF LUMBER AVAILABLE. COPE AT RETURNS, MITER AT CORNERS TO PRODUCE TIGHT FITTING JOINTS. USE SCARF JOINTS FOR END-TO-END JOINTS.

INSTALL FINISH CARPENTRY WORK PLIMB, LEVEL, TRUE AND STRAIGHT WITH NO DISTORTIONS. SHIM AS REQUIRED USING CONCEALED SHIMS. SCRIBE AND CUT FINISH CARPENTRY ITEMS TO FIT ADJOINING WORK. ANCHOR FINISH CARPENTRY WORK SECURELY TO SUPPORTS AND SUBSTRATES. USING CONCEALED FASTENERS AND BLIND NALING WHERE POSSIBLE. USE FINE FINISHING NAILS FOR EXPOSED NAILING EXCEPT AS INDICATED, COUNTERSUNK AND FILLED Flugh with finished surface.

ALL FLASHINGS TO BE 26 GA GALVANIZED METAL OR ALLMINUM ALLOY ANODIZED FINISH. INSTALL FLASHINGS IN ALL LOCATIONS TO MAKE BUILDING WATERTIGHT. THESE AREAS WOULD INCLUDE BUT NOT BE LIMITED TO COPINGS, CAPS, GRAVEL STOPS, BEAM CAPS, DRIP CAPS OVER DOORS WINDOWS AND OTHER OPENINGS, AND ROOF AND WALL INTERSECTIONS.

<u>CAULKING AND SEALANT:</u> THE FOLLOWING OPENINGS IN THE BUILDING ENVELOPE SHALL BE CAULKED OR OTHERWISE SEALED TO LIMIT INFILTRATION. AROUND GLAZING AND DOOR FRAMES, BETWEEN THE UNIT AND THE INTERIOR SHEET ROCK OR THE rauch framing as shawn in details with spray foam sealer; between all exterior wall sale plates and THE STRUCTURAL FLOOR, USING TWO ROWS OF CAULKING AS SHOWN IN DETAILS; OVER ALL FRAMING JOINTS WHERE FLOORS OVER CONDITIONED SPACES INTERSECT EXTERIOR WALLS (E.G. AT RIM AND BAND JOISTS) AS SHOWN IN DETAILS; AROUND OPENINGS IN THE BUILDING ENVELOPE FOR DUCTS, PLUMBING, ELECTRICITY, TELEPHONE, AND CAPLE TELEVISION LINES IN WALLS, CEILINGS AND FLOORS; AT OPENINGS IN THE CEILING, (E.G. WHERE CEILING PANELS MEET INTERIOR AND EXTERIOR WALLS; AT EXPOSED BEAMS, MASONRY FIREPLACES, WOODSTOVE FILES, ETC.); AT PENETRATIONS. ALL OPENINGS IN THE AIR BARRIER INCLUDING SPACES AROUND PLUMBING, ELECTRIC CONDUITS AND BOXES, AND TELEPHONE SERVICE ENTRANCES. PENETRATIONS OF EXTERIOR CEILINGS AND WALLS BY METAL INSULTED FLUES SHALL BE SEALED ACCORDING TO MANUFACTURER'S SPECIFICATIONS; AT RECESSED LIGHTING FIXTURES IN UNHEATED AREAS, SEAL AROUND THE EXTERIOR CAN TO BE AIR TIGHT, THE MOUNTING FLANGE ON THE

EXTERIOR CAN IS CALLKED TO THE GIVB. AT ELECTRICAL OUTLETS; SEAL GAPS BETWEEN GIVB AND OUTLET BOX

ENERGY CODE REQUIREMENTS: (PRESCRIPTIVE SIMPLE FORM) VERTICAL GLAZING: U=0.18 OVERHEAD GLAZING: U=028 FLAT CEILINGS: R=R49 VAULTED CEILINGS: R=38 ABOVE GRADE WALLS: R=2| WALL INTERIOR - BELOW GRADE: R=2| WALL EXTERIOR - BELOW GRADE: R=10 FRAME FLOORS: R=36 SLAB ON GRADE: R=10 PERIMETER AND ENTIRE SLAB

ACCESS HATCHES AND DOORS: ACCESS DOORS FROM CONDITIONED SPACES TO UNCONDITIONED SPACES (E.G., ATTICS AND CRAIML SPACES) SHALL BE WEATHER-STRIPPED AND INSULATED TO A LEVEL EQUIVALENT TO THE INSULATION ON THE SURRAUNDING SURFACES. ACCESS SHALL BE PROVIDED TO ALL EQUIPMENT WHICH PREVENTS DAMAGING ORCOMPRESSING THE INSULATION. A WOOD FRAMED OR EQUIVALENT BAFFLE OR RETAINER MUST BE PROVIDED WHEN LOOSE FILL INSULATION IS INSTALLED TO PREVENT FILL FROM SPILLING INTO CONDITIONED SPACE AND TO MAINTAIN INSTALLED R-VALUE.

<u>CLEARANCES:</u> WHERE REQUIRED, INSULATION SHALL BE INSTALLED WITH CLEARANCES ACCORDING TO MANUFACTURER'S SPECIFICATIONS. INSULATION SHALL BE INSTALLED SO THAT REQUIRED VENTILATION IS UNOPSTRUCTED. FOR BLOWN OR POURED LOOSE FILL, INSULATION CLEARANCES SHALL BE MAINTAINED THROUGH INSTALLATION OF A PERMANENT RETAINER.

ALL INSULATION MATERIALS, INCLUDING FACINGS SUCH AS VAPOR BARRIERS OR BREATHER PAPERS, INSTALLED WITHIN FLOOR/CEILING AGGENIBLIES, ROOF/CEILING AGGENIBLIES, WALLS, CRAWL SPACES, OR ATTICS SHALL HAVE A FLAME-SPREAD RATING OF LESS THAN 25, AND A SMOKE DENSITY NOT TO EXCEED 450 WHEN TESTED IN ACCORDANCE WITH ASTM E84-01. EXCEPTIONS: 1.) FOAM PLASTIC INSULATION SHALL COMPLY WITH SECTION 1403 OF THE 2012 IBG; AND 2.) WHEN SUCH MATERIALS ARE INSTALLED IN CONCEALED SPACES OF TYPES III, IV AND V CONSTRUCTION, THE FLAME SPREAD AND SMOKE DEVELOPED LIMITATIONS DO NOT APPLY TO THE FACING, PROVIDED THAT THE FACING IS INSTALLED IN SUBSTANTIAL CONTACT WITH THE UNEXPOSED SURFACE OF THE CELLING, FLOOR, FINISH. 3.) CELLULOSE INSULATION SHALL COMPLY WITH SECTION 719 OF THE 2012 IBC..

ROOFS/CEILINGS: MAINTAIN I" VENTILATION ABOVE ROOF INSULATION. IF BAFFLES ARE USED THEY SHALL BE RESISTANT TO MOISTURE, BE OF RIGID MATERIAL, AND INSTALLED TO AND EXTEND 6" VERTICALLY ABOVE BATTS OR 12" VERTICALLY ABOVE LOOSE FILL WHEN EAVE VENTS ARE INSTALLED, BAFFLING OF THE VENT OPENINGS SHALL BE PROVIDED SO AS TO DEFLECT THE INCOMING AIR ABOVE THE SURFACE OF THE INSULATION. BAFFLES SHALL BE RIGID MATERIAL, RESISTANT TO WIND DRIVEN MOISTURE.

<u>WALLS:</u> ALL WALL INSULATION SHALL FILL THE ENTIRE CAVITY. EXTERIOR WALL CAVITIES ISOLATED DURING FRAMING (SUCH AS BEHIND BATHTUBS AND SHOWERS) SHALL BE FULLY INSULATED TO THE LEVELS OF SURROUNDING WALLS. ALL FACED INSULATION SHALL BE FACE STAPLED TO AVOID COMPRESSION.

<u>FLOORS:</u> ALL FLOOR INSULATION SHALL BE INSTALLED IN A PERMANENT MANNER IN SUBSTANTIAL CONTACT WITH THE SURFACE BEING INSULATED. INSULATION SUPPORTS SHALL BE INSTALLED SO SPACING IS NO MORE THAN 24 INCHES ON CENTER. FOUNDATION VENTS SHALL BE PLACED SO THAT THE TOP OF THE VENT IS BELOW THE LOWER SURFACE OF THE FLOOR INSULATION.

PERIMETER INSULATION INSTALLED ON THE INSIDE OF THE FOUNDATION WALL SHALL EXTEND DOWNWARD FROM THE TOP OF THE SLAB FOR A MINIMUM OF 24 INCHES OR DOWNWARD AND THEN HORIZONTALLY BENEATH THE SLAB FOR A COMBINED MINIMUM OF 24 INCHES. INCLIATION INSTALLED ON THE OUTSIDE OF THE FOUNDATION SHALL EXTEND DOWNWARD A MINIMUM 24 INCHES OR TO THE FROSTLINE OR FOR MONOLITHIC SLABS FROM THE TOP TO THE BOTTOM OF THE FOOTING. ABOVE GRADE INSULATION SHALL BE PROTECTED. THERMAL BREAKS SHALL BE PLACED IN THE SLAB BETWEEN CONDITIONED AND UNCONDITIONED SPACES. THE ENTIRE AREA OF A RADIANT SLAB SHALL BE THERMALLY ISOLATED FROM THE SOIL WITH MINIMUM R-10 INSULATION. THE INSULATION SHALL BE AN APPROVED PRODUCT FOR IT'S INTENDED USE. IF A SOIL GAS CONTROL SYSTEM IS PRESENT BELOW THE RADIANT SLAB, WHICH RESILTS IN INCREASED CONNECTIVE FLOW, THE SLAB SHALL BE THERMALLY ISOLATED FROM THE SUB-SLAB GRAVEL

BELOW-GRADE WALLS: BELOW GRADE EXTERIOR WALL INSULATION (COLD) SIDE OF THE WALL SHALL EXTEND FROM THE TOP OF THE BELOW GRADE WALL TO THE TOP OF THE FOOTING AND SHALL BE APPROVED FOR BELOW-GRADE USE. ABOVE GRADE INSULATION SHALL BE PROTECTED. INSULATION USED ON THE INTERIOR (WARM) SIDE OF THE WALL SHALL EXTEND FROM THE TOP OF THE BELOW-GRADE WALL TO THE BELOW-GRADE FLOOR LEVEL.

ALL HABITABLE ROOMS SHALL BE PROVIDED WITH AN ASSRESATE GLAZING AREA OF NOT LESS THAN 8 PERCENT OF THE FLOOR AREA OF SUCH ROOMS. VENTILATION SHALL COMPLY WITH THE W.S.V.I.A.Q.

WHALE HOUSE MECHANICAL VENTILATION:

EXHAUST FANS PROVIDING SOURCE SPECIFIC VENTILATION SHALL HAVE MINIMUM FAN FLOW RATING NOT LESS THAN 50 CFM AT 0.25 INCHES WATER GAUGE FOR BATHROOM LAUNDRIES OR SIMILAR ROOMS AND 100 CFM AT 0.25 INCHES WATER GAUGE FOR KITCHENS.

WHALE HOUSE VENTILATION SYSTEMS MAY CONSIST OF WHALE HOUSE EXHAUST, INTEGRATION WITH FORCED-AIR SYSTEMS OR DEDICATED HEAT RECOVERY VENTILATION SYSTEMS. WHOLE HOUSE EXHAUST SYSTEMS SHALL MEET THE FOLLOWING

BEDROOMS OFM MIN OFM MAX 2 OR LESS 85 120 3 95 H3

OUTDOOR AIR SHALL BE SUPPLIED BY EITHER MECHANICAL MEANS OR WITH INDIVIDUAL ROOM OUTDOOR AIR INLETS. INDIVIDUAL ROOM OUTDOOR AIR INLETS SHALL HAVE A CONTROLLABLE AND SECURE OPENING AND BE CAPABLE OF A TOTAL OPENING AREA OF NOT LESS THAN FOUR SQUARE INCHES AND TESTED BY A NATIONALLY RECOGNIZED STANDARD OR APPROVED AGENCY AND LOCATED TO AVOID DRAFTS.

DOMESTIC KITCHEN RANGE VENTILATION AND DOMESTIC CLOTHES DRYERS SHALL BE OF METAL AND HAVE SMOOTH INTERIOR SURFACES. DUCTS SHALL BE SUBSTANTIALLY AIRTIGHT AND SHALL COMPLY WITH THE PROVISIONS OF THE IRC. EXHAUST DUCTS SHALL TERMINATE QUTSIDE OF THE BUILDING AND BE EQUIPPED WITH BACK DRAFT DAMPERS. DOMESTIC QLOTHES DRYERS SHALL BE EXHAUSTED DIRECTLY TO THE OUTSIDE IF IN AN AREA THAT IS HABITABLE OR CONTAINING OTHER FUEL BURNING APPLIANCES AND SHALL MEET THE PROVISIONS OF THE IRC., AS WELL AS CLOTHES DRYER MANUFACTURER'S INSTRILCTIONS AND RECOMMENDATIONS. DRYER EXHAUST DILCTS SHALL TERMINATE ON THE OUTSIDE OF THE BUILDING AND SHALL BE EQUIPPED WITH A BACKDRAFT DAMPER. DUCTS SHALL NOT BE CONNECTED OR INSTALLED WITH SHEET METAL. SCREWS OR OTHER FASTENERS WHICH WILL OBSTRUCT THE FLOW. UNLESS OTHERWISE PERMITTED OR REQUIRED BY THE DRYER MANUFACTURER'S INSTRUCTIONS AND APPROVED BY THE BUILDING OFFICIAL, DRYER EXHAUST DUCTS SHALL NOT EXCEED A TOTAL COMBINED HORIZONTAL AND VERTICAL LENGTH OF 15 FEET, INCLUDING TWO 90 DEGREE ELBOWS. FIVE FEET SHALL BE DEDUCTED FOR EACH 90 DEGREE ELBOW IN EXCESS OF TWO.

HEARTH EXTENSIONS. HEARTH'S SHALL EXTEND AT LEAST 16" FROM THE FRONT OF, AND AT LEAST 8" BEYOND EACH SIDE OF, THE FIREPLACE OPENING. WHERE THE FIREPLACE OPENING IS 6 SQUARE FEET OR LARGER THE HEARTH EXTENSION SHALL EXTEND AT LEAST 20" IN FRONT, AND AT LEAST 12" BEYOND EACH SIDE OF THE FIREPLACE PER 10 IR.C.

FACTORY-BUILT FIREPLACES SHALL BE INSTALLED PER MFR'S. SPECIFICATIONS AND SHALL COMPLY WITH NFPA 211 AND WITH

COMPUSTIBLE MATERIALS SHALL NOT BE PLACED WITHIN 2 INCHES OF FIREPLACE, SMOKE CHAMBER OR CHIMNEY WALLS. COMPUSTIPLE MATERIAL SHALL NOT BE PLACED WITHIN 6 INCHES OF THE FIREPLACE OPENING. NO SUCH COMPUSTIBLE MATERIAL WITHIN 12 INCHES OF THE FIREPLACE OPENING SHALL PROJECT MORE THAN 1/8" OF EACH 1" CLEARANCE FROM SUCH OPENING.

EACH DWELLING UNIT SHALL BE PROVIDED WITH HEATING FACILITIES CAPABLE OF MAINTAINING TO DEGREES F AT A POINT 3 FEET ABOVE THE FLOOR IN ALL HABITABLE ROOMS AT THE 97 1/2% OUTSIDE DESIGN TEMPERATURE FOR THE LOCATION OF THE BUILDING.

LIQUEFIED PETROLEUM GAS BURNING APPLIANCES SHALL NOT BE INSTALLED IN A PIT, BASEMENT, OR SIMILAR LOCATION WHERE HEAVIER-THAN-AIR GAS MIGHT COLLECT. APPLIANCES SO FLIELED SHALL NOT BE INSTALLED IN AN ABOVE GRADE under fl*oor space or* Basement.

APPLIANCES DESIGNED TO BE IN A FIXED POSITION SHALL BE SECURELY FASTENED IN PLACE. SUPPORTS FOR APPLIANCES SHALL BE DESIGNED AND CONSTRUCTED TO SUSTAIN VERTICAL AND HORIZONTAL LOADS WITHIN THE STRESS LIMITATIONS IN THE BUILDING CODE.

ALL FUEL BURNING APPLIANCES LOCATED WITHIN THE BUILDING ENVELOPE SHALL OBTAIN COMBUSTION AIR FROM OUTDOORS PER 10 I.R.C. HEATING EQUIPMENT LOCATED WITHIN THE BUILDING ENVELOPE SHALL BE THERMALLY ISOLATED FROM THE

HEATED AREA PER 14 I.R.C. EVERY APPLIANCE DESIGNED TO BE VENTED SHALL BE CONNECTED TO A VENTING SYSTEM COMPLYING WITH THE IRC.

EVERY FACTORY BUILT CHIMNEY, TYPE I VENT, TYPE B GAS VENT, OR TYPE BW GAS VENT SHALL BE INSTALLED IN ACCORDANCE WITH THE TERMS OF IT'S LISTING, MANUFACTURER'S INSTRUCTIONS, AND PER IRC 1005.

VENT CONNECTORS SHALL BE INSTALLED WITHIN THE SPACE OR AREA IN WHICH THE APPLIANCE IS LOCATED AND SHALL BE CONNECTED TO A CHIMNEY OR VENT IN SUCH A MANNER AS TO MAINTAIN THE CLEARANCE TO COMPUSTIBLES PER IRC.

THERMOSTAT-WALL THERMOSTAT, LOW VOLTAGE, HEAT ANTICIPATING. FOUR TIME PERIODS PER DAY WITH INTELLIGENT RECOVERY FEATURE.

SMOKE DETECTOR & CARBON MONOXIDE DEVICES:

AS FOLLOWS:

GROUND SNOW LOAD: 30 PSF

FROST LINE DEPTH: 12 INCHES

TERMITE: SLIGHT TO MODERATE

DECAY = MODERATE TO SEVERE

MEAN ANNUAL TEMP: 51.4 DEGREES

WINTER DESIGN TEMPERATURE: 26 DEGREES F

FLOOD HAZARDS: PER KITSAP CO. BLDG. CODE SECTION 15.16

ICE SHIELD UNDERLAYMENT REQUIRED: NO

SEISMIC CATEGORY: D2

WEATHERING: MODERATE

AIR FREEZING INDEX: 148

TOPOGRAPHIC EFFECTS: YES

SMOKE ALARM SHALL BE INSTALLED IN THE FOLLOWING LOCATIONS, COORDINATE WITH DRAWINGS:

I. IN EACH SLEEPING ROOM. 2. AUTSIDE EACH SEPARATE SLEEPING AREA IN THE IMMEDIATE VICINITY OF THE BEDROOMS. 3. ON EACH ADDITIONAL STORY OF THE DWELLING, INCLUDING BASEMENTS BUT NOT INCLUDING CRAWLSPACES AND UNINHABITABLE ATTICS. IN DWELLINGS OR DWELLING UNITS WITH SPLIT LEVELS AND WITHOUT AN INTERVENING DOOR BETWEEN THE ADJACENT LEVELS, A SMOKE ALARM INSTALLED ON THE UPPER LEVEL SHALL SUFFICE FOR THE ADJACENT LOWER LEVEL PROVIDED THAT THE LOWER LEVEL IS LESS THAN ONE FULL STORY BELOW THE UPPER

ALL ALARM DEVICES SHALL BE INTERCONNECTED IN SUCH A MANNER THAT THE ACTUATION OF ONE ALARM WILL ACTIVATE ALL OF THE ALARMS IN THE DWELLING UNIT. THE ALARMS SHALL BE CLEARLY ALDIBLE IN ALL BEDROOMS OVER BACKGROUND NOISE LEVELS WITH ALL INTERVENING DOORS CLOSED. THE REQUIRED SMOKE ALARMS SHALL RECEIVE THEIR PRIMARY POWER FROM THE BUILDING WIRING AND BE EQUIPPED WITH A BATTERY BACKUP. THE DETECTOR SHALL EMIT A SIGNAL WHEN THE BATTERIES ARE LOW.

CARBON MONOXIDE ALARMS & DETECTION SHALL COMPLY WITH IRC SECTION R3/5 FOR NEW CONSTRUCTION AND PERMITTED W*o*rk in existing dwellings. New *co*nstruction l*ocations to* inclide *outside of each separate sleeping* area in DWELLING UNITS, WITHIN WHICH FUEL-FIRED APPLIANCECS ARE INSTALLED, AND IN DWELLING UNITS WITH ATTACHED GARAGES. SEE ALSO NEPA 720, AND UL LISTED 2075 WHERE APPLICABLE. ALARM PER UL 2034 AS REQUIRED.

<u>ADDITIONAL NOTES & DESIGN REQUIREMENTS:</u> (INLESS OTHERWISE NOTED BY STRUCTURAL ENGINEER)

STRUCTURAL ENGINEER PER THIS

DATA HEREIN

PROJECT SHALL VERIFY OR MODIFY ALL

 $\frac{1}{2}$

REVISIONS

INT. DATE REV **DESIGNER:** \emptyset DRAFTER: DATE: Ø5/17/18

SHEET NO:

PROJECT NO: 19198

ALL WORK SHALL COMPLY WITH THE FOLLOWING CODES AND GOVERNING ENTITIES: INTERNATIONAL RESIDENTIAL CODE (IR.C.) 2015 EDITION, INCLUDING ANY CITY/COUNTY OR OTHER MORE LOCAL JURISDICTIONAL AMENDMENTS APPLICABLE TO THE CODES DESCRIBED HEREIN.

THE METHODS, TECHNIQUES, SEQUENCE OR PROCEDURES REQUIRED PERFORMING THE WORK.

IN ADDITION, THE CURRENT VERSIONS OF THE CODES COVERING PLIMBING, MECHANICAL, ELECTRICAL AND FIRE SHALL BE FOLLOWED. THIS IS INCLUDING, BUT NOT LIMITED TO THE FOLLOWING:

2012 IMC (INTERNATIONAL MECHANICAL CODE) 2012 IFC (INTERNATIONAL FIRE CODE)

2012 UPC (UNIFORM PLLMBING CODE) 2012 WSEC (WASHINGTON STATE ENERGY CODE, INCLUDING AMENDMENTS TO DATE)

NOTIFY ARCHITECT OF ANY DISCREPANCIES BETWEEN THE CONTRACT DOCUMENTS AND THE BUILDING CODES. WORK SHALL BE DONE TO CURRENT AREA WIDE STANDARDS AND PRACTICES BY EXPERIENCED CRAFTSMEN.

THE CONTRACTOR SHALL VERIFY ALL EXISTING AND NEW DIMENSIONS AND JOB CONDITIONS AND NOTIFY THE ARCHITECT OF ANY DISCREPANCIES PRIOR TO PROCEEDING WITH THE WORK. THE CONTRACTOR SHALL BE RESPONSIBLE FOR ALL SAFETY PRECAUTIONS AND

GRADE ENTIRE AREA OF PROPERTY TO REASONABLY TRUE AND EVEN SURFACES. SLOPE GROUND AWAY FROM BUILDING WALLS TO FACILITATE DRAINAGE. GRADE TO UNIFORM LEVELS OR SLOPES BETWEEN POINTS WHERE GRADES ARE NOTED ON DRAWINGS. ROUND SURFACES AT ABRUPT CHANGES IN LEVEL.

BACKFILL BEHIND RETAINING WALLS WITH FREE DRAINING, GRANULAR FILL AND PROVIDE FOR SUBSURFACE DRAINIAGE.

CUT SLOPES FOR PERMANENT EXCAVATIONS SHALL NOT BE STEEPER THAN 2 HORIZONTAL TO 1 VERTICAL AND SLOPES FOR PERMANENT FILLS SHALL BE NOT STEEPER THAN 2 HORIZONTAL TO 1 VERTICAL UNLESS SUBSTANTIATING DATA JUSTIFYING STEEPER SLOPES ARE

<u>FOUNDATIONS:</u> ALSO SEE STRUCTURAL NOTES FOR ADDITIONAL REQUIREMENTS ASSUMED ALLOWABLE WALL BEARING VALUE 2000 PSF UNLESS INDICATED OTHERWISE IN GEOTECHNICAL REPORT. FOUNDATION FOOTINGS DOOR WHERE A STAIRWAY OF TWO OR FEWER RISERS IS LOCATED ON THE EXTERIOR SIDE OF A DOOR A LANDING. SHALL BE PLACED UPON FIRM, UNDISTURBED NATIVE SOIL NOTIFY ARCHITECT IF UNDISTURBED SOIL DEPTH IS DIFFERENT FROM DRAWINGS. MINIMUM FOOTING DEPTH 18" BELOW ADJACENT FINISH GRADE.

FOUNDATIONS SUPPORTING WOOD SHALL EXTEND AT LEAST 6 INCHES ABOVE THE ADJACENT FINISH GRADE.

FOUNDATIONS FOR ALL BUILDINGS WHERE THE SURFACE OF THE GROUND SLOPES MORE THAN I FOOT IN 10 FEET SHALL BE LEVEL, OR SHALL BE STEPPED SO THAT BOTH TOP AND BOTTOM OF SUCH FOUNDATION ARE LEVEL.

INDIVIDUAL CONCRETE PIER FOOTINGS SHALL PROJECT A MINIMUM OF 8 INCHES ABOVE EXPOSED GROUND UNLESS THE COLUMNS OR POSTS WHICH THEY SUPPORT ARE OF APPROVED WOOD OF NATURAL RESISTANCE TO DECAY OR TREATED WOOD.

COLUMNS AND POSTS LOCATED ON CONCRETE OR MASONRY FLOORS OR DECKS EXPOSED TO THE WEATHER OR TO WATER SPLASH OR IN BASEMENTS AND WHICH SUPPORT PERMANENT STRUCTURES SHALL BE SUPPORTED BY CONCRETE PIERS OR METAL PEDESTALS

PROJECTING ABOVE FLOORS UNLESS APPROVED WOOD OF NATURAL RESISTANCE TO DECAY OR TREATED WOOD IS USED. THE

PEDESTALS SHALL PROJECT AT LEAST 6 INCHES ABOVE EXPOSED EARTH AND AT LEAST | INCH ABOVE SUCH FLOORS. PROVIDE 18 INCH MINIMUM CRAWL SPACE UNDER WOOD JOINTS AND 12 INCHES UNDER WOOD GIRDERS OR BE APPROVED WOOD WITH

FOUNDATION WALLS ENCLOSING A BASEMENT BELOW FINISHED GRADE SHALL BE DAMP PROOFED OUTSIDE BY APPROVED METHODS AND

<u>WOOD:</u> (ALSO SEE STRUCTURAL NOTES FOR ADDITIONAL REQUIREMENTS)

ALL LUMBER, PLYWOOD, PARTICLE BOARD, STRUCTURAL GLUED-LAMINATED TIMBER, AND JOINTED LUMBER, FIBERBOARD SHEATHING (WHEN USED STRICTURALLY), HARDBOARD SIDING (MHEN USED STRICTURALLY), PILES AND POLES SHALL CONFORM TO THE APPLICABLE STANDARDS OR GRADING RULES SPECIFIED IN THE IRC. AND SHALL BE SO IDENTIFIED BY THE GRADE MARK OR A CERTIFICATE OF INSPECTION ISSUED BY AN APPROVED AGENCY.

ALL LUMBER, TIMBER, PLYWOOD, AND POLES REQUIRED TO BE TREATED WOOD SHALL BE IDENTIFIED BY THE QUALITY MARK OF AN APPROVED INSPECTION AGENCY WHICH MAINTAINS CONTINUED SUPERVISION, TESTING, AND INSPECTION OVER THE QUALITY OF THE PRODUCT AS SPECIFIED IN IR.C.,

DELIVERY AND STORAGE: KEEP MATERIALS UNDER COVER AND DRY. PROTECT AGAINST EXPOSURE TO WEATHER AND CONTACT WITH DAMP OR WET SURFACES. STACK LUMBER AS WELL AS PLYWOOD AND OTHER PANELS; SUCH THAT AIR CIRCULATION IS PROVIDED WITHIN AND AROUND STACKS AND UNDER TEMPORARY COVERINGS INCLUDING POLYETHYLENE AND SIMILAR MATERIALS.

FRAME NAILING TO BE IN COMPLIANCE WITH TABLE R602.3(1), IRC..

NATURAL RESISTANCE TO DECAY OR BE PRESSURE TREATED.

WOOD MEMBERS ENTERING MASONRY OR CONCRETE REQUIRE ONE-HALF INCH NET AIR SPACE ON TOP, SIDES, AND END.

FOUNDATION CRIPPLE WALLS SHALL BE FRAMED OF STUDS NOT LESS IN SIZE THAN THE STUDDING ABOVE. WHEN EXCEEDING A FEET HEIGHT, SUCH WALLS SHALL BE FRAMED OF STUDS HAVING THE SIZE REQUIREMENTS FOR AN ADDITIONAL STORY. CRIPPLE WALLS HAVING A STUD HEIGHT LESS THAN 14 INCHES SHALL BE SHEATHED ON AT LEAST ONE SIDE WITH A WOOD STRUCTURAL PANEL THAT IS FASTENED TO BOTH THE TOP AND BOTTOM PLATES OR THE CRIPPLE WALL SHALL BE CONSTRUCTED OF SOLID BLOCKING.

FOR CONVENTIONAL CONSTRUCTION, THE ENDS OF EACH JOIST SHALL HAVE NOT LESS THAN 1-1/2 INCHES OF BEARING ON WOOD OR METAL, NOR LESS THAN 3 INCHES ON MASONRY EXCEPT WHERE SUPPORTED ON A 1x4 RIBBON STRIP NAILED TO ADJACENT STUD OR BY CLOSET DOOR ASSEMBLIES. APPROVED JOIST HANGER.

BEARING PARTITIONS PERPENDICULAR TO JOISTS SHALL NOT BE OFFSET FROM SUPPORTING GIRDERS, WALLS, OR PARTITIONS MORE THAN JOIST DEPTH UNLESS SIZED TO CARRY THE ADDITIONAL LOAD.

JOISTS UNDER AND PARALLEL T*O B*EARING PARTITIONS SHALL BE *O*F ADEQUATE SIZE TO SUPPORT THE LOAD. DOUBLE JOISTS, SIZED TO SUPPORT THE LOAD, THAT ARE SEPARATED TO PERMIT THE INSTALLATION OF PIPING OR VENTS, SHALL BE FULL DEPTH SOLID BLOCKED WITH LLMBER NOT LESS THAN 2 INCHES NOMINAL AND SPACED NOT MORE THAN 4 FEET ON CENTER.

SOLID BLOCKING SHALL BE PROVIDED OVER BEARING PARTITIONS, WALLS, AND BEAMS.

DIMENSION OF THE COVERING SHALL NOT EXCEED ONE-QUARTER INCH.

FIRE BLOCKING AND DRAFTSTOPPING SHALL BE INSTALLED TO CUT OFF ALL CONCEALED DRAFT OPENINGS (BOTH VERTICAL AND HORIZONTAL) AND SHALL FORM AN EFFECTIVE BARRIER BETWEEN FLOORS, AND BETWEEN TOP STORY AND A ROOF OR ATTIC SPACE. FIRE BLOCKING SHALL CONSIST OF 2 INCH NOMINAL LUMBER. FIRE BLOCKING SHALL BE REQUIRED IN CONCEALED SPACES OF STUD WALLS AND PARTITIONS, INCLUDING FURRED SPACES, AT THE CEILING AND FLOOR LEVELS AND AT 10 FOOT INTERVALS BOTH HORIZANTALLY AND VERTICALLY; AT ALL INTERCANNECTIONS BETWEEN CONCEALED VERTICAL AND HORIZONTAL SPACES SUCH AS SOFFITS, *DROP C*EILINGS AND *COVE C*EILINGS; BETWEEN STAIR STRINGERS AT T*OP A*ND BOTTOM AND ALONG RUN BETWEEN STUDS; IN *O*PENINGS AROUND VENTS, PIPES, DUCTS AND SIMILAR OPENINGS WHICH AFFORD A PASSAGE FOR FIRE AT CEILING AND FLOOR LEVELS, WITH APPROVED NON-COMPLISTIPLE MATERIALS. ALL SPACES BETWEEN CHIMNEYS AND FLOORS AND CEILINGS THROUGH WHICH CHIMNEYS PASS SHALL BE FIRE-BLOCKED WITH NONCOMBUSTIBLE MATERIAL SECURELY FASTENED INTO PLACE TO A DEPTH OF I INCH AND SHALL ONLY BE PLACED ON STRIPS OF METAL OR METAL LATH LAID ACROSS THE SPACES BETWEEN COMBUSTIBLE MATERIAL AND THE

ALL WOOD EXPOSED TO WEATHER, SUCH AS WOOD USED FOR DECK FRAMING INCLUDING DECKING, RAILINGS, JOISTS, BEAMS, AND POSTS, SHALL BE AN APPROVED SPECIES AND GRADE OF LUMBER PRESSURE TREATED AND/OR DECAY-RESISTANT HEARTWOOD OF REDWOOD, BLACK LOCUST OR CEDARS.

ROOF SHEATHING SHALL BE IN ACCORDANCE WITH IRC. ROOF SHEATHING. PANELS EXPOSED IN OUTDOOR APPLICATIONS SHALL BE BONDED WITH EXTERIOR GLIE IDENTIFIED AS EXPOSURE I. APPLICATION OF ROOF COVERING MATERIALS SHALL BE IN ACCORDANCE WITH IRG.. THE NET FREE VENTLATING AREA OF ENGLOSED RAFTER OR ATTIC SPACES OR OTHER ENGLOSED BUT UNHEATED SPACES SHALL BE NOT LESS THAN 1/150 OF THE AREA OF EACH SPACE TO BE VENTILATED, EXCEPT THAT THE AREA MAY BE 1/300, PROVIDED THAT AT LEAST 50% AND NOT MORE THAN 80% OF THE REQUIRED VENTILATING AREA IS LOCATED AT LEAST 3 FEET ABOVE EAVE OR *co*rnice vents with the Balance Being provided by the eave *or co*rnice vents, *o*r if a vapor retarder not exceeding a 1 PERM RATING IS INSTALLED ON THE WARM SIDE OF THE INSULATION.

THE VENT AREA OPENINGS SHALL BE COVERED WITH AN I.R.C. APPROVED CORROSION-RESISTANT MATERIAL PROVIDED THAT THE LEAST

TRUSSES AS SHOWN ON DRAWINGS ARE ONLY REPRESENTATIONS; ACTUAL TRUSS CONFIGURATION MAY VARY PER MANUFACTURER'S DESIGN. STRESS ANALYSIS AND DRAWINGS/DETAILS SHALL BE STAMPED BY AN APPROVED STATE OF WASHINGTON REGISTERED ENGINEER. (DRAWINGS/DETAILS SHALL BE PROVIDED TO BUILDING OFFICIALS AND APPROVED PRIOR TO INSTALLATION.) PRE-MANUFACTURED TRUSSES SHALL BE IDENTIFIED BY MANUFACTURER'S STAMP, GIRDER AND FIELD IDENTIFICATION OF LIGHT METAL PLATE CONNECTED TRUGGES IS REQUIRED. INFORMATION BRANDED, MARKED, OR OTHERWISE PERMANENTLY AFFIXED TO EACH TRUGG SHALL CONTAIN THE FALLOWING: () IDENTIFICATION OF THE TRUSS MANUFACTURING COMPANY; 2) THE DESIGN LOAD, AND 3) THE TRUSS SPACING. ENGINEERING DATA AND DETAILS SHALL BE APPROVED BY THE ARCHITECT BEFORE ANY FIELD CUTS OR TRUSS ALTERATIONS. ALL ROOF TRUGGES SHALL BE SO FRAMED AND TIED INTO THE FRAMEWORK AND SUPPORTING WALLS SO AS TO FORM AN INTEGRAL PART OF THE MINIMUM OF 1 1/2-INCHES IN HEIGHT. WHOLE BUILDING. ROOF TRUSSES SHALL HAVE JOINTS WELL FITTED AND SHALL HAVE ALL TENSION MEMBERS WELL TIGHTENED BEFORE 6. OUTBOARD PANES IN INSULATING GLASS UNITS AND OTHER MULTIPLE GLAZED PANELS IN HAZARDOUS LOCATIONS ANY LOAD IS PLACED UPON THE TRUSS. DIAGONAL AND SWAY BRACING SHALL BE USED TO BRACE ALL ROOF TRUSSES.

THE GARAGE SHALL BE SEPARATED FROM THE RESIDENCE AND ITS ATTIC AREA BY NOT LESS THAN 1/2-INCH GYPSUM BOARD APPLIED TO GARAGE SIDE. GARAGES BENEATH HABITABLE SPACE SHALL BE SEPARATED BY NOT LESS THAN 5/8-INCH TYPE X GYPSUM BOARD OR EQUAL WHERE THE SEPARATION IS A FLOOR-CELLING ASSEMBLY, THE STRUCTURE SUPPORTING THE SEPARATION SHALL ALSO BE PROTECTED BY NOT LESS THAN 1/2-INCH GYPSUM BOARD OR EQUAL

OPENINGS BETWEEN GARAGE AND RESIDENCE SHALL BE EQUIPPED WITH SOLID WOOD DOORS OR SOLID OR HONEYCOMPED STEEL DOORS NOT LESS THAN | 3/8-INCH IN THICKNESS OR DOORS HAVING A FIRE PROTECTION RATING OF NOT LESS THAN 20 MINUTES. DOORS SHALL BE SELF CLOSING AND TIGHT FITTING.

DUCT PENETRATION. DUCTS IN THE GARAGE AND DUCTS PENETRATING THE WALLS OR CELLINGS SEPARATING THE DWELLING FROM THE GARAGE SHALL BE CONSTRUCTED OF A MINIMUM NO. 26 GAGE (CARMM) SHEET STEEL OR OTHER APPROVED MATERIAL AND SHALL HAVE NO OPENING INTO THE GARAGE.

BASEMENTS AND EVERY SLEEPING ROOM SHALL HAVE AT LEAST ONE OPERABLE WINDOW OR EXTERIOR DOOR APPROVED FOR EMERGENCY ESCAPE OR RESCUE. ESCAPE OR RESCUE WINDOWS SHALL HAVE A MINIMUM NET CLEAR OPENING OF 5.7 SQUARE FEET. THE MINIMUM NET CLEAR OPENING HEIGHT DIMENSION SHALL BE 24 INCHES. THE MINIMUM NET CLEAR OPENING WIDTH DIMENSION SHALL BE 20 INCHES. WHERE WINDOWS ARE PROVIDED AS A MEANS OF ESCAPE OR RESCUE, THEY SHALL HAVE A FINISHED SILL HEIGHT NOT MORE THAN 44 INCHES ABOVE THE FLOOR. EMERGENCY ESCAPE AND RESCUE OPENINGS SHALL BE OPERATIONAL FROM THE INSIDE OF THE ROOM

ALL CORRIDORS SHALL BE NOT LESS THAN 36 INCHES WIDE. NOT LESS THAN ONE EXIT DOOR SHALL BE PROVIDED FOR DIRECT ACCESS TO THE EXTERIOR WITHOUT REQUIRING TRAVEL THOUGH A GARAGE. THE REQUIRED EXIT DOOR SHALL BE SIDE-HINGED NOT LESS THAN 3 FEET IN WIDTH AND 6 FEET 8 INCHES IN HEIGHT. A FLOOR OR LANDING IS REQUIRED ON EACH SIDE OF THE EXIT DOOR. THE FLOOR OR LANDING AT THE EXIT DOOR SHALL NOT BE MORE THAN 1 1/2-INCHES LOWER THAN THE TOP OF THE THRESHOLD. OTHER THAN THE REQUIRED EXIT IS NOT REQUIRED FOR THE EXTERIOR SIDE OF THE DOOR. FLOORS OR LANDINGS AT EXTERIOR DOORS OTHER THAN THE REQUIRED EXIT DOOR SHALL HAVE A RISE LESS THAN 7 3/4-INCH BELOW THE TOP OF THE THRESHOLD, PROVIDED THE DOOR (OTHER THAN AN EXTERIOR STORM OR SCREEN DOOR) DOES NOT SWING OVER THE LANDING. THE WIDTH OF EACH LANDING SHALL NOT BE LESS THAN THE DOOR SERVED. EVERY LANDING SHALL HAVE A MINIMUM DIMENSION OF 36 INCHES MEASURED IN THE DIRECTION OF TRAVEL

WITHOUT THE USE OF KEYS OR TOOLS.

ENCLOSED ACCESSIBLE SPACE UNDER STAIRS SHALL HAVE WALLS, UNDER STAIR SURFACE, AND ANY SOFFITS PROTECTED ON THE ENCLOSED SIDE WITH 1/2-INCH GYPSUM BOARD.

MAXIMUM RISER HEIGHT 7 3/4-INCHES, MINIMUM TREAD DEPTH 10 INCHES, HEADROOM MINIMUM 6 FEET 8 INCHES, MINIMUM WIDTH 36 INCHES. HANDRAILS SHALL BE PROVIDED ON AT LEAST ONE SIDE OF EACH CONTINUOUS RUN OF TREADS OR FLIGHT WITH FOUR OR MORE RISERS. HANDRAIL ENDS SHALL BE RETURNED OR SHALL TERMINATE IN NEWEL POST OR SAFETY TERMINALS. HANDRAIL HEIGHT SHALL BE NOT LESS THAN 34 INCHES AND NOT MORE THAN 36 INCHES ABOVE SLOPE PLANE ADJOINING THE TREAD NOSING. HANDRAILS WITH CIRCULAR CROSS SECTION SHALL HAVE AN OUTSIDE DIAMETER OF AT LEAST | 1/4-INCHES AND NOT GREATER THAN 2-INCHES. NON CIRCULAR HANDRAILS SHALL HAVE A PERIMETER DIMENSION OF AT LEAST 4-INCHES AND NOT GREATER THAN 6 1/4-INCHES WITH MAXIMUM CROSS SECTION DIMENSION OF 2 1/4-INCHES. HANDRAILS ADJACENT TO A WALL SHALL HAVE A SPACE OF NOT LESS THAN | |/2-inches between the Wall and the Handrail

STAIRS, EXIT BALCONIES AND SIMILAR EXIT FACILITIES SHALL BE POSITIVELY ANCHORED TO THE PRIMARY STRUCTURE TO RESIST BOTH VERTICAL AND LATERAL FORCES. SUCH ATTACHMENT SHALL NOT BE ACCOMPLISHED BY USE OF TOENALS OR NAILS SUBJECT TO WITHDRAWAL

DECKS, SCREENED PORCHES, BALCONIES OR RAISED FLOOR SURFACES ARE MORE THAN 30 INCHES ABOVE THE FLOOR OR GRADE BELOW, SHALL HAVE GUARDS NOT LESS THAN 36 INCHES IN HEIGHT. OPEN SIDES OF STAIRS WITH TOTAL RISE OF MORE THAN 30 INCHES ABOVE THE FLOOR OR GRADE BELOW SHALL HAVE GUARDS NOT LESS THAN 34 INCHES IN HEIGHT MEASURED VERTICALLY FROM THE NOSING OF THE TREADS. INTERMEDIATE RAILS OR ORNAMENTAL CLOSURES ARE REQUIRED THAT DO NOT ALLOW PASSAGE OF A SPHERE 4 INCHES OR MORE IN PIAMETER. TRIANGULAR ØPENINGS ØREATED BY STAIR RISERS, TREADS AND BOTTOM RAIL SHALL NOT ALLOW THE PASSAGE OF A 6 INCH SPHERE.

HAZARDOUS LOCATIONS: EACH PANE OF GLAZING INSTALLED IN HAZARDOUS LOCATIONS SHALL BE VISIBLY LABELED WITH A NON-REMOVABLE LABEL THAT DESIGNATES THE TYPE AND THICKNESS OF GLASS AND SAFETY GLAZING STANDARD. THE FOLLOWING SHALL BE CONSIDERED SPECIFIC HAZARDOUS LOCATIONS FOR THE PURPOSES OF

GLAZING: I. GLAZING IN SWINGING DOORS EXCEPT JALQUSIES.

2. GLAZING IN FIXED AND SLIDING PANELS OF SLIDING DOOR ASSEMBLIES AND PANELS IN SLIDING AND BIFOLD

3. GLAZING IN STORM DOORS. 4. GLAZING IN ALL UNFRAMED SWINGING DOORS.

5. GLAZING IN DOORS AND ENCLOSURES FOR HOT TUBS, WHIRLPOOLS, SAUNAS, STEAM ROOMS, BATHTUBS AND SHOWERS. GLAZING IN ANY PART OF A BUILDING WALL ENCLOSING THESE COMPARTMENTS WHERE THE BOTTOM EXPOSED EDGE OF THE GLAZING IS LEGS THAN 60 INCHES MEASURED VERTICALLY ABOVE ANY STANDING OR WALKING SURFACE.

6. GLAZING IN AN INDIVIDUAL FIXED OR OPERABLE PANEL ADJACENT TO A DOOR WHERE THE NEAREST VERTICAL EDGE IS WITHIN A 24 INCH ARC OF THE DOOR IN A CLOSED POSITION AND WHOSE BOTTOM EDGE IS LESS THAN 60 INCHES ABOVE THE FLOOR OR WALKING SURFACE.

7. GLAZING IN AN INDIVIDUAL FIXED OR OPERABLE PANEL. OTHER THAN THOSE LOCATIONS DESCRIBED IN ITEMS 5 AND 6 ABOVE, THAT MEETS ALL OF THE FOLLOWING CONDITIONS:

7.1 EXPOSED AREA OF AN INDIVIDUAL PANE GREATER THAN 9 SQUARE FEET.

72 BOTTOM EDGE LESS THAN 18 INCHES ABOVE THE FLOOR. 7.3 TOP EDGE GREATER THAN 36 INCHES ABOVE THE FLOOR. 7.4 ONE OR MORE WALKING SURFACES WITHIN 36 INCHES HORIZONTALLY OF THE GLAZING.

8. ALL GLAZING IN RAILINGS REGARDLESS OF AN AREA OR HEIGHT ABOVE A WALKING SURFACE INCLUDED ARE STRUCTURAL BALLISTER PANELS AND NONSTRUCTURAL IN-FILL PANELS. 9. GLAZING IN WALLS AND FENCES ENCLOSING INDOOR AND OUTDOOR SWIMMING POOLS, HOT TUBS AND SPAS WHERE THE BOTTOM EDGE OF THE GLAZING IS LESS THAN 60 INCHES ABOVE A WALKING SURFACE AND WITHIN 60

INCHES HORIZONTALLY OF THE WATER'S EDGE. THIS SHALL APPLY TO SINGLE GLAZING AND ALL PANES IN MULTIPLE GLAZING. 10. GLAZING ADJACENT TO STAIRWAYS, LANDINGS AND RAMPS WITHIN 36 INCHES HORIZONTALLY OF A WALKING SURFACE WHEN THE EXPOSED SURFACE OF THE GLASS IS LESS THAN 60 INCHES ABOVE THE PLANE OF THE

ADJACENT WALKING SURFACE. II. GLAZING ADJACENT TO STAIRWAYS WITHIN 60 INCHES HORIZONTALLY OF THE BOTTOM TREAD OF A STAIRWAY IN SLABG: ANY DIRECTION WHEN THE EXPOSED SURFACE OF THE GLASS IS LESS THAN 60 INCHES ABOVE THE NOSE OF THE

SEE 2014 NATIONAL ELECTRICAL CODE SECTION 25052 (3) & DETAILS ON SHEET A-22 FOR BUILDING GROUNDING.

THE FOLLOWING PRODUCTS, MATERIALS AND USES ARE EXEMPT FROM THE ABOVE HAZARDOUS LOCATIONS: I. OPENINGS IN DOORS THROUGH WHICH A 3-INCH SPHERE IS UNABLE TO PAGE. 2. DECORATIVE GLASS IN EXCEPTION ITEMS, I, 6 OR 7. 3. GLAZING IN HAZARDOUS LOCATIONS, ITEM 6, WHEN THERE IS AN INTERVENING WALL OR OTHER PERMANENT

BARRIER BETWEEN THE DOOR AND THE GLAZING. 4. GLAZING IN HAZARDOUS LOCATIONS, ITEM 6, IN WALLS PERPENDICULAR TO THE PLANE OF THE DOOR IN A CLOSED POSITION OR WHERE ACCESS THROUGH THE DOOR IS TO A CLOSET OR STORAGE AREA 3 FEET OR LESS IN DEPTH. GLAZING IN THESE APPLICATIONS SHALL COMPLY WITH HAZARDOUS LOCATION ITEM 7.

5. GLAZING IN HAZARDOUS LOCATIONS, ITEMS 7 AND 10, WHEN A PROTECTIVE BAR IS INSTALLED ON THE

OR OTHER HORIZONTAL [WITHIN 45° OF HORIZONTAL] SURFACE ADJACENT TO THE GLASS EXTERIOR.

ACCESSIBLE SIDE(S) OF THE GLAZING 36 INCHES ± 2 INCHES ABOVE THE FLOOR. THE BAR SHALL BE CAPABLE OF WITHSTANDING A HORIZONTAL LOAD OF 50 POUNDS PER LINEAR FOOT WITHOUT CONTACTING THE GLASS AND BE A ITEM 7. WHEN THE BOTTOM EDGE OF THE GLASS IS 25 FEET OR MORE ABOVE GRADE. A ROOF, WALKING SURFACE.

WHOLE HOUSE VENTILATION SYSTEM SHALL COMPLY WITH WASHINGTON STATE VENTILATION AND INDOOR AIR QUALITY

I.R.C. TABLE R3012(1) IS AMENDED BY FILLING IN BLANKS OF THE TABLE PER KITSAP CO. BLDG. CODE WIND SPEED: 85 MPH (3 SECOND GUST), I/O MPH ULTIMATE, WIND EXPOSURE "D"

CODE REQUIREMENTS, FOR SIZING, CONTROLS, DUCTING, NOISE AND OTHER REQUIREMENTS.

Established Basic Permit # 19-03650

Permit Number: 20-02542

 \mathcal{O} C \mathcal{O}

TABLE WSEC 403.5.							
FAN LOCATION	AIR FLOW RATE MINIMUM (CFM)	MINIMUM ETTICIENCY (CFM/WATT)	AIR FLØR RATE MAXIMUM (ØFM)				
RANGE HOODS	ANY	18	ANY				
IN-LINE FAN	ANY	18	ANY				
BATHROOM, UTILITY ROOM	6	14	<90				
BATHROOM, UTILITY ROOM	90	18	ANY				

EXHAUST FAN REQUIREMENTS (SECTION 409.3.3 IMC)

LESS THAN 100 CFM @ 0.10 WATER GAUGE.

A BATHROOMS, LAUNDRIES, WATER CLOSETS OR SIMILAR ROOMS SHALL HAVE A MINIMUM FAN FILOW RATING NOT LESS THAN 50 CFM @ 0.25 WATER GAUGE. B. KITCHENS SHALL HAVE A MINIMUM FAN FLOW RATING NOT LESS THAN 100 CFM @ 025 WATER GAUGE. HOWEVER, WHERE A RANGE HOOD OR DOWN DRAFT EXHAUST FAN IS USED THE MINIMUM FAN FLOW RATING SHALL NOT BE

VENTLATION RATES FOR ALL GROUP R PRIVATE DWELLINGS, SINGLE AND MILTIPLE (CONTINUOUSLY OPERATING SYSTEMS)

FL00R			BEDROOMS +		
FLOOR AREA, FT 2	l, FT	2-3	4-5	6-7	>7
<500	30	45	60	75	90
50-3000	45	60	75	90	105
300 -4500	60	75	90	105	120
4501-6000	75	90	105	120	195
600 -7500	90	105	120	195	150
>7500	105	120	135	150	6 5

* VENTILATION RATES IN TABLE ARE MIN. OUTDOOR AIRFLOW RATES MEASURED IN CFM SOURCE SPECIFIC VENTILATION CONTROLS (SECTION IRC 1507.3)

I. LOCATION OF CONTROLS CONTROLS FOR ALL VENTILATION SYSTEMS SHALL BE READLY ACCESSIBLE BY THE

- 2. Instructions, operating instructions for whole house ventilation systems shall be provided to the OCCUPANT BY THE INSTALLER OF THE SYSTEM.
- 3. SOURCE SPECIFIC VENTILATION SYSTEMS. SOURCE SPECIFIC VENTILATION SYSTEMS SHALL BE CONTROLLED BY MANUAL SWITCHES, DEHUMDISTATS, TIMERS, OR OTHER APPROVED MEANS.
- 4. CANTINUAIS WHALE HAUSE VENTILATION SYSTEMS, CONTINUAUS WHALE HAUSE VENTILATION SYSTEMS SHALL OPERATE CONTINUOUSLY. EXHAUST FANS, FORCED-AIR SYSTEM FANS, OR SUPPLY FANS SHALL BE EQUIPPED WITH "FAN ON" AS Override controls. Controls shall be capable of operating the ventilation system without energizing OTHER ENERGY-CONSUMING APPLIANCES. A LABEL SHALL BE AFFIXED TO THE CONTROLS THAT READS "WHOLE HOUSE VENTILATION (SEE OPERATING INSTRUCTIONS)."
- 5. Intermittent whale hause ventilation systems. Intermittent whale hause ventilation systems shall COMPLY WITH THE FOLLOWING:
- 5. THEY SHALL BE CAPABLE OF OPERATION INTERMITTENTLY AND CONTINUOUSLY. 52 THEY SHALL HAVE CONTROLS CAPABLE OF OPERATING THE EXHAUST FANG, FORCED-AIR SYSTEM FANG, OR
- SUPPLY FANS WITHOUT ENERGIZING OTHER ENERGTY-CONSUMING APPLIANCES. 5.3 THE VENTILATION RATE SHALL BE ADJUSTED ACCORDING TO THE EXCEPTION IN SECTION 403851 54 THE SYSTEM SHALL BE DESIGNED SO THAT IT CAN OPERATE AUTOMATICALLY BASED ON THE TYPE OF CONTROL
- TIMER INSTALLED. 55 THE INTERMITTENT MECHANICAL VENTILATION SYSTEM SHALL OPERATE AT LEAST ONE HOUR OUT OF EVERY
- TWELVE 56 THE SYSTEM SHALL HAVE A MANUAL CONTROL AND AUTOMATIC CONTROL, SUCH AS A 24-HOUR CLOCK TIMER. 5.7 AT THE TIME OF FINAL INEPECTION, THE AUTOMATIC CONTROL SHALL BE SET TO OPERATE THE WHOLE HOUSE
- FAN ACCORDING TO THE SCHEDULE USED TO CALCULATE, THE WHOLE HOUSE FAN SIZING. 58 A LABEL SHALL BE AFFIXED TO THE CONTROL THAT READS "WHOLE HOUSE VENTILATION (SEE OPERATION Instrictions)." PRESCRIPTIVE EXHAUST DUCT SIZING

· = ·	A CONTRACTOR OF CONTRACTOR									
FAN TESTED CFM 9 025" W.G.	MINIMUM FLEX DIAMETER	MAXIMUM LENGTH	MINIMUM SMOOTH DAMETER	MAXIMUM LENGTH FEET	MAXIMUM ELBOWS					
50	A"	25	4"	70	3					
50	5"	90	5"	100	3					
50	6"	NO LIMIT	6"	NO LIMIT	3					
80	4"2	NA NA	4"	10	3					
80	5"	15	5"	100	3					
80	6"	90	6"	NO LIMIT	3					
100	5" ¹	NA	5"	50	3					
100	6"	45	6"	NO LIMIT	3					
25	6"	15	6"	NO LIMIT	3					
125	T	70	7"	NO LIMIT	3					

I. FOR EACH ADDITIONAL ELBOW SUBTRACT 10 FEET FROM LENGTH.

- 2. FLEX DUCTS OF THIS DUMNETER ARE NOT PERMITTED WITH FANS OF THIS SIZE.
- 4038A. SOURCE SPECIFIC EXHIUST SYSTEMS. EXHIUST SYSTEMS SHILL BE DESIGNED AND INSTALLED
- TO MEET ALL OF THE CRITERIA BELOW:
- . SOURCE SPECIFIC EXHAUST SHALL BE DISCHARGE OUTDOORS. 2. EXHAUST QUILETS SHALL COMPLY WITH SECTION 5012.
- 3. Pressure equalization shall comply with section 5013.
- 4. EXHAUST DUCTS IN SYSTEMS WHICH ARE DESIGNED TO OPERATE INTERMITTENTLY SHALL BE EQUIPPED WITH BACK-DRAFT DAMPERS
- 5. ALL EXHAUST DUCTS IN UNCONDITIONED SPACES SHALL BE INSULATED TO A MINIMUM OF R-4.
- 6. TERMINAL QUILET ELEMENTS SHALL HAVE AT LEAST THE EQUIVALENT NET FREE AREA OF THE DICTWORK. 7. TERMINAL QUILET ELEMENTS SHALL BE SCREENED OR OTHERWISE PROTECTED AS REQUIRED BY
- BY SECTION 50122.
- 8. EXHAUST FANS IN SEPARATE DWELLING UNITS OR GLEST ROOMS SHALL NOT SHARE COMMON EXHAUST pucts unless the system is engineered for this operation.
- 9. WHERE PERMITTED BY CHAPTER 5, MILITIPLE SOURCE SPECIFIC EXHAUST DUCTS MAY BE COMBINED. IF MORE THAN ONE OF THE EXHAUST FANS IN A DWELLING UNIT OR GLEST ROOM SHARES A COMMON EXHAUST DUCT THEN EACH EXHAUST FAN SHALL BE EQUIPPED WITH A BACK-DRAFT DAMPER TO PREVENT THE RECIRCULATION OF EXHAUST AIR FROM ONE ROOM TO ANOTHER ROOM VIA THE EXHAUST DUCT.

W.A.C. 403.8.5 WHOLE-HOUSE VENTILATION REQUIREMENTS

40385 EACH DWELLING UNIT OR GUEST ROOM SHALL BE EQUIPPED WITH ONE OF THE FOLLOWING FOUR TYPES OF MECHANICAL WHALE HOUSE VENTILATION SYSTEMS: A SYSTEM USING EXHAUST FANS (SEE SECTION 40386); A SYSTEM INTEGRATED WITH FORCED-AIR SYSTEMS (SEE SECTION 4038.7); A SYSTEM USING SUPPLY FANS (SEE SECTION 4038.8; OR A HEAT OR ENERGY RECOVERY VENTILATION SYSTEM (SEE SECTION 40989).

403851 OUTDOOR AIR OUTDOOR AIR SHALL BE DISTRIBUTED TO EACH HABITABLE SPACE. WHERE OUTDOOR AIR SUPPLY INTAKES ARE SEPARATED FROM EXHAUST VENTS BY DOORS, MEANS SHALL BE PROVIDED TO

ENSURE AIRTLOW TO ALL SEPARATED HABITABLE SPACES BY INSTALLING DISTRIBUTION DUCTS, INSTALLED GRILLES, TRANSOMS, DOORS UNDERCUT TO A MINIMUM OF 1/2-INCH ABOVE THE SURFACE OF THE FINISH FLOOR COVERING, OR OTHER SIMILAR MEANS WHERE PERMITTED BY THE INTERNATIONAL BUILDING CODE.

THE MECHANICAL SYSTEM SHALL OPERATE CONTINUOUSLY TO SUPPLY AT LEAST THE VOLUME OF OUTDOOR AIR REQUIRED IN TAPLE 403.3 OR TAPLE 4038.1. 403865 FAN NOISE WHOLE HOUSE EXHAUST AND TRANSFER FANS LOCATED 4 FEET OR LESS FROM THE INTERIOR GRILLE

SHALL HAVE A SONE RATING OF 10 OR LESS MEASURED AT 0.10 INCHES WATER GAUGE. MANUFACTURER'S NOISE RATINGS SHALL BE DETERMINED AS PER HAI 915. REMOTELY MOUNTED FANG SHALL BE ACQUISTICALLY ISOLATED FROM THE STRUCTURAL ELEMENTS OF THE BUILDING AND FROM ATTACHED DUCTWORK USING INSULATED FLEXIBLE DUCT OR OTHER APPROVE MATERIAL.

ATTIC SPACE SHALL BE VENTED PER IRC SEC R806 CRAINL SPACE SHALL BE VENTED W/ | SF. PER 150 SF. OF CRAINL AREA OR PER IRC. SEC RADO

A PERMANENT CERTIFICATE SHALL BE POSTED WITHIN THREE FEET OF THE ELECTRICAL DISTIBUTION PANEL. THE CERTIFICATE SHALL BE COMPLETED BY THE BUILDER OR REGISTERED DESIGN PROTESSIONAL THE CERTIFICATE SHALL LIST THE PREDOMINANT R-VALLES OF INSULATION INSTALLED IN OR ON CELLING/ROOF, WALLS, FOUNDATION (SLAB, BASEMENT WALL, CRAWLSPACE WALL AND/OR FLOOR), AND DUCTS OUTSIDE THE CONDITIONED SPACES, U-FACTORS FOR FENESTRATION, AND THE SOLAR HEAT GAIN COEFFICIENT (SHGC) OF FENESTRATION. WHERE THERE IS MORE THAN ONE VALUE FOR EACH COMPONENT, THE CERTIFICATE SHALL LIST THE VALUE COVERING THE LARGEST AREA. THE CERTIFICATE SHALL LIST THE TYPES AND EFFICIENCIES OF HEATING, COOLING AND SERVICE WATER HEATING EQUIPMENT. WHERE A GAS-FIRED UNMENTED ROOM HEATER, ELECTRIC FURNACE, OR BASEDOARD ELECTRIC HEATER IS INSTALLED IN THE RESIDENCE, THE CERTIFICATE SHALL LIST "GAS-FIRED UNMENTED ROOM HEATER." "ELECTRIC FURNACE" OR "DASEDOARD ELECTRIC HEATER AS APPROPRIATE. AS EFFICIENCY SHALL NOT BE LISTED FOR GAS-FIRED UMENTED ROOM HEATERS, ELECTRIC FURNACES OR ELECTRIC BASE BOARD HEATERS, SECTION PER WSEC RAOLS

DUILVINO AIK LEAKAOE TESTINO

THE BUILDING THERMAL ENVELOPE SHALL BE CONSTRUCTED TO LIMIT AIR LEAKAGE IN ACCORDANCE WITH THE REQUIREMENTS OF SECTIONS WSEC RAOLA! THROUGH RAOLAA

LEAKAGE TESTING

PUCTS SHALL BE LEAK TESTED IN ACCORDANCEWITH WSU RS-99, USING THE MAXIMUM PUCT LEAKAGE RATES SPECIFIED PER WSEC 40322. DUCT TIGHTNESS SHALL BE VERIFIED BY THE SAME. EXCEPTION: THE TOTAL LEAKAGE TEST IS NOT REQUIRED FOR DUCTS AND AIR HANDLERS LOCATED ENTIRELY WITHIN THE BUILDING THERMAL ENVELOPE. DUCTS LOCATED IN CRAWL SPACES DO NOT QUILIFY FOR THIS

WSEC R302.1 INTERIOR DESIGN CONDITIONS: THE INTERIOR DESIGN TEMPERATURES USED FOR HEATING AND COOLING LOAD CALCULATIONS SHALL BE A MAXIMUM OF 72 DEGREES F (22 DEGREES () FOR HEATING AND A MIMINUM OF 75 DEGREES F (24 DEGREES C) FOR COOLING.

WSEC R3011 EXTERIOR DESIGN CONDITIONS: THE HEATING OR COOLING OUTDOOR DESIGN TEMPERATURES SHALL BE SELECTED FROM WSEC APPENDIX 'C'.

WSEC RAOS.I.I PROGRAMMABLE THERMOSTAT: WHERE THE PRIMARY HEATING SYSTEM IS A FORCED-AIR FURNACE, AT LEAST ONE THERMOSTAT PER DWELLING UNIT SHALL BE CAPABLE OF CONTROLLING THE HEATING AND COOLING SYSTEM ON A DAILY SCHEDULE TO MAINTAIN DIFFERENT TEMPERATURE SET POINTS AT DIFFERENT TIMES OF THE DAY. THE THERMOSTAT SHALL ALLOW FOR, AT A MINIMUM, A 5-2 PROGRAMMABLE SCHEDULE (WEEKDAYS/WEEKENDS) AND BE CAPABLE OF PROVIDING AT LEAST TWO PROGRAMMABLE SETBACK PERIODS PER DAY. THIS THERMOSTAT SHALL INCLUDE THE CAPABILITY TO SET BACK OR TEMPORARLY OPERATE THE SYSTEM TO MAINTAIN ZONE TEMPERATURES DOWN TO 55 DEGREES F (15 DEGREES C) AND A COOLING TEMPERATURE SET POINT NO LOMER THAN 76 DEGREES F (24 DEGREES C). THE THERMOSTAT AND/OR CONTROL SYSTEM SHALL

SYSTEMS CONTROLLED BY AN OCCUPANT SENSOR THAT IS CAPABLE OF SHUTTING THE SYSTEM OFF WHEN NO OCCUPANT IS SENSED FOR A PERIOD OF UP TO 30 MINUTES.

SYSTEMS CONTROLLED SOLELY BY A MANUALLY OPERATED TIMER CAPABLE OF OPERATING THE SYSTEM FOR

WSEC RAOS,12 HEAT PUMP SUPPLEMENTARY HEAT (MANDATORY):

HAVE AN ADJUSTABLE DEADBAND OF NOT LESS THAN 10 DEGREES F.

Unitary ar coaled heat pumps shall inclide controls that minimize supplemental heat usage during start-up, set-up, and DEFROST CONDITIONS. THESE CONTROLS SHALL ANTICIPATE NEED FOR HEAT AND USE COMPRESSION HEATING AS THE FIRST STAGE OF HEAT. CONTROLS SHALL INDICATE WHEN SUPPLEMENTAL HEATING IS BEING USED THROUGH VISUAL MEANS (E.G., LED INDICATORS). HEAT PUMP'S EQUIPPED WITH SUPPLEMENTARY HEATERS SHALL BE INSTALLED WITH CONTROLS THAT PREVENT SUPPLEMENTAL HEATER OPERATION ABOVE 40 DEGREES F. AT FINAL INSPECTION THE AUXILIARY HEAT LOCK OUT CONTROL SHALL BE SET TO 35 DEGREES F OR LESS.

WSEC RAOSS MECHANICAL SYSTEM PIPING INSULATION (MANDATORY):

OFF THE HOT WATER CIRCULATING PUMP WHEN THE SYSTEM IS NOT IN USE.

MECHANICAL SYSTEM PIPING CAPABLE OF CARRYING FLUIDS ABOVE 105 DEGREES F (4) DEGREES C) OR BELOW 55 DEGREES F (13 DEGREES 6) SHALL BE INSULATED TO A MINIMUM OF R-6. WSEC 4033 PROTECTION OF PIPING INSILATION:

PIPING INGULATION EXPOSED TO WEATHER SHALL BE PROTECTED FROM DAMAGE, INCLIDING THAT CAUSED BY SUNLIGHT, MOISTURE. EQUIPMENT MAINTENANCE, AND WIND, AND SHALL PROVIDE SHIELDING FROM SOLAR RADIATION THAT CAN CAUSE DEGRADATION OF THE MATERIAL ADHESIVE TAPE SHALL NOT BE PERMITTED.

WSEC RAOSA! CIRCULATING HOT WATER SYSTEMS (MANDATORY): CIRCULATING HOT WATER SYSTEMS SHALL BE PROVIDED WITH AN AUTOMATIC OR READILY ACCESSIBLE MANUAL SWITCH THAT CAN TURN

WSEC RAOSA2 HOT WATER PIPE INSULATION (PRESCRIPTIVE): INSULATION FOR HOT WATER PIPE SHALL HAVE A MINIMUM THERMAL RESISTANCE (R-VALLE) OF R-4.

WSEC RAOSS MECHANICAL VENTILATION (MANDATORY):

THE BUILDING SHALL BE PROVIDED WITH VENTILATION THAT MEETS THE REQUIREMENTS OF THE INTERNATIONAL RESIDENTIAL OR INTERNATIONAL MECHANICAL CODE, AS APPLICABLE, OR WITH OTHER APPROVIED MEANS OF VENTILATION. OUTDOOR AIR INTAKES AND EXHAUSTS SHALL HAVE AUTOMATIC OR GRAVITY DAMPERS THAT CLOSE WHEN THE VENTILATION SYSTEM IS NOT OPERATING.

WSEC 4035. WHOLE-HOUSE MECHANICAL VENTILATION SYSTEM FAN ETTICACY: MECHANICAL VENTILATION SYSTEM FANS SHALL MEET THE ETTICACY REQUIREMENTS OF TABLE 4035, LOCATED TO THE LEFT ON

WHERE MICHANICAL VENTILATION FANS ARE INTEGRAL TO TESTED AND LISTED HVAC EQUIPMENT, THEY SHALL BE POWERED BY AN ELECTRONICALLY COMMUTATED MOTOR. WSEC RAOSA EQUIPMENT SIZING (MANDATORY):

HEATING AND COOLING EQUIPMENT SHALL BE SIZED IN ACCORDANCE WITH ACCA MANUAL S BASED ON BUILDING LOADS CALCULATED IN ACCORPANCE WITH ACCA MANUAL J OR OTHER APPROVED HEATING AND COOLING CALCULATION METHODOLOGIES.

UNLESS NOTED OTHERWISE, INSULATION TO BE PER WSEC TABLE 402,11 CLIMATE ZONE 2 -INSILATION BAFFLES TO MAINTAIN I" ABOVE INSILATION. -BAFFLES TO EXTEND 6" ABOVE BATT. INSULATION.

-PAFFLES TO EXTEND 12" ABOVE LOOSE FILL INSULATION. -insulate Behind Tubs/showers, Partitions and Corners. -FRICTION FIT UNFACED BATTS MUST PROVIDE ONE OF THE FOLLOWING:

4 MIL POLYVAPOR RETARDER OR PVA PAINT WITH A DRY CUP PERM RATING OF I MAX

TYPICAL INSULATION VALUES:

EXTERIOR WALLS: WALLS BETWEEN HOUSE AND GARAGE: R-21 BATT. FLOORS o/ CRAWL SPACE & GARAGE: R-38 BATT.

R-36 BATT. CEILING (VAULTED 2x/2 FRAMING): R-49 PLOWN-IN (ALSO SEE OPTION RADI2) FOR R-30) CEILING (ATTIC): SLAB ON GRADE:

R-8 PER WSEC 4032. DUCTS IN OR ON BUILDINGS:

FURNACE *NOTE: CLIENT PROPOSED CAPET WALL "ZONED HEAT" ONLY, ALT. MITSUPISHI " MINI SPLIT SYSTEM". PROPOSED HEATING SYSTEM

HEATING SYSTEM TYPE:

per spec's per spec's SYSTEM ETFICIENCY: 95% UNLESS NOTED OTHERWISE IN CHAPTER 4 OPTIONS MODIFIED ETFICIENCY:

HEATING LOAD (AT 44 DEGREES F. DT): SYSTEM SIZE: MAXIMUM SIZE @ 150%: 40,000 BTUh

- A DUCT SYSTEMS SHALL BE OF METAL AS SET FORTH IN 2012 IRC TABLES MIGOLLI(2) OR FACTORY-MADE AIR DUCTS COMPLYING WITH 2012 IRC 16012 AND TABLE MIGOLLI(1)
- B. JOINTS AND SEAMS SHALL BE SUBSTANTIALLY AIRTIGHT, PER 2012 IRC MIGOLA! AND WSEC SECTION 40322 C. INSTALLATION OF DUCTS SHALL COMPLY WITH 2012 IRC SECTION MIGOLA D. DUCT INSILATION SHALL BE INSTALLED IN ACCORDANCE WITH 2012 IRC MIGOLAS
- E ALL AIR DUCTS, AIR HANDLERS, FILTER BOXES, AND BUILDING CAVITIES USED AS DUCTS SHALL BE SEALED PER WSEC 4031. JOINTS AND SEAMS SHALL COMPLY WITH SECTION MIGOLS OF THE INTERNATIONAL RESIDENTIAL CODE OR SECTION 603.9 OF THE INTERNATIONAL MECH. CODE.

NOTE: WHERE DUCTS ARE USED FOR BOTH HEATING AND COOLING, THE MINIMUM INSULATION SHALL BE AS REQUIRED FOR THE MOST RESTRICTIVE CONDITION PER SYSTEM SPECIFICATIONS.

EXCEPTION: INSULATION MAY BE CAMITTED ON THAT PORTION OF A DUCT WHICH IS LOCATED WITHIN A WALL OR FLOOR/CELING SPACE WHERE BOTH SIDES OF THIS SPACE ARE EXPOSED TO CONDITIONED AIR AND WHERE THIS SPACE IS NOT VENTILATED OR OTHERWISE EXPOSED TO UNCONDITIONED AIR.

INSULATION TYPES: MINIMUM DENSITIES AND OUT-OF-PACKAGE THICKNESS A 05-INCH 15 TO 2 LB/CU FT DUCT LINER, MINERAL OR GLASS FIRER PLANKET OR EQUIVALENT TO PROVIDE AN INSTALLED

- TOTAL THERMAL RESISTANCE OF AT LEAST R.2. B. 2-INCH 060 LB/CU FT MINERAL OR GLAGG FIBER BLANKET, IS-INCH IS TO 2 LB/CU FT DUCT LINER MINERAL OR GLAGG FIBER BLANKET. 15-INCH 9 TO 7 LB/CU FT MINERAL OR GLAGG FIBER BOARD OR EQUIVALENT TO PROVIDE AN INSTALLED TOTAL THERMAL RESISTANCE OF AT LEAST R-5.
- C. 3-INCH 060 LB/CU FT MINERAL OR GLASS FIBER BLANKET, 2-INCH 15 TO 2 LB/CU FT DUCT LINER MINERAL OR GLASS FIBER BLANKET. 2-INCH 3 TO 7 LB/CU FT MINERAL OR GLASS FIBER BOARD OR EQUIVALENT TO PROVIDE AN INSTALLED TOTAL THERMAL RESISTANCE OF AT LEAST R-7. D. 4-INCH 060 LB/CU FT MINERAL OR GLASS FIBER BLANKET, 3-INCH 15 TO 2 LB/CU FT DUCT LINER, MINERAL OR GLASS
- FIBER BLANKET. 9-INCH 9 TO 7 LB/CU FT MINERAL OR GLASS FIBER BOARD OR EQUIVALENT TO PROVIDE AN INSTALLED TOTAL THERMAL RESISTANCE OF AT LEAST R-10. E. 35-INCH 060 LB/CU FT MINERAL OR GLASS FIBER BLANKET, 25-INCH 15 TO 2 LB/CU FT DUCT LINER, MINERAL OR GLASS FIBER BOARD OR EQUIVALENT TO PROVIDE AN INSTALLED TOTAL THERMAL RESISTANCE OF AT LEAST R-8.

INFILTRATION CONTROL

F. APPROVED WEATHERPROOF BARRIER.

DOORS AND WINDOWS GENERAL: EXTERIOR DOORS AND WINDOWS SHALL BE DESIGNED TO LIMIT AIR LEAKAGE INTO OR FROM THE BUILDING ENVELOPE. SITE-CONSTRUCTED DOORS AND WINDOWS SHALL BE SEALED IN ACCORDANCE WITH WSEC SECTION RADIA & IRC NIJOLA

- A. EXTERIOR JOINTS AROUND WINDOWS AND DOOR FRAMES, OPENINGS BETWEEN WALLS AND FOUNDATION, BETWEEN WALLS AND ROOF AND WALL PANELS: OPENINGS AT PENETRATIONS OF UTILITY SERVICES THROUGH WALLS, FLOORS AND ROOFS, AND ALL OTHER OPENINGS IN THE BUILDING ENVELOPE AND ALL OTHER OPENINGS BETWEEN UNITS SHALL BE SEALED, CAULKED, GASKETED OR WEATHERSTRIPPED TO LIMIT AIR LEAKAGE. OTHER EXTERIOR JOINTS AND SEAMS SHALL BE SIMLARLY TREATED, OR TAPED, OR COVERED WITH MOISTURE VAPOR PERMEABLE HOUSEWRAP.
- B. ALL EXTERIOR DOORS OR DOORS SERVING AS ACCESS TO AN ENCLOSED UNHEATED AREA SHALL BE WEATHERSTRIPPED TO LIMIT LEAKAGE AROUND THEIR PERIMETER WHEN IN A CLOSED POSITION.

C. SITE BUILT WINDOWS ARE EXEMPT FROM TESTING BUT SHALL BE MADE TIGHT FITTING. FIXED LIGHTS SHALL HAVE CLASS RETAINED BY STOPS WITH SEALANT OR CALLKING ALL AROUND. OPERATING SASH SHALL HAVE WEATHERSTRIPPING WORKING AGAINST OVERLAPPING TRIM AND A CLOSER/LATCH WHICH WILL HOLD THE SASH CLOSED. THE WINDOW FRAME TO FRAMING CRACK SHALL BE MADE TIGHT WITH CAULKING, OVERLAPPING MEMBRANE OR OTHER APPROVED TECHNIQUE.


VAPOR BARRIERS / GROUND COVERS

AN APPROVED VAPOR RETARDER SHALL BE INSTALLED ON THE WARM SIDE (IN WINTER) OF INSULATION AS SPECIFIED

VAPOR RETARDERS FL*00*R 0 4-ML POLY O BACKED BATTS IR EXT. T&G PLYWOOD WALLS 0 4-ML POLY O BACKED BATTS 10 PVA - PAINT CELLINGS O BACKED BATTS 10 PVA - PAINT

GRAUND COVER: A GRAUND COVER OF SIX MIL (0006 INCH THICK) PLACK POLYETHYLENE OR APPROVED EQUAL SHALL BE LAID OVER THE GROUND WITHIN CRAWL SPACES. THE GROUND COVER SHALL BE OVERLAPPED 12 INCHES MINIMUM AT THE JOINTS AND SHALL EXTEND TO THE FOUNDATION WALL. (W.S.E.C. SECT. 502.16.7)

LIGHTING SYSTEMS

RADA! LIGHTING EQUIPMENT (MANDATORY). A MINIMUM OF 75 PERCENT OF PERMANENTLY INSTALLED LAWPS IN LIGHTING FIXTURES SHALL BE HIGH-EFFICACY

RADALI LIGHTING EQUIPMENT (MANDATORY) FLEL GAS LIGHTING SYSTEMS SHALL NOT HAVE CONTINUOUSLY BURNING PILOT LIGHTS.

WSEC - TABLE R402.1.1 CHAPTER 51-11 WAC. - WSEC 2015 ETTECTIVE JULY 1, 2016 PRESCRIPTIVE REQUIREMENTS FOR SINGLE-FAMILY RESIDENTIAL CLIMATE ZONES LISTED

CLIMATE ZONE	5 AND MARINE 4	6
FENESTRATION U-FACTOR ^b	030	030
SKYLIGHT U-FACTOR b	050	050
GLAZED FENESTRATION SHOC 6, °	NR.	NR.
CELING R-VALLE I	49	49
WOOD FRAME WALL R-VALUE 9 K, I	21 INT.	2H5 CI
MASS WALL R-VALLE I	2 /2 h	2H5 h
FLOOR R-VALUE b	30 ⁹	30 ⁹
BELOW-GRADE WALL R-VALUE ^{6, K}	10/15/2 INT + TB	10/15/21 INT. + TB
SLAB R-VALUE & DEPTH d	10, 2 FT	10, 4 FT

FOR SI: | FOOT.=3048 mm, CI = CONTINUOUS INSULATION, INT. = INTERMEDIATE FRAMING, TB = THERMAL BREAK" R-VALLES ARE MINIMUMS. U-FACTORS AND SHISC ARE MAXIMUMS. WHEN INSULATION IS INSTALLED IN A CAVITY WHICH IS LESS THAN THE LABEL OR DESIGN THICKNESS OF THE INSULATION, THE COMPRESSED R-VALUE OF

THE INSULATION FROM APPENDIX TABLE AID/A SHALL NOT BE LESS THAN THE R-VALUE SPECIFIED IN THE TABLE. ^d the fenestration u-factor column excludes skylights. The shoc column applies to all glazed fenestration. EXCEPTION: SKYLIGHTS MAY BE EXCLIDED FROM GLAZED FENESTRATION SHEC REQUIREMENTS IN CLIMATE ZONES I THROUGH 3 WHERE THE SHEC FOR SUCH SKYLIGHTS DOES NOT EXCEED 0.30.

"10/15/21+TB" MEANS R-10 CONTINUOUS INSULATION ON THE EXTERIOR OF THE WALL, OR R-15 ON THE CONTINUOUS INSULATION ON THE INTERIOR OF THE WALL, OR R-21 CAVITY INSULATION PLUS A THERWAL BREAK BETWEEN THE SLAB AND THE BASEMENT WALL AT THE INTERIOR OF THE BASEMENT WALL "10/15/21+TB" SHALL BE PERMITTED TO BE MET WITH R-13 CAVITY INSULATION ON THE INTERIOR OF THE BASEMENT WALL PLUS R-5 CONTINUOUS INSULATION ON THE INTERIOR OR EXTERIOR OF THE WALL "10/19" MEANS R-10 CONTINUOUS INSULATION ON THE INTERIOR OR EXTERIOR OF THE HOME OR R-13 CAVITY INSULATION AT THE INTERIOR OF THE BASEMENT WALL. "TB" MEANS THERMAL BREAK BETWEEN FLOOR SLAB AND BASEMENT WALL

° r-10 continuous insulation is reguired under heated slab on grade filoors. See ra01291. THERE IS NO SHEC REQUIREMENTS IN THE MARINE ZONE.

BASEMENT WALL INSULATION IS NOT REQUIRED IN WARM-HUMID LOCATIONS AS DEFINED BY FISURE R30!, AND TABLE

' FIRST VALLE IS CAVITY INSILATION. SECOND IS CONTINUOUS INSILATION OR INSILATED SIDING, SO "13.45" MEANS R-13 CAVITY INSULATION PLUS R-5 CONTINUOUS INSULATION OR INSULATED SIDING. IF STRUCTURAL SHEATHING COVERS 40 PERCENT OR LESS OF THE EXTERIOR. CONTINUOUS INSLLATION R-VALLE SHALL BE PERMITTED TO BE REDUCED BY NO MORE THAN R-3 IN THE LOCATIONS WHERE STRUCTURAL SHEATHING IS USED TO MAINTAIN A CONSISTENT TOTAL

' THE SECOND R-VALUE APPLIES WHEN MORE THAN HALF THE INSULATION IS ON THE INTERIOR OF THE MASS WALL. 1 FOR SINGLE RAFTER- OR JOIST-VALLTED CELLINGS, THE INSULATION MAY BE REDUCED TO R-36.

INT. (INTERMEDIATE FRAMING) DENOTES STANDARD FRAMING 16" ON CENTER WITH HEADERS INSULATED WITH A MİNIMUM OF R-10 INSULTION.

LOG AND SOLID TIMBER WALLS WITH A MINIMUM AVERAGE THICKNESS OF 35 INCHES ARE EXEMPT FROM THIS INSILATION REQUIREMENT.

WSEC - TABLE 406.2 ENERGY CREDITS

ADDITIONAL ENERGY ETFICIENCY REQUIREMENTS (MANDATORY). EACH DWELLING UNIT IN ONE- AND TWO-FAMILY DWELLINGS AND TOWNHOUSES, AS DEFINED IN SECTION 1012 OF THE INTERNATIONAL RESIDENTIAL CODE SHALL COMPLY WITH SUFFICIENT OPTIONS FROM TABLE RADIA SO AS TO ACHIEVE THE FOLLOWING MINIMUM NUMBER OF CREDITS:

I. SWALL DWELLING UNIT: 15 POINTS DWELLING UNITS LESS THAN 1500 SQUARE FEET IN CONDITIONED FLOOR AREA WITH LESS THAN 300 SQUARE FEET OF FENESTRATION AREA ADDITIONS TO EXISTING BUILDING THAT ARE LESS THAN 150 SQUARE FEET OF HEATED FLOOR

2. MEDIUM DWELLING UNIT: 35 POINTS ALL DWELLING UNITS THAT ARE NOT INCLUDED IN # OR #3. 3. LARGE DWELLING UNIT: 45 POINTS

PRESCRIPTIVE COMPLIANCE IS BASED ON TABLE RADALI WITH THE FOLLOWING MODIFICATIONS:

9.46 ON GRADE R-10 PERIMETER AND UNDER ENTIRE 9.46 BELOW GRADE 9.46 R-10 PERIMETER AND UNDER ENTIRE

DWELLING LINITS EXCEEDING 5000 SQUARE FEET OF CONDITIONED ILOOR AREA

PETERENT BUILDING ENVELOPE 16: PRESCRIPTIVE COMPLIANCE IS BASED ON TABLE RADIAL WITH THE FOLLOWING MODIFICATIONS: FENESTRATION 11=025 WALL R-21 PLUS R-4 BASEMENT WALL R-21 INT. PLUS R-5 CI SLAD ON GRADE R-10 PERMENTER AND UNDER ENTIRE SLAD BELOW GRADE SLAB R-10 PERIMETER AND UNDER ENTIRE SLAB

WOOD FRAME WALL R-21 INT. PLUS R-12 CI

BASEMENT WALL R-21 INT. PLUS R-12 CI

FL00R R-36

COMPLIANCE BASED ON SECTION RADILIA: REDUCE THE TOTAL UN BY 5%

COMPLIANCE BASED ON SECTION RAO2.14: REDUCE THE TOTAL UN BY 15% EFFICIENT BUILDING ENVELOPE IC: PRESCRIPTINE COMPLIANCE IS BASED ON TABLE RAOZ/II WITH THE FOLLOWING MODIFICATIONS: FENESTRATION 11=022 CELING AND SINGLE-RAFTER OR JOIST VALLTED R-49 ADVANCED

glad an grade R-10 perimeter-and under entire glad BELOW GRADE SLAB R-10 PERMETER AND UNDER ENTIRE SLAB COMPLIANCE BASED ON SECTION RADILIA: REDUCE THE TOTAL UN BY 30% 2a. AR LEAKAGE CONTROL AND ETTICIENT VENTILATION 2a: COMPLIANCE BASED ON RADIA!2: REDUCE THE TESTED AIR LEAKAGE TO 40 AIR CHANGES PER HOUR ALL WHALE HOUSE VENTILATION REQUIREMENTS AS DETERMINED BY SECTION MISOTIS OF THE INTERNATIONAL residential *co*de shall be met with high efficiency fan (maximum *09*5 watts/cfm), not interlocked . with the furnace fan ventlation systems using a furnace including an eam motor are allowed, 🖔 provided that they are controlled to operate at low speed in ventilation only mode. TO QUALIFY TO CLAIM THIS CREDIT, THE BUILDING PERMIT DRAWINGS SHALL SPECIFY THE OPTION BEING SELECTED AND SHALL SPECIFY THE MAXIMUM TESTED BUILDING AIR LEAKAGE AND SHALL SHOW THE HEAT RECOVERY VENTILATION SYSTEM. 26. AR LEAKAGE CONTROL AND ETTICENT VENTILATION 26: COMPLIANCE DASED ON SECTION RAO24.12: REDUCE THE TESTED AIR LEAKAGE TO 20 AIR CHANGES PER all whale hause ventilation requirements as determined by section miso73 of the international residential code shall be met with a heat-recovery ventilation system with minimum sensible HEAT RECOVERY ETTICIENCY OF 0.70. TO QUALITY TO CLAIM THIS CREDIT, THE BUILDING PERMIT DRAWINGS SHALL SPECIFY THE OPTION BEING gelected and stall specify the maximum tested building air leakage and shall show the heat recovery ventilation system AIR LEAKAGE CONTROL AND EFFICIENT VENTILATION 2c: COMPLIANCE BASED ON SECTION RADIA[2: REDUCE THE TESTED AIR LEAKAGE TO 15 AIR CHANGES PER HOUR all whale hause ventilation requirements as determined by section miso73 of the international residential code shall be met with a heat recovery-ventilation system with minimum sensible teat recovery efficiency *of 085* TO QUILLEY TO CLAIM THIS CREDIT, THE BUILDING PERMIT DREAWINGS SHALL SPECIFY THE OPTION BEING SELECTED AND SHALL SPECIFY THE MAXIMUM TESTED BUILDING AIR LEAKAGE AND SHALL SHOW THE HEAT RECOVERY VENTLATION SYSTEM. 3a. HIGH EFFICIENCY HVAC EQUIPMENT 3a: 6A6, PROPANE OR OIL-FIRED FURNACE WITH MINIMUM AFIJE OF 95% TO QUALIFY TO CLAIM THIS CREDIT, THE BUILDING PERMIT DRAWINGS SHALL SPECIFY THE OPTION BEING SELECTED AND SHALL SPECIFY THE HEATING EQUIPMENT TYPE AND THE MINIMUM EQUIPMENT EFFICIENCY 36. MICH ETTICIENCY HVAC EQUIPMENT 36: ar-source heat pump with minimum hispf. Of 85

to qualify to claim this <u>credit, the building permit</u> drawings shall specify the option being PLECTED AND SHALL SPECIFY THE HEATING EQUIPMENT TYPE AND THE MINIMUM EQUIPMENT ETTICIENCY.

HIGH ETTICIENCY HVAC EQUIPMENT 9c: CLOSED-LOOP GROUND SOURCE HEAT PLMP, WITH A MINIMUM COP. OF 33-OR OPEN LOOP WATER SOURCE HEAT PLMP WITH A MAXIMUM PLMPING HYDRALLIC HEAD OF 50 THET AND MINIMUM COP. OF 36 TO QUALIFY TO CLAIM THIS CREDIT, THE BUILDING PERMIT DRAWINGS SHALL SPECIFY THE OPTION BEING SELECTED AND SHALL SPECIFY THE HEATING EQUIPMENT TYPE AND THE MINIMUM EQUIPMENT EFFICIENCY

DUCTLESS SPLIT SYSTEM HEAT PLMPS, ZONAL CONTROL: IN HOMES WHERE THE PRIMARY SPACE HEATING SYSTEM IS ZONAL ELECTRIC HEATING, A DUCTLESS HEAT PLMP SYSTEM SHALL BE INSTALLED AND PROVIDED HEATING TO AT LEAST ONE ZURE OF THE HOUSING UNIT.
TO QUALIFY TO CLAIM THIS CREDIT, THE BUILDING PERMIT DRAWINGS SHALL STEZEY THE OPTION BEING SELECTED AND SHALL SPECIFY THE HEATING EQUIPMENT TYPE AND THE MINIMUM EQUIPMENT ETTICIENCY HIGH ETTICIENCY HVAC DISTRIBUTION SYSTEM: ALL HEATING AND COOLING SYSTEM COMPONENTS INSTALLED INSIDE THE CONDITIONED SPACE. ALL

LOCATING SYSTEM COMPONENTS IN CONDITIONED CRAWL SPACES IS NOT PERMITTED UNDER THIS OPTION. ELECTRIC RESISTANCE HEAT IS NOT PERMITTED UNDER THIS OPTION. direct compustion heating equipment with affile less than 80% is not permitted under this option. TO QUALIFY TO CLAIM THIS GREDIT, THE BUILDING PERMIT DRAWINGS SHALL SPECIFY THE OPTION BEING FLECTED AND SHULL SPECIFY THE HEATING EQUIPMENT TYPE AND SHULL SHOW THE LOCATION OF THE HEATING AND COOLING EQUIPMENT AND ALL THE DUCTWORK

COMPUSTION EQUIPMENT SHALL BE DIRECT VENT OR SEALED COMPUSTION.

WATER HEATING SYSTEM SHALL INCLIDE ONE OF THE FOLLOWING: GAS, PROPANE OR OIL WATER HEATER WITH A MINIMUM EF. OF O.A. ELECTRIC WATER HEATER WITH A MINIMUM EF. OF 0.99.

3d. HIGH ETTIGENCY HVAC EQUIPMENT 3d:

AND FOR BOTH CASES all showerhead and kitchen sink faucets installed in the house shall be rated at 1,75 GPM or less. All other lavatory falkets shall be rated at 10 gpm or less. TO QUALIFY TO CLAIM THIS CREDIT, THE BUILDING PERMIT DRAWINGS SHALL SPECIFY THE OPTION BEING SELECTED AND SHALL SPECIFY THE WATER HEATER EQUIPMENT TYPE AND THE MINIMUM EQUIPMENT efficiency and shall specify the maximum flow rates for all showerheads, kitchèn sink falcets, AND OTHER LAVATORY FAUGETS. EFFICIENT WATER HEATING 56:

water heating system shall include one of the following: GAS, PROPANE OR OIL WATER HEATER WITH A MINIMUM EF. OF 0801 OR SOLAR WATER HEATING SUPPLEMENTING A MINIMAN STANDARD WATER HEATER SOLAR WATER HEATING WILL PROVIDE A RATED MINIMUM SAVINGS OF 85 THERMS OR 2000 KNY DASED ON THE SOLAR RATING AND CERTIFICATION CORPORATION (SRCC) ANNUAL PERFORMANCE OF 06-300 CERTIFIED SOLAR WATER HEATING OR ELECTRIC HEAT PLMP WATER HEATER WITH A MINIMUM EF. OF 20 AND MEETING THE STANDARDS OF NEEA'S NORTHERN CLIMATE SPECIFICATIONS FOR HEAT PLMP WATER HEATERS

or water heater heated by ground source heat pump meeting the requirements of option 30. to quality to claim this credit. The building permit prayings shall specify the option being SELECTED AND SHALL SPECIFY THE WATER HEATER EQUIPMENT TYPE AND THE MINIMUM EQUIPMENT ETTUENCY AND, FOR SOLAR WATER HEATING SYSTEMS, THE CALCULATION OF THE MINIMUM ENERGY SAVINGS.
ETTUENT WATER HEATING 50: vater heating system shall inclide one of the following: GAG, PROPANE OR OIL WATER HEATER WITH A MINIMUM EF. OF 091

OR SOLAR WATER HEATING SUPPLEMENTING A MINIMUM STANDARD WATER HEATER. SOLAR WATER HEATING WILL PROVIDE A RATED MINIMUM SAVINGS OF 85 THERMS OR 2000 KWh BASED ON THE SOLAR RATING AND CERTIFICATION CORPORATION (SRCC) ANNUAL PERFORMANCE OF 06-900 CERTIFIED SOLAR WATER HEATING OR ELECTRIC HEAT PLMP WATER HEATER WITH A MINIMUM EF. OF 20 AND MEETING THE STANDARDS OF NEES'S NORTHERN CLIMATE SPECIFICATIONS FOR HEAT PUMP WATER HEATERS ør water heater heated by grønd søuræ heat pump meeting the requirements øf øptiøn 30. TO QUALIFY TO CLAIM THIS CREDIT. THE BUILDING PERMIT DRAWINGS SHALL SPECIFY THE OPTION BEING

SELECTED AND SHALL SPECIFY THE WATER HEATER EQUIPMENT TYPE AND THE MINIMUM EQUIPMENT tticiency and, for solar water heating systems, the calculation of the minimum energy savings, RENEWACLE FLECTRIC ENERGY: for each 1200 kmH of Electrical Generation provided annually by on-site wind or solar EQUIPMENT A 05 CREDIT SHALL BE ALLOWED, UP TO 3 CREDITS. GENERATION SHALL BE CALCULATED AS

FOR SOLAR ELECTRIC SYSTEMS, THE DESIGN SHALL BE DEMONSTRATED TO MEET THIS REQUIREMENT USING THE NATIONAL RENEWABLE ENERGY DABORATORY CALCULATOR PVWATTS. DOCUMENTATION NOTING SOLAR ACCESS SHALL BE INCLUDED ON THE PLANS. for wind generated prajects designs shall document annual power generation based on the THE WIND TURDINE POWER CURVE, AMERICE ANNUAL WIND SPEED AT THE SITE, FREQUENCY DISTRIBUTION OF THE WIND SPEED AT THE SITE AND HEIGHT OF THE TOWER.

TO QUALIFY TO CLAIM THIS CREDIT, THE BUILDING PERMIT DRAWINGS SHALL SPECIFY THE OPTION BEING SELECTED AND SHALL SHOW THE PHOTOVOLTAIC OR WIND TURDINE EQUIPMENT TYPE, PROVIDE DOCUMENTATION OF SOLAR AND WIND ACCESS AND INCLIDE A CALCULATION OF THE MINIMUM ANNUAL ENERGY POWER NOTE: 6C/CLIENT MAY MODIFY SELECTIONS TO MEET W.S.E.C.

BUT REQUIRED TOTAL SHALL EQUAL 35 AND JURISPICTION TO

A||2.|8.|/C5A 13|25.|.

A|12.18.1/CSA B|25.1.

DE NOTIFIED / UPDATED PRIOR TO ORDER, INSTALL, & INSPECTION

a. Interior plut placement: pluts included as option 4 of table R4062 shall be placed wholly within the HEATED ENVELOPE OF THE HOUSING UNIT. THE PLACEMENT SHALL BE INSPECTED AND CERTIFIED TO RECEIVE THE CREDITS ASSOCIATED WITH THIS OPTION. EXCEPTION: DUCTS COMPLYING WITH THIS SECTION MAY HAVE UP TO 5% OF THE TOTAL LINEAR FEET OF DUCTS

WILL BE TESTED TO THE FOLLOWING STANDARDS: POST-CONSTRUCTION TEST: LEAKAGE TO OUTDOORS SHALL BE LESS THAN OR EQUAL TO 1 CFM PER 100 SQ FT OF CONDITIONED FLOOR AREA WHEN TESTED AT A PRESSURE DIFFERENTIAL OF O. INCHES W.g. (1997a) ACROSS THE ENTIRE SYSTEM, INCLUDING THE MANUFACTURER'S AIR HANDLER ENCLOSURE ALL REGISTER BOOTS SHALL BE TAPED OR OTHERWISE SEALED DURING THE TEST.

3. RESIDENTIAL SHOWERHEADS: MAXIMUM FLOW RATE - 66 LPM (1.75 GPM) WHEN TESTED IN ACCORDANCE WITH ASME

LOCATED IN THE EXTERIOR CAVITIES OR BUFFER SPACES OF THE DWELLING. IF THIS EXCEPTION IS USED THE

b. Plimbing fixture flow ratings: Low flow plimbing fixtures (water closets and urinals) and fittings (FAUCETS AND SHOWERHEADS) SHALL COMPLY WITH THE FOLLOWING REQUIREMENTS: residential pathroom lavatory sink faucets: Maximum flow rate — 35 LPM (10 6PM) when tested in ACCORDANCE WITH ASME A|12,181,1/05A \$1251. 2. RESIDENTIAL KITCHEN FAUCETS: MAXIMUM FLOW RATE — 66 LPM (175 GPM) WHEN TESTED IN ACCORDANCE WITH

> *NOTE: CLIENT MODIFICATIONS AS OWNER &/OR IN COORD. W/BUILDER FROM CODE DATA RELAITED HEREIN SHALL BE *coo*rdinated with Bidder designer sub-consultants t*o* meet "or equal" APPROACH AND APPROVED BY INDUSTRY TESTING OR OTHER JURISDICTIONALLY-ALLOMED ALTERNATIVE APPROVAL

TOTAL REQUIRED: | 3.5

CHANGES

MUST Be Approved Prior

To Performing Work

REVISIONS

INT. DATE REV **DESIGNER:** Ø DRAFTER: Ø5/17/18 DATE:

SHEET NO:

PROJECT NO: 19198

Established Basic Permit # 19-03650

SU 333 ω

REVISIONS

INT. DATE REV DESIGNER: Ø DRAFTER: Ø5/17/18 DATE:

PROJECT NO: 19198

NOTE: THIS IS BY NO MEANS THE CODES IN

THEIR ENTIRETY, NOR INTENDED TO BE AN

EXHAUSTIVE LIST OF ALL REQUIREMENTS OR

COMPLIANCES. G.C. AND JURISDICTION SHALL HOLD FULL REVIEW RESPONSIBILITY AND GC SHALL MEET LOCAL REQUIREMENTS FOR WORKMANSHIP AND LOCAL JURISDICTIONS, INSPECTIONS, AND THE LIKE, AND SHALL SUPERCEDE THE GENERAL NATURE OF TYPICAL CODE REFERENCES AND NOTES HEREIN AS PROVIDED FOR CONVENIENCE.

SHEET NO:

Established Basic Permit # 19-03650

ADDITIONAL FOOTING INFORMATION: IRC 2015

TO THE EXTERIOR FINISHED GRADE LEVEL

* STEM WALLS AT FOOTINGS SHALL LEAVE 7" CLEAR FROM THE BOTTOM OF THE SOLE PLATE

Permit Number: 20-02542

INTERIOR DIMENSION - CODE COMPLIANCE NOTES

BASED ON INTERNATIONAL RESIDENTIAL CODE (IRC) - 2015 EDITION

<u>CEILING HEIGHT: IRC TABLE R305.1</u>

HABITABLE SPACE, HALLWAYS AND PORTIONS OF BASEMENTS CONTAINING THESE SPACES: 7 MIN. ROOMS WITH SLOPED CEILINGS: AT LEAST 50% MUST BE 7 MIN. AND NO PORTION MUST BE LESS THAN 5' MIN.

BATHROOMS, TOILET ROOMS AND LAUNDRY ROOMS: 6'-8" MIN.

ROOM AREAS:

MINIMUM ROOM AREAS

HABITABLE ROOM FLOOR AREA: 10 SQ.

HABITABLE ROOM DIMENSIONS: 7 MIN. IN ANY HORIZONTAL DIMENSION

HABITABLE ROOM AGGREGATE GLAZING AREA: 8% OF THE FLOOR AREA HABITABLE ROOM VENTILATION OPENABLE AREA: 4% MIN. OF THE FLOOR AREA.

NOTE: NATURAL VENTILATION MUST BE THROUGH WINDOWS, SKYLIGHTS, DOORS, LOUVERS OR OTHER APPROVED OPENINGS TO THE OUTDOOR AIR. SUCH OPENINGS MUST BE READILY CONTROLLABLE BY THE BUILDING OCCUPANTS.

<u>STAIRS / RAILINGS | STAIRWAYS: R311.71 - R311.75</u>

WIDTH: 36" MIN. ALL POINTS ABOVE THE PERMITTED HANDRAIL HEIGHT AND BELOW THE REQUIRED HEADROOM HEIGHT.

CLEAR WIDTH - HANDRAIL INSTALLED ON ONE SIDE: 31-1/2" CLEAR WIDTH - HANDRAIL INSTALLED ON BOTH SIDES: 27"

HANDRAIL PROTECTION: 4-1/2" MAX. ON EITHER SIDE

HEADROOM: 6'-8" MIN. MEASURED VERTICALLY FROM THE SLOPED LINE ADJOINING THE TREAD NOSING OR FROM THE FLOOR SURFACE OF THE LANDING OR PLATFORM.

STAIR RISER HEIGHT: 7-3/4" MAX. MEASURED VERTICALLY BETWEEN LEADING EDGES OF THE ADJACENT TREADS.

RISER TOLERANCE: THE GREATEST RISER HEIGHT WITHIN ANY FLIGHT OF STAIRS MUST NOT EXCEED THE SMALLEST BY MORE THAN 3/8"

RISER SLOPE ANGLE: RISER MUST BE VERTICAL OR SLOPED FROM THE UNDERSIDE OF THE NOSING OF THE TREAD ABOVE AT AN ANGLE NO MORE THAN 30 DEGREES FROM THE VERTICAL. OPEN RISERS: PERMITTED PROVIDED THAT THE OPENING LOCATED MORE THAN 30" AS MEASURED VERTICALLY, TO THE FLOOR OR GRADE BELOW DO NOT PERMIT THE PASSAGE OF A 4" DIA.

TREAD DEPTH: 10" MIN. MEASURED HORIZONTALLY BETWEEN THE VERTICAL PLANES OF THE FOREMOST PROJECTION OF ADJACENT TREADS AND AT A RIGHT ANGLE TO THE TREAD'S LEADING

TREAD TOLERANCE: GREATEST TREAD DEPTH WITHIN ANY FLIGHT OF STAIRS MUST NOT EXCEED THE THE SMALLEST BY MORE THAN 3/8"

NOSING RADIUS OF CURVATURE: 9/16"

SOLID RISER NOSING PROJECTION: 3/4" MIN. TO 1-1/4" MAX.

NOSING PROJECTION TOLERANCE: THE GREATEST NOSING PROJECTION MUST NOT EXCEED THE SMALLEST NOSING PROJECTION BY MORE THAN 3/8" BETWEEN TWO STORIES, INCLUDING THE NOSING AT THE LEVEL OF FLOORS AND LANDINGS.

HANDRAILS: R311.78; R311.8.3

BEVELING OF NOSINGS: 1/2" MAX.

MIN. NUMBER AND LOCATION: MIN. OF I SIDE HANDRAIL ON EACH CONTINUOUS RUN OR FLIGHT WITH 4 OR MORE RISERS.

HEIGHT: 34" MIN. TO 38" MAX. MEASURED VERTICALLY FROM THE SLOPED PLANE ADJOINING THE TREAD NOSING, OR FINISH SURFACE OF RAMP SLOPE.

CONTINUITY: MUST BE CONTINUOUS FOR THE FULL LENGTH OF THE FIGHT, FROM A POINT DIRECTLY ABOVE THE RISER OF THE FLIGHT TO A POINT DIRECTLY ABOVE THE LOWEST RISER OF THE FLIGHT.

ENDS: MUST BE RETURNED OR MUST TERMINATE IN NEWEL POSTS OR SAFETY TERMINALS. CLEARANCE: MIN. 1-1/2" BETWEEN THE WALL AND THE HANDRAIL.

CIRCULAR CROSS SECTION: |-|/4" MIN. TO 2" MAX. OUTSIDE DIAMETER.

NON-CIRCULAR CROSS SECTION: CROSS SECTION 2-1/4"; PERIMETER DIMENSION IS 4" MIN. AND 6-1/4" MAX; 1-1/4" MIN. TO 2" MAX. OUTSIDE DIAMETER.

EDGE RADIUS: 00".

GUARDS - R312.1.1-R312.1.3

LOCATION: ALONG OPEN-SIDED WALKING SURFACES, INCLUDING STAIRS, RAMPS, PORCHES, BALCONIES AND LANDINGS, THAT ARE LOCATED MORE THAN 30" MEASURED VERTICALLY TO THE FLOOR OR GRADE BELOW AT ANY POINT WITHIN 36" HORIZONTALLY TO THE EDGE OF THE OPEN SIDE.

NOTE: INSECT SCREENING IS NOT CONSIDERED AS A GUARD.

HEIGHT OF GUARD: 36" MIN. MEASURED VERTICALLY FROM ABOVE THE ADJACENT WALKING SURFACE OR THE LINE CONNECTING THE LEADING EDGES OF THE TREADS. OPENING LIMITATIONS: GUARDS MUST NOT HAVE OPENINGS FROM THE WALKING SURFACE

TO THE REQUIRED GUARD HEIGHT THAT ALLOW THE PASSAGE OF A SPHERE 4" IN DIAMETER. TRIANGULAR OPENINGS: TRIANGULAR OPENINGS AT THE OPEN SIDE OF STAIR, FORMED BY THE RISER, THREAD AND BOTTOM RAIL OF A GUARD, MUST NOT ALLOW PASSAGE OF A SPHERE 6" IN DIAMETER.

MEANS OF EGRESS

EMERGENCY & RESCUE OPENINGS - R3102.1-R31022

NET CLEAR OPENING AREA: 5.7 FT SQ MIN.

NET CLEAR OPENING HEIGHT: 24" MIN.

NET CLEAR OPENING WIDTH: 20" MIN.

WINDOW STILL HEIGHT: 44" MAX. ABOVE THE FLOOR. THE NET CLEAR OPENING DIMENSIONS REQUIRED BY THIS SECTION MUST BE OBTAINED BY THE NORMAL OPERATION OF THE EMERGENCY ESCAPE AND RESCUE OPENING FROM INSIDE.

BARS, GRILLES, COVERS & SCREENS - R310.4

BARS, GRILLES, COVERS, SCREENS OR SIMILAR DEVICES ARE PERMITTED TO BE PLACED OVER EMERGENCY ESCAPE AND RESCUE OPENINGS, BULKHEAD ENCLOSURES, OR WINDOW WELLS THAT SERVE SUCH OPENING BUT DEVICES MUST BE RELEASABLE OR REMOVABLE FROM THE INSIDE WITHOUT THE USE OF A KEY, TOOL, SPECIAL KNOWLEDGE OR FORCE GREATER THAN THAT WHICH IS REQUIRED FOR NORMAL OPERATION OF THE ESCAPE AND RESCUE OPENING.

<u>EGRESS DOOR - R311.2</u>

NUMBER OF EGRESS DOORS: | MIN. PER DWELLING UNIT.

DOOR STYLE: SIDE-HINGED

CLEAR WIDTH: 32" MIN. MEASURED BETWEEN THE FACE OF THE DOOR AND THE STOP, WITH THE DOOR OPEN 90°

CLEAR HEIGHT: 6'-6" (78") MIN. MEASURED FROM THE TOP OF THE THRESHOLD TO THE BOTTOM OF THE STOP. DOOR HEIGHT: 6-8"

OPERATION: EGRESS DOORS MUST BE ABLE TO BE ABLE TO BE OPENED FROM THE INSIDE OF THE DWELLING THE USE OF AKEY OR SPECIAL KNOWLEDGE OR EFFORT.

WINDOW WELLS - R310.2.3

HORIZONTAL AREA: 9 FT SQ MIN. HORIZONTAL PROJECTION AND WIDTH: 36" MIN. THE AREA OF THE WINDOW WELL MUST ALLOW

THE EMERGENCY ESCAPE AND RESCUE OPENING TO BE FULLY OPENED. WINDOW WELLS WITH A VERTICAL DEPTH MORE THAN 44" MUST BE EQUIPPED WITH A PERMANENTLY AFFIXED LADDER OR STEPS USABLE WITH THE WINDOW IN THE FULLY OPEN POSITION.

LADDERS OR RUNGS INSIDE WIDTH: 12" MIN.

LADDERS OR RUNGS PROJECTION: 3" MIN. FROM THE WALL. LADDERS OR RUNGS SPACING: 18" ON CENTER VERTICALLY FOR THE FULL HEIGHT OF THE WINDOW WELL.

SMOKE ALARMS

<u>CARBON MONOXIDE ALARMS — R3|5</u>

APPROVED CARBON MONOXIDE ALARM MUST BE INSTALLED OUTSIDE OF EACH SEPARATE SLEEPING AREA IN THE IMMEDIATE VICINITY OF THE BEDROOMS.

FOR NEW CONSTRUCTION, CARBON MONOXIDE ALARMS MUST BE PROVIDED IN DWELLING UNITS WHERE THE DWELLING UNIT:

• CONTAINS A FUEL-FIRED APPLIANCE.

HAS AN ATTACHED GARAGE WITH AN OPENING THAT COMMUNICATES WITH THE DWELLING

SMOKE ALARMS LOCATIONS - R314.3

SMOKE ALARMS MUST BE INSTALLED IN ALL OF THE FOLLOWING LOCATIONS: . IN EACH SLEEPING R*OO*M.

2. *O*UTSIDE EACH SEPARATE SLEEPING AREA IN THE IMMEDIATE VICINITY OF THE BEDR*OO*MS. 3. ON EACH ADDITIONAL STORY OF THE DWELLING, INCLUDING BASEMENTS AND HABITABLE

EXCEPTION: CRAWL SPACES AND UNINHABITABLE ATTICS.

INTERIOR WALL COVERINGS

INTERIOR WALL COVERING: R7022

COATS OF PLASTER WHEN APPLIED OVER METAL LATH: THREE (3) MINIMUM COATS OF PLASTER WHEN APPLIED OVER OTHER PERMITTED BASES: TWO (2) MINIMUM

<u>HEATING & COOLING EQUIPMENT - MI4012, MI4014, MI4023, MI4032</u>

BASED ON INTERNATIONAL RESIDENTIAL CODE (IRC) - 2015 EDITION

- HEATING & COOLING EQUIPMENT AND APPLIANCES MUST BE LOCATED WITH RESPECT TO BUILDING CONSTRUCTION AND OTHER EQUIPMENT AND APPLIANCES TO PERMIT MAINTENANCE, SERVICING AND REPLACEMENT.
- CLEARANCE MUST BE MAINTAINED TO PERMIT CLEANING OF HEATING AND COOLING SURFACES; REPLACEMENT OF FILTERS, BLOWERS, MOTORS, CONTROLS AND VENT CONNECTIONS; LUBRICATION OF MOVING PARTS AND ADJUSTMENTS.
- EQUIPMENT AND APPLIANCES INSTALLED OUTDOORS MUST BE LISTED AND LABELED FOR autdoor installation.
- SUPPORTS AND FOUNDATIONS MUST PREVENT EXCESSIVE VIBRATION, SETTLEMENT OR MOVEMENT OF THE EQUIPMENT.

COMBUSTION AIR OPENINGS CLEARANCE IN CENTRAL FURNACES = 6" MIN. IN FRONT OF OPENING.

<u> APPLIANCES IN R*OO*MS — M13*0*5.1.2; M13*0*5.1.3</u>

APPLIANCES INSTALLED IN A COMPARTMENT, ALCOVE, BASEMENT OR SIMILAR SPACE MUST BE ACCESSED BY AN OPENING OR DOOR AND AN UNOBSTRUCTED PASSAGEWAY. UNOBSTRUCTED PASSAGEWAY WIDTH: 24" MIN. AND LARGE ENOUGH TO ALLOW REMOVAL OF

THE LARGEST APPLIANCES IN THE SPACE. THERE MUST BE A LEVEL SERVICE SPACE A MIN. OF 30" DEEP AND THE HEIGHT OF THE APPLIANCE, BUT NOT LESS THAN 30", AT THE FRONT OR SERVICE SIDE OF THE APPLIANCE

<u> APPLIANCES WITH IGNITION SOURCE IN GARAGES — MI307.3</u>

CLEARANCE OF SOURCE OF IGNITION: 18" MIN. ABOVE THE FLOOR IN GARAGES. EXCEPTION: ELEVATION OF IGNITION SOURCE IS NOT REQUIRED FOR APPLIANCES THAT ARE LISTED AS FLAMMABLE VAPOR IGNITION RESISTANT

APPLIANCES MUST NOT BE INSTALLED IN A LOCATION SUBJECT TO VEHICLE DAMAGE EXCEP WHERE PROTECTED BY APPROVED BARRIERS.

APPLIANCES INSTALLED IN ATTICS - M/305.13

WITH THE DOOR OPEN.

 ATTICS CONTAINING APPLIANCES MUST BE PROVIDED WITH AN OPENING AND A CLEAR. AND UNOBSTRUCTED PASSAGEWAY LARGE ENOUGH TO ALLOW REMOVAL OF THE LARGEST APPLIANCE.

UN*O*BSTRUCTED PASSAGEWAY SIZES: 30" MIN. WIDE AND 22" MIN. WIDE AND 20' MAX. LONG MEASURED ALONG THE CENTERLINE OF THE PASSAGEWAY FROM THE OPENING TO THE APPLIANCE.

• A LEVEL SERVICE SPACE A MIN. OF 30" DEEP X 30" WIDE MUST BE PRESENT ALONG A SIDES OF THE APPLIANCE WHERE ACCESS IS REQUIRED.) THE CLEAR ACCESS OPENING DIMENSIONS MUST BE A MIN. OF 20" X 30", AND LARGE

MECHANICAL VENTILATION RATE - MISOT.3.3

ENOUGH TO ALLOW REMOVAL OF THE LARGEST APPLIANCE

WHALEHOUSE MECHANICAL VENTILATION SYSTEM MUST PROVIDE OUTDOOR AIR AT A CONTINUOUS RATE OF NOT LESS THAN THAT DETERMINED IN ACCORDANCE WITH TABLE M1507.3.3(1).

CONTINUOUS WHOLE-HOUSE MECHANICAL VENTILATION SYSTEM AIRFLOW RATE REQUIREMENTS (IRC TABLE MI507.3.3(1))

DWELLING UNIT	NUMBER OF BEDROOMS							
FLOOR AREA	0-1	2–3	4–5	6–7	> 7			
(SQUARE FEET)	AIRFLOW IN CFM							
< 1,500	30	45	60	75	90			
,50 - 3.000	45	60	75	90	105			
3,00 - 4,500	60	75	90	05	120			
4,50 - 6,000	75	90	105	120	35			
6 <i>00</i> - 7 <i>500</i>	90	105	120	35	150			
> 7,500	05	120	35	150	65			
	FOR 51: 50	RUARE FOOT = α	0.0929 m ² , 1 CUB	K FOOT				

PER MINUTE = $0.0004719 \text{ m}^3/\text{s}$ MECHANICAL VENTILATION SYSTEM — MI5007.3.1 WHOLE-HOUSE VENTILATION SYSTEM MUST CONSIST OF:

- ONE OR MORE SUPPLY OR EXHAUST FANS, OR A COMBINATION OF SUCH.
- ASSOCIATED DUCTS AND CONTROLS.
- LOCAL EXHAUST OR SUPPLY FANS PERMITTED TO SERVE AS SUCH A SYSTEM. OUTDOOR AIR DUCTS CONNECTED TO THE RETURN SIDE OF AN AIR HANDLER MUST BE CONSIDERED TO PROVIDE SUPPLY VENTILATION.

THE WHOLE-HOUSE MECHANICAL VENTILATION SYSTEMS MUST BE PROVIDED WITH CONTROLS THAT ENABLE MANUAL OVERRIDE.

LOCAL EXHAUST RATES - MISOT.A LOCAL EXHAUST SYSTEMS MUST BE DESIGNED TO HAVE THE CAPACITY TO EXHAUST THE MIN. AIR FLOW. SEE TABLE MISOT.4

EXHAUST RATES EXHAUSTED MIN. REQUIRED LOCAL EXHAUST RATES FOR 100 cfm INTERMITTENT OR ONE-AND TWO-FAMILY KITCHENS 25 cfm CONTINUOUS DWELLINGS (IRC TABLE MISOTA) BATHROOMS-MECHANICAL EXHAUST CAPACITY OF 50 cfm TOILET ROOMS INTERMITTENT OR 20 cfm CONTINUOUS

EXHAUST HOOD SHOULD HAVE 24" CLEARANCE FROM THE STOVE TOP.

AREAS TO BE

FOR SI: | CUBIC FOOT PER MINUTE = $0.0004719 \text{ m}^3/\text{s}$ CFM = CUBIC FEET PER MINUTE

APPLIANCES UNDER FLOOR - MI305.14

UNOBSTRUCTED PASSAGEWAY SIZE: 30" MIN. HIGH, 22" MIN. WIDE AND 20' MAX. LONG

ALONG THE CENTERLINE OF THE PASSAGEWAY FROM THE OPENING FROM THE APPLIANCE. SERVICE SPACE: 30" DEEP X 30" WIDE AT THE FRONT OF THE APPLIANCE

NOTE: IF THE DEPTH OF THE PASSAGEWAY OR THE SERVICE SPACE EXCEEDS 12" BELOW THE ADJOINING GRADE, THE WALL A OF THE PASSAGEWAY MUST BE LINED WITH CONCRETE OR MASONRY EXTENDING 4" ABOVE THE ADJOINING GRADE.

ROUGH-FRAMED ACCESS OPENING DIMENSIONS: 22" MIN. X 30" MIN. NOTE: ALL SPACES FOR MECHANICAL EQUIPMENT MUST BE LARGE ENOUGH TO ALLOW

REMOVAL OF THE LARGEST APPLIANCE IN THE SPACE.

APPLIANCES MUST BE ACCESSIBLE FOR INSPECTION, SERVICE, REPAIR AND REPLACEMENT WITHOUT REMOVING PERMANENT CONSTRUCTION, OTHER APPLIANCE OR ANY OTHER PIPING OR DUCTS NOT CONNECTED TO THE APPLIANCE BEING INSPECTED, SERVICED, REPAIRED OR REPLACED.

<u>LEVEL WORKING SPACE - M1305.1</u>

LEVEL WORKING SPACE: 30" DEEP X 30" WIDE MIN. IN FRONT OF CONTROL SIDE TO SERVICE AN APPLIANCE.

MECHANICAL EQUIPMENT CLEARENCES - MI305.1.4.1; MI403.2

GROUND SUPPORTED EQUIPMENT: 3" MIN. ABOVE THE GROUND; LEVEL AND FIRMLY SUPPORTED ON CONCRETE SLAB OR OTHER APPROVED MATERIAL. SUSPENDED APPLIANCES: 6" MIN. FROM THE GROUND.

<u> FURNACES & HANDLERS (WITHIN COMPARTMENTS OR ALCOVES) — M1305.[.]</u>

WORKING SPACE CLEARANCE (ALONG SIDES, BACK AND TOP): 3" MIN.

TOTAL WIDTH OF ENCLOSING SPACE: 12" MIN. WIDER THAN THE FURNACE OR AIR HANDLER FURNACE WITH FIREBOX OPEN TO THE ATMOSPHERE: 6" WORKING SPACE ALONG THE FRONT COMBUSTION CHAMBER SIDE.

OVERHEAD EXHAUST HOODS - MISOS.

DOMESTIC OPEN-TOP BROILER UNITS MUST HAVE A METAL EXHAUST HOOD HAVING A MIN. THICKNESS OF 0.0157-INCH (NO. 18 GAGE).

<u>CLEARANCES -</u> HOOD AND UNDERSIDE OF COMBUSTIBLE MATERIAL OR CABINETS: 1/4" MIN.

COOKING SURFACE AND THE COMBUSTIBLE MATERIAL OR CABINETS: 24" MIN. HOOD WIDTH: AS WIDE AS THE BROILER UNIT (MIN.)

HOOD EXTENSION: MUST EXTEND OVER THE ENTIRE UNIT. HOOD DISCHARGE LOCATION: OUTDOORS

EXHAUST SYSTEMS / RANGE HOODS - MISO3.1; MISO3.2 • MUST DISCHARGE TO THE OUTDOORS THROUGH A DUCT.

- DUCT SERVING THE HOOD MUST HAVE A SMOOTH INTERIOR SURFACE, MUST BE AIR TIGHT, MUST BE EQUIPPED WITH A BACK-DAMPER AND MUST BE INDEPENDENT OF ALL OTHER EXHAUST SYSTEMS.
- DUCTS SERVING RANGE HOODS MUST NOT TERMINATE ATTICS OR CRAWL SPACES OR IN ANY AREAS INSIDE THE BUILDING. DUCTS SERVING RANGE HOODS MUST BE CONSTRUCTED OF GALVANIZED STEEL,

<u>EXHAUST SYSTEMS / EXHAUST OPENINGS - MISO6.3</u>

- AIR EXHAUST OPENINGS MUST TERMINATE: • 3' MIN. FROM PROPERTY LINES.
- 3' MIN. FROM OPERABLE AND NON-OPERABLE OPENINGS INTO THE BUILDING AND • 10' MIN. FROM MECHANICAL AIR INTAKES EXCEPT WHERE THE OPENING IS LOCATED 3'
- ABOVE THE AIR INTAKE. RECIRCULATION OF AIR - MISO7.2

STAINLESS STEEL OR COPPER.

- EXHAUST AIR FROM BATHROOMS AND TOILET ROOMS MUST NOT BE RECIRCULATED WITHIN A RESIDENCE OR TO ANOTHER DWELLING UNIT.
- EXHAUST AIR FROM BATHROOMS AND TOILET ROOMS MUST NOT DISCHARGE INTO AN ATTIC, CRAWL SPACE OR OTHER AREAS INSIDE THE BUILDING.
- EXHAUST AIR MUST BE EXHAUSTED DIRECTLY TO THE OUTDOORS.

NOTE: SAME REQUIREMENTS APPLY TO MECHANICAL VENTILATION.

CODE COMPLIANCE NOTES FOR ALL GENERAL IRC CODE COMPLIANCE, SEE SHEETS A-12 AND FOR SECTION RELATED NOTES SUCH AS FOUNDATIONS, FRAMING, INTERIOR SPACES, GENERAL HVAC AND ELECTRICAL IRC REQUIREMENTS. REFER ALSO TO SHEETS A-40 a & c

(*APPLIES TO ALL BUILDING & WALL SECTIONS, AND ADDITIONAL SHEETS HEREIN, U.N.O.)

SEE ADDITIONAL WALL AND BUILDING SECTIONS & SHEETS FOR ADDITIONAL CODE COMPLIANCE REQUIREMENTS WHERE OTHERWISE STATED PER DRAWINGS HEREIN, TYP.

NOTE: THIS IS BY NO MEANS THE CODES IN THEIR ENTIRETY, NOR INTENDED TO BE AN EXHAUSTIVE LIST OF ALL REQUIREMENTS OR COMPLIANCES. G.C. AND JURISDICTION SHALL HALD FULL REVIEW RESPONSIBILITY AND 60 SHALL MEET LOCAL REQUIREMENTS FOR WORKMANSHIP AND LOCAL JURISDICTIONS, INSPECTIONS. AND THE LIKE, AND SHALL SUPERCEDE THE GENERAL NATURE OF TYPICAL CODE REFERENCES AND NOTES HEREIN AS PROVIDED FOR CONVENIENCE.


MUST Be Approved Prior

FRAMIG PLAN ω **₩** < CODE

REVISIONS

TURAL CTION-(

ARCHITECT CONSTRUC COMPLIANC

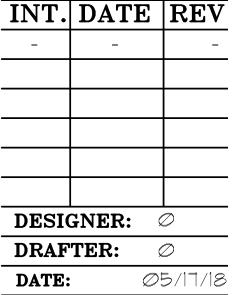

SHEET NO:

PROJECT NO: 19198

Established Basic Permit # 19-03650

Permit Number: 20-02542

20

20

8

20

20

CODE COMPLIANCE NOTES

BASED ON INTERNATIONAL RESIDENTIAL CODE (IRC) - 2015 EDITION

THE CONDUCTOR EMERGES FROM ITS RACEWAY OR CABLE SHEATH

ENGLOSURE / WORKING SPACE & GLEARANCES - E3405.1; E3405.7

LENGTH: 6" MIN. OF FREE CONDUCTOR MUST BE PROVIDED AT EACH OUTLET, JUNCTION OR

WHERE OUTLET, JUNCTION OR SWITCH POINT IS LESS THAN 8" IN ANY DIMENSION.

SYSTEMS MUST BE 3-WIRE, 120/240-VOLT, SINGLE-PHASE WITH A GROUNDED NEUTRAL.

SWITCH POINT WHERE CONDUCTORS ARE TO BE SPLICED, TERMINATED OR CONNECTED TO

MEASURING REQUIRED LENGTH: LENGTH MUST BE MEASURED FROM THE POINT IN THE BOX WHERE

CONDUCTOR'S LENGTH: 3" MIN. OUTSIDE THE OPENING OF AN OUTLET, JUNCTION OR SWITCH POINT

WORKING CLEARANCES FOR ENERGIZED EQUIPMENT, SERVICE EQUIPMENT AND PANEL BOARD

WIDTH: 30" MIN. OR THE WIDTH OF THE EQUIPMENT, WHICHEVER IS GREATER IN FRONT OF

HEIGHT: 6'-6" MIN. OR THE HEIGHT OF THE EQUIPMENT, WHICHEVER IS GREATER IN FRONT

MEASURING DISTANCES: DISTANCES MUST BE MEASURED FROM THE ENERGIZED PARTS WHERE

SUCH PARTS ARE EXPOSED OR FROM THE ENCLOSURE FRONT OR OPENING WHERE SUCH

PARTS ARE EXPOSED OR FROM THE ENCLOSURE FRONT OR OPENING WHERE SUCH PARTS

EXTENSIONS OF ASSOCIATED EQUIPMENT: 6" MAX. ABOVE OR BELOW THE ELECTRICAL

ILLUMINATION: ARTIFICIAL ILLUMINATION MUST BE PROVIDED FOR ALL WORKING SPACES

INSTALLED INDOORS; MUST NOT BE CONTROLLED BY SOLELY AUTOMATIC MEANS.

UNGROUNDED SERVICE CONDUCTORS: NO LESS THAN THE LOAD SERVED

ONE-FAMILY DWELLINGS UNDERGROUND CONDUCTORS: 100 AMPERES, 3 WIRE

ALL OTHER INSTALLATIONS OF THE UNGROUNDED CONDUCTORS: 60 MIN. AMPERES

HABITABLE ROOMS & BATHROOMS: | MIN. WALL SWITCH-CONTROLLED LIGHTING OUTLET.

ADDITIONAL LOCATIONS: | MIN. WALL SWITCH-CONTROLLED LIGHTING OUTLET IN HALLWAYS,

STAIRWAYS, ATTACHED GARAGES, AND DETACHED GARAGES WITH ELECTRIC POWER AND AT

EXTERIOR SIDE OF EACH OUTDOOR EGRESS DOOR, ATTICS, UNDER-FLOOR SPACES, UTILITY

NOTE: IN ADDITION, A LIGHTING OUTLET MUST BE PROVIDED AT OR NEAR EQUIPMENT THAT

WALL COUNTERTOP RECEPTACLES OUTLETS: | AT EACH WALL COUNTERTOP SPACE 12" OR

NOTE: SAME REQUIREMENT APPLIES TO PENINGULAR COUNTERTOP SPACES. A PENINGULA

COUNTERTOP IS MEASURED FROM THE COUNTERTOP EDGE.

SPECIFIC APPLIANCE. SPECIFIC APPLIANCE EXAMPLE: LAUNDRY EQUIPMENT.

RECEPTACLE LOCATION/SPACING: 6" MAX. DISTANCE FROM ANY POINT MEASURED HORIZONTALLY

WIDER; NO POINT MUST BE MORE THAN 24" FROM THE RECEPTAGLE OUTLET SERVING THAT

ISLAND COUNTERTOP OUTLETS: I MIN. WHEN THE DIMENSION OF THE ISLAND IS GREATER THAN

APPLIANCE RECEPTACLE OUTLETS: INSTALLED WITHIN 6' OF THE INTENDED LOCATION OF THE

LAVATORY BASIN ON A WALL OR PARTITION THAT IS ADJACENT TO THE LAVATORY BASIN

BATHROOM RECEPTACLE OUTLETS: | MIN.; LOCATED WITHIN 36" OF THE OUTSIDE EDGE OF EACH

IMPORTANT NOTE: RECEPTACLE OUTLETS MUST BE INSTALLED IN A FACE-UP POSITION IN THE

OUTDOOR RECEPTAGLE OUTLETS: | MIN.; INSTALLED OUTDOORS AT THE FRONT AND BACK OF

BALCONIES, DECKS AND PORCHES RECEPTAGLE OUTLETS: | MIN.; INSTALLED WITHIN THE

BASEMENTS AND GARAGES RECEPTACLE OUTLETS: | MIN. IN EACH SEPARATE, UNFINISHED

HALLWAYS RECEPTACLE OUTLET: I MIN. IF THE HALLWAY IS ID OR GREATER IN LENGTH.

UNDER THE CONDITIONS OF USE WITHOUT EXCEEDING ITS TEMPERATURE RATING.

THE CAPACITY TO CONDUCT SAFELY ANY FAULT CURRENT LIKELY TO BE IMPOSED.

CONNECTED LUMINARIES THAT ARE NOT A PART OF AN APPLIANCE.

BRANCH CIRCUIT: THE CIRCUIT CONDUCTORS BETWEEN THE FINAL OVER CURRENT DEVICE

• BRANCH CIRCUIT, APPLIANCE: A BRANCH CIRCUIT THAT SUPPLIES ENERGY TO ONE OR MORE

OUTLETS TO WHICH APPLIANCES ARE TO BE CONNECTED, AND THAT HAS NO PERMANENTLY

PORTION OF THE BASEMENT IN ADDITION TO REQUIRED SPECIFIC APPLIANCE RECEPTACLE

NOTE: SAME REQUIREMENTS APPLY TO UNFINISHED PORTIONS OF BASEMENTS AND ACCESSORY

AMPACITY: THE MAX CURRENT IN AMPERES THAT A CONDUCTOR CAN CARRY CONTINUOUSLY

BONDING: CONNECTING TO ESTABLISH ELECTRICAL CONTINUITY AND CONDUCTIVITY. BONDING

BONDING MUST BE PROVIDED WHERE NECESSARY TO ENSURE ELECTRICAL CONTINUITY AND

PERIMETER OF THE BALCONY, DECK OR PORCH, LOCATED 6'-6" MAX. ABOVE GRADE.

LOCATION, LOCATED ON THE COUNTERTOP, OR INSTALLED ON THE SIDE OR FACE OF THE BASIN

WORK SURFACES OR COUNTERTOPS IN A BATHROOM BASIN LOCATION.

LENGTH OF CONDUCTOR FOR SPLICE OR TERMINATION:

LENGTH OF CONDUCTOR - E3406.11.3

FIXTURES OR DEVICES

<u>VOLTAGE RATING - E3602.4</u>

DEPTH: 36" MIN.

EQUIPMENT.

OF THE EQUIPMENT.

ENCLOSURES MUST BE AS FOLLOWS:

DOOR OR HINGED PANELS OPENING: 90°

<u>AMPACITY / UNDERGROUND CONDUCTORS - E3602.</u>

<u>RECEPTACLE / OUTLETS - E390121; 39014 - E3901.10</u>

ALONG THE FLOOR LINE OF ANY WALL SPACE.

CABINET 12" MAX. BELOW THE TOP BASIN.

EACH DWELLING UNIT; LOCATED 6'-6" MAX. ABOVE GRADE.

PROTECTING THE CIRCUIT AND THE OUTLET(S).

<u>LIGHTING OUTLETS - E903.2-E3903.4</u>

REQUIRES SERVICING.

ROOMS, BASEMENTS.

24" I ONG X 12" SHORT.

SPACE.

TERM ALERT -

BASIC PERMIT PACKAGE REVIEWED FOR CODE COMPLIANCE KITSAP COUNTY BUILDING DEPARTMENT

PLUMBING - CODE COMPLIANCE NOTES BASED ON INTERNATIONAL RESIDENTIAL CODE (IRC) - 2015 EDITION REQUIRED CAPACITIES AT POINT OF OUTLET DISCHARGE - IRC TABLE P2903. FIXTURE SUPPLY OUTLET SERVING FLOW RATE (gpm) | FLOW PRESSURE (gpm) <u>TRENCHING & BEDDING - P2604.1</u> WHERE TRENCHES ARE EXCAVATED IN ORDER FOR THE BOTTOM OF THE TRENCH TO FORM THE BATHTUB, BALANCED-PRESSURE, BED FOR THE PIPE, SOLID AND CONTINUOUS LOAD-BEARING SUPPORT MUST BE PROVIDED THERMOSTATIC MIXING VALVE BETWEEN JOINTS. OR COMBINATION PROTECTION OF FOOTINGS - P2604.4 BIDET, THERMOSTATIC MIXING VALVE • TRENCHING INSTALLED PARALLEL TO FOOTINGS AND WALLS MUST NOT EXTENT INTO THE BEARING PLANE OF A FOOTING OR WALL. 2.75 DISHWASHER • THE UPPER BOUNDARY OF THE BEARING PLANE IS A LINE THAT EXTENDS DOWNWARD, AT AN LAUNDRY TRAY ANGLE OF 45 DEGREES FROM HORIZONTAL, FROM THE OUTSIDE BOTTOM EDGE OF THE FOOTING OR WALL. LAVAT*O*RY 03 WASTE OUTLETS - p27|1.3; p27|2.4; p27|3.1; p27|4.1 SHOWER, BALANCING-PRESSURE, 2.5 LAVATORY WASTE OUTLETS: |-|/4" IN DIAMETER. THERMOSTATIC OR COMBINATION A STRAINER, POP-UP STOPPER, CROSSIBAR OR OTHER DEVICE MUST BE PROVIDED TO RESTRICT SILLCOCK, HOSE BIBB 5 THE CLEAR OPENING OF THE WASTE OUTLET 1.75 SINK WASTE OUTLETS: |-|/2|' DIAMETER. A STRAINER, CROSSBAR OR OTHER DEVICE MUST BE PROVIDED TO RESTRICT THE CLEAR WATER CLOSET, FLUSHOMETER TANK OPENING OF THE WASTE OUTLET. WATER CLOSET, TANK, CLOSE COUPLED 3 BATHTUB OUTLETS: |-|/2" DIAMETER BATHTUB WASTE OUTLETS AND OVERFLOWS: BATHTUBS MUST BE EQUIPPED WITH A WASTE WATER CLOSET, TANK, ONE-PIECE OUTLET AND AN OVERFLOW OUTLET. THE WASTE OUTLET MUST BE EQUIPPED WITH A WATER-TIGHT STOPPER. FOR SI: | GALLON PER MINUTE = 3.785 L/m, FLUSH VALVES IN FLUSH TANKS: I" MIN. ABOVE THE FLOOD-LEVEL RIM OF THE BOWL CONNECTED | POUND PER SQUARE INCH = 6895 k/Pa. THERETO. <u>PLUMBING FIXTURES / TAIL PIECES - P2703</u> WASTE RECEPTORS - P2706 FIXTURE TAIL PIECES FOR SINKS, DISHWASHERS, LAUNDRY TUBS, BATHTUBS AND SIMILAR FIXTURES: FOR OTHER THAN HUB DRAINS THAT RECEIVE ONLY CLEAR—WATER WASTE AND STANDPIPES, I-1/2" MIN. IN DIAMETER A REMOVABLE STRAINER OR BASKET MUST COVER THE WASTE OUTLET OF WASTE OF WASTE FIXTURE TAIL PIECES FOR BIDETS, LAVATORIES AND SIMILAR FIXTURES: 1-1/4" MIN. IN DIAMETER) WASTE RECEPTORS MUST NOT BE INSTALLED IN CONCEALED SPACES, PLENUMS, ATTICS, FIXTURES WITH CONCEALED SLIP-JOINT CONNECTIONS MUST BE PROVIDED WITH AN ACCESS PANEL CRAWL SPACES OR INTERSTITIAL SPACES ABOVE CEILINGS AND BELOW FLOORS. OR UTILITY SPACE 12" MIN. IN ITS SMALLEST DIMENSION — P2704. WASTE RECEPTORS MUST BE READILY ACCESSIBLE. <u>PLUMBING FIXTURES / INSTALLATION - P2705.1</u> • HUB DRAINS MUST BE IN THE FORM OF A HUB OR A PIPE THAT EXTENDS A MIN. OF I" ABOVE A WATER-IMPERVIUOS FLOOR. FLOOR-OUTLET OR FLOOR- MOUNTED FIXTURES: MUST BE SECURED TO THE DRAINAGE CONNECTION AND THE FLOOR, BY SCREWS, BOLTS, WASHERS, NUTS AND SIMILAR FASTENERS O STANDPIPES MUST EXTEND 18" MIN. AND 42" MAX ABOVE THE TRAP WEIR. OF COPPER, COPPER ALLY OR OTHER CORROSION-RESISTANTMATERIAL WHERE A LAUNDRY TRAY WASTE LINE CONNECTS INTO A STANDPIPE FOR AN AUTOMATIC WALL-HUNG FIXTURES: MUST BE RIGIDLY SUPPORTED SO THAT STRAIN IS NOT TRANSMITTED TO CLOTHES WASHER DRAIN, THE STANDPIPE MUST EXTEND 30" MIN. ABOVE THE STANDPIPE TRAP THE PLUMBING SYSTEM. WEIR AND MUST EXTEND ABOVE THE FLOOD LEVEL RIM OF THE LAUNDRY TRAY. WATER TIGHT CONTACT AREA: WHERE FIXTURES COME IN CONTACT WITH WALLS AND FLOORS, • THE OUTLET OF THE LAUNDRY TRAY MUST BE 30" MAX. HORIZONTALLY FROM THE STANDPIPE THE CONTACT AREA MUST BE WATER TIGHT. FUNCTIONALITY: PLUMBING FIXTURES MUST BE USABLE. PLUMBING FIXTURES THAT ARE USED FOR WASHING AND BATHING MUST NOT BE USED TO RECEIVE THE DISCHARGE OF INDIRECT WASTE PIPING. BATHROOM CLEARANCES - R305.; R307.; P2708 CLEARANCE FOR WATER CLOSETS, LAVATORIES AND BIDETS: 15" MIN. FROM ITS CENTER TO SIDE MAX. FLOW RATES AND CONSUMPTION FOR PLUMBING WALL, PARTITION OR VANITY. FIXTURES AND FIXTURE FITTINGSD - P1903.1 CLEARANCES BETWEEN ADJACENT FIXTURES: 30" MIN. CENTER-TO-CENTER. PLUMBING FIXTURE OR PLUMBING FIXTURE CLEARANCE IN FRONT OF WATER CLOSET: 21" MIN. THE LOCATION OF PIPING, FIXTURES OR OR FIXTURE FITTING FIXTURE FITTING EQUIPMENT MUST NOT INTERFERE WITH THE OPERATION OF WINDOWS OR DOORS. LAVATORY FAUSCET 2.2 gpm at *60* psi SHOWER COMPARTMENTS - P2708 SHOWER HEAD a 25 apm at 80 psi INTERIOR CROSS-SECTIONAL AREA: 900 SQ. IN. DIMENSION: 30" MIN. MEASURED FROM THE FINISHED INTERIOR DIMENSION OF THE SHOWER SINK FAUSCET 2.2 gpm at *60* psi COMPARTMENT, EXCLUSIVE OF FIXTURE VALVES, SHOWER HEADS, SOAP DISHES AND SAFETY GRAB WATER CLOSET 1.6 GALLONS PER FLUSHING CYCLE BARS OR RAILS. FOR SI: | GALLON PER MINUTE = 3.785 L/mACCESS AND EGRESS OPENING WIDTH: 22" MIN. I POUND PER SQUARE INCH = 6895 kPa. SHOWER DRAINS OUTLET SIZES: |-1/2" IN DIAMETER. HIGH LIMIT STOP WATER TEMPERATURE: 120 DEGRESS F MAX. a. A HANDHELD SHOWER SPRAY IS ALSO A SHOWER HEAD. OTHER SHOWER CLEARANCES: b. CONSUMPTION TOLERANCES BUST BE DETERMINED FROM REFERENCED STANDARDS. HINGED SHOWER DOORS MUST OPEN OUTWARD. • THE WALL AREA ABOVE BUILT-IN TUBS BUST FROM A WATER-TIGHT JOINT WITH EACH OTHER PLUMBING FIXTURES / ACCESS TO CONNECTIONS - P2704 AND WITH EITHER THE TUB, RECEPTOR OR SHOWER FLOOR. SLIP JOINTS MUST BE MADE WITH AN APPROVED ELASTOMERIC GASKET. THE MINIMUM REQUIRED AREA AND DIMENSION MUST BE MEASURED FROM THE FINISHED SLIP JOINTS INSTALLATION LOCATIONS = TRAP OUTLET, TRAP INLET AND WITHIN THE TRAP SEAL. INTERIOR DIMENSION AT A HEIGHT EQUAL TO THE TOP OF THE THRESHOLD AND AT A POINT FIXTURES WITH CONCEALED SLIP-JOINT CONNECTIONS MUST BE PROVIDED WITH AN ACCESS TANGENT TO ITS CENTERLINE AND MUST BE CONTINUED TO A HEIGHT OF NOT LESS THAN PANEL OR UTILITY SPACE OF 12" MIN. IN ITS SMALLEST DIMENSION OR OTHER APPROVED 10" ABOVE THE SHOWER DRAIN OUTLET. ARRANGEMENT SO AS TO PROVIDED ACCESS TO THE SLIP CONNECTIONS FOR INSPECTION WATER SUPPLY RISERS FROM THE SHOWER VALVE TO THE SHOWER HEAD OUTLET, WHETHER AND REPAIR. EXPOSED OR CONCEALED, MUST BE ATTACHED TO THE STRUCTURE USING SUPPORT DEVICES DESIGNED FOR USE WITH THE SPECIFIC PIPING MATERIAL OR FITTINGS ANCHORED WITH HORIZONTAL DRAINAGE PIPING SLOPE - P3005.3 SCREWS. MIN. SLOPES OF PIPES WITH DIAMETER 2-1/2" OR LESS: 1/4 UNIT VERTICAL IN 12 UNITS HORIZONTAL (2% SLOPE) MIN. SLOPES OF PIPES WITH DIAMETER 3" OR GREATER: 1/8 UNIT VERTICAL IN 12 UNITS HORIZONTAL (1% SLOPE) BACKFILLING - P2604.3 PIPES MUST BE COVERED BY TAMPED EARTH = 12" MIN. BACKFILL MUST BE FREE FROM: DISCARDED CONSTRUCTION MATERIAL AND DEBRIS • ROCKS, BROKEN CONCRETE AND FROZEN CHUNKS BACKFILL LOCATION = BOTH SIDES OF THE PIPE BACKFILL MUST BE PLACED EVENLY AND TAMPED TO RETAIN PROPER ALIGNMENT.

• LOOSE EARTH MUST BE CAREFULLY PLACED IN THE TRENCH IN 6" LAYERS AND TAMPED

• ALLOW MOVEMENT ASSOCIATED WITH THE EXPANSION AND CONTRACTION OF THE PIPING

PROPORTIONAL SHARE OF WEIGHT OF PIPE AND CONTENTS AND OF SUFFICIENT WIDTH TO

RIGID SUPPORT SWAY BRACING MUST BE PROVIDED AT CHANGES IN DIRECTION GREATER THAN

HANGERS AND STRAPPING MUST BE OF APPROVED MATERIAL THAT DOES NOT PROMOTE

PIPING IN THE GROUND MUST BE LAID ON A FIRM BED FOR ITS ENTIRE LENGTH.

HANGERS AND ANCHORS MUST BE OF SUFFICIENT STRENGTH TO MAINTAIN THEIR

IN PLACE.

PIPE SUPPORT - P2605

ENSURE ALIGNMENT.

PREVENT SAGGING.

GALVANIC ACTION.

PIPING MUST SUPPORTED TO:

PREVENT DISTORTION TO THE PIPE.

45 DEGREES FOR PIPE SIZES 4" AND LARGER.

BRANCH-CIRCUIT REQUIREMENTS-SUMMARY a,b - IRC TABLE E3702.14 CIRCUIT RATING 20 AMP 30 AMP CONDUCTORS: MIN. SIZE (AGW) CIRCUIT CONDUCTORS MAX. OVER-CURRENT PROTECTION DEVICE 30 RATING AMPERES RATING OUTLET DEVICES: LAMP HOLDERS PERMITTED N/A 30 RECEPTACLE RATING (AMPERES) 15 OR 20 15 MAX. MAX. LOAD (AMPERES) THESE GAGES ARE FOR COPPER CONDUCTORS DN/A = NOT ALLOWED

<u>SERVICES - E36012; E36013; E36014</u>

• ONE-AND TWO FAMILY DWELLINGS MUST BE SUPPLIED BY ONLY ONE SERVICE.

- SERVICE CONDUCTORS SUPPLYING A BUILDING OR OTHER STRUCTURE MUST NOT PASS THROUGH THE INTERIOR OF ANOTHER BUILDING OR THROUGH ANOTHER STRUCTURE.
- ONDUCTORS OTHER THAN SERVICE CONDUCTORS MUST NOT INSTALLED IN THE SAME SERVICE RACEWAY OR SERVICE CABLE.

<u> SURFACE & UNDERGROUND INSTALLATION — E3802.3.1; E3803.1</u>

- SURFACE INSTALLATION · CABLES MUST CLOSELY FOLLOW THE SURFACE OF THE BUILDING FINISH OR RUNNING BOARDS. UNDERGRAUND INSTALLATION
- UNDERGROUND SERVICE CONDUCTORS THAT ARE NOT ENCASED IN CONCRETE AND THAT ARE BURIED 18" OR MORE BELOW GRADE MUST HAVE THEIR LOCATION IDENTIFIED BY A WARNING RIBBON THAT IS PLACED IN THE TRENCH 12" MIN. ABOVE THE UNDERGROUND INSTALLATION.
- DIRECT BURIED CONDUCTORS AND CABLES EMERGING FROM THE GROUND MUST BE PROTECTED BY ENCLOSURES OR RACEWAYS EXTENDING FROM THE MIN. COVER DISTANCE BELOW GRADE A POINT AT LEAST 8' ABOVE FINISHED GRADE.
- CONDUCTORS ENTERING A BUILDING MUST BE PROTECTED TO THE POINT OF ENTRANCE.

<u> CABLE PROTECTION - E3801.3.1; E3801.3.3</u>

- WHERE SUBJECT TO PHYSICAL DAMAGE, CABLES MUST BE PROTECTED BY RIGID METAL CONDUIT, INTERMEDIATE METAL CONDUIT, ELECTRICAL METALLIC TUBING, SCHEDULE 80 PVC RIGID NON-METALLIC CONDUIT, OR OTHER APPROVED MEANS.
-) WHERE PASSING THR*O*UGH A FL*OO*R, THE CABLE MUST BE ENCLOSED IN RIGID METAL CONDUIT, INTERMEDIATE METAL *CO*NDUIT, ELECTRICAL METALLIC TUBING, SCHEDULE *80* PVC RIGID NON-METALLIC CONDUIT, OR OTHER APPROVED MEANS. EXTENDING A MIN. OF 6" ABOVE THE
- WHERE EXPOSED TO SUNLIGHT, CONDUCTORS AND CABLES MUST BE MARKED AS "SUNLIGHT RESISTANT" OR BE COVERED WITH INSULATING MATERIAL LISTED "SUNLIGHT RESISTANT".

16FC1 AND AFC1 ELECTRICAL DEVICES

A GFCI AND AN AFCI ARE DIFFERENT ELECTRICAL DEVICES THAT PERFORM DIFFERENT KINDS OF ACTIONS.

- A GROUND-FAULT CIRCUIT INTERRUPTER (GFCI) IS DESIGNED TO PREVENT ELECTRICAL SHOCK. EFCI'S ARE REQUIRED IN DAMP AREAS AND OUTSIDE AREAS.
- AN ARC-FAULT CIRCUIT INTERRUPTER (AFCI) IS DESIGNED TO PREVENT ELECTRICAL FIRES. AFCIS ARE REQUIRED IN ALL SLEEPING AREAS, BEDROOMS, DENS ETC.

CODE COMPLIANCE NOTES

REFER ALSO TO SHEETS A-400&b

(*APPLIES TO ALL BUILDING & WALL SECTIONS, AND <u>ADDITIONAL SHEETS HEREIN, U.N.O.)</u>


NOTE: THIS IS BY NO MEANS THE CODES IN THEIR ENTIRETY, NOR INTENDED TO BE AN EXHAUSTIVE LIST OF ALL REQUIREMENTS OR COMPLIANCES. G.C. AND JURISDICTION SHALL HOLD FULL REVIEW RESPONSIBILITY AND GC SHALL MEET LOCAL REQUIREMENTS FOR WORKMANSHIP AND LOCAL JURISDICTIONS, INSPECTIONS, AND THE LIKE, AND SHALL SUPERCEDE THE GENERAL NATURE OF TYPICAL CODE REFERENCES AND NOTES HEREIN AS PROVIDED FOR CONVENIENCE.

MUST Be Approved Prior To Performing Work

> FRAMIG PLAN 0 $\bigcirc \omega$

CODE

REVISIONS

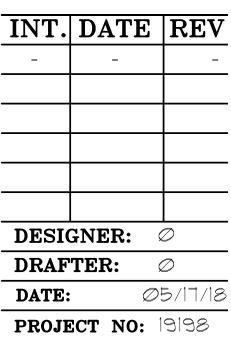

SHEET NO:

Established Basic Permit # 19-03650

Permit Number: 20-02542

FOR ALL GENERAL IRC CODE COMPLIANCE, SEE SHEETS A-1.2 AND FOR SECTION RELATED NOTES SUCH AS FOUNDATIONS, FRAMING, INTERIOR SPACES, GENERAL HVAC AND ELECTRICAL IRC REQUIREMENTS,


SEE ADDITIONAL WALL AND BUILDING SECTIONS & SHEETS FOR ADDITIONAL CODE COMPLIANCE REQUIREMENTS WHERE OTHERWISE STATED PER DRAWINGS HEREIN, TYP.

BASIC PERMIT PACKAGE
REVIEWED FOR CODE COMPLIANCE
WITH IRC 2015
KITSAP COUNTY BUILDING DEPARTMENT

Smoke & carbon monoxide detectors required. Smoke and carbon monoxide detectors must be installed throughout the building in all locations required by the IRC as amended by WAC.

Reviewed for code compliance with IRC 2015 with Building Departmen Kitsap County Building Na.us gshapiro@co.kitsap.wa.us 08/05/2020

Manufacturer's installation instructions and specs shall be on site at time of inspection

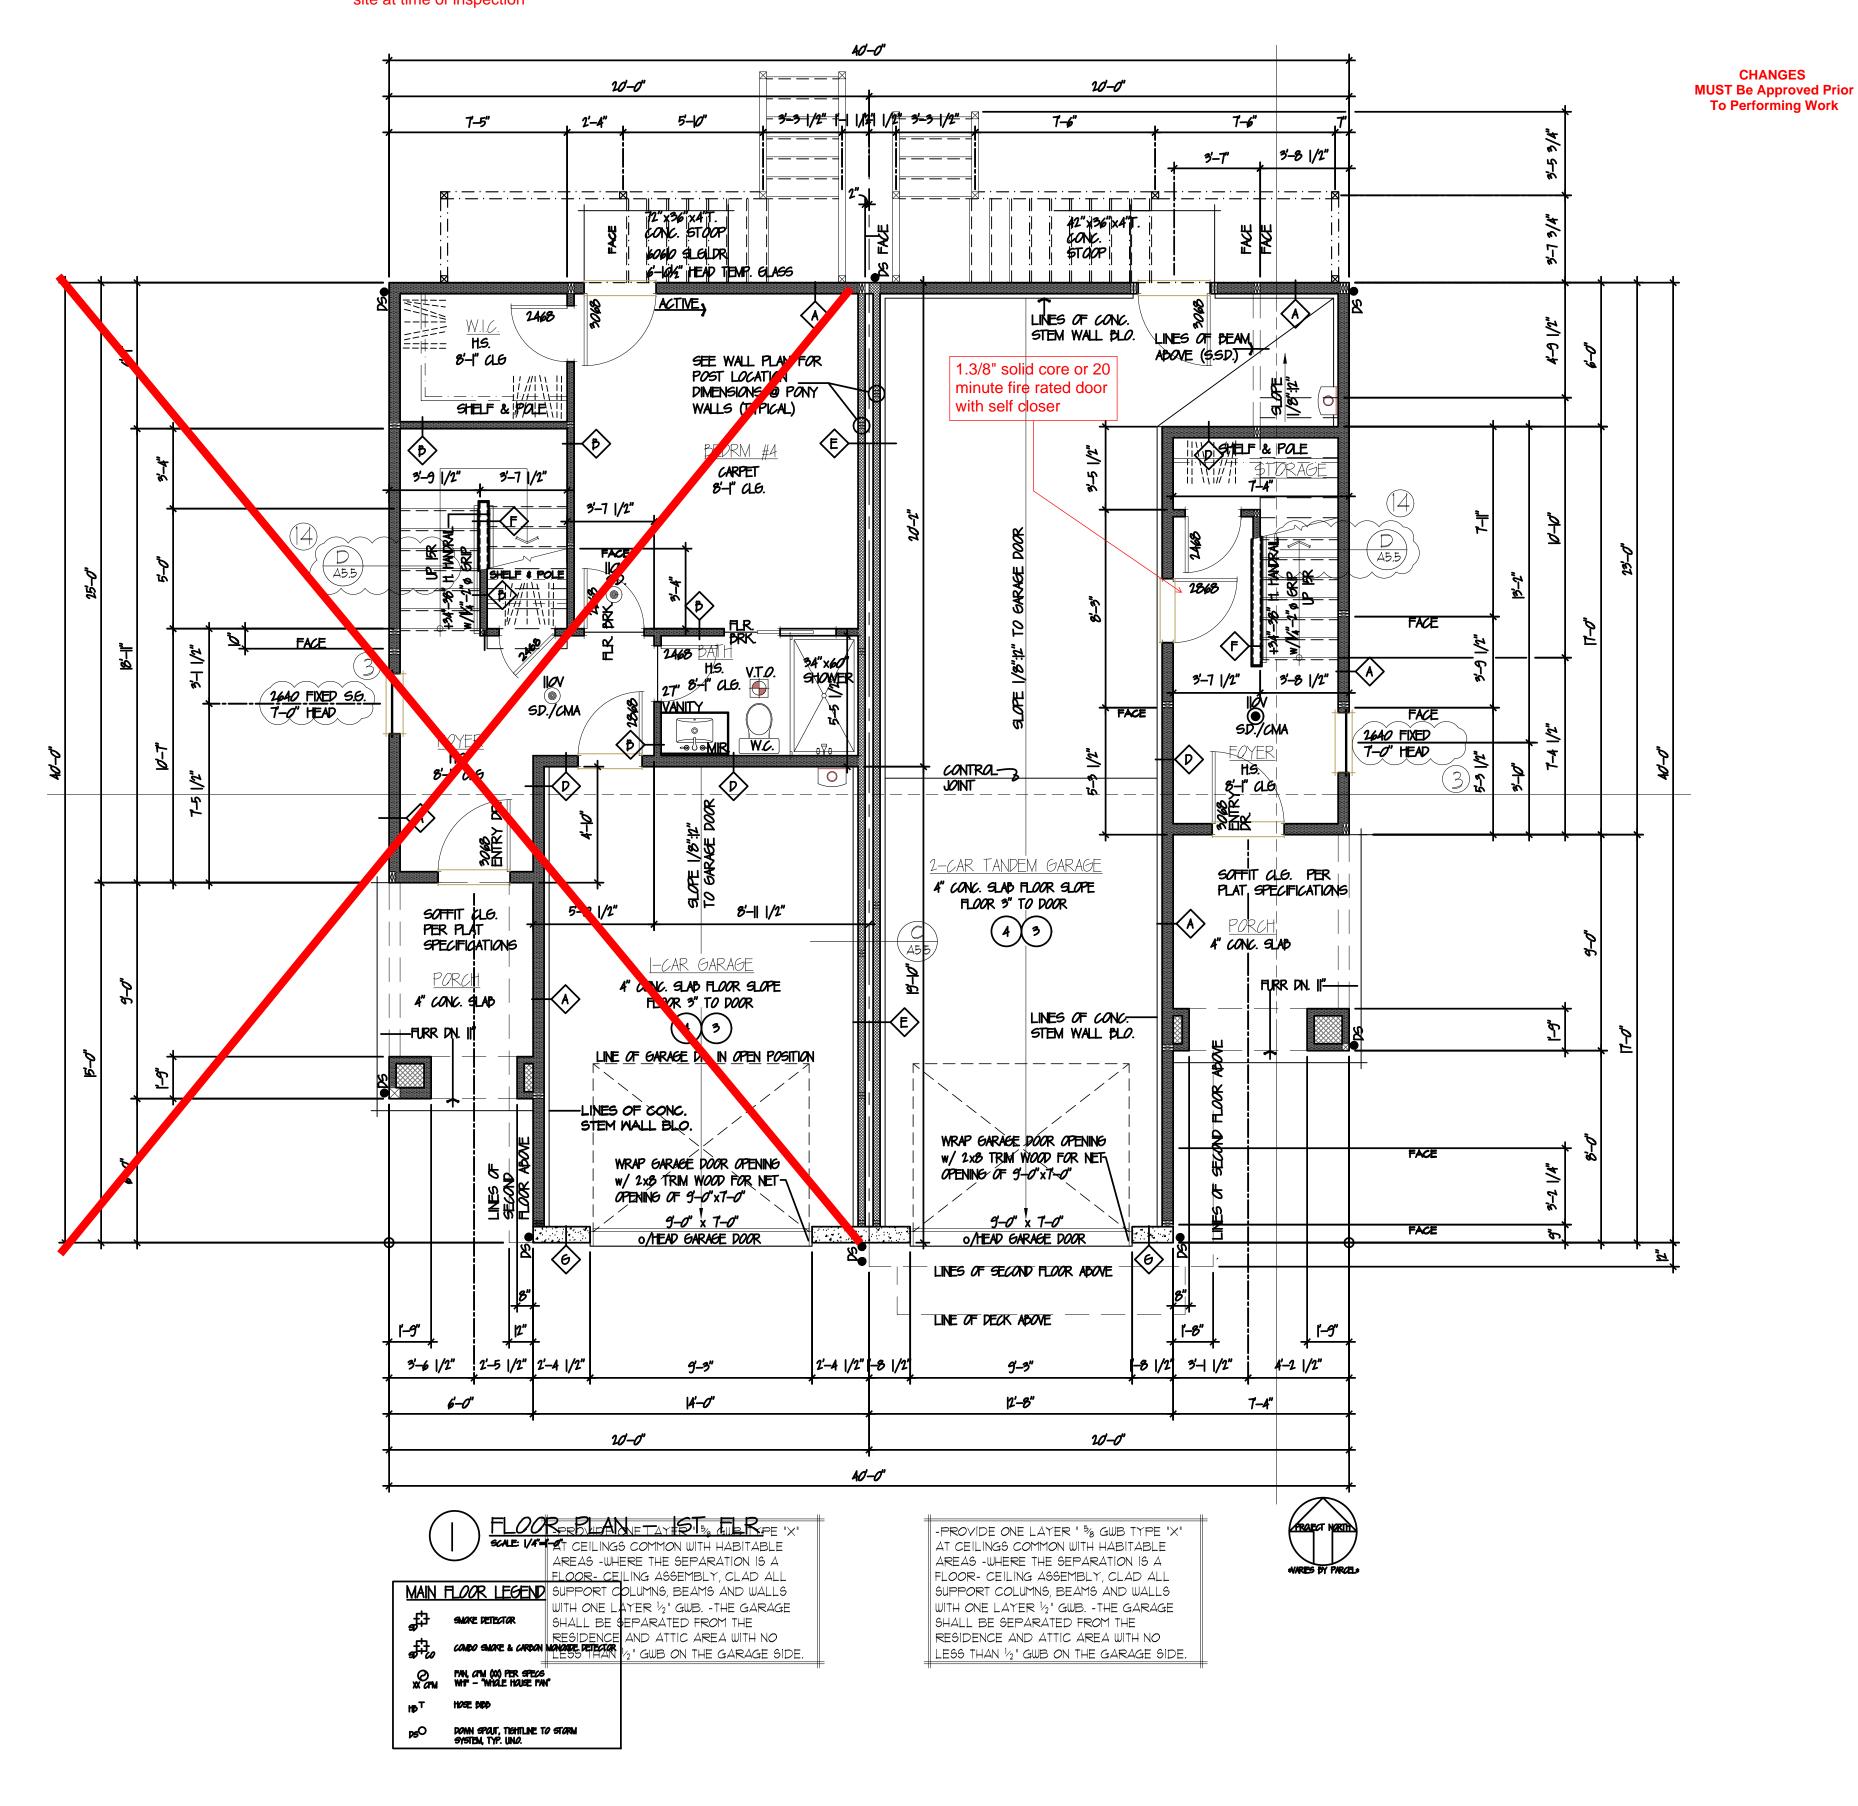

GENERAL PLAN NOTES

I. BASED ON DESIGN INTENT DOCUMENTS PROVIDED HEREIN, OWNER TO PROVIDE, VERIFY, OR OTHERWISE APPROVE ALL PRODUCT AND MATERIAL SELECTIONS PRIOR TO 60 ORDER AND OR INSTALLATION OF ANY PRODUCTS / MATERIALS RELATED TO PROJECT.

2. PROVIDE THERMAL AND SOUND BATT INSULATION AT ALL FLOORS, WALLS, RAFTERS, AND INTERIOR PARTITIONS UNLESS OTHERWISE NOTED. SEE THERMAL VALUES / TABLES IN GENERAL ARCHITECTURAL NOTES SHEET(S). INSULATION MAY NOT BE SHOWN FOR CLARITY.

3. DOORS AND WINDOWS SHOWN FOR DESIGN INTENT SIZE AND LOCATION ONLY. SEE SCHEDULES AND ELEVATIONS FOR COORDINATION.

4. UNLESS OTHERWISE NOTED, ALL EXTERIOR STUDS ARE NOMINAL 2x6. ALL INTERIOR PLIMIDING WALLS ARE NOMINAL 2x6. ALL OTHER INTERIOR STUDS ARE NOMINAL 2x4. SEE BUILDING AND WALL SECTIONS FOR TYPICAL WALLTYPES AND SHEET A-4XX SERIES SHEETS FOR ADDITIONAL INFO.

5. UNLESS ØTHERWISE NØTED, ALL DIMENSION LINES ARE ASSUMED TO BE FROM FACE OF STUD. C IS TO SHOW CENTERLINE DIMENSIONS.

6. SEE ADD'L. A-2XX & A-3XX SERIES FOR ALL DOOR AND WINDOW TYPES, DIMENSIONS. TRIM, HARDWARE AND ADDITIONAL RELATED INFO. MAY BE FOUND IN SCHEDULES WHEN/AS PROVIDED HEREIN.

7. GC. AND OWNER TO COORD. FOR APPROVAL OF TYPICAL INTERIOR FINISHES NOT SPECIFICALLY STATED ON FLOOR PLANS OR IN OTHER SHEETS/DESIGN INFO. HEREIN.

8. ANYWHERE MIN. REQUIREMENTS ARE CALLED OUT ON DRAWINGS, REFER TO GENERAL NOTES, SPECIFICATIONS, AND APPLY ADHERENCE TO MOST RESTRICTIVE CODE AND/OR SPECIFICATION REFERENCE, AS WELL AS BEST INDUSTRY PRACTICES.

FLOOR PLAN NOTES

I) ALL HABITABLE SLEEPING ROOMS TO RECEIVE CLG. MOUNTED SMOKE DETECTORS, HARD WIRED W/ BATTERY BACKUPS.

2) ALL BATHROOMS, SHOWER ROOMS TO RECEIVE CLG. FANS (SEPARATE UNIT OR COMBO FAN/LIGHT TBD) - CODE REQ'D. CFM MIN. UNO. - VENT TO EXTERIOR, TYP.

3) ALL PLIMBING AND ASSOCIATED WORK TO BE BIDDER DESIGN & COORDINATED WITH DESIGN INTENT AS SHOWN THROUGHOUT THESE DRAWINGS ALONG WITH RELATED 66. SUB PERMITTING & RELATED CODE COMPLIANCE.

4) ALL ELECTRICAL AND ASSOCIATED WORK TO BE BIDDER DESIGN & COORDINATED WITH DESIGN INTENT AS SHOWN THROUGHOUT THESE DRAWINGS ALONG WITH RELATED 66. SUB PERMITTING & RELATED CODE COMPLIANCE.

5) FACTORY-BUILT WOOD STOVE INSTALLATION TO COMPLY WITH MANUFACTURER'S REQUIREMENTS, AS WELL AS I.R.C. 1004:1-4. & WITH KITSAP COUNTY BROCHURE #75 TITLED "WOODSTOVES AND FIREPLACES" & WITH 2006 NFPA. 2011.

6) ALL INTERIOR DOORS ARE UNRATED SOLID CORE WOOD DOORS, UN.O. ELSEWHERE IN DOCS. HEREIN.

GENERAL WALL TYPES

EXTERIOR WALL CONSTRUCTION —
SIDING PER ELEVATIONS OVER AIR BARRIER HOUSE WRAP OVER
1/16" CDX PLYWOOD (ALT. 05B) SHEATHING (VERIFY W/ STRUCT.
ENGINEERING &/OR PRESCRIPTIVE DESIGN) OVER 1x6 STUDS @
16" OC. W/ BATT INSULATION (R-21 MIN. OR AS CODE REC(D.)
OVER 1/2" GWB @ INT. SIDE, MUD/TAPE, TEXTURE AND PAINT @
WARM INT. SIDE (OVER 5/8" TYPE X' 1-HR RATED GWB @
GARAGE INT. SIDE W/ HABITABLE SPACES ADJACENT)

B INTERIOR WALL CONSTRUCTION —

1/1" GWP EACH SIDE OVER 1×4 STUDS @ 16" O.C.

FINISH PER TYPE 'A' ABOVE

SIMILAR TO 'B' EXCEPT ADD ACQUISTIC BATT INSULATION FULL
HT. & WIDTH OF WALL, TYP. @ SOUND "PRIVACY" WALL LOCS.
6C. TO COORD. W/ CLIENT AS REQD., TYP. UNO.

INTERIOR WALL CONSTRUCTION —
PLIMBING WALL: 1/2" GWB EACH SIDE OVER 2x6 STUDS @ 16"
OC. W/ SOUND BATT INSUL FULL HT. / WIDTH OF WALL,

SIMILAR TO 'C' EXCEPT W/ R-2| BATT INSULATION MIN. (OR AS CODE REQ'D)

E = Rated 2 hour firewall (See Sheet A-5.5) G = Concrete Wall

GENERAL I.R.C. 2015 NOTES

MUD/TAPE, TEXTURE, PAINT

| POST ADDRESS SO AS TO BE LEGIBLE FROM STREET, WITH #S TO ADEQUATELY CONTRAST FROM ADJACENT BACKGROUND - IRC R319.1

- 2. 2. A FLOOR OR LANDING @ 7-3/4" MAX. BELOW THRESHOLD, IS REQUIRED FROM AN EXIT DOOR IRC R3||33.|
- 3. 3. FLASHING @ / OVER TOPS OF WINDOWS & @ / OVER TOPS OF TRIM, TYP. ALL LOCS. UNO.
- 4. VERIFY ALL DOWNSPOUT LOCATIONS BASED ON PARCEL/LOT, TIGHTLINES, AND THE LIKE, TYP.
- 5. GABLE END CONDITIONS: ALL PLYWOOD SHEAR PANELS MUST EXTEND CONTINUOUS FROM THE DIAPHRAGM UND. THIS REQUIREMENT MAY BE ELIMINATED IF THE SE & IN COORDINATION WITH THE TRUSS MANUFACTURER PROVIDES AN ADEQUATE SHEAR OR DRAG TRUSS IN SAID LOCATIONS. THE ARCHITECT/DESIGNER AND STRUCTURAL ENGINEER SHALL BE NOTIFICED OF SUCH A DECISION TO ALTER, AND BE PROVIDED WITH APPROPRIATE CALCULATIONS TO SUPPORT SAID DECISION, PRIOR TO THE START OF THE WORK, ORDERING OR INSTALLATION OF RELATED SYSTEMS, MATERIALS, AND THE LIKE. TYP. ALL LOCS. UND., GC. SHALL VERIFY PER PARCEL / LOT / BUILDING DESIGN IN COORDINATION WITH STRUCTURAL ENGINEERING RELATED AND PROVIDED PER PROJECT.
- . WHEN/WHERE A SHEAR WALL IS INDICATED ON THE DRAWINGS (ARCHITECTURAL OR STRUCTURAL) FOR ANY PORTION OF A WALL, THE REMAINDER OF THAT WALL ADJACENT SHALL BE, IN THE SAME PLANE, SMILARLY SHEATHED, FOR DIMENSIONAL CONTINUITY ACROSS THE ENTIRETY OF THE WALL PLANE FOR A UNIFORM FINISHING SURFACE, TYP. ALL LOCG. AS REQD.
- 7. INSTALLATIONS OF ALL ROOFING AND WALL FLASHINGS ARE TO BE PER INDUSTRY STANDARDS, CONSTRUCTION BEST PRACTICES, AND IN COMPLIANCE WITH 2015 IR.C. SECTIONS R705.75, R7038, R903.1, R905. DRIP EDGES REQUIRED PER R905.28.5
- 8. APPROVED CORROSION RESISTANT FLASHING SHALL BE INSTALLED AT ALL OF THE FOLLOWING LOCATIONS —
 A) AT THE TOP OF ALL EXTERIOR WINDOW AND DOOR OPENINGS, INSTALLED IN SUCH A MANNER AS TO BE WATERPROOF,
- WEATHERPROOF, AND LEAKPROOF. EXCEPT THAT IN SELF-FLASHING WINDOWS HAVING A CONTINUOUS LAP OF NOT LESS.

 THE SHEATHING MATERIAL AROUND THE PERIMETER OF THE OPENING, INCLUDING ALL CORNERS, THEN DO NOT REQUIRE SAID FLASHING.

 B) AT THE INTERSECTIONS OF CHIMINEYS OR OTHER MASONRY TYPE CONSTRUCTION WITH FRAME OR STUCCO WALLS, WITH PROJECTING LIPS ON BOTH SIDES UNDER STUCCO. COPINGS.

C) UNDER AND AT THE ENDS OF ALL MASONRY, WOOD, OR METAL STYLE COPINGS AND SILLS.

D) CONTINUOUS Y ABOVE ALL PROJECTING WOOD TRIM TYP THROUGHOUT

D) CONTINUOUSLY ABOVE ALL PROJECTING WOOD TRIM, TYP. THROUGHOUT


E) WHERE ANY EXTERIOR PORCHES, DECKS, OR STAIRS ATTACH TO A WALL OR FLOOR / FLOORLINE ASSEMBLY MADE OF WOOD CONSTRUCTION.

F) AT ANY/ALL WALL AND ROOF INTERSECTIONS.

6) AT ALL BUILT-IN GUTTERS, PER IRC SECTION R7038.

9. WHERE ANY ON SITE GRADE IS GREATER THAN 30" BELDW AN ADJACENT WALKWAY, LANDING, PATIO, AND/OR DECK, A CONTINUOUS RAILING / GUARDRAIL WITH A MIN. HEIGHT OF 36" ABOVE FINISHED WALKING SUFFACE. RAILING SHALL BE DESIGNED, PER IRC COMPLIANCE, SO THAT THE DESIGN WILL NOT ALLOW PASSAGE OF A 4" DIAMETER SPHERE BETWEEN RAILING PICKETS/MEMBERS. PROVIDE 34" MIN. HEIGHT (36" TYP.) GUARD AT THE OPEN SIDE OF ANY/ALL STAIRWAYS WITH A TOTAL RISE OF MORE THAN 30", PER R312.] A 4-3/6" SPHERE MAY NOT PASS THROUGH SAID GUARD IN THIS LOC. A 6" DIA. SPHERE MAY NOT PASS THORUGH ANY TRIANGULAR SHAPE IN RAILING / GUARD DESIGN CREATED BY / AT RISER, TREAD, AND BOTTOM OF RAIL OR GUARD LAYOUT.

10. EXTERIOR STAIRWAYS PER IRC R3|1.7 SHALL BE OF MIN. 36" CLEAR WIDTH. LANDINGS SHALL HAVE A 36" MIN. DIMENSION IN THE DIRECTION OF TRAVEL. RISERS TO BE MAX. 7-3/4" HEIGHT. TREADS TO BE 10" MIN. DEPTH. MAX. VARIATION OF SAID DIMENSIONS TO BE 36". TREADS W/SOLID RISERS ARE TO HAVE 3/" MIN. TO 1-1/4" MAX. NOSINGS, OR ||" MIN. DEPTH AT TREAD. 4" DIA. SPHERE SHALL NOT BE PASSABLE THROUGH OPEN RISERS ON STAIRWAYS RISING MORE THAN 30". HANDRAIL SHALL BE REQUIRED WHERE 4 OR MORE RISERS ARE PRESENT IN A RUN. HANDRAILS SHALL BE INSTALLED AT 34-36" CONTINUOUS HEIGHT ABOVE NOSINGS. HANDRAILS SHALL BE 1-1/4" TO 2" IN DIA. GRIP, CONTINUOUS FOR THE FILL LENGTH OF THE STAIR FLIGHT. RETURN RAILING ENDS TO WALL OR STAIR NEWELL POST. 6-8" CONTINUOUS CLEAR HEAD HEIGHT REQUIRED FOR FILL STAIR RUN. PROVIDE 34" MIN. HEIGHT GUARDS AT OPEN SIDE/S OF STAIRWAYS WITH TOTAL RISE OF 30" OR MORE, PER R3/2.1. 4-3/6" DIA. SPHERE SHALL NOT PASS THROUGH GUARDS. 6" DIA. SPHERE SHALL NOT PASS THROUGH ANY TRIANGULAR OPENING CREATED BY RISER, TREAD, AND BOTTOM RAIL OF SAID GUARD.

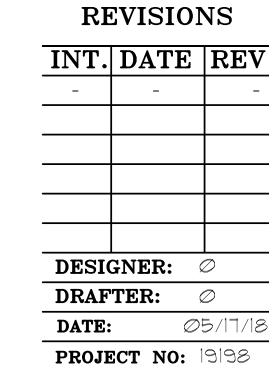

 Δ -2.1

SHEET NO:

Established Basic Permit # 19-03650

60cfm with a continuous

-WHOLE HOUSE FAN

MANUAL OVERRIDE \ runtime.

W/ AUTO TIMER &

B-O' HEAD

8'-0" HEAD /

4050 SLIDE-BY 8'-0" HEAD

MUST Be Approved Prior To Performing Work

5-3 |/2" 6-4 1/2"___ 3'-3 |/2"

instructions and specs shall be on site at time of inspection

20-0"

12640 FIXED SE 1 7-0 HEAD TEMP. GLASS PS

9-1" alb.

1450 FIXED 5.6. 3'-|| |/2" 2'-6" REFER SPACE <u>DINING</u>

9-1" alb. **\$'-9** 1/2" 3'-6" 3'-8 1/2" 5'-6" 1650 FIXED <u>DINING</u> 8-0' HEAD 9-1" al6.

> LOCATION
> DIMENSIONS •
> PONY WALLS H.S. 9-1" (J.G. <u>GREAT RM.</u>

9-1" alb.

(A5.5) 3-6 1/2" 1-5 1/2" 4-7 1/2" 2'-10 1/2" 4-3 1/2" | 2'-|0 |/2" | 2'-|0 |/2"

40-0"

FLOOR PLAN - 2ND FLR.

10-0"

MAIN FLOOR LEGEND SMAKE PETECTOR

5-0"

GENERAL PLAN NOTES

BASED ON DESIGN INTENT DOCUMENTS PROVIDED HEREIN, OWNER TO PROVIDE, VERIFY, OR OTHERWISE APPROVE ALL PRODUCT AND MATERIAL SELECTIONS PRIOR TO GC ORDER AND OR INSTALLATION OF ANY PRODUCTS / MATERIALS RELATED TO PROJECT.

. PROVIDE THERMAL AND SOUND BATT INSULATION AT ALL FLOORS, WALLS, RAFTERS, AND INTERIOR PARTITIONS UNLESS OTHERWISE NOTED. SEE THERMAL VALUES / TABLES IN GENERAL ARCHITECTURAL NOTES SHEET(S). INSULATION MAY NOT BE SHOWN FOR CLARITY.

3. DOORS AND WINDOWS SHOWN FOR DESIGN INTENT SIZE AND LOCATION ONLY. SEE SCHEDULES AND ELEVATIONS FOR COORDINATION.

4. UNLESS ØTHERWISE NØTED, ALL EXTERIØR STUDS ARE NØMINAL 2×6. ALL INTERIØR PLUMBING WALLS ARE NØMINAL 2X6. ALL ØTHER INTERIØR STUDS ARE NOMINAL 2x4. SEE BUILDING AND WALL SECTIONS FOR TYPICAL WALLTYPES AND SHEET A-4XX SERIES SHEETS FOR ADDITIONAL INFO.

5. UNLESS OTHERWISE NOTED, ALL DIMENSION LINES ARE ASSUMED TO BE FROM FACE OF STUD. C IS TO SHOW CENTERLINE DIMENSIONS.

6. SEE ADDL A-2XX & A-3XX SERIES FOR ALL DOOR AND WINDOW TYPES, DIMENSIONS. TRIM, HARDWARE AND ADDITIONAL RELATED INFO. MAY BE FOUND IN SCHEDULES WHEN/AS PROVIDED HEREIN.

7. 6C. AND OWNER TO COORD. FOR APPROVAL OF TYPICAL INTERIOR FINISHES NOT SPECIFICALLY STATED ON FLOOR PLANS OR IN OTHER SHEETS/DESIGN INFO. HEREIN.

8. ANYWHERE MIN. REQUIREMENTS ARE CALLED OUT ON DRAWINGS, REFER TO GENERAL NOTES, SPECIFICATIONS, AND APPLY ADHERENCE TO MOST RESTRICTIVE CODE AND/OR SPECIFICATION REFERENCE, AS WELL AS BEST INDUSTRY PRACTICES.

FLOOR PLAN NOTES

I) ALL HABITABLE SLEEPING ROOMS TO RECEIVE CLG. MOUNTED SMOKE DETECTORS, HARD WIRED W/ BATTERY BACKUPS.

2) ALL BATHROOMS, SHOWER ROOMS TO RECEIVE CLG. FANS (SEPARATE UNIT OR COMBO FAN/LIGHT TBD) — CODE REQD. CFM MIN. UN.O. — VENT

3) ALL PLIMBING AND ASSOCIATED WORK TO BE BIDDER DESIGN & COORDINATED WITH DESIGN INTENT AS SHOWN THROUGHOUT THESE DRAWINGS ALONG WITH RELATED GC. SUB PERMITTING & RELATED CODE COMPLIANCE

4) ALL ELECTRICAL AND ASSOCIATED WORK TO BE BIDDER DESIGN & COORDINATED WITH DESIGN INTENT AS SHOWN THROUGHOUT THESE DRAWINGS ALONG WITH RELATED GC. SUB PERMITTING & RELATED CODE COMPLIANCE

5) FACTORY-BUILT WOOD STOVE INSTALLATION TO COMPLY WITH MANUFACTURER'S REQUIREMENTS, AS WELL AS IRC. 1004:1-4. & WITH KITSAP | COUNTY BROCHURE #75 TITLED "WOODSTOVES AND FIREPLACES" & WITH 2006 NFPA 20||.

6) ALL INTERIOR DOORS ARE UNRATED SOLID CORE WOOD DOORS, UN.O. ELSEWHERE IN DOCS. HEREIN.

GENERAL WALL TYPES

EXTERIOR WALL CONSTRUCTION —
SIDING PER ELEVATIONS OVER AIR BARRIER HOUSE WRAP OVER 7/16" CDX PLYWOOD (ALT. OSB) SHEATHING (VERIFY W/ STRUCT. ENGINEERING &/OR PRESCRIPTIVE DESIGN) OVER 2x6 STUDS @ 16" OC. W/ BATT INSULATION (R-21 MIN. OR AS CODE REQD.) OVER 1/2" GWB @ INT. SIDE, MUD/TAPE, TEXTURE AND PAINT @ WARM INT. SIDE (OVER 5/8" TYPE X IHR RATED GWB @ GARAGE INT. SIDE W/ HABITABLE SPACES ADJACENT)

(B) INTERIOR WALL CONSTRUCTION -1/2" GWB EACH SIDE OVER 2x4 STUDS @ 16" O.C. FINISH PER TYPE 'A' ABOVE

(B) SIMILAR TO 'B' EXCEPT ADD ACQUSTIC BATT INSULATION FULL HT. & WIDTH OF WALL, TYP. @ SOUND "PRIVACY" WALL LOCS. 66. TO COORD. W/ CLIENT AS REQD., TYP. UNO.

INTERIOR WALL CONSTRUCTION -PLIMBING WALL: 1/2" GWB EACH SIDE OVER 2x6 STUDS @ 16" OC. W/ SOUND BATT INSUL FULL HT. / WIDTH OF WALL, MUD/TAPE, TEXTURE, PAINT

SIMILAR TO 'C' EXCEPT W/ R-2| BATT INSULATION MIN. (OR AS CODE REQD)

D GARAGE WALL CONSTRUCTION -

E NTERIOR TENANT / PARTY WALL CONSTRUCTION See sheet a-5.5

F STAIR RAILING / PARTIL HEIGHT WALL CONSTRUCTION -

6 CONCRETE WALL

GENERAL I.R.C. 2015 NOTES

POST ADDRESS SO AS TO BE LEGIBLE FROM STREET, WITH #S TO ADEQUATELY CONTRAST FROM ADJACENT BACKGROUND — IRC R319.1

2. 2. A FLOOR OR LANDING @ 7-3/4" MAX. BELOW THRESHOLD, IS REQUIRED FROM AN EXIT DOOR - IRC R3/153/1

3. 3. FLASHING @ / OVER TOPS OF WINDOWS & @ / OVER TOPS OF TRIM, TYP. ALL LOCS. UND.

4. VERIFY ALL DOWNSPOUT LOCATIONS BASED ON PARCEL/LOT, TIGHTLINES, AND THE LIKE, TYP.

GABLE END CONDITIONS: ALL PLYWOOD SHEAR PANELS MUST EXTEND CONTINUOUS FROM THE DIAPHRAGM UN.O. THIS REQUIREMENT MAY BE ELIMINATED IF THE SE & IN COORDINATION WITH THE TRUSS MANUFACTURER PROVIDES AN ADEQUATE SHEAR OR DRAG TRUSS IN SAID LOCATIONS. THE ARCHITECT/DESIGNER AND STRUCTURAL ENGINEER SHALL BE NOTIFICED OF SUCH A DECISION TO ALTER, AND BE PROVIDED WITH APPROPRIATE CALCULATIONS TO SUPPORT SAID DECISION, PRIOR TO THE START OF THE WORK, ORDERING OR INSTALLATION OF RELATED SYSTEMS, MATERIALS, AND THE LIKE. TYP. ALL LOCS. UN.O., GC. SHALL VERIFY PER PARCEL / LOT / BUILDING DESIGN IN COORDINATION WITH STRUCTURAL ENGINEERING RELATED AND PROVIDED PER PROJECT.

WHEN/MHERE A SHEAR WALL IS INDICATED ON THE DRAWINGS (ARCHITECTURAL OR STRUCTURAL) FOR ANY PORTION OF A WALL, THE REMAINDER OF THAT WALL ADJACENT SHALL BE, IN THE SAME PLANE, SIMILARLY SHEATHED, FOR DIMENSIONAL CONTINUITY ACROSS THE ENTIRETY OF THE WALL PLANE FOR A UNIFORM FINISHING SURFACE, TYP. ALL LOCG. AS REQD.

INSTALLATIONS OF ALL ROOFING AND WALL FLASHINGS ARE TO BE PER INDUSTRY STANDARDS, CONSTRUCTION BEST PRACTICES, AND IN COMPLIANCE WITH 2015 IRC. SECTIONS R705.75, R7038, R9031, R905. DRIP EDGES REQUIRED PER R9051.85

A) AT THE T*OP O*F ALL EXTERIOR WINDOW AND DOOR OPENINGS, INSTALLED IN SUCH A MANNER AS TO BE WATERPROOF, WEATHERPROOF, AND LEAKPROOF. EXCEPT THAT IN SELF-FLASHING WINDOWS HAVING A CONTINUOUS LAP OF NOT LESS THE SHEATHING MATERIAL AROUND THE PERIMETER OF THE OPENING, INCLUDING ALL CORNERS, THEN DO NOT REQUIRE SAID FLASHING. B) AT THE INTERSECTIONS OF CHIMNEYS OR OTHER MASONRY TYPE CONSTRUCTION WITH FRAME OR STUCCO WALLS, PRAJECTING LIPS ON BOTH SIDES UNDER STUCCO COPINGS.

c) under and at the ends of all masonry, wood, or metal style copings and sills. D) CONTINUOUSLY ABOVE ALL PROJECTING WOOD TRIM, TYP. THROUGHOUT

8. APPROVED CORROSION RESISTANT FLASHING SHALL BE INSTALLED AT ALL OF THE FOLLOWING LOCATIONS -

E) WHERE ANY EXTERIOR PORCHES, DECKS, OR STAIRS ATTACH TO A WALL OR FLOOR / FLOORLINE ASSEMBLY MADE *o*f w*ood* CONSTRUCTION.

F) AT ANY/ALL WALL AND ROOF INTERSECTIONS. 6) AT ALL BUILT-IN GUTTERS, PER IRC SECTION R7038.

WHERE ANY ON SITE GRADE IS GREATER THAN 30" BELOW AN ADJACENT WALKWAY, LANDING, PATIO, AND/OR DECK, A CONTINUOUS RAILING / GUARDRAIL WITH A MIN. HEIGHT OF 36" ABOVE FINISHED WALKING SURFACE. RAILING SHALL BE DESIGNED, PER IRC COMPLIANCE, SO THAT THE DESIGN WILL NOT ALLOW PASSAGE OF A 4" DIAMETER SPHERE BETWEEN RAILING PICKETS/MEMBERS. PROVIDE 34" MIN. HEIGHT (36" TYP.) GUARD AT THE OPEN SIDE OF ANY/ALL STAIRWAYS WITH A TOTAL RISE OF MORE THAN 30", PER R312. A 4-3/8" SPHERE MAY NOT PASS THROUGH SAID GUARD IN THIS LOC. A 6" DIA. SPHERE MAY NOT PAGS THORUGH ANY TRIANGULAR SHAPE IN RAILING / GUARD DESIGN CREATED BY / AT RISER, TREAD, AND BOTTOM OF RAIL OR GUARD LAYOUT.

10. EXTERIOR STAIRWAYS PER IRC R3/1.7 SHALL BE OF MIN. 36" CLEAR WIDTH. LANDINGS SHALL HAVE A 36" MIN. DIMENSION IN THE DIRECTION OF TRAVEL. RISERS TO BE MAX. 7-3/4" HEIGHT. TREADS TO BE 10" MIN. DEPTH. MAX. VARIATION OF SAID DIMENSIONS TO BE 36". TREADS W/ SOLID RISERS ARE TO HAVE 3/1" MIN. TO 1-1/4" MAX. NOSINGS, OR 11" MIN. DEPTH AT TREAD. 4" DIA. SPHERE SHALL NOT BE PASSABLE THROUGH OPEN RISERS ON STAIRWAYS RISING MORE THAN 30". HANDRAIL SHALL BE REQUIRED WHERE 4 OR MORE RISERS ARE PRESENT IN A RUN. HANDRAILS SHALL BE INSTALLED AT 34-36" CONTINUOUS HEIGHT ABOVE NOSINGS. HANDRAILS SHALL BE 1-1/4" TO 2" IN DIA GRIP, CONTINUOUS FOR THE FULL LENGTH OF THE STAIR FLIGHT. RETURN RAILING ENDS TO WALL OR STAIR NEWELL POST. 6-8" CONTINUOUS CLEAR HEAD HEIGHT REQUIRED FOR FULL STAIR RUN. PROVIDE 34" MIN. HEIGHT GUARDS AT OPEN SIDE/S OF STAIRWAYS WITH TOTAL RISE OF 30" OR MORE, PER R3/2.1. 4-3/8" DIA. SPHERE SHALL NOT PASS THROUGH GUARDS. 6" DIA. SPHERE SHALL NOT PASS THROUGH ANY TRIANGULAR OPENING CREATED BY RISER, TREAD, AND BOTTOM RAIL OF SAID GUARD.

DUPLEX FLOOR PL SECOND FLOOR

REVISIONS

INT. DATE REV **DESIGNER:** \emptyset DRAFTER: DATE: Ø5/17/18 PROJECT NO: 19198

SHEET NO:

Established Basic Permit # 19-03650

 $\langle A \rangle$

2'-7"

4'-3 |/2"

|4'**-4**"

Subject To Field Inspection

THE WHOLE-HOUSE VENTILATION SYSTEM SHALL CONSIST OF ONE OR MORE SUPPLY OR EXHAUST FANS, OR A COMBINATION OF SUCH. SYSTEM SHALL BE PROVIDED WITH CONTROLS THAT ENABLE MANUAL OVERRIDE. PROVIDE OUTDOOR AIR AT A CONTINUOUS RATE OF NOT LESS THAN THAT DETERMINED IN ACCORDANCE WITH TABLE MISØ1.3.3(1)

EXCEPTION: THE WHOLE-HOUSE MECHANICAL VENTILATION SYSTEM IS PERMITTED TO OPERATE INTERMITTENTLY WHERE THE SYSTEM HAS CONTROLS THAT ENABLE OPERATION FOR NOT LESS THAN 25-PERCENT OF EACH 4-HOUR SEGMENT AND THE VENTILATION RATE PRESCRIBED IN TABLE MISOT.3.3(1) IS MULTIPLIED BY THE FACTOR DETERMINED IN ACCORDANCE WITH TABLE MISOT.3.3(2)

VENTILATION RATE FOR WHOLE HOUSE FAN
TO BE 60 AIRFLOW IN CFM PER TABLE M507.3.3 (1)
HVAC CONTRACTOR TO SPECIFY LOCATION.

Smoke & carbon monoxide detectors required.

Smoke and carbon monoxide detectors must be

TABLE RISOT.3.3(1) CONINUOUS WHOLE-HOUSE MECHANICAL VENTILATION SYSTEM AIRFLOW RAT REQUIREMENTS

<u>/</u>	11 4 = 2 20 1	(/ (.,	<u>_</u>			
DWELLING UNIT	NUMBER OF BEDROOMS						
FLOOR AREA	Ø-1	2-3	4-5	6-7	7		
(SQUARE FEET)							
J,500	3Ø	45	60	75	90		
1,501-3,000	45	(60)	75	90	1Ø5		
3,001-4,500	60	75	90	105	120		
4,501-6,000	75	90	105	120	135		
6,001-7,500	90	105	120	135	150		

1005 | 120 | 135 | 150 | 165

INTERMITTENT WHOLE-	HOUSE M	ECHANIC.	AL VENT	ILATION F	RATE FAC	ITORS ^{ald}
TABLE M1507.3.3(2)						
RUN-TIME PERCENTAGE IN EACH 4-HOUR SEGMENT	25%	33%	50%	66%	75%	100%
FACTOR	4	3	2	1.5	1.3	(1.0)

a. FOR VENTILATION SYSTEM RUN TIME VALUES BETWEEN THOSEE GIVEN, THE FACTORS ARE PERMITTED TO BE DETERMINED BY INTERPOLATION.
 b. EXTRAPOLATION BEYOND THE TABLE IS PROHIBITED.

Manufacturer's installation
instructions and specs shall be on
site at time of inspection

MAD CONTRACTOR TO SPECIFY LOCATION.

Manufacturer's installation
instructions and specs shall be on
gshapiro 08/05/2020

site at time of inspection *10-0*" *10-0*" **BASIC PERMIT PACKAGE** 10-6" 10-10" 9-2" 9-6" REVIEWED FOR CODE COMPLIANCE **WITH IRC 2015** 4-9 1/2" 4-8 1/2" 4-7 1/2" 5'-4" 5'-6" KITSAP COUNTY BUILDING DEPARTMENT

installed throughout the building in all locations required by the IRC as amended by WAC. S 2'-2 1/2 1640 FIXED S.G. 2 7-0" HEAD **18'-1"** (1.6. 8'-1" (LG. 1640 FIXED S.G. 1-0" HEAD 3'-7 1/2" 7-0 1/2" 4'--|" / AUTO TIMER & 1040 FIXED 56. ATTICE *7-0*" HEAD ∧ KCESS 1640 FIXED 5.6. 7-0" HEAD (B) 22X30 MIN OPTION ADDENDUM ||Still#/& POLE<P FOR LAUNDRY ROOM SHE & HOLE//I BY 当 22X20 M 3050 SH. 7-0" HEAD 5'-8 |/2" **4**'-| |/2" EGRESS/ CARPET 8'-1" (L.G. CARPET 8'-1" CLG. 3'-4" 7-0" HEAD 5'-| |/2" 5-9" SEE WALL PLAN FOR POST LOCATION DIMENSIANS @ PANY WALLS (TYPICAL) MSTR. SUITE 8'-1" CL 8'-1" (L.G. (A5.5) A5.5 2'-6 1/2" 2'-10" 3'-6 1/2" 1-5 1/2 2'-7" 3'-|" 7-2" 15'-0" 14'-4"

40-0"

FLOOR PLAN - 3RD FLR.

2*0-0*"

MAIN FLOOR LEGEND

STATE SHARE PETECTOR

COMPO SHARE & CARDON MONORDE DETECTOR

OF THIS CHIN (00) FER SPECS

XX CHIN WIT - "WHILE HOUSE FAN"

HOT HOSE DED

DOWN SPOLIT, TIGHTILINE TO STORM

ECT NORTH

20-0"

GENERAL PLAN NOTES

I. BASED ON DESIGN INTENT DOCUMENTS PROVIDED HEREIN, OWNER TO PROVIDE, VERIFY, OR OTHERWISE APPROVE ALL PRODUCT AND MATERIAL SELECTIONS PRIOR TO GC ORDER AND OR INSTALLATION OF ANY PRODUCTS / MATERIALS RELATED TO PROJECT.

2. PROVIDE THERMAL AND SOUND BATT INSULATION AT ALL FLOORS, WALLS, RAFTERS, AND INTERIOR PARTITIONS UNLESS OTHERWISE NOTED. SEE THERMAL VALUES / TABLES IN GENERAL ARCHITECTURAL NOTES SHEET(S). INSULATION MAY NOT BE SHOWN FOR CLARITY.

3. DOORS AND WINDOWS SHOWN FOR DESIGN INTENT SIZE AND LOCATION ONLY. SEE SCHEDULES AND ELEVATIONS FOR COORDINATION.

4. UNLESS OTHERWISE NOTED, ALL EXTERIOR STUDS ARE NOMINAL 2x6. ALL INTERIOR PLUMBING WALLS ARE NOMINAL 2X6. ALL OTHER INTERIOR STUDS ARE NOMINAL 2x4. SEE BULDING AND WALL SECTIONS FOR TYPICAL WALLTYPES AND SHEET A-4XX SERIES SHEETS FOR ADDITIONAL INFO.

5. UNLESS OTHERWISE NOTED, ALL DIMENSION LINES ARE ASSUMED TO BE FROM FACE OF STUD. C IS TO SHOW CENTERLINE DIMENSIONS.

6. SEE ADD'L. A-2XX & A-3XX SERIES FOR ALL DOOR AND WINDOW TYPES, DIMENSIONS. TRIM, HARDWARE AND ADDITIONAL RELATED INFO. MAY BE FOUND IN SCHEDULES WHEN/AS PROVIDED HEREIN.

7. 6C. AND OWNER TO COORD. FOR APPROVAL OF TYPICAL INTERIOR FINISHES NOT SPECIFICALLY STATED ON FLOOR PLANS OR IN OTHER SHEETS/DESIGN INFO. HEREIN.

8. ANYWHERE MIN. REQUIREMENTS ARE CALLED OUT ON DRAWINGS, REFER TO GENERAL NOTES, SPECIFICATIONS, AND APPLY ADHERENCE TO MOST RESTRICTIVE CODE AND/OR SPECIFICATION REFERENCE, AS WELL AS BEST INDUSTRY PRACTICES.

FLOOR PLAN NOTES

I) ALL HABITABLE SLEEPING ROOMS TO RECEIVE CLG. MOUNTED SMOKE DETECTORS, HARD WIRED W/ BATTERY BACKUPS.

2) ALL BATHROOMS, SHOWER ROOMS TO RECEIVE CLG. FANS (SEPARATE UNIT OR COMBO FAN/LIGHT TBD) — CODE REQD. CFM MIN. U.N.O. — VENT TO EXTERIOR, TYP.

, 3) ALL PLUMBING AND ASSOCIATED WORK TO BE BIDDER DESIGN & COORDINATED WITH DESIGN INTENT AS SHOWN THROUGHOUT THESE DRAWINGS ALONG WITH RELATED G.C. SUID PERMITTING & RELATED CODE COMPLIANCE.

4) ALL ELECTRICAL AND ASSOCIATED WORK TO BE PIDDER DESIGN & COORDINATED WITH DESIGN INTENT AS SHOWN THROUGHOUT THESE DRAWINGS ALONG WITH RELATED GC. SUB PERMITTING & RELATED CODE COMPLIANCE.

5) FACTORY-BUILT WOOD STOVE INSTALLATION TO COMPLY WITH MANUFACTURER'S REQUIREMENTS, AS WELL AS IRC. 1004.1—4. & WITH KITSAP COUNTY BROCHURE #15 TITLED "WOODSTOVES AND FIREPLACES" & WITH 2006 NFPA. 2011.

6) ALL INTERIOR DOORS ARE UNRATED SOLID CORE WOOD DOORS, UNO. ELSEWHERE IN DOCS. HEREIN.

GENERAL WALL TYPES

EXTERIOR WALL CONSTRUCTION —
SIDING PER ELEVATIONS OVER AIR BARRIER HOUSE WRAP OVER
1/16" CDX PLYWOOD (ALT. OSB) SHEATHING (VERIFY W/ STRUCT.
ENGINEERING &/OR PRESCRIPTIVE DESIGN) OVER 2x6 STUDS @
16" O.C. W/ BATT INSULATION (R-2| MIN. OR AS CODE REQD.)
OVER 1/1" GWB @ INT. SIDE, MUD/TAPE, TEXTURE AND PAINT @
WARM INT. SIDE (OVER 5/8" TYPE X 1 HIR RATED GWB @
GARAGE INT. SIDE W/ HABITABLE SPACES ADJACENT)

(P) INTERIOR WALL CONSTRUCTION —

1/1" GMP EACH SIDE OVER 1×4 STUPS @ 16" O.C.

FINISH PER TYPE 'A' ABOVE

SIMILAR TO "B" EXCEPT ADD ACQUSTIC BATT INSULATION FULL HT. & WIDTH OF WALL, TYP. @ SOUND "PRIVACY" WALL LOCS. 66. TO COORD. W/ CLIENT AS REQD., TYP. UND.

INTERIOR WALL CONSTRUCTION —
PLUMBING WALL: |/2" GWB EACH SIDE OVER 2x6 STUDS @ 16"
OC. W/ SOUND BATT INSUL FULL HT. / WIDTH OF WALL,
MUD/TAPE, TEXTURE, PAINT

SIMILAR TO 'C' EXCEPT W/ R-2| BATT INSULATION MIN. (OR AS CODE REQD)

D GARAGE WALL CONSTRUCTION -

NTERIOR TENANT / PARTY WALL CONSTRUCTION See sheet a-5.5

F STAIR RAILING / PARTIL HEIGHT WALL CONSTRUCTION -

6 CONCRETE WALL

GENERAL I.R.C. 2015 NOTES

I. POST ADDRESS SO AS TO BE LEGIBLE FROM STREET, WITH #S TO ADEQUATELY CONTRAST FROM ADJACENT BACKGROUND - IRC R319.1

2. 2. A FLOOR OR LANDING @ 7-3/4" MAX. BELOW THRESHOLD, IS REQUIRED FROM AN EXIT DOOR - IRC R3||3:3.|

3. 3. FLASHING @ / OVER TOPS OF WINDOWS & @ / OVER TOPS OF TRIM, TYP. ALL LOCS. UND.

4. VERIFY ALL DOWNSPOUT LOCATIONS BASED ON PARCEL/LOT, TIGHTLINES, AND THE LIKE, TYP.

5. GABLE END CONDITIONS: ALL PLYWOOD SHEAR PANELS MUST EXTEND CONTINUOUS FROM THE DIAPHRAEM UND. THIS REQUIREMENT MAY BE ELIMINATED IF THE SE & IN COORDINATION WITH THE TRUSS MANUFACTURER PROVIDES AN ADEQUATE SHEAR OR DRAG TRUSS IN SAID LOCATIONS. THE ARCHITECT/DESIGNER AND STRUCTURAL ENGINEER SHALL BE NOTIFICED OF SUCH A DECISION TO ALTER, AND BE PROVIDED WITH APPROPRIATE CALCULATIONS TO SUPPORT SAID DECISION, PRIOR TO THE START OF THE WORK, ORDERING OR INSTALLATION OF RELATED SYSTEMS, MATERIALS, AND THE LIKE. TYP. ALL LOCS. UND., GC. SHALL VERIFY PER PARCEL / LOT / BUILDING DESIGN IN COORDINATION WITH STRUCTURAL ENGINEERING RELATED AND PROVIDED PER PROJECT.

6. WHEN/WHERE A SHEAR WALL IS INDICATED ON THE DRAWINGS (ARCHITECTURAL OR STRUCTURAL) FOR ANY PORTION OF A WALL, THE REMAINDER OF THAT WALL ADJACENT SHALL BE, IN THE SAME PLANE, SIMILARLY SHEATHED, FOR DIMENSIONAL CONTINUITY ACROSS THE ENTIRETY OF THE WALL PLANE FOR A UNIFORM FINISHING SURFACE, TYP. ALL LOCG. AS REQD.

7. INSTALLATIONS OF ALL ROOFING AND WALL FLASHINGS ARE TO BE PER INDUSTRY STANDARDS, CONSTRUCTION BEST PRACTICES, AND IN COMPLIANCE WITH 2015 IR.C. SECTIONS R705.75, R7038, R9031, R905. DRIP EDGES REQUIRED PER R9051.85

8. APPROVED CORROSION RESISTANT FLASHING SHALL BE INSTALLED AT ALL OF THE FOLLOWING LOCATIONS -

A) AT THE TOP OF ALL EXTERIOR WINDOW AND DOOR OPENINGS, INSTALLED IN SUCH A MANNER AS TO BE WATERPROOF, WEATHERPROOF, AND LEAKPROOF. EXCEPT THAT IN SELF-FLASHING WINDOWS HAVING A CONTINUOUS LAP OF NOT LESS.

THE SHEATHING MATERIAL AROUND THE PERIMETER OF THE OPENING, INCLUDING ALL CORNERS, THEN DO NOT REQUIRE SAID FLASHING.

B) AT THE INTERSECTIONS OF CHIMNEYS OR OTHER MASONRY TYPE CONSTRUCTION WITH FRAME OR STUCCO WALLS, WITH PROJECTING LIPS ON BOTH SIDES UNDER STUCCO COPINGS.

C) UNDER AND AT THE ENDS OF ALL MASONRY, WOOD, OR METAL STYLE COPINGS AND SILLS.

D) CONTINUOUSLY ABOVE ALL PROJECTING WOOD TRIM, TYP. THROUGHOUT

E) WHERE ANY EXTERIOR PORCHES, DECKS, OR STAIRS ATTACH TO A WALL OR FLOOR / FLOORLINE ASSEMBLY MADE OF WOOD CONSTRUCTION.

F) AT ANY/ALL WALL AND ROOF INTERSECTIONS.

6) AT ALL BUILT-IN GUTTERS, PER IRC SECTION R7038.

9. WHERE ANY ON SITE GRADE IS GREATER THAN 30" BELOW AN ADJACENT WALKWAY, LANDING, PATIO, AND/OR DECK, A CONTINUOUS RALING / GUARDRAIL WITH A MIN. HEIGHT OF 36" ABOVE FINISHED WALKING SURFACE. RAILING SHALL BE DESIGNED, PER IRC COMPLIANCE, SO THAT THE DESIGN WILL NOT ALLOW PASSAGE OF A 4" DIAMETER SPHERE BETWEEN RAILING PICKETS/MEMBERS. PROVIDE 34" MIN. HEIGHT (36" TYP.) GUARD AT THE OPEN SIDE OF ANY/ALL STAIRWAYS WITH A TOTAL RISE OF MORE THAN 30", PER R312.] A 4-3/6" SPHERE MAY NOT PASS THROUGH SAID GUARD IN THIS LOC. A 6" DIA SPHERE MAY NOT PASS THORUGH ANY TRIANGULAR SHAPE IN RAILING / GUARD DESIGN CREATED BY / AT RISER, TREAD, AND BOTTOM OF RAIL OR GUARD LAYOUT.

D. EXTERIOR STAIRWAYS PER IRC R9|1.7 SHALL BE OF MIN. 36" CLEAR WIDTH. LANDINGS SHALL HAVE A 36" MIN. DIMENSION IN THE DIRECTION OF TRAVEL. RISERS TO BE MAX. 7-3/4" HEIGHT. TREADS TO BE 10" MIN. DEPTH. MAX. VARIATION OF SAID DIMENSIONS TO BE 36". TREADS W/SOLID RISERS ARE TO HAVE 36" MIN. TO 1-1/4" MAX. NOSINGS, OR II" MIN. DEPTH AT TREAD. 4" DIA. SPHERE SHALL NOT BE PASSABLE THROUGH OPEN RISERS ON STAIRWAYS RISING MORE THAN 30". HANDRAIL SHALL BE REQUIRED WHERE 4 OR MORE RISERS ARE PRESENT IN A RUN. HANDRAILS SHALL BE INSTALLED AT 34-36" CONTINUOUS HEIGHT ABOVE NOSINGS. HANDRAILS SHALL BE 1-1/4" TO 1" IN DIA. GRIP, CONTINUOUS FOR THE FULL LENGTH OF THE STAIR FLIGHT. RETURN RAILING ENDS TO WALL OR STAIR NEWELL POST. 6'-8" CONTINUOUS CLEAR HEAD HEIGHT REQUIRED FOR FULL STAIR RUN. PROVIDE 34" MIN. HEIGHT GUARDS AT OPEN SIDE/S OF STAIRWAYS WITH TOTAL RISE OF 30" OR MORE, PER R3/2. 4-3/6" DIA. SPHERE SHALL NOT PASS THROUGH ANY TRIANGULAR OPENING CREATED BY RISER, TREAD, AND BOTTOM RAIL OF SAID GUARD.

H H H

REVISIONS


INT. DATE REV

- - -
DESIGNER:
DRAFTER:
DATE:
DATE:
DESIGNER:
DATE:
DESIGNER:
DATE:
DESIGNER:
DATE:
DESIGNER:
DESIGNER

A-2.3

SHEET NO:

Established Basic Permit # 19-03650

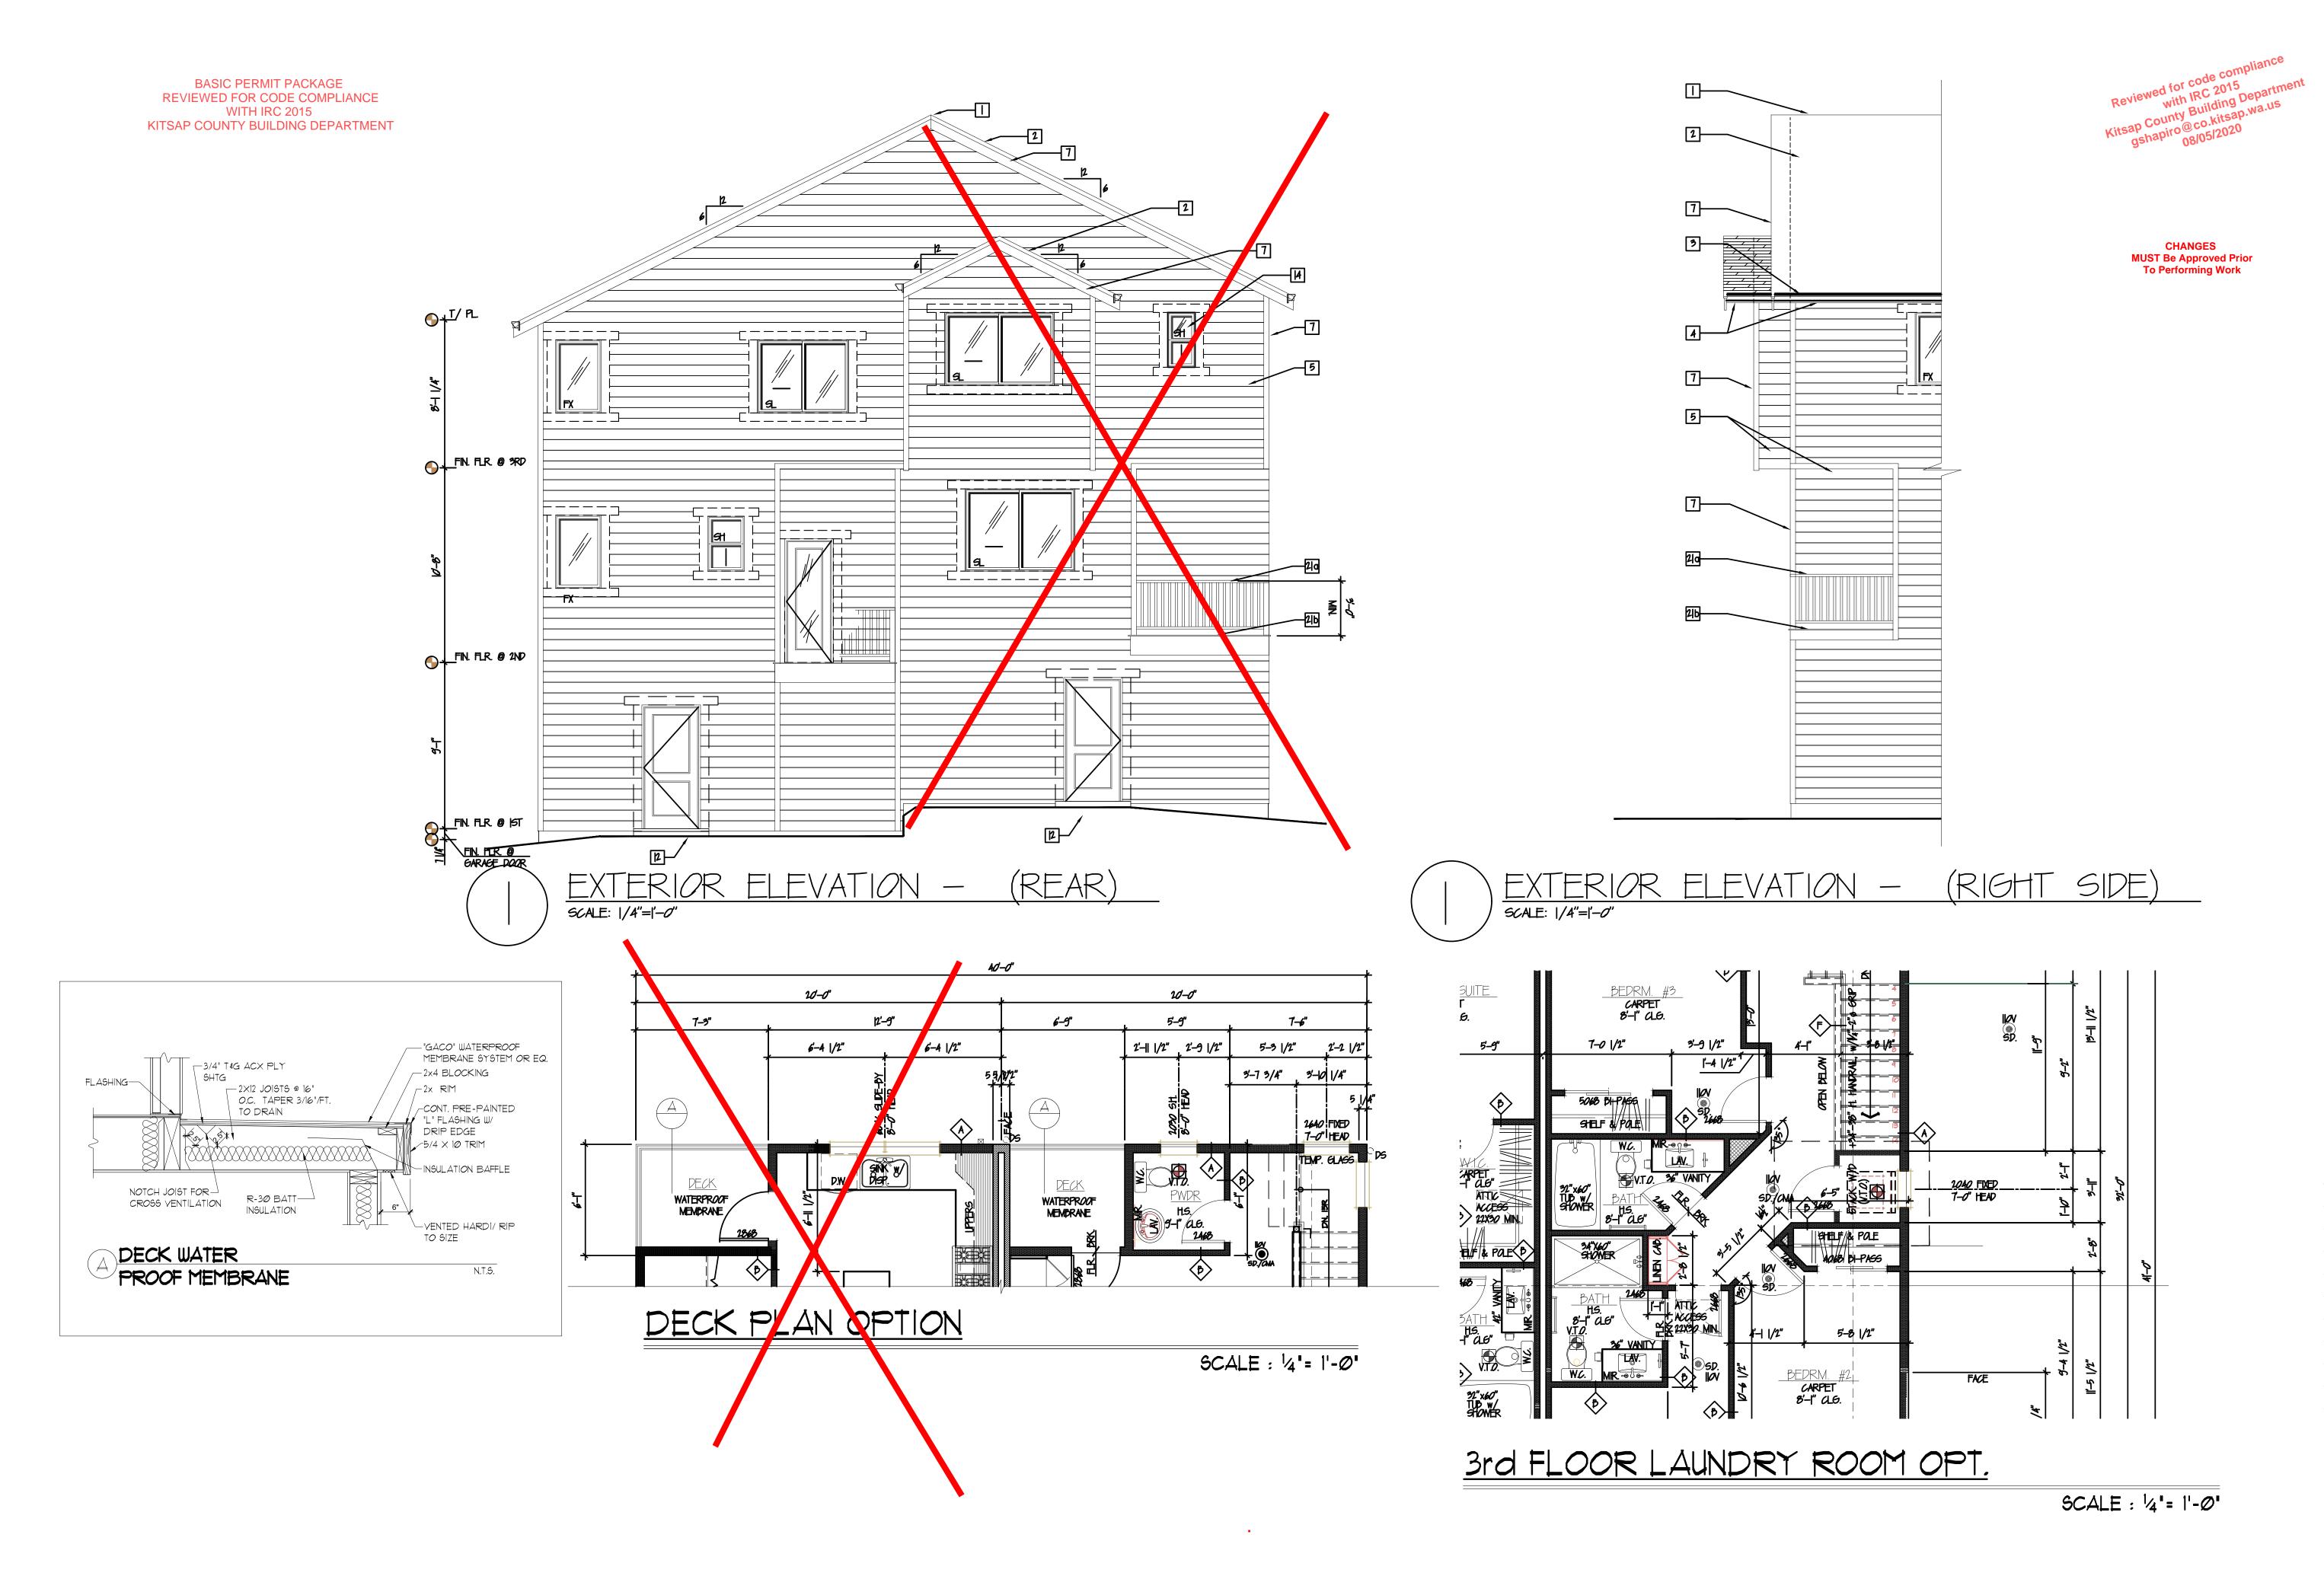

TOORPLANFLOORPLANOOR-DECK
OOR-DECK

10829 NE 68TH ST SUITE B

KIRKLAND, WA 98033

PHONE: 206 624 1888

REVISIONS

Which is the property of the proper

INT. DATE REV

- - -
DESIGNER:
DRAFTER:
DATE:
DATE:
DESIGNER:
PROJECT NO: 19198

SHEET NO:

A-2.3.1

ROOF PLAN NOTES

I) FLASH, CAULK & SEAL, AND GENERALLY WATER PROOF ALL ROOF PENETRATIONS PER MOST STRINGENT STANDARDS OF CODE, INDUSTRY STDS., AND/OR INSTRUCTIONS FROM ROOFING AND FLASHING MANUFACTURER.

2) CONCEAL ALL FLASHINGS AND SEALANT TO THE EXTENT APPLICABLE AND POSSIBLE PER INDUSTRY STANDARDS, IN CONSIDERATION OF FIELD CONDITIONS AND AS IT APPLIES TO STANDARD CONSTRUCTION PRACTICES FOR WATERPROOFING OF STRUCTURE(S) PER THE DRAWINGS HEREIN.

3. PROVIDE METAL FLASHINGS TO MATCH ROOF SYSTEM IN FINISH AT ALL RIDGES, VALLEYS, EAVES, CHIMNEYS, DRIP EDGES, SIDE WALLS, ETC.

4. REFER TO FLOOR PLANS, ELEVATIONS, AND BUILDING SECTIONS FOR ADDITIONAL DIMENSIONS AND RELATED COORDINATION CONDITIONS.

5. ANYWHERE MINIMUM REQUIREMENTS ARE CALLED OUT ON DRAWINGS REFER TO GENERAL NOTES AND SPECIFICATIONS FOR ADHERENCE TO MOST RESTRICTIVE SPECIFICATION REFERENCE.

ROOF VENT/ATTIC CALCULATIONS

| SQ. FT. OF ATTIC VENTILATION IS REQUIRED FOR EVERY |50 SQ. FT. OF ATTIC AREA. TOTAL BLDG FLOOR AREA = |,556 SQ. FT. /150 = |0.4 SQ. FT.

THEREFORE, 10.4 SQ. FT. OF ATTIC VENTILATION SHALL BE PROVIDED, WITH 50% OF REQUIRED VENTILATION TO BE PROVIDED BY ROOF VENTS LOCATED IN THE ROOF (AT LEAST 3' ABOVE EAVE VENTS) AND THE BALANCE PROVIDED BY EAVE VENTS.

PROJECT VENTING CALCULATIONS

MAIN FLOOR: |,704 SF. x |/|50 = ||.36 SF. REQUIRED|

GAPLE END VENTS: N/A PER HAND FRAMING @ ROOF RIDGE

CONT. RIDGE VENT: 465 LF. TOTAL

18 SQ. IN./LF. x 465 LF. = 837 SQ. IN. 837/144 = 58 SF. NET FREE AREA TOTAL (BASED ON GAF COBRA RIDGE VENT @

18 SQ. IN./L.F. OF NET FREE AREA) EAVE VENTS:

32+34=76 LF. TOTAL 215" SCREENED EAVE BLOCKS @ 034 SF.

NET FREE AREA EA. (35" x215" STAMPED BLOCKS) 225/12 = 1875 LF. PER BLOCK

76/1875 = 40 PLOCKS $40 \times 0.34 = |36 \text{ SF. NET FREE AREA TOTAL}$

RIDGE VENTS = 58 SF.

EAVE VENTS = 136 SF. TOTAL VENTING = 194 SF. > 104 SF. REQUIRED = MEETS CODE

* NOTE: 66. SHALL MODIFY ROOF VENTING WITH ADDITION FIXTURES AS REQUIRED TO MEET 50% AT MIN. 3' ABOVE THE EAVE, TYP.)

ROOF PLAN LEGEND

DS = DOWNSPOUT

ROUTED TO AND TIED INTO NEW DOWNSPOUT TIGHTLINE DRAIN FOR POSITIVE DRAINAGE AWAY FROM BUILDING AND

ALTERNATE WHERE REQUIRED-ROUTED TO SPLASH BLOCKS CLR. 5' LF. FROM FACE OF CONC FTG./STEMWALLS, TYP. ALL LOCATIONS.

REVISIONS

INT. DATE REV DESIGNER: DRAFTER: Ø5/17/18

DATE:

PROJECT NO: 19198

SHEET NO:

ROOF PLAN NOTES

I) FLASH, CAULK & SEAL, AND GENERALLY WATER PROOF ALL ROOF PENETRATIONS PER MOST STRINGENT STANDARDS OF CODE, INDUSTRY STDS., AND/OR INSTRUCTIONS FROM ROOFING AND FLASHING MANUFACTURER.

2) CONCEAL ALL FLASHINGS AND SEALANT TO THE EXTENT APPLICABLE AND POSSIBLE PER INDUSTRY STANDARDS, IN CONSIDERATION OF FIELD CONDITIONS AND AS IT APPLIES TO STANDARD CONSTRUCTION PRACTICES FOR WATERPROOFING OF STRUCTURE(S) PER THE DRAWINGS HEREIN.

3. PROVIDE METAL FLASHINGS TO MATCH ROOF SYSTEM IN FINISH AT ALL RIDGES, VALLEYS, EAVES, CHIMNEYS, DRIP EDGES, SIDE WALLS, ETC.

4. REFER TO FLOOR PLANS, ELEVATIONS, AND BUILDING SECTIONS FOR ADDITIONAL DIMENSIONS AND RELATED COORDINATION CONDITIONS.

5. ANYWHERE MINIMUM REQUIREMENTS ARE CALLED OUT ON DRAWINGS REFER TO GENERAL NOTES AND SPECIFICATIONS FOR ADHERENCE TO MOST RESTRICTIVE SPECIFICATION REFERENCE.

ROOF VENT/ATTIC CALCULATIONS

| SQ. FT. OF ATTIC VENTILATION IS REQUIRED FOR EVERY 150 SQ. FT. OF ATTIC AREA.

TOTAL BLDG FLOOR AREA = 1,556 SQ. FT. /150 = 10.4 SQ. FT.

THEREFORE, 10.4 SQ. FT. OF ATTIC VENTILATION SHALL BE PROVIDED, WITH 50% OF REQUIRED VENTILATION TO BE PROVIDED BY ROOF VENTS LOCATED IN THE ROOF (AT LEAST 3' ABOVE EAVE VENTS) AND THE BALANCE PROVIDED BY EAVE VENTS.

PROJECT VENTING CALCULATIONS

MAIN FLOOR: |,704 SF. x |/|50 = ||.36 SF. REQUIRED|

GABLE END VENTS: N/A PER HAND FRAMING @ ROOF RIDGE

CONT. RIDGE VENT: 465 LF. TOTAL

18 SQ. IN./LF. x 465 LF. = 897 SQ. IN. 897/144 = 58 SF. NET FREE AREA TOTAL (BASED ON GAF COBRA RIDGE VENT @ IB SQ. IN./L.F. OF NET FREE AREA)

92+34=76 LF. TOTAL 125" SCREENED EAVE BLOCKS @ 0.34 SF. NET FREE AREA EA. (35"x225" STAMPED BLOCKS) 22.5/12 = 1875 LF. PER \$LOCK76/1875 = 40 BLOCKS

RIDGE VENTS = 58 SF. EAVE VENTS = |36 SF.

TOTAL VENTING = 19.4 SF. > 10.4 SF. REQUIRED = MEETS CODE

* NOTE: 66. SHALL MODIFY ROOF VENTING WITH ADDITION FIXTURES AS REQUIRED TO MEET 50% AT MIN. 3' ABOVE THE EAVE, TYP.)

 $40 \times 0.34 = |36 \text{ SF. NET FREE AREA TOTAL}$

ROOF PLAN LEGEND


DS = DOWNSPOUT

ALL LOCATIONS.


ROUTED TO AND TIED INTO NEW DOWNSPOUT TIGHTLINE DRAIN FOR POSITIVE DRAINAGE AWAY FROM BUILDING AND


ALTERNATE WHERE REQUIRED-ROUTED TO SPLASH SLOCKING CLR. 5' LF. FROM FACE OF CONC FTG./STEMWALLS, TYP.

REVISIONS

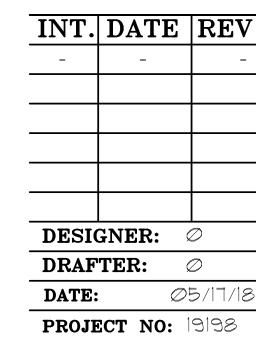

SHEET NO:

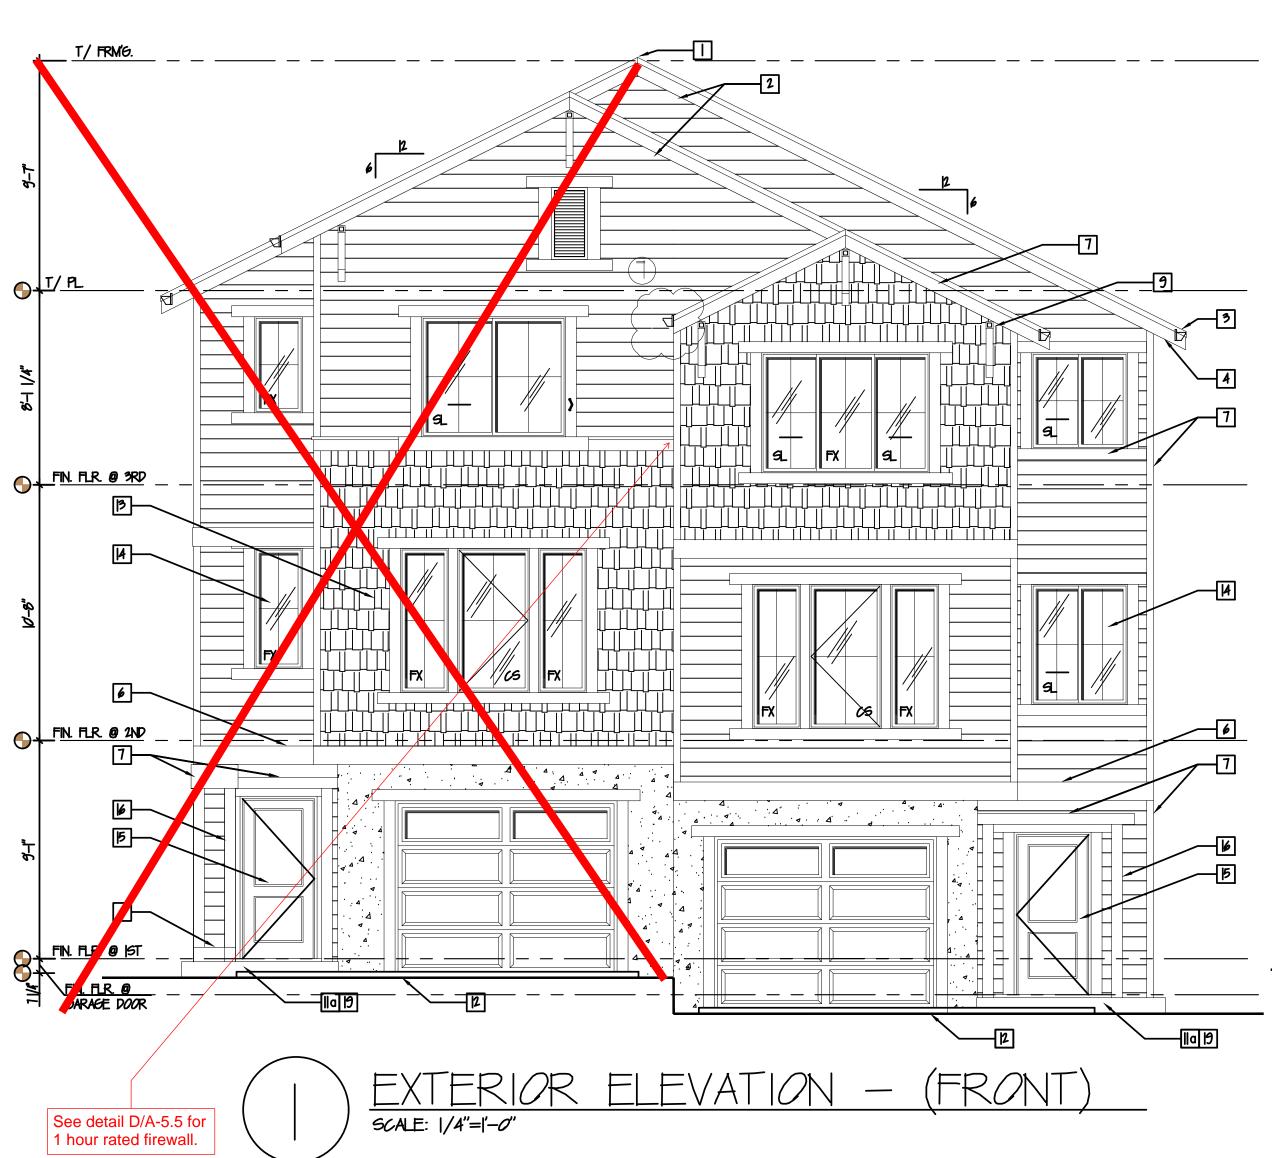

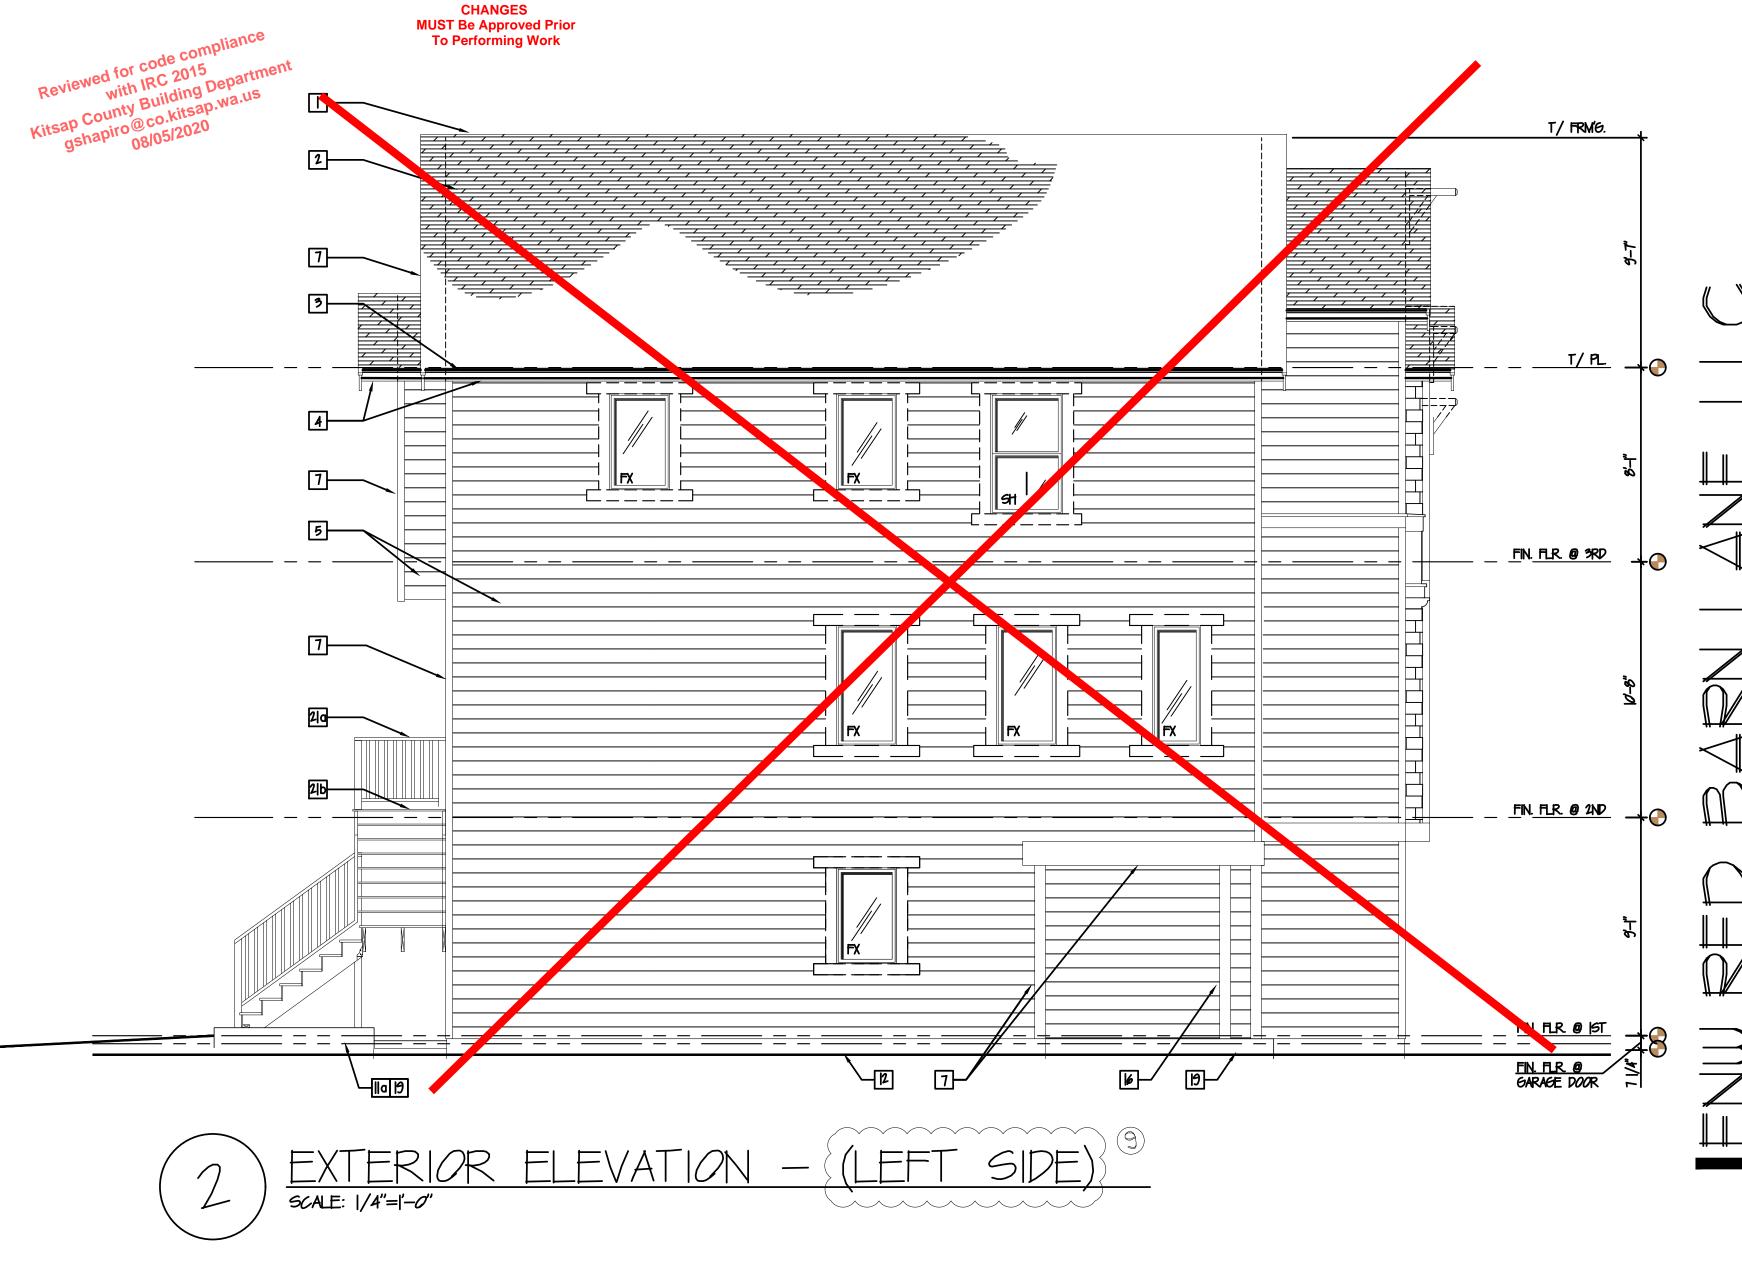

EXTERIOR ELEVATIONS - GENERAL NOTES:

I. BASED ON DESIGN INTENT DOCUMENTS AND GRAPHIC REPRESENTATIONS PROVIDED HEREIN, THE 6C AND OWNER ARE TO PROVIDE, VERIFY, OR OTHERWISE APPROVE VIA OWNER/CLIENT ALL PRODUCT AND MATERIAL SELECTIONS PRIOR TO GC ORDER AND OR INSTALLATION OF ANY PRODUCTS / MATERIALS RELATED TO PROJECT. THIS IS INCLUDING BUT NOT LIMITED TO DOORS, WINDOWS, BULT IN CABINETRY, FIXTURES, APPLIANCES, BUILDING AND STRUCTURAL SYSTEMS, MATERIALS, FINISHES, AND THE LIKE, THIS IS TO INCLUDE INFORMATION SHOWN SPECIFICALLY AND/OR THAT INFORMATION THAT IS TO BE UNDERSTOOD AS IMPLIED AND EXPECTED (POSSIBLY NOT SHOWN FOR GRAPHIC CLARITY) BY INDUSTRY STANDARDS OF QUALITY CRAFTSMANSHIP AND COMPLETE WORK FOR THE PROJECT.

2. PROVIDE THERMAL AND SOUND BATT INSULATION AT ALL FLOORS, WALLS, RAFTERS, AND INTERIOR PARTITIONS UNLESS OTHERWISE NOTED. SEE THERMAL VALUES / TABLES IN GENERAL ARCHITECTURAL NOTES SHEET(S). INSULATION MAY NOT BE SHOWN FOR CLARITY, BUT IS REQUIRED REGARDLESS OF GRAPHIC REPRESENTATION HEREIN PER IRC CODES FOR FLOORS, WALLS, RAFTERS, AND THE LIKE

3. DOORS AND WINDOWS SHOWN FOR DESIGN INTENT AND PERMIT APPD. SIZE AND LOCATION ONLY. SEE PLAN &/OR SCHEDULES AND OWNER APPD SELECTIONS FOR FINAL COORDINATION AND APPROVAL PRIOR TO GC ORDER / INSTALLATION. SEE SHEETS A-2.], A-3.1 AND A-4.1 FOR ALL DOOR AND WINDOW TYPES, DIMENSIONS OVERALL (O.A.), ROUGH OPENINGS (R.O.) OR CENTER LINE (C.L.), TRIM STYLE, SIZES, AND ADDITIONAL INFO. RELATED.

4. UNLESS OTHERWISE NOTED, ALL EXTERIOR STUDS ARE NOMINAL 2x6. ALL INTERIOR PLUMBING WALLS ARE NOMINAL 2x6. ALL OTHER INTERIOR STUDS ARE NOMINAL 2x4. SEE BUILDING AND WALL SECTIONS FOR TYPICAL WALLTYPES AND ADDITIONAL INFO.

5. UNLESS OTHERWISE NOTED, ALL DIMENSION LINES ARE ASSUMED TO BE FROM FACE OF STUD AND/OR FACE OF STEM WALL / CONC.

6. ALL PRODUCTS, SYSTEMS, MATERIALS, FINISHES, AND THE LIKE SHALL BE INSTALLED PER INDUSTRY STANDARDS AND APPROVED INDUSTRY BEST PRACTICES, AND INSTALLED BY 66. APPROVED PERSONNEL WHEN APPLICABLE AND/OR REQUIRED. INSTALLATIONS TO BE COMPLETED BY LICENSED (AND IF REQUIRED BONDED AND INSURED) CONTRACTORS, SUB-CONTRACTORS, AND/OR OTHER REQUIREMENTS FOR QUALIFIED Individuals or entities.

7. FOOTINGS, STEM WALLS, AND STEPPED CONDITIONS SHOWN ARE FOR DESIGN INTENT ONLY. ALL FOOTING SIZES, STEM WALL THICKNESSES AND OTHER STRUCTURAL BEARING CONSIDERATIONS ARE PER PRESCRIPTIVE PATH AND/OR STRUCTURAL ENGINEERING CALCULATIONS PROVIDED & ATTACHED HEREIN, BY A WASHINGTON STATE LICENSED ENGINEER. CODE REQUID SIZES, HEIGHTS, DEPTHS, COVERAGES MUST BE COMPLIANT W/ MOST RESTRICTIVE APPLICABLE CODE AND LOCAL JURISDICTIONAL REQINTS.

8. ANYWHERE MINIMUM REQUIREMENTS ARE CALLED OUT ON DRAWINGS REFER TO GENERAL NOTES AND SPECIFICATIONS FOR ADHERENCE TO MOST RESTRICTIVE CODE AND / OR SPECIFICATION REFERENCE ALL PRODUCTS, SPECIFICATIONS, AND INSTALLATIONS SHALL MEET THE MOST CURRENT AND STRINGENT OF REQUIRED CODE COMPLIANCES APPLICABLE AND RELATED TO THE SPECIFIC PROJECT, INDUSTRY, CONTRACTOR, INSTALLER, JURISDICTION, AND MATERIALS BEING USED.

9. ALL TRANSITIONS BETWEEN MATERIALS AND ADJACENT PLANES ARE TO BE FLASHED, CALLKED, SEALED, AND/OR OTHERWISE CLOSED, CONCEALED, WATERPROOFED, AND INSTALLED FOR POSITIVE DRAINAGE AWAY FROM THE BUILDING AND ITS PRODUCTS, OPENINGS, AND MATERIAL

- 10. ALL GLAZING W/IN DOORS AND WINDOWS W/IN 24" RADIUS OF OPERABLE DOORS SHALL BE TEMPERED.
- II. SEE ALL OTHER ARCHITECTURAL GENERAL NOTES, AS REQD. FOR ADDITIONAL INFO. RELATED TO DESIGN INTENTIONS & COMPLIANCE.
- 12. ALL GLAZING TO BE MIN. OF DOUBLE PANE & LOW-E COATING PER ARCH. NOTE
- 13. 66 & MANUFACTURER SHALL VFY. THAT ALL EGRESS REQUIRED LOCATIONS & SIZES ARE COMPLIANT, PRIOR TO ORDER AND INSTALL 14. GC SHALL ADHERE TO ALL OTHER CONSTRUCTION, CODE, AND INDUSTRY STANDARDS FOR CONSTRUCTION CRAFTSMANSHIP AND QUALITY

- EXTERIOR ELEVATIONS KEY NOTES
- * = EGRESS WINDOW: TO MEET IRC CODE FOR CLEAR DIMENTIONS IN WIDTH, HEIGHT OF OPENING AND CLEAR SF. NET OPENING SEE ARCHITECTURAL GENERAL NOTES FOR ADDITIONAL INFORMATION. GC. TO COORDINATE MANUFACTURER / PRODUCT MEETS CODE REQIMTS. PRIOR TO FINALIZING OF RO. FABRICATION / INSTALLATION.
- T = TEMPERED: ALL GLAZING REQUIRED TO BE TEMPERED SHALL MEET UL LISTING AND ANY/ALL ASTM STANDARDS AND IRC CODE FOR LOCATIONS REQUIRED. SEE ARCHITECTURAL GENERAL NOTES FOR ADDITIONAL INFORMATION

FACADE & GLAZING CALCULATIONS - SEE SHEET A-32

EXTERIOR ELEVATIONS - KEY NOTES

"HARDI-PLANK" HORIZONTAL LAP SIDING, T" REVEAL

- ROOF VENTING: CONTINUOUS RIDGE VENT AT ALL RIDGE LOCATIONS, UN.O.
- 2 ROOFING: 3-TAB ARCHITECTURAL REVEAL SHINGLE STYLE ROOFING, MIN. 40 YR. WARRANTY, COLOR/FINISH PER 6C/ CLIENT.
- 3 <u>GUTTERS & DOMNSPOUTS:</u> 4" COLD ROLLED ALIM. (OR APPD ALT.), PROFILE (K-LINE OR SIM.) -PRODUCT, COLOR & FINISH BY 6C/OWNER. TIGHT LINE ALL LOCS. TO SUB-GRADE DRAINAGE SYSTEM AT PERIMETER FOOTINGS, TYP. ALL LOCS. SEE BUILDING SECTIONS FOR ADDITIONAL INFORMATION IF/AS REQUIRED.
- ROOF SOFFITS: N/6 T&G TK CEDAR W/ CONT. STRIP VENTING, COLOR/ STAIN PER GC/ CLIENT.
- SIDINGS (AS SHOW PER GRAPHICS / HATCH PATTERNS): * STAIN/ COLOR/ FINISH PER 6C/CLIENT, TYP. ALL LOCS. UNO. "HARDI-PLANK" SHEETS/PANELS OF SHAKE/SHINGLE SIDING
- 6 BELLY BAND / BOARDS: * STAIN/ COLOR/ FINISH PER GC/CLIENT, TYP. ALL LOCS. UND. 2x12's @ FIRST FLOOR LINES 2x8's @ TOP PLATE SIDING TRANSITIONS, FLOOR LINE SIDING TRANSITIONS, TYP. UN.O. 5/4x4's HORIZONTAL @ TOPS OF SIDING END CONDITIONS UNDER EAVES. APPLIED TIGHT TO UNDERSIDE @ RAFTER TAILS
- EXTERIOR SIDING TRIM LOCATIONS: PRE-PRIMED WHITE WOOD OR APPD. ALT. - PRODUCT/COLOR BY 6C./OWNER WINDOWS & OORS:
- VERTICALS @ JAMBS, 5/4x4 - HEADS, & SILLS 5/4x6 WITH 2x SILL LEDGE TABLE RIPPED & FLASHED FOR POSITIVE DRAINAGE, & 5/4x6 SKIRT BLW. FASCIA BOARDS: 2x8's @ EAVES, 2x3's OVER 2x12's @ MAIN GABLE ENDS, 2x10's @ GARAGE,

CORNER BOARDS: 5/4x6 EXTERIORS, 2x2 INTERIORS

SH = SINGLE HUNG

DH = DOUBLE HUNG AWN = AWNINGEDHPR = HOPPER

<u>WINDOW</u> STYLES:

THROUGH/INCLUDING SPARK ARRESTOR. EXTERIOR SIDING/TRIM AS SHOWN GRAPHICALLY, & PER SIDING/TRIM

<u>CONCRETE PATIOS & WALKWAYS:</u> SLOPE 2% MIN. AWAY FROM \$LDG. IN ALL DIRECTIONS, WEATHER

STANDARDS FOR SCORE JOINTS &/OR CONTROL JOINTS IF/AS REQUIRED, TO ALLOW FOR LINEAR

STEM WALL & CRAWL SPACE FOUNDATION: FOOTINGS, STEM WALL THICKNESSES, AND REINFORCING /

PROPOSED FINISH GRADING ELEVATIONS, TYP. ALL LOCS. SEE BUILDING SECTIONS FOR PATT INSULATION,

EXTERIOR RIGID INSULATION (FOR W.S.E.C. IF/AS REQ'D.), WEATHERPROOFING & FLASHING (PER INDUSTRY

VENTILATION WITH 8x16 INSERTS, TYP. AS REQU AT CRAWL SPACE LOCS., USING IRC. CODE

- *NOTE: VENTING CODE REQ'D. 150 RATIO SF. FREE VENT AREA TO FLOOR SF. AREA - CROSS

Over 4" Crijshed Rock Over Indisturbed Soils (or fill compaction of pred material soils free of

FOOTING DRAINAGE, AS REQD. FOR DIMENSIONAL INDUSTRY/CODE REQUIREMENTS AND SEPARATIONS, SURROUNDING

ORGANICS). ADD. INFO. PER STRUCTURAL NOTES & FOUNDATION PLANS, BUILDING & WALL SECTIONS, TYP. ALL

LOCS. UNO. PROVIDE CONTINUOUS VAPOR BARRIERS, & WATERPROOFING/BITUMINOUS COATINGS @ SUB-GRADE

WALLS & CONDITIONS, TYP. ALL LOCS. COORDINATE W/ TIGHTLINE DOWNSPOUT LOCATIONS & PERIMETER

12 GRAND / SUBSTRATE PREPARATIONS: TYPICAL FOUNDATIONS TO BE PLACED OVER 6 MIL V.D. OVER 1" SAND

NOTES HEREIN. * NOTE: ALL CHIMNEY LOCATIONS IF/AS SHOWN, SHALL EXTEND AT MIN. 24" ABOVE ANY

DIRECT VENT F.P. AUTLET: COORDINATE AUTLET RAUTE, LOCATION, & SIZE PER CODES W/ 60 & CLIENT PER

US = CASEMENT FX = FIXED

ROOFLINE W/IN 10' HORIZONTALLY, TO MEET IRC. & IFC. CODES AS REQUIRED.

STANDARDS) AND ANY ADDITIONAL INFORMATION, TYP.

COMPLIANT SPACING & SEPARATIONS, TYP.

MATERIALS SUCH AS FILTER FABRICS, AND THE LIKE

13 NOT USED

- WINDOWS (EXTERIOR GLAZING): PER DESIGN INTENT AS SHOWN GRAPHICALLY HEREIN. SIZING PER PLAN, OPERATION CHIMNEY/ FLLE (IF USED): MANUFACTURER'S SPEC. FOR INTERNAL FIRE RATED FLUE & CONSTRUCTION UP TO AND STYLE PER EXT. ELEVATIONS. PRODUCT SELECTION, INCLUDING BRAND, STYLE, GRILL LAYOUT, HARDWARE, AND THE LIKE SHALL BE THE SELECTION OF THE CLIENT PER 6C OPTIONS. ARCHITECT AVAILABLE FOR CONSULTATION IF/AS
 - <u>DOORS (EXTERIOR FENESTRATION):</u> PER DESIGN INTENT AS SHOWN GRAPHICALLY HEREIN. SIZING PER PLAN, OPERATION STYLE PER EXT. ELEVATIONS. PRODUCT SELECTION, INCLUDING BRAND, STYLE, GRILL LAYOUT, HARDWARE AND LIKE SHALL BE THE SELECTION OF THE CLIENT W/ GC OPTIONS. ARCHITECT AVAILABLE FOR CONSULTATION IF/AS NEEDED.
- 6 CALIMNE & CALIMN TRIM/WRAP: STRUCTURAL CALIMN SIZING PER SE DRAWINGS AND CALCULATIONS. CALIMN INCLOSURE FRAMING TO INCLUDE ROUGH SAWN WHITE WOOD EXTERIOR GRADE PRE-PRIMED 3/1 x TRIM WRAP (SEE SEALANT & STAIN/STAMP FINISH PER 60 & CLIENT, TYP. ALL LOCG. - SEE STRUCT. ENG. FOR THICKNESS FLOOR PLANS & DETALS) W/ 5/4x8 BASE (PROUD OF COLUMN WRAP) AND 5/4x6 COLUMN CAP (PROUD OF COLUMN WRAP @ UNDERSIDE OF WRAPPED BEAM OR CELLING ABOVE). FINAL PRODUCT SELECTIONS, STAIN / - FOR POSITIVE DRAINAGE. CLEAR SEALANT FINISH, TYP. BASED ON SIZES OF SLABS, CONSIDER INDUSTRY FINISH, TO BE PER 60 / CLIENT COORD.
 - TO BEAM / FRAMING SIZE, SPECIES, AND CONNECTIONS PER STRUCTURAL, TYP. ALL LOCS. UND.
 - CONNECTIONS PER STRUCTURAL ENGINEERING. HOLD WOOD SIDING MATERIALS MIN. 7" ABOVE EXISTING OR
 - [19] CONCRETE STEPS PER PLAN SEE NOTE \$30 ON FLOORPLANS, TYP. ALL LOCS.
 - 1201 NEW RAISED CONCRETE WALKWAY PER PLANS, SEE NOTE ||a & #30 ON FLOOR PLANS
 - 20 New Decking Per Plans $\frac{1}{2}$ 1x6 exterior grade cedar or trex (or equal) Per gc/client.
 - 216 NEW DECK STEPS AND RALING ADHERE TO CODE MINIMUMS 36" RALING, 10-3/4" RISERS, 11" TREADS, TYP.
 - 22 CRAWL SPACE 8x16 VENTING INSERTS: SIZE/ SPACING FOR 1: 150 CLR FREE VENTING & CROSS BREEZE SF. AREA RATIO TO FLOOR SF. AREA, SPEC PER SC, SHALL MEET IRC. SPACING & CODE COMPLIANCE, INCLUDING ONE VENT OPENING SHALL BE WITHIN 3' OF EACH CORNER OF THE BLDG.

INT. DATE REV **DESIGNER:** \emptyset DRAFTER: DATE: Ø5/17/18 PROJECT NO: 19198

REVISIONS

SHEET NO:


8 NOT USED

9 NOT USED. SEE 5-7 FOR SIDING INFORMATION.

IIa <u>stem walls / faundations / faotings:</u>

& REINFORCING, TYP.

CRACKING EXPECTED.

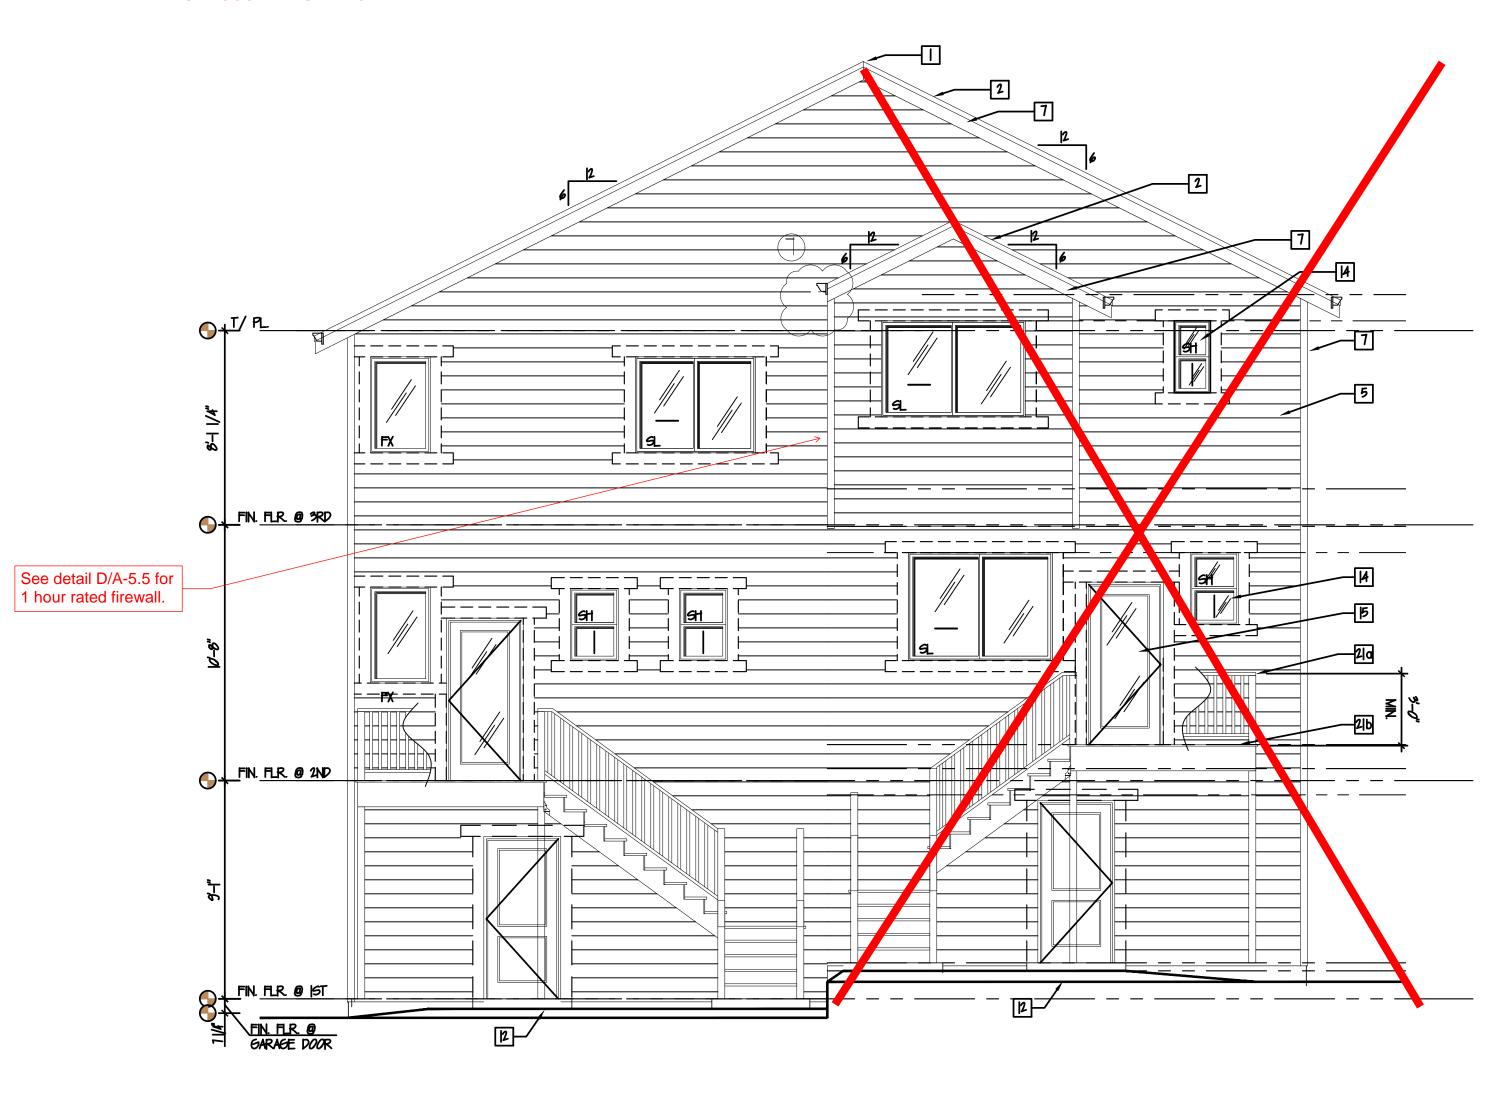

T/PL FIN. FLR. @ 3RD _____ FIN. FLR. @ 2ND FIN. FLR. 0 GARAGE DOOR EXTERIOR ELEVATION -(RIGHT SIDE) SCALE: 1/4"=1'-0" The underside of projections

SCALE: 1/4"=1'-0"

EXTERIOR ELEVATIONS — GENERAL NOTES:

I. BASED ON DESIGN INTENT DOCUMENTS AND GRAPHIC REPRESENTATIONS PROVIDED HEREIN, THE 6C AND OWNER ARE TO PROVIDE, VERIFY, OR OTHERWISE APPROVE VIA OWNER/CLIENT ALL PRODUCT AND MATERIAL SELECTIONS PRIOR TO 6C ORDER AND OR INSTALLATION OF ANY PRODUCTS / MATERIALS RELATED TO PROJECT. THIS IS INCLUDING BUT NOT LIMITED TO DOORS, WINDOWS, BUILT IN CABINETRY, FIXTURES, APPLIANCES, BUILDING AND STRUCTURAL SYSTEMS, MATERIALS, FINISHES, AND THE LIKE, THIS IS TO INCLUDE INFORMATION SHOWN SPECIFICALLY AND/OR THAT INFORMATION THAT IS TO BE UNDERSTOOD AS IMPLIED AND EXPECTED (POSSIBLY NOT SHOWN FOR GRAPHIC CLARITY) BY INDUSTRY STANDARDS OF QUALITY CRAFTSMANISHIP AND COMPLETE WORK FOR THE PROJECT.

EXTERIOR ELEVATION - (REAR)

2. PROVIDE THERMAL AND SOUND BATT INSULATION AT ALL FLOORS, WALLS, RAFTERS, AND INTERIOR PARTITIONS UNLESS OTHERWISE NOTED. SEE THERMAL VALUES / TABLES IN GENERAL ARCHITECTURAL NOTES SHEET(S). INSULATION MAY NOT BE SHOWN FOR CLARITY, BUT IS REQUIRED REGARDLESS OF GRAPHIC REPRESENTATION HEREIN PER IRC CODES FOR FLOORS, WALLS, RAFTERS, AND THE LIKE.

3. DOORS AND WINDOWS SHOWN FOR DESIGN INTENT AND PERMIT APPD. SIZE AND LOCATION ONLY. SEE PLAN &/OR SCHEDULES AND OWNER APPD SELECTIONS FOR FINAL COORDINATION AND APPROVAL PRIOR TO SC ORDER / INSTALLATION. SEE SHEETS A-2.1, A-3.1 AND A-4.1 FOR ALL DOOR AND WINDOW TYPES, DIMENSIONS OVERALL (O.A.), ROUGH OPENINGS (R.O.) OR CENTER LINE (C.L.), TRIM STYLE, SIZES, AND ADDITIONAL INFO. RELATED.

4. UNLESS OTHERWISE NOTED, ALL EXTERIOR STUDS ARE NOMINAL 2x6. ALL INTERIOR PLUMPING WALLS ARE NOMINAL 2x6. ALL OTHER INTERIOR STUDS ARE NOMINAL 2x4. SEE BUILDING AND WALL SECTIONS FOR TYPICAL WALLTYPES AND ADDITIONAL INFO.

5. UNLESS OTHERWISE NOTED, ALL DIMENSION LINES ARE ASSUMED TO BE FROM FACE OF STUD AND/OR FACE OF STEM WALL / CONC.

6. ALL PRODUCTS, SYSTEMS, MATERIALS, FINISHES, AND THE LIKE SHALL BE INSTALLED PER INDUSTRY STANDARDS AND APPROVED INDUSTRY BEST PRACTICES, AND INSTALLED BY GC. APPROVED PERSONNEL WHEN APPLICABLE AND/OR REQUIRED. INSTALLATIONS TO BE COMPLETED BY LICENSED (AND IF REQUIRED BONDED AND INSURED) CONTRACTORS, SUB-CONTRACTORS, AND/OR OTHER REQUIREMENTS FOR QUALIFIED INDIVIDUALS OR ENTITIES.

7. FOOTINGS, STEM WALLS, AND STEPPED CONDITIONS SHOWN ARE FOR DESIGN INTENT ONLY. ALL FOOTING SIZES, STEM WALL
THICKNESSES AND OTHER STRUCTURAL BEARING CONSIDERATIONS ARE PER PRESCRIPTIVE PATH AND/OR STRUCTURAL ENGINEERING
CALCULATIONS PROVIDED & ATTACHED HEREIN, BY A WASHINGTON STATE LICENSED ENGINEER. CODE REQ'D SIZES, HEIGHTS, DEPTHS,
COVERAGES MUST BE COMPLIANT W/ MOST RESTRICTIVE APPLICABLE CODE AND LOCAL JURISDICTIONAL REQ'NTS.

8. ANYWHERE MINIMUM REQUIREMENTS ARE CALLED OUT ON DRAWINGS REFER TO GENERAL NOTES AND SPECIFICATIONS FOR ADHERENCE TO MOST RESTRICTIVE CODE AND / OR SPECIFICATION REFERENCE ALL PRODUCTS, SPECIFICATIONS, AND INSTALLATIONS SHALL MEET THE MOST CURRENT AND STRINGENT OF REQUIRED CODE COMPLIANCES APPLICABLE AND RELATED TO THE SPECIFIC PROJECT, INDUSTRY, CONTRACTOR, INSTALLER, JURISDICTION, AND MATERIALS BEING USED.

9. ALL TRANSITIONS BETWEEN MATERIALS AND ADJACENT PLANES ARE TO BE FLASHED, CALLKED, SEALED, AND/OR OTHERWISE CLOSED, CONCEALED, WATERPROOTED, AND INSTALLED FOR POSITIVE DRAINAGE AWAY FROM THE BUILDING AND ITS PRODUCTS, OPENINGS, AND MATERIAL TRANSPORTAGE

10. ALL GLAZING W/IN DOORS AND WINDOWS W/IN 24" RADIUS OF OPERABLE DOORS SHALL BE TEMPERED.

II. SEE ALL OTHER ARCHITECTURAL GENERAL NOTES, AS REQD. FOR ADDITIONAL INFO. RELATED TO DESIGN INTENTIONS & COMPLIANCE.

12. ALL GLAZING TO BE MIN. OF DOUBLE PANE & LOW-E COATING PER ARCH. NOTE

19. 66 & MANUFACTURER SHALL VEY. THAT ALL EGRESS REQUIRED LOCATIONS & SIZES ARE COMPLIANT, PRIOR TO ORDER AND INSTALL

14. 6C SHALL ADHERE TO ALL OTHER CONSTRUCTION, CODE, AND INDUSTRY STANDARDS FOR CONSTRUCTION CRAFTSMANSHIP AND QUALITY

WINDOW STYLES:

SH = SINGLE HUNG

DH = DOUBLE HUNG

AWN = AWNINGED

HPR = HOPPER

CG = CAGEMENT

FX = FIXED

EXTERIOR ELEVATIONS - KEY NOTES


** = EGRESS WINDOW: TO MEET IRC CODE FOR CLEAR DIMENTIONS IN WIDTH,

HEIGHT OF OPENING AND CLEAR SF. NET OPENING — SEE ARCHITECTURAL GENERAL NOTES FOR ADDITIONAL INFORMATION. GC. TO COORDINATE MANUFACTURER / PRODUCT MEETS CODE REQIMTS. PRIOR TO FINALIZING OF RO. FABRICATION / INSTALLATION.

(1) = TEMPERED: ALL GLAZING REQUIRED TO BE TEMPERED SHALL MEET UL LISTING AND ANY/ALL ASTM STANDARDS AND IRC CODE FOR LOCATIONS REQUIRED. SEE ARCHITECTURAL GENERAL NOTES FOR ADDITIONAL INFORMATION

shall be 1 hour fire rated.


See detail E/A-5.5.

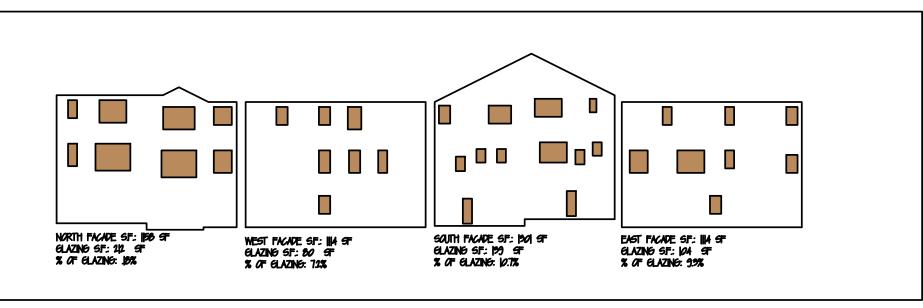

<u>GLAZING TOTALS</u> FACADE: 1,158+1,114+1,30|+1,114=4,687 GLAZING: 212+80+139+104=535 % OF GLAZING = 11,41% ELEVAT (OPTION


T/FRM6.

REVISIONS

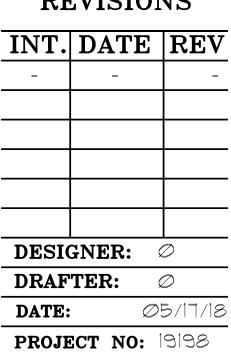

SHEET NO:

A-3.2

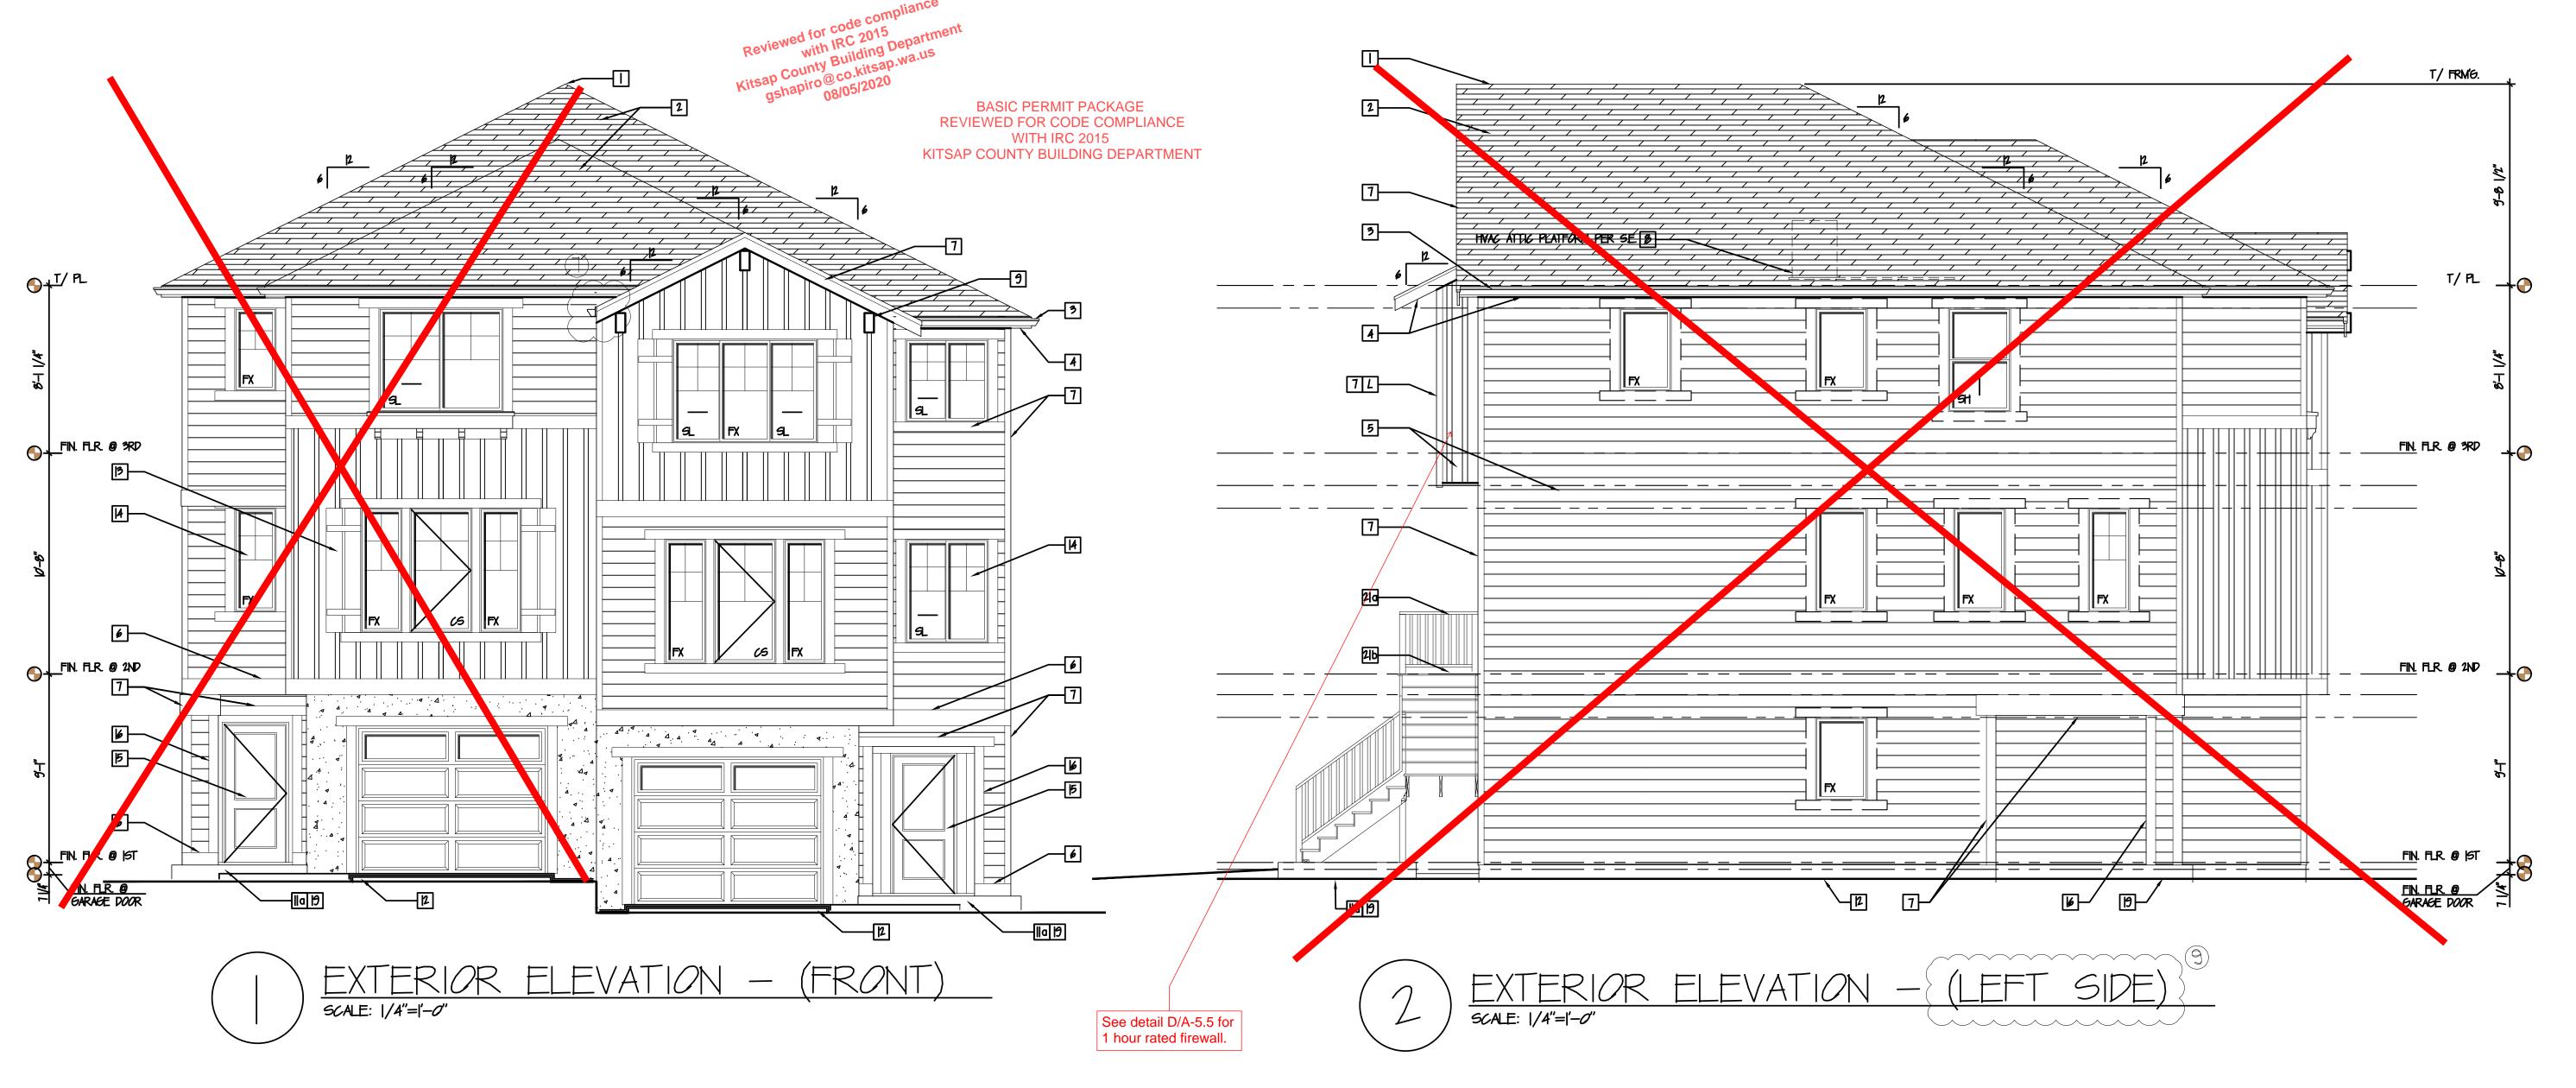

<u>EXTERIOR ELEVATIONS - GENERAL NOTES:</u> 1. BASED ON DESIGN INTENT DOCUMENTS AND GRAPHIC REPRESENTATIONS PROVIDED HEREIN, THE 6C AND OWNER ARE TO PROVIDE, VERIFY, OR OTHERWISE APPROVE VIA OWNER/CLIENT ALL PRODUCT AND MATERIAL SELECTIONS PRIOR TO SC ORDER AND OR INSTALLATION OF ANY PRODUCTS / MATERIALS RELATED TO PROJECT. THIS IS INCLIDING BUT NOT LIMITED TO DOORS, WINDOWS, BUILT IN CABINETRY, FIXTURES, APPLIANCES, BUILDING AND STRUCTURAL SYSTEMS, MATERIALS, FINISHES, AND THE LIKE, THIS IS TO INCLUDE INFORMATION SHOWN SPECIFICALLY AND/OR THAT INFORMATION THAT IS TO BE UNDERSTOOD AS IMPLIED AND EXPECTED (POSSIBLY NOT SHOWN FOR GRAPHIC CLARITY) BY INDUSTRY STANDARDS OF QUALITY CRAFTSMANSHIP AND COMPLETE WORK FOR THE PROJECT.

2. PROVIDE THERMAL AND SOUND BATT INSULATION AT ALL FLOORS, WALLS, RAFTERS, AND INTERIOR PARTITIONS UNLESS OTHERWISE NOTED. SEE THERMAL VALUES / TABLES IN GENERAL ARCHITECTURAL NOTES SHEET(S). INSULATION MAY NOT BE SHOWN FOR CLARITY, BUT IS REQUIRED REGARDLESS OF GRAPHIC REPRESENTATION HEREIN PER IRC CODES FOR FLOORS, WALLS, RAFTERS, AND THE LIKE

3. DOORS AND WINDOWS SHOWN FOR DESIGN INTENT AND PERMIT APPD. SIZE AND LOCATION ONLY. SEE PLAN &/OR SCHEDULES AND OWNER APPD SELECTIONS FOR FINAL COORDINATION AND APPROVAL PRIOR TO GC ORDER / INSTALLATION. SEE SHEETS A-2.1 , A-3.1 AND A-4.1 FOR ALL DOOR AND WINDOW TYPES, DIMENSIONS OVERALL (O.A.), ROUGH OPENINGS (R.O.) OR CENTER LINE (C.L.), TRIM STYLE, SIZES, AND

4. UNLESS OTHERWISE NOTED, ALL EXTERIOR STUDS ARE NOMINAL 2x6. ALL INTERIOR PLUMBING WALLS ARE NOMINAL 2x6. ALL OTHER INTERIOR STUDS ARE NOMINAL 2x4. SEE BUILDING AND WALL SECTIONS FOR TYPICAL WALLTYPES AND ADDITIONAL INFO.

- 5. UNLESS OTHERWISE NOTED, ALL DIMENSION LINES ARE ASSUMED TO BE FROM FACE OF STUD AND/OR FACE OF STEM WALL / CONC.
- 6. ALL PRODUCTS, SYSTEMS, MATERIALS, FINISHES, AND THE LIKE SHALL BE INSTALLED PER INDUSTRY STANDARDS AND APPROVED INDUSTRY BEST PRACTICES, AND INSTALLED BY GC. APPROVED PERSONNEL WHEN APPLICABLE AND/OR REQUIRED. INSTALLATIONS TO BE COMPLETED BY LICENSED (AND IF REQUIRED BONDED AND INSURED) CONTRACTORS, SUB-CONTRACTORS, AND/OR OTHER REQUIREMENTS FOR QUALIFIED INDIVIDUALS OR ENTITIES.

7. FOOTINGS, STEM WALLS, AND STEPPED CONDITIONS SHOWN ARE FOR DESIGN INTENT ONLY. ALL FOOTING SIZES, STEM WALL THICKNESSES AND OTHER STRUCTURAL BEARING CONSIDERATIONS ARE PER PRESCRIPTIVE PATH AND/OR STRUCTURAL ENGINEERING CALCULATIONS PROVIDED & ATTACHED HEREIN, BY A WASHINGTON STATE LICENSED ENGINEER. CODE REQID SIZES, HEIGHTS, DEPTHS, COVERAGES MUST BE COMPLIANT W/ MOST RESTRICTIVE APPLICABLE CODE AND LOCAL JURISDICTIONAL REQINTS.

8. ANYWHERE MINIMUM REQUIREMENTS ARE CALLED OUT ON DRAWINGS REFER TO GENERAL NOTES AND SPECIFICATIONS FOR ADHERENCE TO MOST RESTRICTIVE CODE AND / OR SPECIFICATION REFERENCE. ALL PRODUCTS, SPECIFICATIONS, AND INSTALLATIONS SHALL MEET THE MOST CURRENT AND STRINGENT OF REQUIRED CODE COMPLIANCES APPLICABLE AND RELATED TO THE SPECIFIC PROJECT, INDUSTRY, CONTRACTOR, INSTALLER, JURISDICTION, AND MATERIALS BEING USED.

9. ALL TRANSITIONS BETWEEN MATERIALS AND ADJACENT PLANES ARE TO BE FLASHED, CALLKED, SEALED, AND/OR OTHERWISE CLOSED, CONCEALED, WATERPROOFED, AND INSTALLED FOR POSITIVE DRAINAGE AWAY FROM THE BUILDING AND ITS PRODUCTS, OPENINGS, AND MATERIAL

- 10. ALL GLAZING W/IN DOORS AND WINDOWS W/IN 24" RADIUS OF OPERABLE DOORS SHALL BE TEMPERED.
- II. SEE ALL OTHER ARCHITECTURAL GENERAL NOTES, AS REQD. FOR ADDITIONAL INFO. RELATED TO DESIGN INTENTIONS & COMPLIANCE.
- 12. ALL GLAZING TO BE MIN. OF DOUBLE PANE & LOW-E COATING PER ARCH. NOTE
- 13. GC & MANUFACTURER SHALL VFY. THAT ALL EGRESS REQUIRED LOCATIONS & SIZES ARE COMPLIANT, PRIOR TO ORDER AND INSTALL
- 14. GC SHALL ADHERE TO ALL OTHER CONSTRUCTION, CODE, AND INDUSTRY STANDARDS FOR CONSTRUCTION CRAFTSMANSHIP AND QUALITY

EXTERIOR ELEVATIONS - KEY NOTES

* = EGRESS WINDOW: TO MEET IRC CODE FOR CLEAR DIMENTIONS IN WIDTH, HEIGHT OF OPENING AND CLEAR SF. NET OPENING - SEE ARCHITECTURAL GENERAL NOTES FOR ADDITIONAL INFORMATION. GC. TO COORDINATE MANUFACTURER / PRODUCT MEETS CODE REQINTS. PRIOR TO FINALIZING OF RO. FABRICATION / INSTALLATION.

①= TEMPERED: ALL GLAZING REQUIRED TO BE TEMPERED SHALL MEET UL LISTING AND ANY/ALL ASTM STANDARDS AND IRC CODE FOR LOCATIONS REQUIRED. SEE ARCHITECTURAL GENERAL NOTES FOR ADDITIONAL INFORMATION

FACADE & GLAZING CALCULATIONS - SEE SHEET A-32

EXTERIOR ELEVATIONS - KEY NOTES

"HARDI-PLANK" HORIZONTAL LAP SIDING, 7" REVEAL

CORNER BOARDS: 5/4x6 EXTERIORS, 2x2 INTERIORS

UNDERSIDE @ RAFTER TAILS

- ROOF VENTING: CONTINUOUS RIDGE VENT AT ALL RIDGE LOCATIONS, UN.O.
- 2 ROOFING: 3-TAB ARCHITECTURAL REVEAL SHINGLE STYLE ROOFING, MIN. 40 YR. WARRANTY, COLOR/FINISH PER 6C/ CLIENT.
- 3 <u>GUTTERS & DOMNSPOUTS:</u> 4" COLD ROLLED ALLM. (OR APPD ALT.), PROFILE (K-LINE OR SIM.) PRODUCT, COLOR & FINISH BY 6C/OWNER. TIGHT LINE ALL LOCS. TO SUB-GRADE DRAINAGE SYSTEM AT PERIMETER FOOTINGS, TYP. ALL LOCS. SEE BUILDING SECTIONS FOR ADDITIONAL INFORMATION IF/AS REQUIRED.
- ROOF SOFFITS: NG T&G TK CEDAR W/ CONT. STRIP VENTING, COLOR/ STAIN PER GC/ CLIENT.
- 5 SIDINGS (AS SHOW PER GRAPHICS / HATCH PATTERNS): * STAIN/ COLOR/ FINISH PER 6c/client, typ. all l*ocs.* Un*o.* "HARDI-PLANK" SHEETS/PANELS OF SHAKE/SHINGLE SIDING
- 6 BELLY BAND / BOARDS: * STAIN/ COLOR/ FINISH PER 6C/CLIENT, TYP. ALL LOCS. UNO. 2x/2's @ FIRST FLOOR LINES 2x8's @ TOP PLATE SIDING TRANSITIONS, FLOOR LINE SIDING TRANSITIONS, TYP. UN.O. 5/4x4's HORIZONTAL @ TOPS OF SIDING END CONDITIONS UNDER EAVES. APPLIED TIGHT TO
- 7 EXTERIOR SIDING TRIM LOCATIONS: PRE-PRIMED WHITE WOOD OR APPD. ALT. - PRODUCT/COLOR BY 6C./OMNER
- WINDOWS & OORS: - VERTICALS @ JAMBS, 5/4x4 - HEADS, & SILLS 5/4x6 WITH 2x SILL LEDGE TABLE RIPPED & FLASHED FOR POSITIVE
- DRAINAGE, & 5/4x6 9KIRT BLW. FASCIA BOARDS: 2x8's @ EAVES, 2x9's OVER 2x12's @ MAIN GABLE ENDS, 2x10's @ GARAGE,

8 NOT USED

- 9 NOT USED. SEE 5-7 FOR SIDING INFORMATION.
- (F USED): MANUFACTURER'S SPEC. FOR INTERNAL FIRE RATED FILE & CONSTRUCTION UP TO AND THROUGH/INCLUDING SPARK ARRESTOR. EXTERIOR SIDING/TRIM AS SHOWN GRAPHICALLY, & PER SIDING/TRIM NOTES HEREIN. * <u>NOTE:</u> ALL CHIMNEY LOCATIONS IF/AS SHOWN, SHALL EXTEND AT MIN. 24" ABOVE ANY ROOFLINE W/IN 10 HORIZONTALLY, TO MEET IRC. & IFC. CODES AS REQUIRED.
- DIRECT VENT FP. AUTLET: COORDINATE AUTLET RAUTE, LOCATION, & SIZE PER CODES W/ 6C & CLIENT PER

WINDOW STYLES:

SH = SINGLE HUNG

DH = DOUBLE HUNG

AWN = AWNINGED

CS = CASEMENT

HPR = HOPPER

FX = FIXED

IIIa STEM WALLS / FOUNDATIONS / FOOTINGS:

- CONCRETE PATIOS & WALKWAYS: SLOPE 2% MIN. AWAY FROM BLDG. IN ALL DIRECTIONS, WEATHER SEALANT & STAIN/STAMP FINISH PER 60 & CLIENT, TYP. ALL LOCG. - SEE STRUCT. ENG. FOR THICKNESS
- STANDARDS FOR SCORE JOINTS &/OR CONTROL JOINTS IF/AS REQUIRED, TO ALLOW FOR LINEAR CRACKING EXPECTED.
- STEM WALL & CRAML SPACE FOUNDATION: FOOTINGS, STEM WALL THICKNESSES, AND REINFORCING , CONNECTIONS PER STRUCTURAL ENGINEERING. HOLD WOOD SIDING MATERIALS MIN. 7" ABOVE EXISTING OR PROPOSED FINISH GRADING ELEVATIONS, TYP. ALL LOCS. SEE BUILDING SECTIONS FOR BATT INSULATION, EXTERIOR RIGID INSULATION (FOR W.S.E.C. IF/AS REQID.), WEATHERPROOFING & FLASHING (PER INDUSTRY STANDARDS) AND ANY ADDITIONAL INFORMATION, TYP.
- *NOTE: VENTING CODE REQ'D. 150 RATIO SF. FREE VENT AREA TO FLOOR SF. AREA CROSS VENTILATION WITH 8x16 INSERTS, TYP. AS REQ'D AT CRAWL SPACE LOCS., USING IRC. CODE COMPLIANT SPACING & SEPARATIONS, TYP.
- 12 GRAND / SUBSTRATE PREPARATIONS: TYPICAL FOUNDATIONS TO BE PLACED OVER 6 MIL. V.B. OVER 2" SAND OVER 4" CRUSHED ROCK OVER UNDISTURBED SOILS (OR FULL COMPACTION OF PREP MATERIAL SOILS FREE OF ORGANICS). ADD. INFO. PER STRUCTURAL NOTES & FOUNDATION PLANS, BUILDING & WALL SECTIONS, TYP. ALL LOCS. UNO. PROVIDE CONTINUOUS VAPOR BARRIERS, & WATERPROOFING/BITUMINOUS COATINGS @ SUB-GRADE WALLS & CONDITIONS, TYP. ALL LOCS. COORDINATE W/ TIGHTLINE DOWNSPOUT LOCATIONS & PERIMETER FOOTING DRAINAGE, AS REQD. FOR DIMENSIONAL INDUSTRY/CODE REQUIREMENTS AND SEPARATIONS, SURROUNDING MATERIALS SUCH AS FILTER FABRICS, AND THE LIKE

19 NOT USED

- MINDOWS (EXTERIOR GLAZING): PER DESIGN INTENT AS SHOWN GRAPHICALLY HEREIN. SIZING PER PLAN, OPERATION STYLE PER EXT. ELEVATIONS. PRODUCT SELECTION, INCLIDING BRAND, STYLE, GRILL LAYOUT, HARDWARE, AND THE LIKE SHALL BE THE SELECTION OF THE CLIENT PER 60 OPTIONS. ARCHITECT AVAILABLE FOR CONSULTATION IF/AS NEEDED.
- <u>DOORS (EXTERIOR FENESTRATION):</u> PER DESIGN INTENT AS SHOWN GRAPHICALLY HEREIN. SIZING PER PLAN, *O*PERATION STYLE PER EXT. ELEVATIONS. PRODUCT SELECTION, INCLUDING BRAND, STYLE, GRILL LAYOUT, HARDWARE AND LIKE SHALL BE THE SELECTION OF THE CLIENT W/ GC OPTIONS. ARCHITECT AVAILABLE FOR CONSULTATION IF/AS NEEDED.
- CALIMNS & CALIMN TRIM/WRAP: STRUCTURAL CALIMN SIZING PER SE DRAWINGS AND CALCULATIONS. CALIMN INCLOSURE FRAMING TO INCLUDE ROUGH SAWN WHITE WOOD EXTERIOR GRADE PRE-PRIMED 3/1/x TRIM WRAP (SEE FLOOR PLANS & DETAILS) W/ 5/4x8 BASE (PROUD OF COLUMN WRAP) AND 5/4x6 COLUMN CAP (PROUD OF COLUMN WRAP @ UNDERSIDE OF WRAPPED BEAM OR CEILING ABOVE). FINAL PRODUCT SELECTIONS, STAIN / - FOR POSITIVE DRAINAGE. CLEAR SEALANT FINISH, TYP. BASED ON SIZES OF SLABS, CONSIDER INDUSTRY FINISH, TO BE PER 66 / CLIENT COORD.
 - T BEAM / FRAMING SIZE, SPECIES, AND CONNECTIONS PER STRUCTURAL, TYP. ALL LOCS. UND.
 - 19 24X 48 SKYLIGHT- INSTALL, CRICKET & FLASHING PER MFR. 'S SPECS. FOR POSITIVE DRAINAGE TYP.
 - 19 CONCRETE STEPS PER PLAN SEE NOTE #90 ON FLOORPLANS, TYP. ALL LOCS.
 - 120 NEW RAISED CONCRETE WALKWAY PER PLANS, SEE NOTE 110 & #30 ON FLOOR PLANS
 - 210 NEW DECKING PER PLANS 3/4"x6 EXTERIOR GRADE CEDAR OR TREX (OR EQUAL) PER GC/CLIENT.
 - 216 NEW DECK STEPS AND RALING ADHERE TO CODE MINIMUMS 36" RAILING, 10-3/4" RISERS, 11" TREADS, TYP.
 - 22 CRAWL SPACE 8x16 VENTING INSERTS: SIZE/ SPACING FOR 1: 150 CLR FREE VENTING & CROSS BREEZE SF. AREA RATIO TO FLOOR SF. AREA, SPEC PER SC, SHALL MEET IRC. SPACING & CODE COMPLIANCE, INCLUDING ONE VENT OPENING SHALL BE WITHIN 3 OF EACH CORNER OF THE BLDG.

INT. DATE REV **DESIGNER:** \emptyset DRAFTER:

DATE:

REVISIONS

SHEET NO:

PROJECT NO: 19198

Ø5/17/18

BASIC PERMIT PACKAGE

REVIEWED FOR CODE COMPLIANCE WITH IRC 2015

KITSAP COUNTY BUILDING DEPARTMENT T/FRMG. -B HVAC ATTIC PLATFORM PER SE. _ T/ PL. FIN. FLR. @ 3RD FIN. FLR. @ 2ND , FIN. FLR. @ EXTERIOR ELEVATION -(RIGHT SIDE) SCALE: 1/4"=1'-0"

> The underside of projections shall be 1 hour fire rated.

See detail E/A-5.5.

SCALE: 1/4"=1'-0"

EXTERIOR ELEVATIONS - GENERAL NOTES: I. BASED ON DESIGN INTENT DOCUMENTS AND GRAPHIC REPRESENTATIONS PROVIDED HEREIN, THE 6C AND OWNER ARE TO PROVIDE, VERIFY, OR OTHERWISE APPROVE VIA OMNER/CLIENT ALL PRODUCT AND MATERIAL SELECTIONS PRIOR TO GC ORDER AND OR INSTALLATION OF ANY PRODUCTS / MATERIALS RELATED TO PROJECT. THIS IS INCLUDING BUT NOT LIMITED TO DOORS, WINDOWS, BUILT IN CABINETRY, FIXTURES, APPLIANCES, BUILDING AND STRUCTURAL SYSTEMS, MATERIALS, FINISHES, AND THE LIKE, THIS IS TO INCLUDE INFORMATION SHOWN SPECIFICALLY AND/OR THAT INFORMATION THAT IS TO BE UNDERSTOOD AS IMPLIED AND EXPECTED (POSSIBLY NOT SHOWN FOR GRAPHIC CLARITY) BY INDUSTRY STANDARDS OF QUALITY CRAFTSMANSHIP AND COMPLETE WORK FOR THE PROJECT.

2. PROVIDE THERMAL AND SOUND BATT INSULATION AT ALL FLOORS, WALLS, RAFTERS, AND INTERIOR PARTITIONS UNLESS OTHERWISE NOTED. SEE THERMAL VALLES / TABLES IN GENERAL ARCHITECTURAL NOTES SHEET(S). INSULATION MAY NOT BE SHOWN FOR CLARITY, BUT IS REQUIRED REGARDLESS OF GRAPHIC REPRESENTATION HEREIN PER IRC CODES FOR FLOORS, WALLS, RAFTERS, AND THE LIKE

3. DOORS AND WINDOWS SHOWN FOR DESIGN INTENT AND PERMIT APPD. SIZE AND LOCATION ONLY. SEE PLAN &/OR SCHEDULES AND OWNER APPD SELECTIONS FOR FINAL COORDINATION AND APPROVAL PRIOR TO SC ORDER / INSTALLATION. SEE SHEETS A-21, A-31 AND A-41 FOR ALL DOOR AND WINDOW TYPES, DIMENSIONS OVERALL (O.A.), ROUGH OPENINGS (R.O.) OR CENTER LINE (C.L.), TRIM STYLE, SIZES, AND ADDITIONAL INFO. RELATED.

4. UNLESS OTHERWISE NOTED, ALL EXTERIOR STUDS ARE NOMINAL 2x6. ALL INTERIOR PLIMBING WALLS ARE NOMINAL 2x6. ALL OTHER INTERIOR STUDS ARE NOMINAL 2x4. SEE BUILDING AND WALL SECTIONS FOR TYPICAL WALLTYPES AND ADDITIONAL INFO.

5. UNLESS OTHERWISE NOTED, ALL DIMENSION LINES ARE ASSUMED TO BE FROM FACE OF STUD AND/OR FACE OF STEM WALL / CONC.

6. ALL PRODUCTS, SYSTEMS, MATERIALS, FINISHES, AND THE LIKE SHALL BE INSTALLED PER INDUSTRY STANDARDS AND APPROVED INDUSTRY BEST PRACTICES, AND INSTALLED BY 6C. APPROVED PERSONNEL WHEN APPLICABLE AND/OR REQUIRED. INSTALLATIONS TO BE COMPLETED BY LICENSED (AND IF REQUIRED BONDED AND INSURED) CONTRACTORS, SUB-CONTRACTORS, AND/OR OTHER REQUIREMENTS FOR QUALIFIED individuals or entities.

7. FOOTINGS, STEM WALLS, AND STEPPED CONDITIONS SHOWN ARE FOR DESIGN INTENT ONLY. ALL FOOTING SIZES, STEM WALL THICKNESSES AND OTHER STRUCTURAL BEARING CONSIDERATIONS ARE PER PRESCRIPTIVE PATH AND/OR STRUCTURAL ENGINEERING CALCULATIONS PROVIDED & ATTACHED HEREIN, BY A WASHINGTON STATE LICENSED ENGINEER. CODE REQU SIZES, HEIGHTS, DEPTHS, COVERAGES MUST BE COMPLIANT W/ MOST RESTRICTIVE APPLICABLE CODE AND LOCAL JURISDICTIONAL REGINTS.

8. ANYWHERE MINIMUM REQUIREMENTS ARE CALLED OUT ON DRAWINGS REFER TO GENERAL NOTES AND SPECIFICATIONS FOR ADHERENCE TO MOST RESTRICTIVE CODE AND / OR SPECIFICATION REFERENCE. ALL PRODUCTS, SPECIFICATIONS, AND INSTALLATIONS SHALL MEET THE MOST CURRENT AND STRINGENT OF REQUIRED CODE COMPLIANCES APPLICABLE AND RELATED TO THE SPECIFIC PROJECT, INDUSTRY, CONTRACTOR, INSTALLER, JURISDICTION, AND MATERIALS BEING USED.

9. ALL TRANSITIONS BETWEEN MATERIALS AND ADJACENT PLANES ARE TO BE FLASHED, CALLKED, SEALED, AND/OR OTHERWISE CLOSED, CONCEALED, WATERPROOTED, AND INSTALLED FOR POSITIVE DRAINAGE AWAY FROM THE BUILDING AND ITS PRODUCTS, OPENINGS, AND MATERIAL

10. ALL GLAZING W/IN DOORS AND WINDOWS W/IN 24" RADIUS OF OPERABLE DOORS SHALL BE TEMPERED.

II. SEE ALL OTHER ARCHITECTURAL GENERAL NOTES, AS REQD. FOR ADDITIONAL INFO. RELATED TO DESIGN INTENTIONS & COMPLIANCE.

12. ALL GLAZING TO BE MIN. OF DOUBLE PANE & LOW-E COATING PER ARCH. NOTE

13. 6C & MANUFACTURER SHALL VEY. THAT ALL EGRESS REQUIRED LOCATIONS & SIZES ARE COMPLIANT, PRIOR TO ORDER AND INSTALL

14. 6C SHALL ADHERE TO ALL OTHER CONSTRUCTION, CODE, AND INDUSTRY STANDARDS FOR CONSTRUCTION CRAFTSMANSHIP AND QUALITY


WINDOW STYLES:

| SH = SINGLE HUNG DH = DOUBLE HUNG AWN = AWNINGED HPR = HOPPER CS = CASEMENT FX = FIXED

EXTERIOR ELEVATIONS - KEY NOTES

 \circledast = egress window: to meet irc code for clear dimentions in width, HEIGHT OF OPENING AND CLEAR SF. NET OPENING - SEE ARCHITECTURAL GENERAL NOTES FOR ADDITIONAL INFORMATION. GC. TO COORDINATE MANUFACTURER / PRODUCT MEETS CODE REQINTS. PRIOR TO FINALIZING OF R.O. FABRICATION / INSTALLATION.

(1) = TEMPERED: ALL GLAZING REQUIRED TO BE TEMPERED SHALL MEET UL LISTING AND ANY/ALL ASTM STANDARDS AND IRC CODE FOR LOCATIONS REQUIRED. SEE ARCHITECTURAL GENERAL NOTES FOR ADDITIONAL INFORMATION

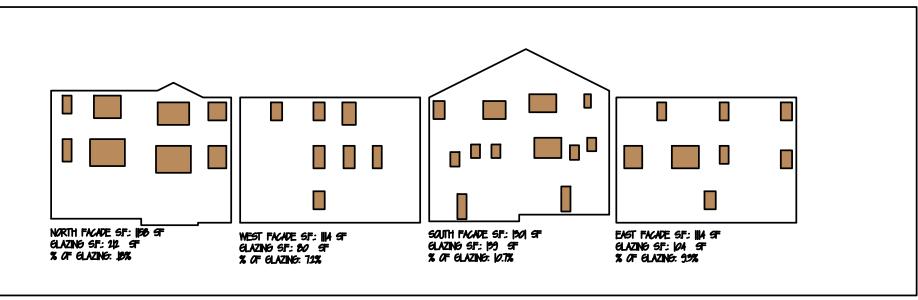

<u>GLAZING TOTALS</u> FACADE: 1,158+1,114+1,301+1,114=4,687 6LAZING: 2|2+80+|39+|04=535

% OF GLAZING = ||A|%


REVISIONS

INT. DATE REV **DESIGNER:** \emptyset DRAFTER: DATE: Ø5/17/18

SHEET NO:

PROJECT NO: 19198

CHANGES MUST Be Approved Prior To Performing Work

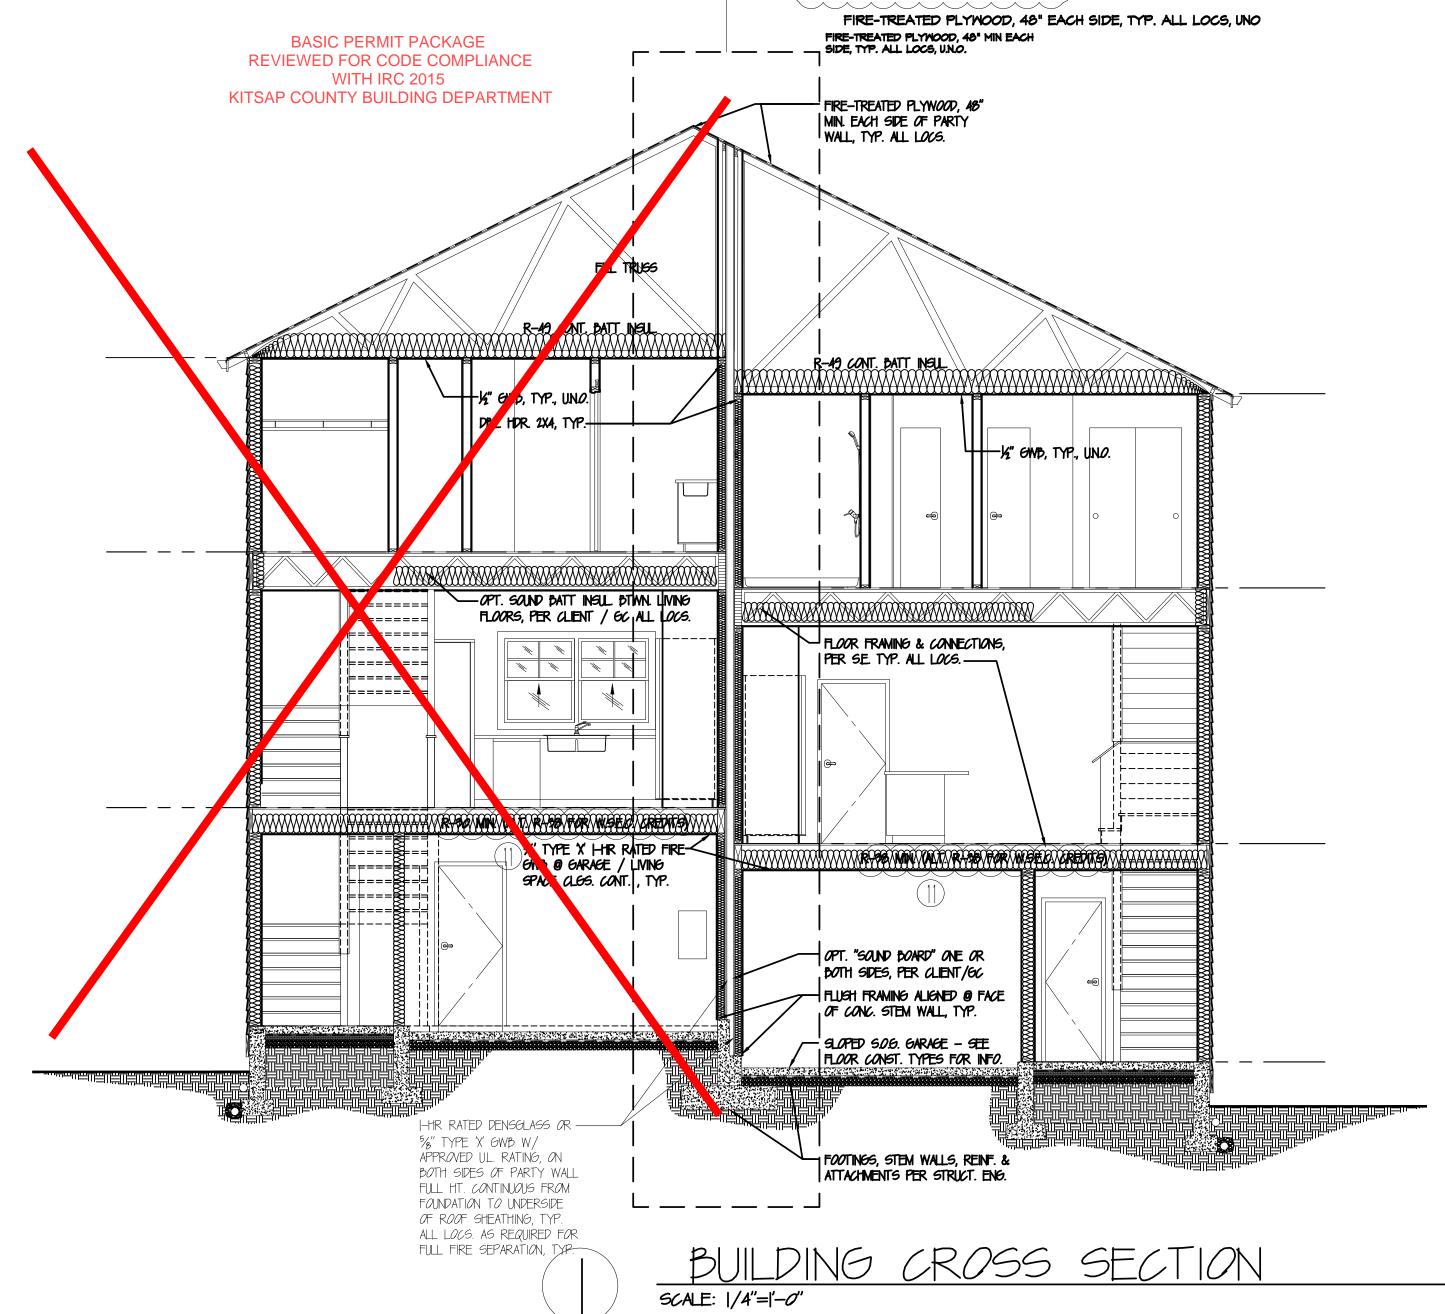

BUILDING SECTIONS - KEY NOTES

ROOF VENTING: CONTINUOUS RIDGE VENT AT ALL RIDGE LOCATIONS, COR-A-VENT 600 OR APPVD. ALT. - TYP. ALL LOCS. UND.

2 ROOF ASSEMBLY: ROOFING PER EXTERIOR FINISH SCHEDULE, SEE A-3XX SHEET SERIES OVER 30# BLDG PAPER (2 LAYERS @ 15# EACH, OVERLAP PER MFR. SPECS, OVER PLYWOOD/OSD ROOF SHEATHING PER STRUCTURAL ENGINEER, OVER ROOF RAFTERS PER SE. W/BATT INSULATION = R-49 @ FLAT BOTTOM CHORDS, OR R-38 BATT INSULATION @ VAULTED CEILINGS, TYP.

OVER 1/2" INTERIOR 6WB. MUD, TAPE, TEXTURE, PRIME & PAINT * NOTE: BAFFLE INSULATION SPACES AS REQD. FOR VENTILATION (| " AIR FLOW @ EAVES), PER IRC. & ARCH. NOTES, 60 COORD W/ MFR. & INSTALLER<u>ROOFING:</u> 3-TAB ARCHITECTURAL REVEAL SHINGLE STYLE ROOFING, MIN. 40 YR. WARRANTY, COLOR/FINISH PER 6C/ CLIENT.

3 GUTTERS & DOWNSPOUTS: 4" COLD ROLLED ALLM. (OR APPD ALT.), PROFILE (K-LINE OR SIM.) - PRODUCT, COLOR & FINISH BY 6C/OMNER. TIGHT LINE ALL LOCS. TO SUB-GRADE DRAINAGE SYSTEM AT PERIMETER FOOTINGS, TYP. ALL LOCS. SEE BUILDING | III STEM WALLS / FOUNDATIONS / FOOTINGS: SECTIONS FOR ADDITIONAL INFORMATION IF/AS REQUIRED.

A 44 EMPOSED OPEN ROOF TRUES EAVE RAFTER TALLS W/ CONT. BIRD BLOCKING/ VENTING BETWEEN, PER INDUSTRY STDS.

4B: CLOSED SOFFITING — AT COVERED PORCH "CEILINGS", 5/4×6 T&G TK. CEDAR W/ CONT. STRIP VENTING, COLOR/ STAIN PER 6C/ CLIENT.

| 5 | EXTERIOR WALL AGGEMBLY: SIDING PER EXTERIOR ELEVATIONS FINISH SCHEDULE (SEE SHEET A-3X SERIES), OVER WEATHER BARRIER EXTERIOR BUILDING WRAP (TYVEK OR EQUAL) OVER WALL SHEATHING PLYWOOD/OSD PER STRUCTURAL ENGINEERING, OVER 2x6 FRAMING @ 16" OC. MAX. AND IRC. APPROVED SPACING AND FRAMING LAYOUTS @ WALL TRANSITIONS W/ CONTINUOUS R-2| MIN. BATT INSULATION, OVER VAPOR BARRIER (WARM SIDE, ALT. V.B. PRIMER),

OVER 1/2" INTERIOR 6.W.B. - MUD, TAPE, TEXTURE, PRIME & PAINT 6 BELLY BAND / BOARDS: * STAIN/ COLOR/ FINISH PER 6C/CLIENT, TYP. ALL LOCS. UND. 2x8's @ TOP PLATE SIDING TRANSITIONS, FLOOR LINE SIDING TRANSITIONS, TYP. UN.O. (OPT.) 5/4x4's HORIZONTAL @ TOPS OF SIDING END CONDITIONS UNDER EAVES. APPLIED TIGHT TO UNDERSIDE @ RAFTER TALS

7 EXTERIOR TRIM LOCATIONS:

PRE-PRIMED WHITE WOOD OR APPD. ALT. - PRODUCT/COLOR BY 6C./OWNER WINDOWS & DOORS:

"WATER TABLE" (FLOOR LINE BELLY BAND) - 2x/2's TYP. ALL LOCS., UNO.

- VERTICALS @ JAMPS, 5/4x4

- HEADS, & SILLS 5/4x/ WITH 2x SILL LEDGE TABLE RIPPED & FLASHED FOR POSITIVE DRAINAGE, & 5/4x/ SKIRT BLW. FASCIA BOARDS: 2x14's @ EAVES, 2x3's OVER 2x14's @ MAIN GABLE ENDS, 2x10's @ GARAGE (IF APPLICABLE), UN.O. CORNER BOARDS: 5/4x/ EXTERIORS, 2x2 INTERIORS

8 INTERIOR WALL ASSEMBLY - NON BEARING WALLS: 1/2'' GWP OVER 2X4 FRAMING @ 16" OC. MAX (UNO. PER SE.) OVER 1/2'' GWP - MUD, TAPE, TEXTURE, PRIME AND PAINT. SEE PLAN FOR WALL TYPES

9 <u>structural headers:</u> Located @ all door and window rough openings, uno. - see struct. For size/loc., typ. -INFILL SPACE W/ RIGID INSUL TYP.

10 <u>chimney (if used):</u> manufacturer's spec. For internal fire rated fille & construction up to and through/incliding SPARK ARRESTOR. EXTERIOR SIDING/TRIM AS SHOWN GRAPHICALLY, & PER SIDING/TRIM NOTES HEREIN. + NOTE: ALL SPARK ARRESTOR. EXTENDIA SHOWN, SHALL EXTEND AT MIN. 24" ABOVE ANY ROOFLINE W/IN 10 HORIZONTALLY, TO MEET IR.C. & 10 INTERIOR ELEVATION ELEMENT - SHOWER ENCLOSURE PER PLAN IF*C. CODES AS* REQUIRED.

DIRECT VENT F.P. AUTLET: COORDINATE AUTLET RAUTE, LOCATION, & SIZE PER CODES W/ 60 & CLIENT & PER MFR. SPECS.

- CONCRETE PATIOS & WALKWAYS: SLOPE 2% MIN. AWAY FROM BLDG. IN ALL DIRECTIONS, WEATHER SEALANT & STAIN/STAMP FINISH PER 60 & CLIENT, TYP. ALL LOCS. - SEE STRUCT. ENG. FOR THICKNESS & REINFORCING, TYP.

FLOOR ASSEMBLY (IF USED): FINISH FLOORING & PASE TRIM PER 6C/CLIENT, TYP. ALL ROOMS,

OVER PLYWOOD PER STRUCT. ENG., OVER FLOOR FRAMING / TJI JOISTS PER STRUCT. W/ CONT. R-30 BATT INSUL PER CODE, OVER BEAMS PER STRUCT. AND/OR HUNG / SEATED ON STEM WALLS, SEE STRUCT. DETAILS,

FLOOR ASSEMBLY - SLAB ON GRADE (IF USED): CONC. SLAB THICKNESS & REINFORCEMENT PER STRUCT. ENG. CLEAR SEALED FINISH, OVER 6 MIL. VAPOR BARRIER

OVER 2" SAND OVER 4" WASHED CRUSHED ROCK OVER COMPACTED SOILS FREE OF ORGANICS AND STRUCT. APPROVAL FOR BEARING CAPACITY.

MINDOWS (EXTERIOR GLAZING): PER DESIGN INTENT AS SHOWN GRAPHICALLY HEREIN. SIZING PER PLAN, OPERATION STYLE PER EXT. ELEVATIONS. PRODUCT SELECTION, INCLIDING BRAND, STYLE, GRILL LAYOUT, HARDWARE, AND THE LIKE SHALL BE THE SELECTION OF THE CLIENT PER GC OPTIONS. ARCHITECT AVAILABLE FOR CONSULTATION IF/AS NEEDED.

15 <u>Doors (exterior fenestration):</u> Per Design Intent as shown graphically herein. Sizing Per Plan, operation style PER EXT. ELEVATIONS. PRODUCT SELECTION, INCLUDING BRAND, STYLE, GRILL LAYOUT, HARDWARE AND LIKE SHALL BE THE SELECTION OF THE CLIENT W/ 6C OPTIONS. ARCHITECT AVAILABLE FOR CONSULTATION IF/AS NEEDED.

EXTERIOR COLUMNS & COLUMN TRIM/MRAP: STRUCTURAL COLUMN SIZING PER SE PRAWINGS AND CALCULATIONS. COLUMN - Underside of Wrapped Beam or Ceiling Above). Final product selections, stain / Finish, to be per 6c / Client

17 <u>Beams:</u> Per structural engineering design, drawings, details, and calculations, typ. all l*ocs.* U.N.O. FINISH / WRAP @ INTERIORS: EXPOSED, CLEAR STAIN/SEALANT IF ARCHITECTURAL GRADE SELECTED. FINISH / WRAP @ EXTERIORS: EXPOSED, EXTERIOR WATERPROOFING, CAP/FLASH TOP/ENDS TO MATCH ROOFING MATERIALS, TYP. ALL LOCS. UND.

[B] FOOTING, STEM WALL & CRAWL SPACE: FOOTINGS, STEM WALL THICKNESSES, AND REINFORCING / CONNECTIONS PER STRUCTURAL ENGINEERING. HOLD WOOD SIDING MATERIALS MIN. T' ABOVE EXISTING OR PROPOSED FINISH GRAPING ELEVATIONS, TYP. ALL LOCS. SEE BUILDING SECTIONS FOR BATT INSULATION, EXTERIOR RIGID INSULATION (FOR W.SE.C. IF/AS REQD.), WEATHERPROOFING & FLASHING (PER INDUSTRY STANDARDS) AND ANY ADDITIONAL INFORMATION, TYP.

*NOTE: VENTING CODE REQD. 150 RATIO SF. FREE VENT AREA TO FLOOR SF. AREA - CROSS VENTILATION WITH 8x16 INSERTS, TYP. AS REQ'D AT CRAWL SPACE LOCS, USING IRC. CODE COMPLIANT SPACING & SEPARATIONS, TYP.

19 INTERIOR ELEVATION ELEMENT - KITCHEN CAPINETS AND COUNTER AT 36" AFF.

2) INTERIOR ELEVATION ELEMENT - KITCHEN HOOD V.T.O.S.

22 <u>Exterior siding:</u> Per exterior elevations & finish schedule, as shown graphically or otherwise defined.

DECK PRODUCTS & FINISHES PER OWNER/ GC (TREX, CEDAR, OR APPVD. ALT.) INSTALLATION PER MANUFACTURERS SPECIFICATIONS AND INSTRUCTIONS, OVER PRESERVATIVE (PRESSURE) TREATED DECK JOISTS, OVER PRESERVATIVE TREATED BEAMS, SIZING, SPACING, SPECIES, AND CONNECTIONS, PER SE.

[24] DECK RAILING, PRE-FAB, ALLM. RAILING (FACTORY PAINTED) W/ CABLE RAILING SYSTEM (ALT. TEMPERED GLAZING), OR 6C/CLIENT APPVD. ALT.

[25] FINISH FLOORING & BASE TRIM PER 6C/CLIENT, OVER EXST'G FLOOR FRAMING. SEE ARCHITECTURAL & STRUCTURAL PLANS VERIFY EXST'G BATT INSUL TO BE R-30 PER CODE

[26] FINISH GRADE (VARIES), SLOPE 2% AWAY FROM BLDG. FIRST 5' MIN. FOR POSITIVE DRAINAGE

127 ROOF JOISTS AT EXTERIOR OVERHANG PER STRUCTURAL & ROOF PLAN.

24X 48 SKYLIGHT- INSTALL, CRICKET & FLASHING PER MFR. 'S SPECS. FOR POSITIVE DRAINAGE TYP.

29 CRAWL SPACE BX16 VENTING INSERTS: SIZE/ SPACING FOR 1: 150 CLR VENTING & CROSS PREEZE PER GC, TO MEET IRC. SPACING & CODE COMPLIANCE. ONE VENT OPENING SHALL BE WITHIN 5' OF EACH CORNER OF THE BLDG.

*NOTE: INSULATION VALLES STATED HEREIN ARE BASED ON IRC. "BASE VALLES" PER CODE. PERMIT SUBMITTAL APPLICATION FORMS AND DOCUMENTS MAY INCLUDE WASHINGTON STATE ENERGY CODE COMPLIANCE FORMS AND POTENTIAL PRODUCT SELECTIONS. GC. SHALL REFERENCE BOTH THE DRAWINGS AND THE W.S.E.C. FORMS FOR PRODUCT SELECTIONS AND RELATED "U" AND/OR "R" VALUES OF PRODUCTS SUCH AS INSULATION, GLAZING / FENSTRATION, AND THE LIKE. MOST RESTRICTIVE (TYPICALLY THE WISELO. FORM CHOICES FOR "CREDITS") SHALL BE THE REFERENCE TO BE UTILIZED FOR PRODUCT ORDERING AND INSTALLATION. GC / CLIENT MAY MAKE "OR EQUAL" ALTERNATE SELECTIONS, BUT SHALL LET THE GOVERNING JURISDICTION KNOW OF ANY SUCH CHANGES FROM THE INITIAL PERMIT SUBMITTAL INFORMATION.

CODE COMPLIANCE NOTES

SEE ADDITIONAL WALL AND BUILDING SECTIONS & SHEETS IN A-4XX SERIES FOR CODE COMPLIANCE REQUIREMENTS WHERE NOT OTHERWISE STATED PER DRAWINGS HEREIN, TYP.

GENERAL SECTION NOTES

|. Based on design intent documents provided Herein, owner to provide, verify, OR OTHERWISE APPROVE ALL PRODUCT AND MATERIAL SELECTIONS PRIOR TO GC ORDER AND OR INSTALLATION OF ANY PRODUCTS / MATERIALS RELATED TO PROJECT.

2. PROVIDE THERMAL AND SOUND BATT INSULATION AT ALL FLOORS, WALLS, RAFTERS, AND INTERIOR PARTITIONS UNLESS OTHERWISE NOTED. SEE THERMAL VALUES / TABLES IN GENERAL ARCHITECTURAL NOTES SHEET(S). INSULATION MAY NOT BE SHOWN FOR CLARITY.

3. DOORS AND WINDOWS SHOWN FOR DESIGN INTENT AND PERMIT APPD. SIZE AND LOCATION ONLY. SEE SCHEDULES AND OWNER APP'D SELECTIONS FOR COORDINATION PRIOR TO ORDER / INSTALLATION.

4. UNLESS OTHERWISE NOTED, ALL EXTERIOR STUDS ARE NOMINAL 2x6. ALL INTERIOR PLUMBING WALLS ARE NOMINAL 2X6. ALL OTHER INTERIOR STUDS ARE NOMINAL 2x4. SEE | BUILDING AND WALL SECTIONS FOR TYPICAL WALLTYPES AND ADDITIONAL INFO.

UNLESS OTHERWISE NOTED, ALL DIMENSION LINES ARE ASSUMED TO BE FROM FACE

6. SEE SHEETS A-2.1 , A-3.1 AND A-4.1 FOR ALL DOOR AND WINDOW TYPES, DIMENSIONS, TRIM, AND ADDITIONAL INFO. RELATED.

FOOTINGS, STEM WALLS, AND STEPPED CONDITIONS SHOWN ARE FOR DESIGN INTENT ONLY. ALL FOOTING SIZES, STEM WALL THICKNESSES AND OTHER STRUCTURAL BEARING CONSIDERATIONS ARE PER PRESCRIPTIVE PATH. CODE REQTO SIZES AND HEIGHTS/DEPTHS/COVERAGES MUST BE COMPLIANT W/ MOST RESTRICTIVE APPLICABLE CODE AND LOCAL JURISDICTIONAL REQIMTS.

8. ANYWHERE MINIMUM REQUIREMENTS ARE CALLED OUT ON DRAWINGS REFER TO GENERAL NOTES AND SPECIFICATIONS FOR ADHERENCE TO MOST RESTRICTIVE CODE AND / OR SPECIFICATION REFERENCE.

REVISIONS INT. DATE REV

DESIGNER: \emptyset

PROJECT NO: 19198


SHEET NO:

Ø5/17/18

DRAFTER:

DATE:

Established Basic Permit # 19-03650

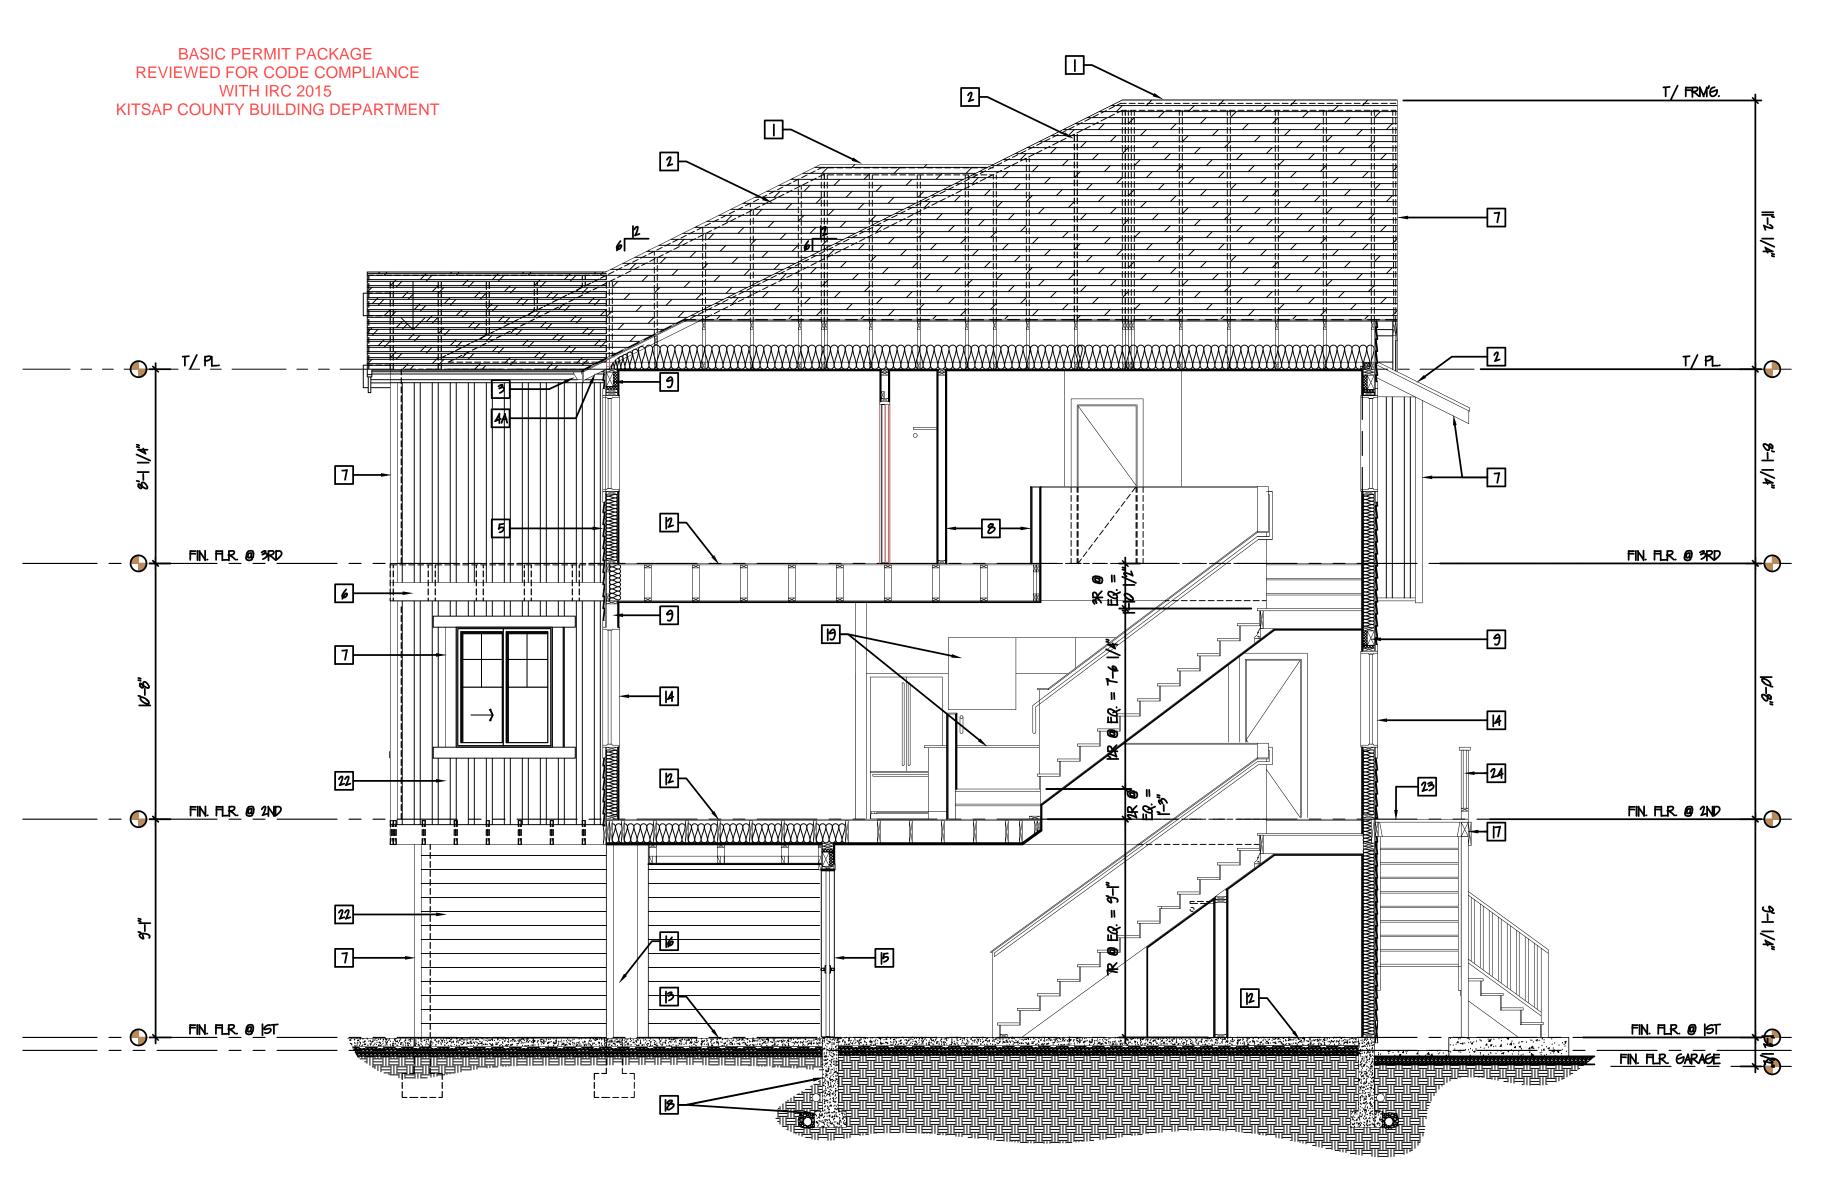

BUILDING LONGITUDINAL SECTION SCALE: 1/4"=1'-0"

BUILDING SECTIONS - KEY NOTES

- ROOF VENTING: CONTINUOUS RIDGE VENT AT ALL RIDGE LOCATIONS, COR-A-VENT 600 OR APPVD. ALT. TYP. ALL LOCS. UND.
- 2 ROOF ASSEMBLY:
- ROOFING PER EXTERIOR FINISH SCHEDULE, SEE A-3XX SHEET SERIES OVER 30# PLDG PAPER (2 LAYERS @ 15# EACH, OVERLAP PER MFR. SPECS,
- OVER PLYWOOD/OSD ROOF SHEATHING PER STRUCTURAL ENGINEER, OVER ROOF RAFTERS PER SE. W/ BATT INSULATION = R-49 @ FLAT BOTTOM CHORDS, OR R-38 BATT INSULATION @ VAULTED CEILINGS, TYP.
- OVER 1/2" INTERIOR GWB. MUD, TAPE, TEXTURE, PRIME & PAINT * NOTE: BAFFLE INSULATION SPACES AS REQD. FOR VENTILATION (|" AIR FLOW @ EAVES), PER IRC. & ARCH. NOTES, 60 COORD W/ MFR. & INSTALLER<u>ROOFING:</u> 3-TAB ARCHITECTURAL REVEAL SHINGLE STYLE ROOFING, MIN. 40 YR. WARRANTY, COLOR/FINISH PER 6C/ CLIENT.
- 3 <u>GUTTERS & DOMNEPOUTS:</u> 4" COLD ROLLED ALLM. (OR APPD ALT.), PROFILE (K-LINE OR SIM.) PRODUCT, COLOR & FINISH BY GC/OMNER. TIGHT LINE ALL LOCS. TO SUB-GRADE DRAINAGE SYSTEM AT PERIMETER FOOTINGS, TYP. ALL LOCS. SEE BUILDING | III STEM WALLS / FOUNDATIONS / FOOTINGS: SECTIONS FOR ADDITIONAL INFORMATION IF/AS REQUIRED.
- SOFFITS:

 44 4A-EXPOSED OPEN ROOF TRUSS EAVE RAFTER TAILS W/ CONT. PIRD PLOCKING/ VENTING SETWEEN, PER INDUSTRY STDS.
- 45 AB: CLOSED SOFFITING AT COVERED PORCH "CEILINGS", 3/4×6 T&G TK. CEDAR W/ CONT. STRIP VENTING, COLOR/ STAIN PER 6C/ CLIENT.
- 5 EXTERIOR WALL ASSEMBLY: SIDING PER EXTERIOR ELEVATIONS FINISH SCHEDULE (SEE SHEET A-3X SERIES),
- OVER WEATHER BARRIER EXTERIOR BUILDING WRAP (TYVEK OR EQUAL) OVER WALL SHEATHING PLYWOOD/OSD PER STRUCTURAL ENGINEERING, OVER 2x6 FRAMING @ 16" OC. MAX. AND IRC. APPROVED SPACING AND FRAMING LAYOUTS @ WALL TRANSITIONS
- OVER VAPOR BARRIER (WARM SIDE, ALT. V.B. PRIMER), OVER 1/2" INTERIOR 6.W.B. - MUD, TAPE, TEXTURE, PRIME & PAINT

W/ CONTINUOUS R-21 MIN. BATT INSULATION,

- 6 BELLY BAND / BOARDS: * STAIN/ COLOR/ FINISH PER 6C/CLIENT, TYP. ALL LOCS. UNO. 2x8's @ TOP PLATE SIDING TRANSITIONS, FLOOR LINE SIDING TRANSITIONS, TYP. UND. (OPT.) 5/4x4's HORIZONTAL @ TOPS OF SIDING END CONDITIONS UNDER EAVES. APPLIED TIGHT TO UNDERSIDE @ RAFTER TAILS
- "WATER TABLE" (FLOOR LINE BELLY BAND) 2x12's TYP. ALL LOCG., UNO. 7 EXTERIOR TRIM LOCATIONS:
- PRE-PRIMED WHITE WOOD OR APPD. ALT. PRODUCT/COLOR BY 6C./ONNER WINDOWS & DOORS: - VERTICALS @ JAMPS, 5/4×4
- HEADS, & SILLS 5/4X6 WITH 2X SILL LEDGE TABLE RIPPED & FLASHED FOR POSITIVE PRAINAGE, & 5/4X6 SKIRT BLW. FASCIA BOARDS: 2x|4's @ EAVES, 2x5's OVER 2x|4's @ MAIN GABLE ENDS, 2x|0's @ GARAGE (IF APPLICABLE), UN.O. CORNER BOARDS. 5/4x6 EXTERIORS, 1x1 INTERIORS

- 8 INTERIOR WALL ASSEMBLY NON BEARING WALLS: /2" GWB OVER 2X4 FRAMING @ 16" OC. MAX (UNO. PER SE) OVER 1/2" GWB — MUD, TAPE, TEXTURE, PRIME AND PAINT.
- 9 STRUCTURAL HEADERS: LOCATED @ ALL DOOR AND WINDOW ROUGH OPENINGS, UNO. SEE STRUCT. FOR SIZE/LOC., TYP. -INFILL SPACE W/ RIGID INSUL. TYP.
- 10 CHIMNEY (IF USED): MANUFACTURER'S SPEC. FOR INTERNAL FIRE RATED FILLE & CONSTRUCTION UP TO AND THROUGH/INCLIDING SPARK ARRESTOR. EXTERIOR SIDING/TRIM AS SHOWN GRAPHICALLY, & PER SIDING/TRIM NOTES HEREIN. + NOTE: ALL CHIMNEY LOCATIONS IF/AS SHOWN, SHALL EXTEND AT MIN. 24" ABOVE ANY ROOFLINE W/IN 10 HORIZONTALLY, TO MEET IR.C. & IF*C. CODES AS REQ*UIRED.
- DIRECT VENT F.P. AUTLET: COORDINATE OUTLET ROUTE, LOCATION, & SIZE PER CODES W/ 6C & CLIENT & PER MFR. SPECS.
- - CONCRETE PATIOS & WALKWAYS: SLOPE 2% MIN. AWAY FROM BLDG. IN ALL DIRECTIONS, WEATHER SEALANT & STAIN/STAMP FINISH PER 60 & CLIENT, TYP. ALL LOCS. - SEE STRUCT. ENG. FOR THICKNESS & REINFORCING, TYP.
- FL*OOR ASS*EMBLY (IF USED): FINISH FLOORING & BASE TRIM PER 6C/CLIENT, TYP. ALL ROOMS,
- OVER PLYWOOD PER STRUCT. ENG.,
- OVER FLOOR FRAMING / TJI JOISTS PER STRUCT. W/ CONT. R-30 \$ATT INSUL PER CODE, OVER BEAMS PER STRUCT. AND/OR HUNG / SEATED ON STEM WALLS, SEE STRUCT. DETAILS,
- FLOOR AGGEMBLY GLAB ON GRADE (IF USED): CONC. GLAB THICKNESS & REINFORCEMENT PER STRUCT. ENG. CLEAR SEALED FINISH, OVER 6 MIL. VAPOR BARRIER

SELECTION OF THE CLIENT PER 6C OPTIONS. ARCHITECT AVAILABLE FOR CONSULTATION IF/AS NEEDED.

- OVER 1" SAND OVER 4" WASHED CRUSHED ROCK OVER COMPACTED SOILS FREE OF ORGANICS AND STRUCT. APPROVAL FOR BEARING CAPACITY.
- 14 <u>Windows (exterior glazing):</u> Per design intent as shown graphically herein. Sizing per plan, operation style per EXT. ELEVATIONS. PRODUCT SELECTION, INCLIDING BRAND, STYLE, GRILL LAYOUT, HARDWARE, AND THE LIKE SHALL BE THE
- [5] <u>Doors (exterior fenestration):</u> Per Design Intent as shown graphically Herein. Sizing Per Plan, operation style PER EXT. ELEVATIONS. PRODUCT SELECTION, INCLUDING BRAND, STYLE, GRILL LAYOUT, HARDWARE AND LIKE SHALL BE THE SELECTION OF THE CLIENT W/ GC OPTIONS. ARCHITECT AVAILABLE FOR CONSULTATION IF/AS NEEDED.
- EXTERIOR COLUMNS & COLUMN TRIM/WRAP: STRUCTURAL COLUMN SIZING PER SE DRAWINGS AND CALCULATIONS. COLUMN WRAP" (INCLOSIRE FRANING) TO INCLIDE ROUGH SAWN WHITE WOOD EXTERIOR GRADE PRE-PRINED 5/1/x TRIM WRAP (SEE TEOOR PLANS & DETAILS) W/ 5/4XS BASE (PROD OF COLIMN WRAP) AND 5/4X6 COLIMN CAP (PROD OF COLIMN WRAP @ - UNDERSIDE OF WRAPPED BEAM OR CELLING ABOVE). FINAL PRODUCT SELECTIONS, STAIN / FINISH, TO BE PER 60 / CLIENT
- 17 BEAMS: PER STRUCTURAL ENGINEERING DESIGN, DRAWINGS, DETAILS, AND CALCULATIONS, TYP. ALL LOCS. UND. FINISH / WRAP @ INTERIORS: EXPOSED, CLEAR STAIN/SEALANT IF ARCHITECTURAL GRADE SELECTED. FINISH / WRAP @ EXTERIORS: EXPOSED, EXTERIOR WATERPROOFING, CAP/FLASH TOP/ENDS TO MATCH ROOFING MATERIALS, TYP. ALL LOCS. UNO.

18 FOOTING, STEM WALL & CRAWL SPACE: FOOTINGS, STEM WALL THICKNESSES, AND REINFORCING / CONNECTIONS PER STRUCTURAL ENGINEERING. HOLD WOOD SIDING MATERIALS MIN. 7" ABOVE EXISTING OR PROPOSED FINISH GRADING ELEVATIONS, TYP. ALL LOCS. SEE BUILDING SECTIONS FOR BATT INSULATION, EXTERIOR RIGID INSULATION (FOR W.S.E.C. IF/AS REQD.), WEATHERPROOFING & FLASHING (PER INDUSTRY STANDARDS) AND ANY ADDITIONAL

INFORMATION, TYP. - #NOTE: VENTING CODE REQD. 150 RATIO SF. FREE VENT AREA TO FLOOR SF. AREA - CROSS VENTILATION WITH 8x16 INSERTS, TYP. AS REQU AT CRAWL SPACE LOCS., USING IRC. CODE COMPLIANT SPACING & SEPARATIONS, TYP.

- 19 INTERIOR ELEVATION ELEMENT KITCHEN CABINETS AND COUNTER AT 36" AFF.
- 120 Interior Elevation Element Shower Englosure per Plan
- 21 INTERIOR ELEVATION ELEMENT KITCHEN HOOD V.T.O.S.
- [22] EXTERIOR SIDING: PER EXTERIOR ELEVATIONS & FINISH SCHEDULE, AS SHOWN GRAPHICALLY OR OTHERWISE DEFINED.
- DECK ASSEMBLY:
 DECK PRODUCTS & FINISHES PER OWNER/ GC (TREX, CEDAR, OR APP'VD. ALT.) INSTALLATION PER MANUFACTURERS SPECIFICATIONS AND INSTRUCTIONS, OVER PRESERVATIVE (PRESSURE) TREATED DECK
- JOISTS, OVER PRESERVATIVE TREATED BEAMS, SIZING, SPACING, SPECIES, AND CONNECTIONS, PER SE. [24] DECK RAILING. PRE-FAB. ALLIM. RAILING (FACTORY PAINTED) W/ CABLE RAILING SYSTEM (ALT. TEMPERED GLAZING), OR 6C/CLIENT APPVD. ALT.
- 75 FINISH FLOORING & BASE TRIM PER 6C/CLIENT, OVER EXST'G FLOOR FRAMING. SEE ARCHITECTURAL & STRUCTURAL PLANS VERIFY EXST'S BATT INSUL TO BE R-30 PER CODE
- 126 FINISH GRADE (VARIES), SLOPE 2% AWAY FROM BLDG. FIRST 5' MIN. FOR POSITIVE DRAINAGE
- [27] ROOF JOISTS AT EXTERIOR OVERHANG PER STRUCTURAL & ROOF PLAN.
- 24X 48 9KYLIGHT- INSTALL, CRICKET & FLASHING PER MFR. 'S SPECS. FOR POSITIVE DRAINAGE TYP.
- [29] CRAWL SPACE 8X16 VENTING INSERTS: SIZE/ SPACING FOR 1: 150 CLR VENTING & CROSS BREEZE PER GC, TO MEET IRC. SPACING & CODE COMPLIANCE. ONE VENT OPENING SHALL BE WITHIN 5' OF EACH CORNER OF THE BLDG.

*NOTE: INSULATION VALLES STATED HEREIN ARE BASED ON I.R.C. "BASE VALLES" PER CODE. PERMIT SUBMITTAL APPLICATIO FORMS AND DOCUMENTS MAY INCLUDE WASHINGTON STATE ENERGY CODE COMPLIANCE FORMS AND POTENTIAL PRODUCT SELECTIONS. GC. SHALL REFERENCE BOTH THE DRAWINGS AND THE W.S.E.C. FORMS FOR PRODUCT SELECTIONS AND RELATED "U" AND/OR "R" VALUES OF PROPUCTS SUCH AS INSULATION, GLAZING / FENSTRATION, AND THE LIKE. MOST RESTRICTIVE (TYPICALLY THE W.SEC. FORM CHOICES FOR "CREDITS") SHALL BE THE REFERENCE TO BE UTILIZED FOR PRODUCT ORDERING AND INSTALLATION. GC / CLIENT MAY MAKE "OR EQUAL" ALTERNATE SELECTIONS, BUT SHALL LET THE GOVERNING JURISPICTION KNOW OF ANY SUCH CHANGES FROM THE INITIAL PERMIT SUBMITTAL INFORMATION.

CODE COMPLIANCE NOTES SEE ADDITIONAL WALL AND BUILDING SECTIONS &

SHEETS IN A-4XX SERIES FOR CODE COMPLIANCE REQUIREMENTS WHERE NOT OTHERWISE STATED PER DRAWINGS HEREIN, TYP.

GENERAL SECTION NOTES

- I. BASED ON DESIGN INTENT DOCUMENTS PROVIDED HEREIN, OWNER TO PROVIDE, VERIFY, OR OTHERWISE APPROVE ALL PRODUCT AND MATERIAL SELECTIONS PRIOR TO GO ORDER AND OR INSTALLATION OF ANY PRODUCTS / MATERIALS RELATED TO PROJECT.
- 2. PROVIDE THERMAL AND SOUND BATT INSULATION AT ALL FLOORS, WALLS, RAFTERS, AND INTERIOR PARTITIONS UNLESS OTHERWISE NOTED. SEE THERMAL VALUES / TABLES IN GENERAL ARCHITECTURAL NOTES SHEET(S). INSULATION MAY NOT BE SHOWN FOR CLARITY.
- 3. DOORS AND WINDOWS SHOWN FOR DESIGN INTENT AND PERMIT APPD. SIZE AND LOCATION ONLY. SEE SCHEDULES AND OWNER APP'D SELECTIONS FOR COORDINATION PRIOR TO ORDER / INSTALLATION.
- 4. UNLESS OTHERWISE NOTED, ALL EXTERIOR STUDS ARE NOMINAL 2x6. ALL INTERIOR PLUMBING WALLS ARE NOMINAL 2X6. ALL OTHER INTERIOR STUDS ARE NOMINAL 2x4. SEE
- BUILDING AND WALL SECTIONS FOR TYPICAL WALLTYPES AND ADDITIONAL INFO. 5. UNLESS OTHERWISE NOTED, ALL DIMENSION LINES ARE ASSUMED TO BE FROM FACE
- 6. SEE SHEETS A-2.1, A-3.1 AND A-4.1 FOR ALL DOOR AND WINDOW TYPES,
- DIMENSIONS, TRIM, AND ADDITIONAL INFO. RELATED. 7. FOOTINGS, STEM WALLS, AND STEPPED CONDITIONS SHOWN ARE FOR DESIGN INTENT ONLY. ALL FOOTING SIZES, STEM WALL THICKNESSES AND OTHER STRUCTURAL PEARING CONSIDERATIONS ARE PER PRESCRIPTIVE PATH. CODE REQUISIZES AND HEIGHTS/DEPTHS/COVERAGES MUST BE COMPLIANT W/ MOST RESTRICTIVE APPLICABLE
- 8. ANYWHERE MINIMUM REQUIREMENTS ARE CALLED OUT ON DRAWINGS REFER TO GENERAL NOTES AND SPECIFICATIONS FOR ADHERENCE TO MOST RESTRICTIVE CODE AND / OR SPECIFICATION REFERENCE.

CODE AND LOCAL JURISDICTIONAL REQINTS.

INT. DATE REV **DESIGNER:** Ø

REVISIONS


PROJECT NO: 19198 SHEET NO:

Ø5/17/18

DRAFTER: \emptyset


DATE:

Established Basic Permit # 19-03650

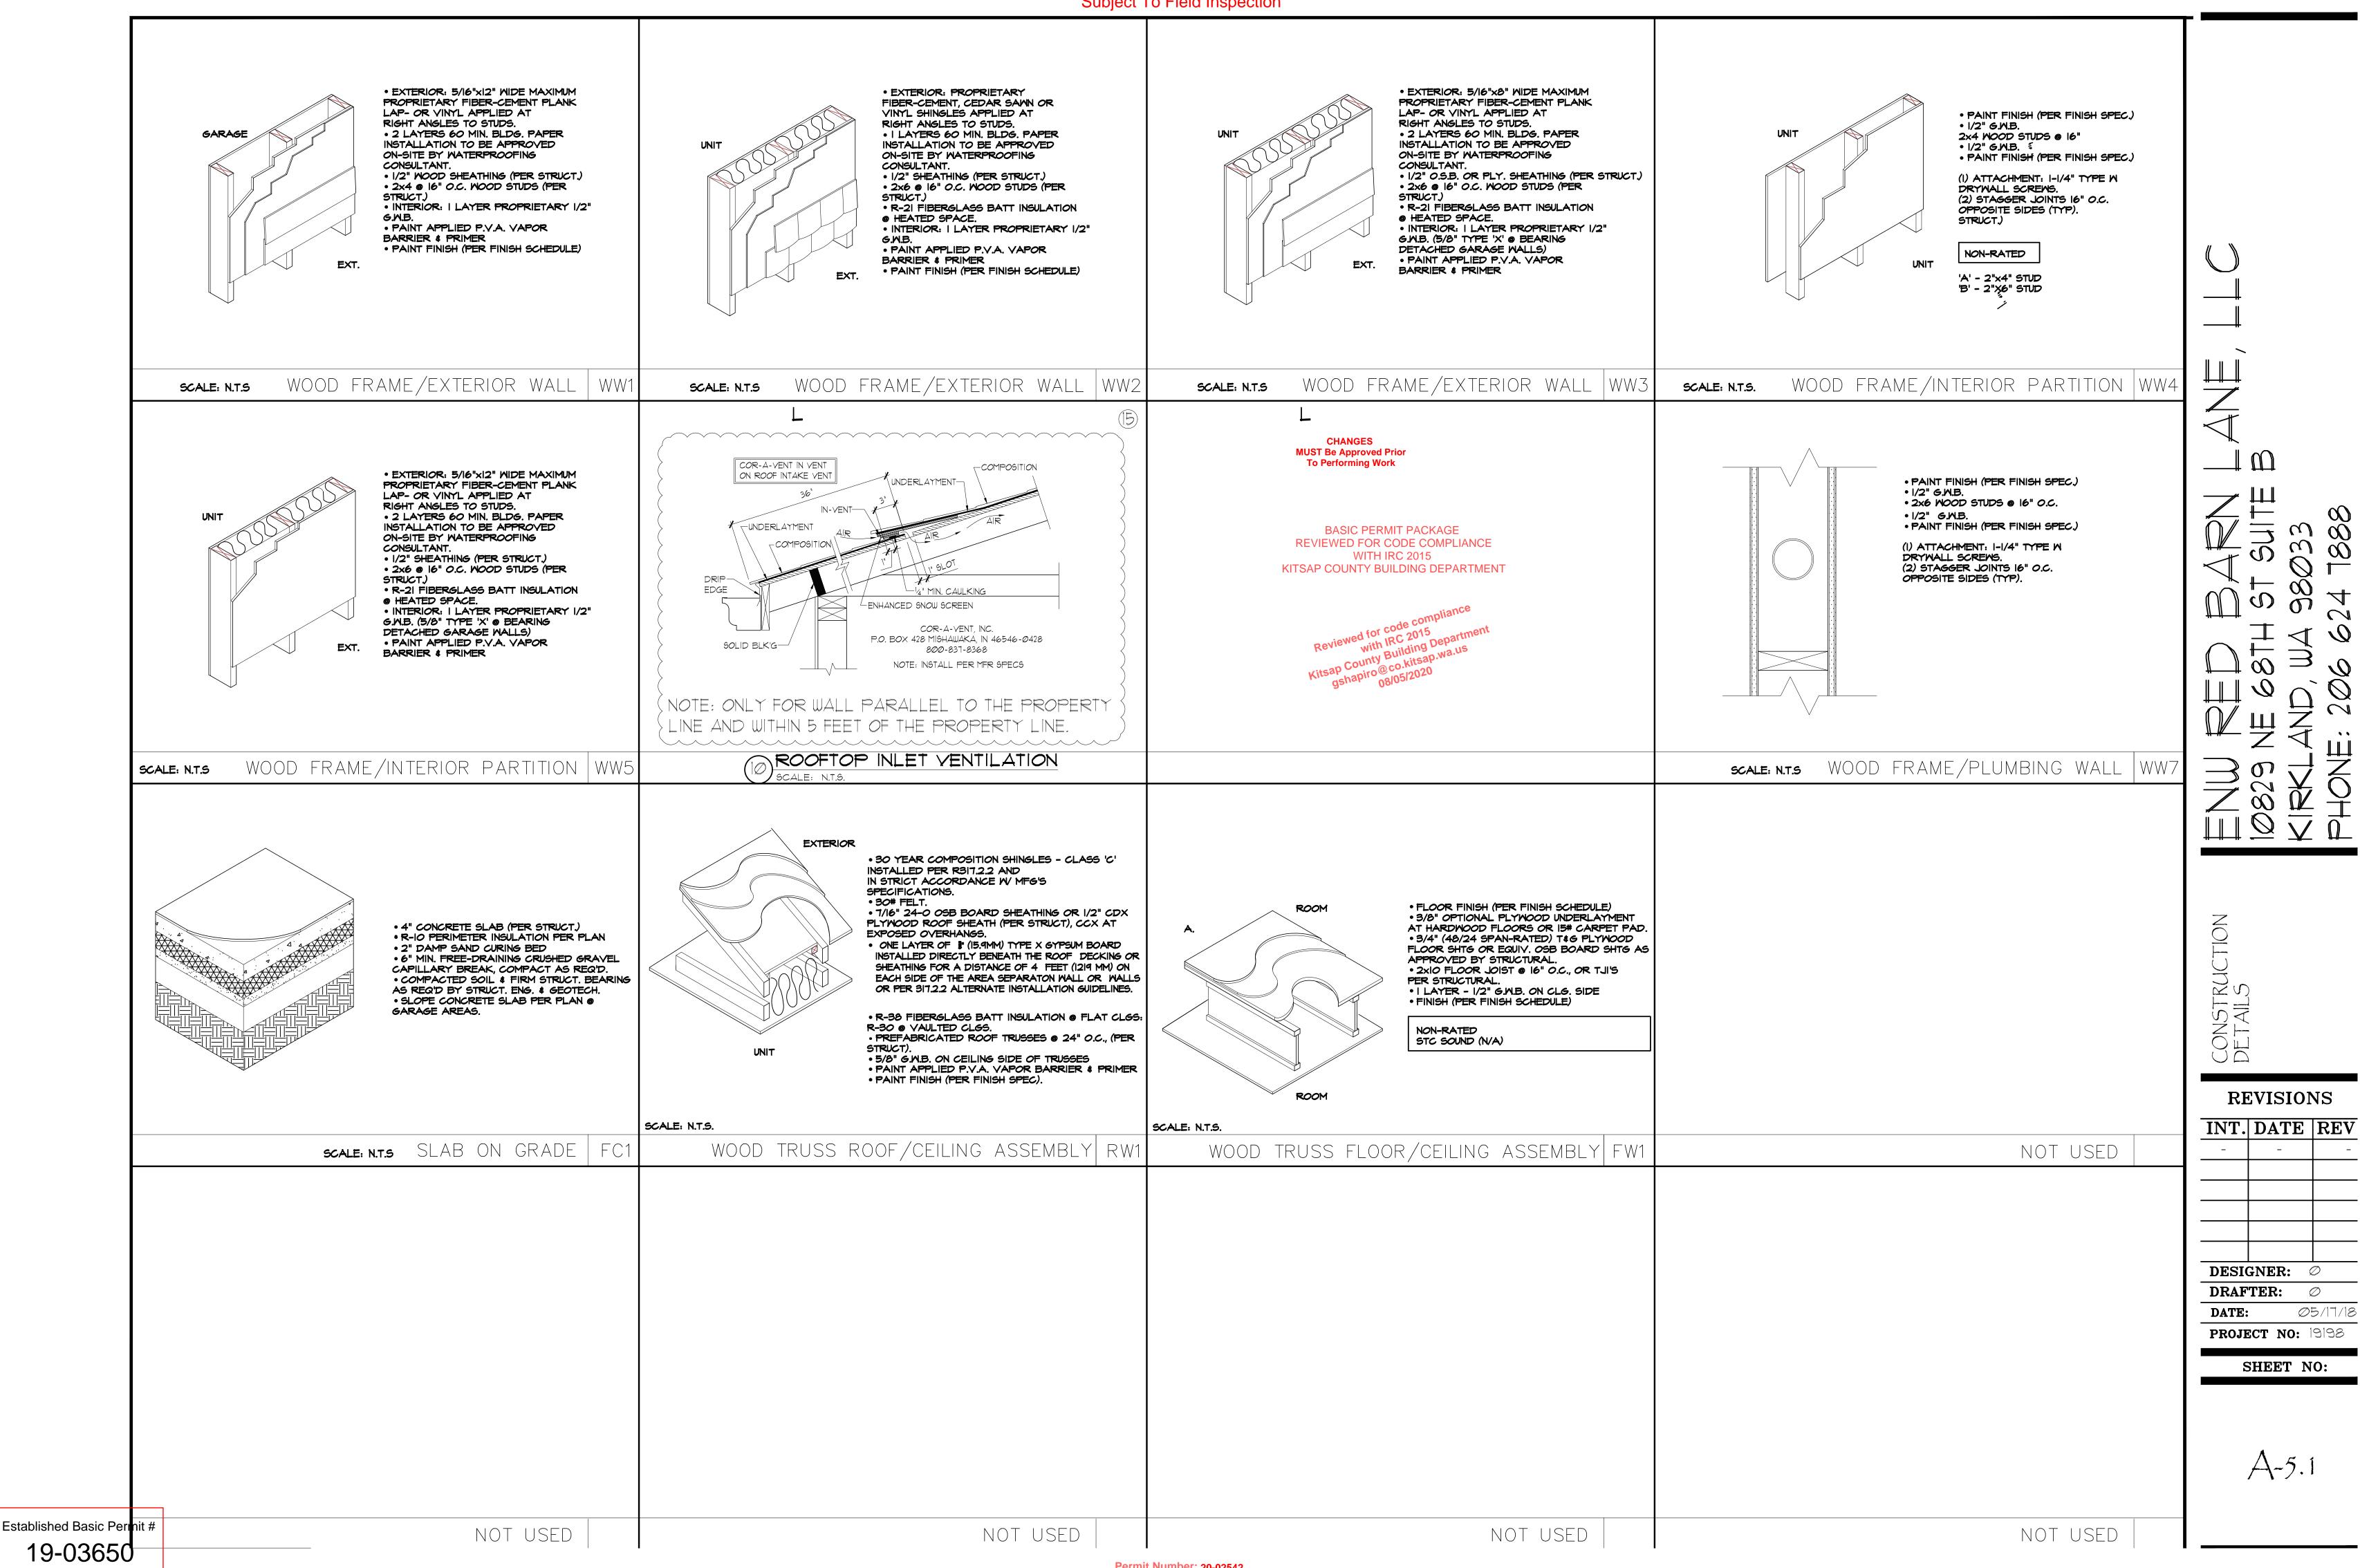


Permit Number: 20-02542

Subject To Field Inspection

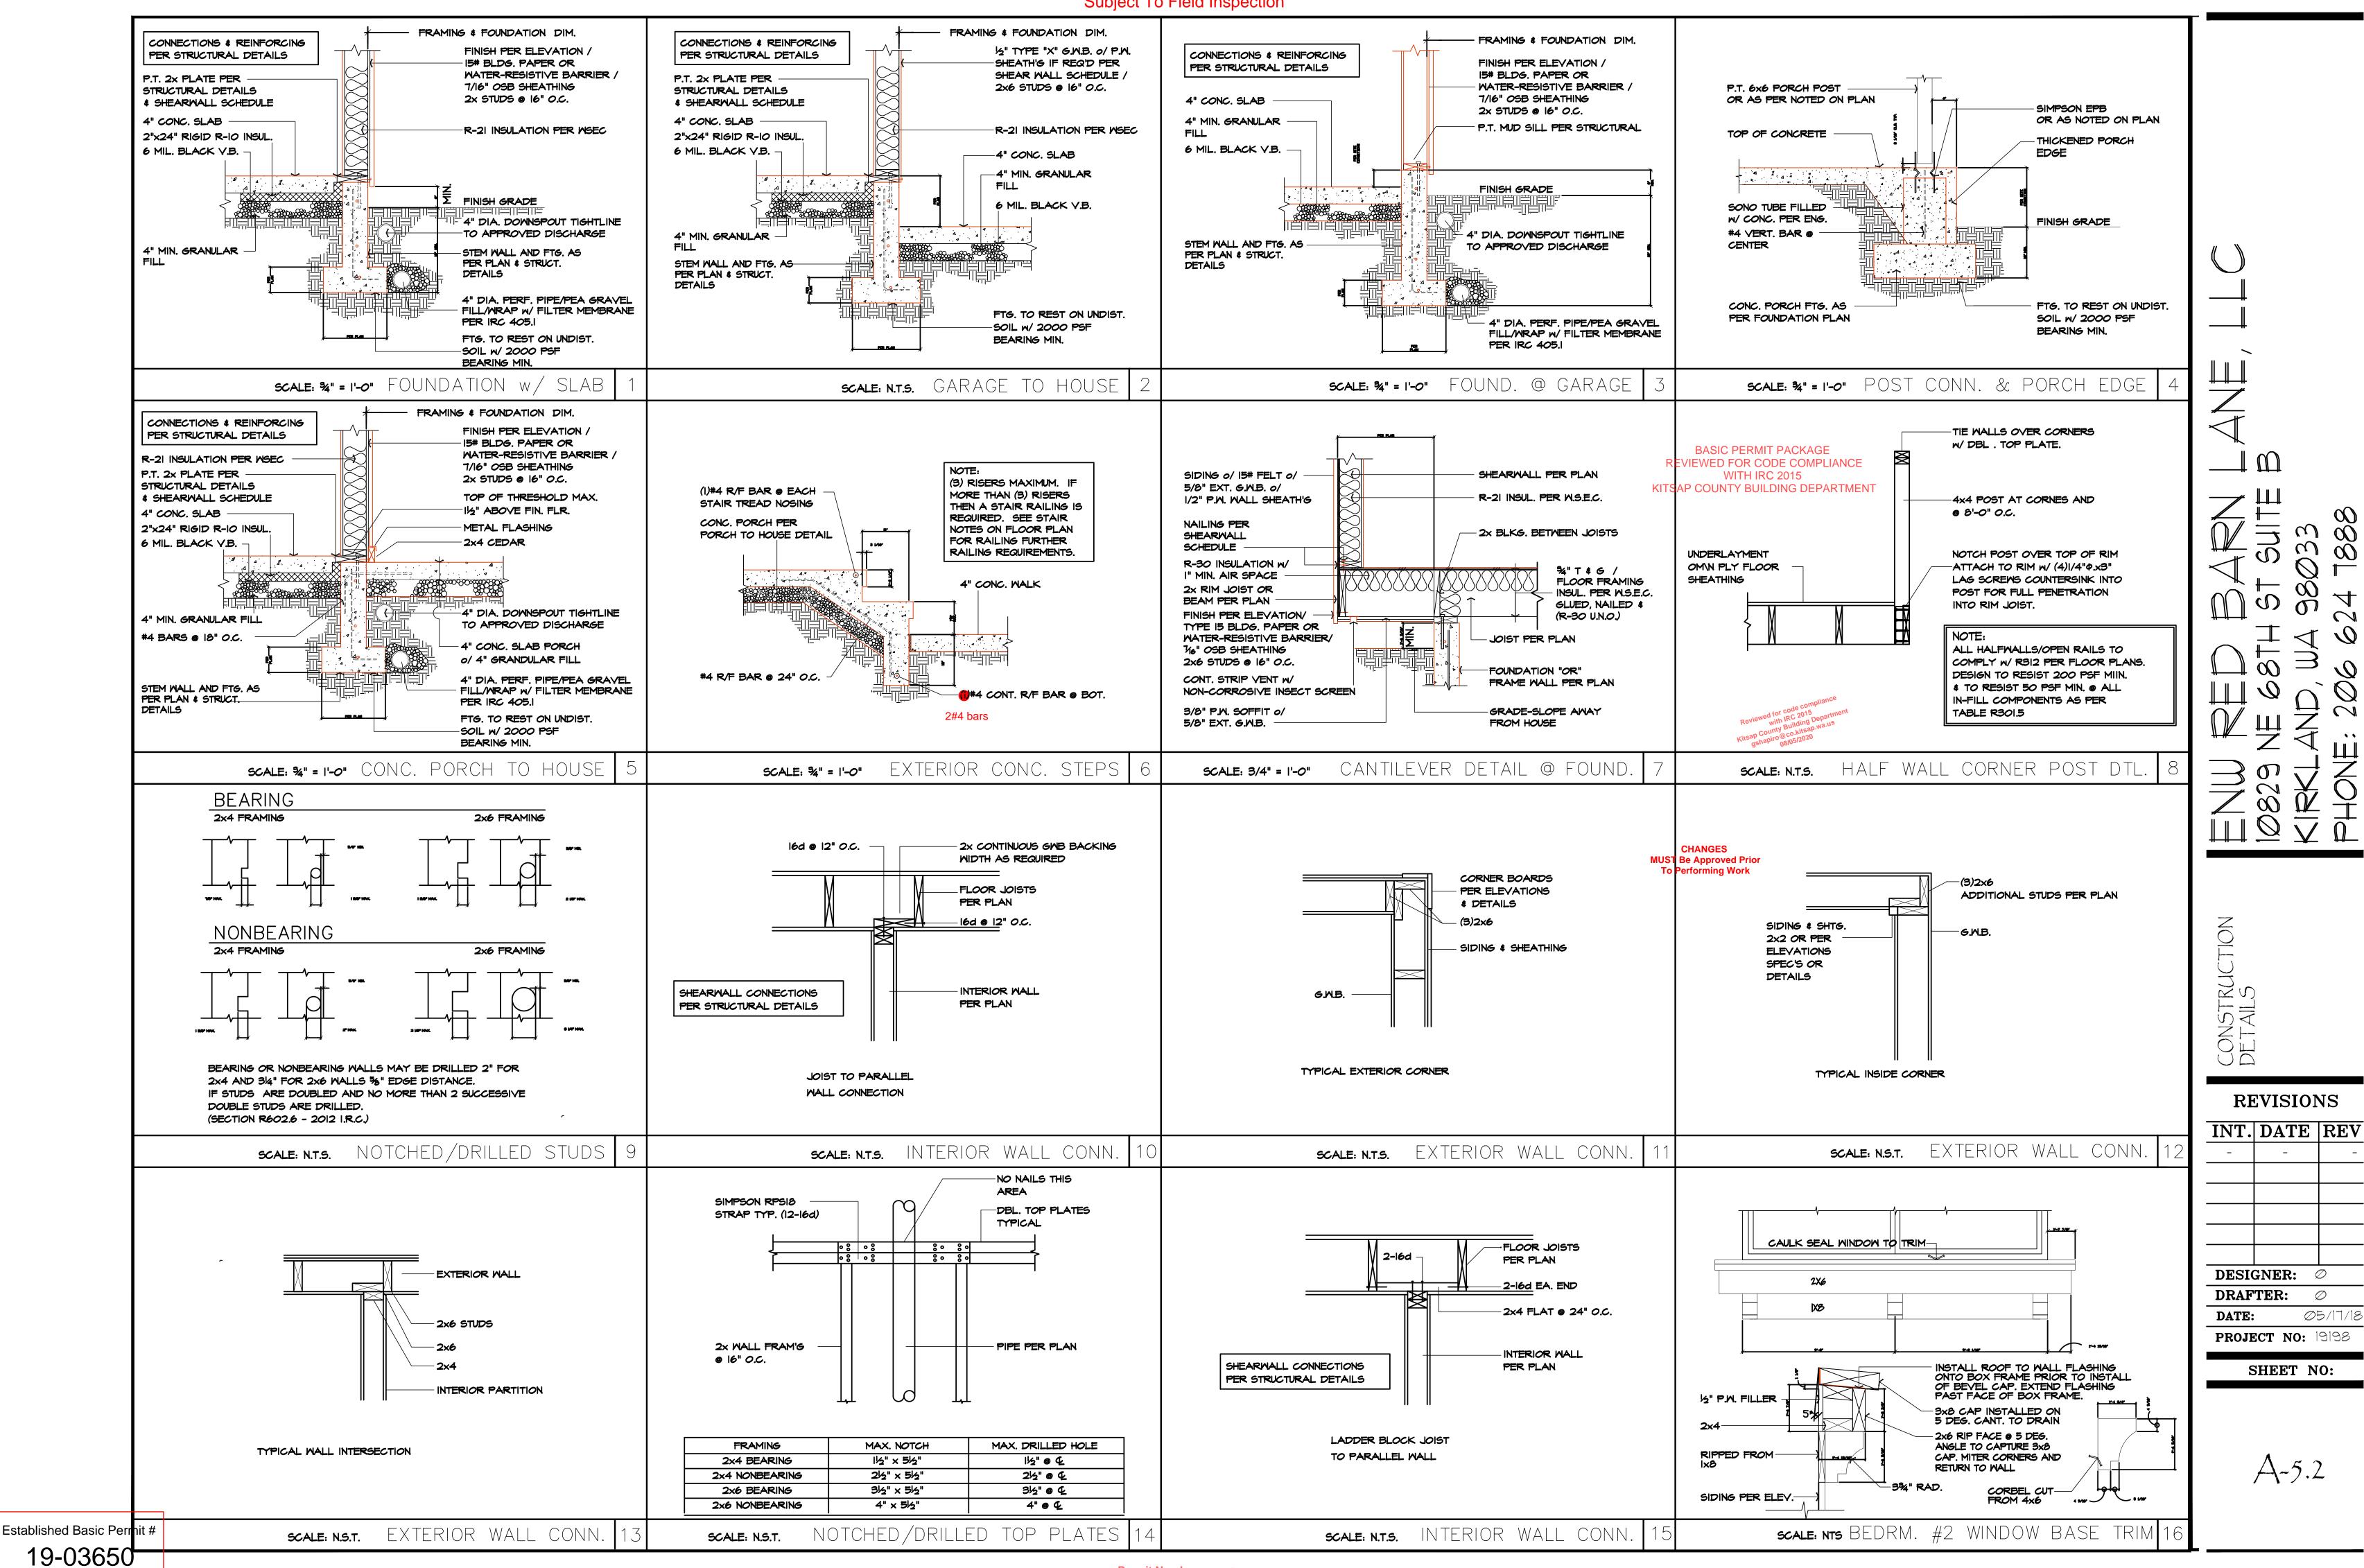

Subject To Field Inspection **BASIC PERMIT PACKAGE** CONNECTIONS TYPICAL ROOF SYSTEM: REVIEWED FOR CODE COMPLIANCE PER STRUCTURAL DETAILS ROOFING PER PLAN / **WITH IRC 2015** ROOFING PER PLAN / TYPE 15 FELT # 15 FELT (#30 @ CEDAR SHAKE) KITSAP COUNTY BUILDING DEPARTMENT ROOFING PER PLAN / TYPE 15 FELT (TYPE 30 @ CEDAR SHAKE) 1/6" O.S.B. 7/16" O.S.B "OR" 1/2" APA RATED (TYPE 30 @ CEDAR SHAKE) 1/6" O.S.B. 1/2" APA RATED SHTH'G / TRUSSES SHTH'G / TRUSSES PER PLAN / 5/16" FIBER CEMENT BOARD 1/2" APA RATED SHTH'G / TRUSSES PER PLAN / INSUL. PER W.S.E.C. (R-49) INSUL. PER W.S.E.C. (R-49 FLAT o/ 2x4 OUTLOOKERS-LAY -SHEAR WALL PER PLAN PER PLAN / INSUL. PER W.S.E.C. (R-49) R-38 VAULTED) FLAT @ 24" O.C. TIGHT FIT SOLID BLK'G INSULATION BAFFLE (CARDBOARD) CONNECTIONS PER ELEV. EXTEND 12" ABY. INSUL. 3/4"x8 BARGE w/ PER STRUCTURAL DETAILS -BOUNDARY NAILS PER PLAN I" MIN. CLEAR AIRSPACE IX3 TRIM o/ TRUSS PER PLAN CHANGES -ROOF SHEATHING PER PLAN T Be Approved Prior 2X TRIM 2x VENTED & SCREENED 2x SOLID BLOCKING Performing Work SHEATH WALL PER S.W. BELOW DASHED LINE DASHED LINE EAVE BLOCKING SCISSOR TRUSS SCISSOR TRUSS FRONT ELEY. ONLY - DO NOT - CONT. METAL FACIA GUTTER - CONT. METAL FACIA GUTTER CONDITION CONDITION SHEATH TRUSS SIDES/REAR 26 GA. TYP. 26 GA. TYP. - ROOF FRAMING RAKE PLATE OR PER PLAN 1/2" SAG RESIT. OR HEADER PER PLAN 1/2" SAG RESIT. OR HEADER PER PLAN GABLE END TRUSS % G.W.B. WHERE %" G.M.B. WHERE -2x6 LEDGER (OR TRUSS TOP VAULTS FINISH PER ELEVATION / 15# FINISH PER ELEVATION / 15# FRM'6 @ 24" O.C. FRM'6 @ 24" O.C. CHORD) W/ (3) OD EA. STUD CONNECTIONS BLDG. PAPER OR WATER-BLDG. PAPER OR WATER-2" G.W.B. WHERE 12" G.M.B. WHERE FINISH PER ELEVATION / PER STRUCTURAL DETAILS FRM'G @ 16" O.C. RESISTIVE BARRIER / 1/6" O.S.B. FRM'6 @ 16" O.C. RESISTIVE BARRIER / 1/6" O.S.B. 15# BLDG. PAPER OR SHEATHING OR PER SHEARWALL SHEATHING OR PER SHEARWALL WATER-RESISTIVE BARRIER / SCHEDULE / 2x6 STUDS @ 16" O.C. SCHEDULE / 2x6 STUDS @ 16" O.C. 16" OSB SHEATHING W/ FULL LENGTH STUDS (R-21 INSUL.) (R-21 INSUL.) @ RAKE WALLS 2x6 STUDS @ 16" O.C. (R-21 INSUL.) FRAMING & FOUNDATION DIM. FRAMING & FOUNDATION DIM. GABLE RAKE DETAIL ROOF LEDGER DETAIL ROOF EAVE DETAIL ROOF EAVE DETAIL @ 5' BSBL SCALE: 34" = 1'-0" SCALE: N.T.S. SCALE: N.T.S. SCALE: N.T.S. SHEARWALL PER PLAN HEADER OR BEAM PER PLAN FLASH & CNTR. WHERE OPENING >8'-0" DOUBLE TOP PLATE FLASHING-FIRESTOP LOCATE DIRECTLY o/ OPENING - ½" G.M.B. @ ROOF LINE -STC CLIP -2x10 ROOF SHEATHING - INSTALLED EVERY EDGE NAILING HEADER TO BE OTHER TRUSS R-49 BLOWN-IN TYP. - TIGHT AGAINST A35 TOP & BOTTOM 2× BLOCK BTWN. TRUSS TYP. EXT. SHEATHING 2× BLOCK BETWEEN OMIT @ OPEN'GS (8'-0" TRUSSES w/ lod STUDS w/ (2)10d TOENAILS - ½" G.M.B. EXT. WALLS ONLY ROOF SHEATHING **●** 6" O.C. ⁻ OR END-NAILS EACH END 46" O.S.B. MFG. ROOF TRUSSES (6)10d 2x2 FRAME ROOF SHEATHING TOP PLATE OF NON-ADDITIONAL BEARING (TRIMMER) EDGE NAILING STUDS WHERE SPECIFIED ON PLAN BEARING WALL -TYP. STUDS 2× VENT BLOCK PROVIDE (2)BEARING (TRIMMER) STUDS AT ENDS OF ALL HEADERS OR BEAMS 6'-O" OR OVER IN LENGTH DOUBLE KING STUD FIRST FLR. TOP 12 IXIO TRIM WHERE OPEN'S >8'-0" - BOTTOM CHORD OF TRUSS BEAM PER PLAN BOTTOM PLATE DOUBLE SILL SEISMIC TIE: BEAM PER PLAN WEATHER STRIP PLATES WHERE SIMPSON HI @ SMOOTH FACE CEM. BD. OPENING >8'-0" -Ix2 TRIM EACH TRUSS SIDING SOFFIT G.M.B. HANGER PER TRUSS MFG. TYPICAL HEADER SUPPORT SIMPSON STC CLIP DETAIL SCALE: NTS RAFT. PERP. TO WALL ATTIC ACCESS SCALE: N.T.S. (8)-10d COMMON (12) IOD COMMON 10d @ 12" O.C. NAILS -NAILS -STAGGERED PRE-FAB ROOF TRUSSES ELSEWHERE @ 24" O.C. (3) ROMS IOD COMMON @ 12" O.C. (TRPL. MEMBER NAIL EACH SIDE) FURR BEAM W/ 2x TO A FINISHED WIDTH OF 5½" FACE FLUSH W/ 6x6 POST DOUBLE --PLATE SPLICE TOP PLATE CEILING LINE PROVIDE STAIRWAY ILLUMINATION PER -INTERSECTING BIRD BLK. 8'-6" PORCH ? PARTITITION ASSEMBLY OF NOTE: STAIRWAY SHALL BE POSITIVELY 4x HEADER NEWELL POST NCHORED TO THE PRIMARY STRUCTURE WITHOUT USING TOE NAILS OR NAILS (IF OPT. RAIL IS IXIO TRIM SUBJECT TO WITHDRAWAL SELECTED) INSTALL (8)-10d NAILS WITHIN 5/4x4 TRIM - IXIO TRIM -4x4 POST -ALLOW 34" SPACING BETWEEN STAIRS AND WALL FOR DRYWALL APPLICATION 24" OF EACH END. INTERSECTING 2 ROWS IOD NAILS 1/2" SMOOTH FACE CEM. BD. -2x Framing @ Wall 为" SMOOTH FACE PARTITION OR SPLICE OF EACH STAGGERED. NAILS BELOW OPT. OPEN SIDING O/ BUILDING PAPER CEM. BOARD TRIPLE DOUBLE TOP PLATE. SEE DETAIL ABOVE MAY BE INSTALLED SIDING SOFFIT **REVISIONS** MEMBER MEMBER FOR CLARIFICATION FROM EITHER TOP HAND RAIL TO BE ATTACHED WITH OR BOTTOM METAL BRACKETS @ 24" O.C. 2x/ IX M.M. TRIM MRAP INT. DATE REV BLOCKING FOR RAILING SUPPORT o/ BUILDING PAPER SCALE: 3/4" = 1'-0" MULTI-MEMBER NAILING DETAL SCALE: N.T.S. DBL. TOP PLATE SPLICE @ 36" IN HEIGHT NOTCH 4x8 INTO STRINGER 6x6 P.T. POST CAULK ALL JOINTS IF WALL IS PER WALL PLAN REMOVED OPT. PLYWOOD WALL/DECK FLASHING SKIRT TRIM. 3/4" T&G EXT. GRADE PLYWOOD **BULLNOSE STAIR** - 2x STRINGER METAL FLASHING O/TRIM TREADS I" THK. II I/2" SHIM AS REQ. TO ELASTOMERIC WATERPROOF **DESIGNER:** CREATE ½" CANT DECKING INSTALLED AS PER MFGR. SPEC'S-TO BE INSTALLED FIRE BLOCK @ **DRAFTER:** \emptyset 5/4×4 M.M. TRIM MIDSPAN OF STAIRS BY LICENSED/BONDED INSTALLER RISER - IX8 UTIL Ø5/17/18 # BTR M/S 545 DATE: 2×4 REINFORCEMENT NAILED TO STRINGER PROJECT NO: 19198 WALL/DECK FLASHING SIDING PER PLAN o/ BUILDING PAPER SHEET NO: 1/2" SHEETROCK WHEN STAIRS ACCESSIBLE THRU HOUSE -IX4 W.W. TRIM 2x P.T. FRAMING WRAP W/ 1/2" P.W. IXI2 M.M. TRIM - 2×4 THRUST BLOCK SOLID RIP AS REQ. FOR 1/2" ANCHOR TOP OF PORCH REVEAL BLW. SOFFIT -2xIO RIM JOIST 2xIO P.T. HF#2 DECK JST. RIP CAP ATTACH LEDGER PER DETAIL X/53 WEDGE TOP TO SLOPE 1/4" PER 1'-0" TO DRAIN -CONT. SOFFIT VENT - 2x8 P.T. BLOCKING W/AIR SPACE SCALE: 3/4" = 1'-0" PORCH COLUMN SCALE: N.T.S. SUN DECK FRAMING DETAIL EXTERIOR CONC. STEPS Established Basic Perinit # Permit Number: 20-02542

Subject To Field Inspection

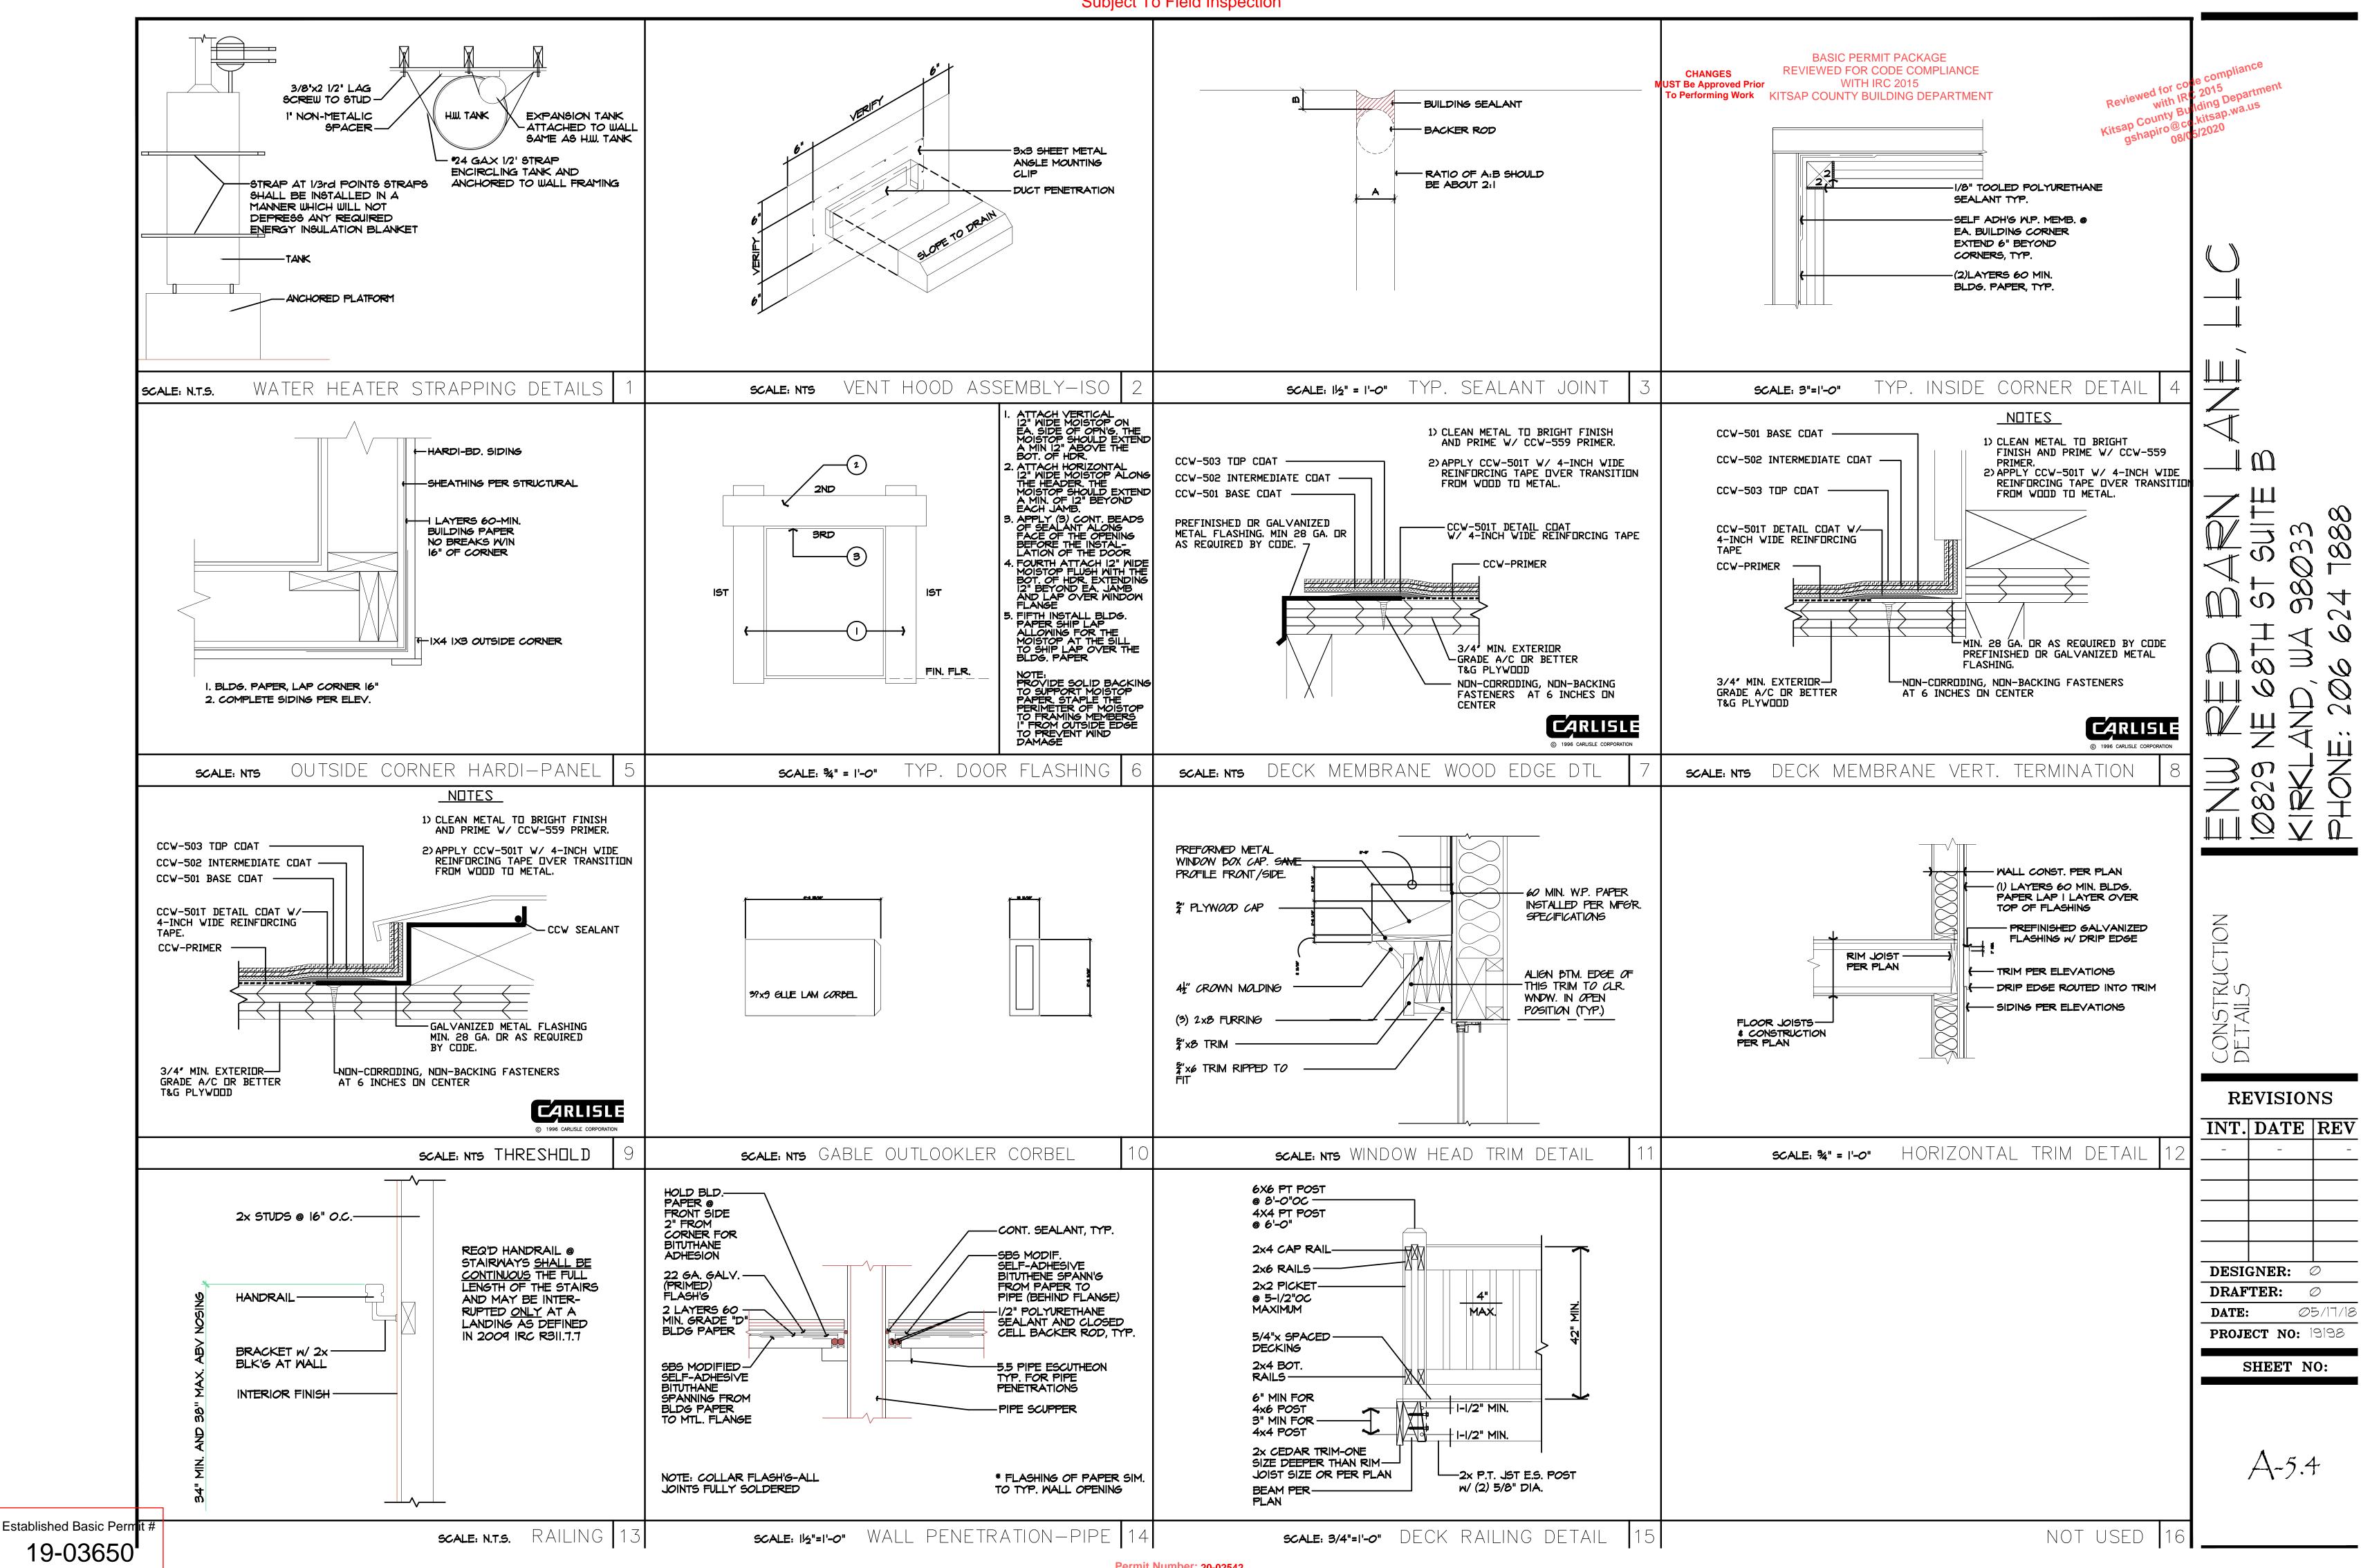

REVISIONS INT. DATE REV


DESIGNER: Ø **DRAFTER:** \emptyset

Ø5/17/18 DATE: PROJECT NO: 19198

SHEET NO:

Established Basic Permit #

19-03650

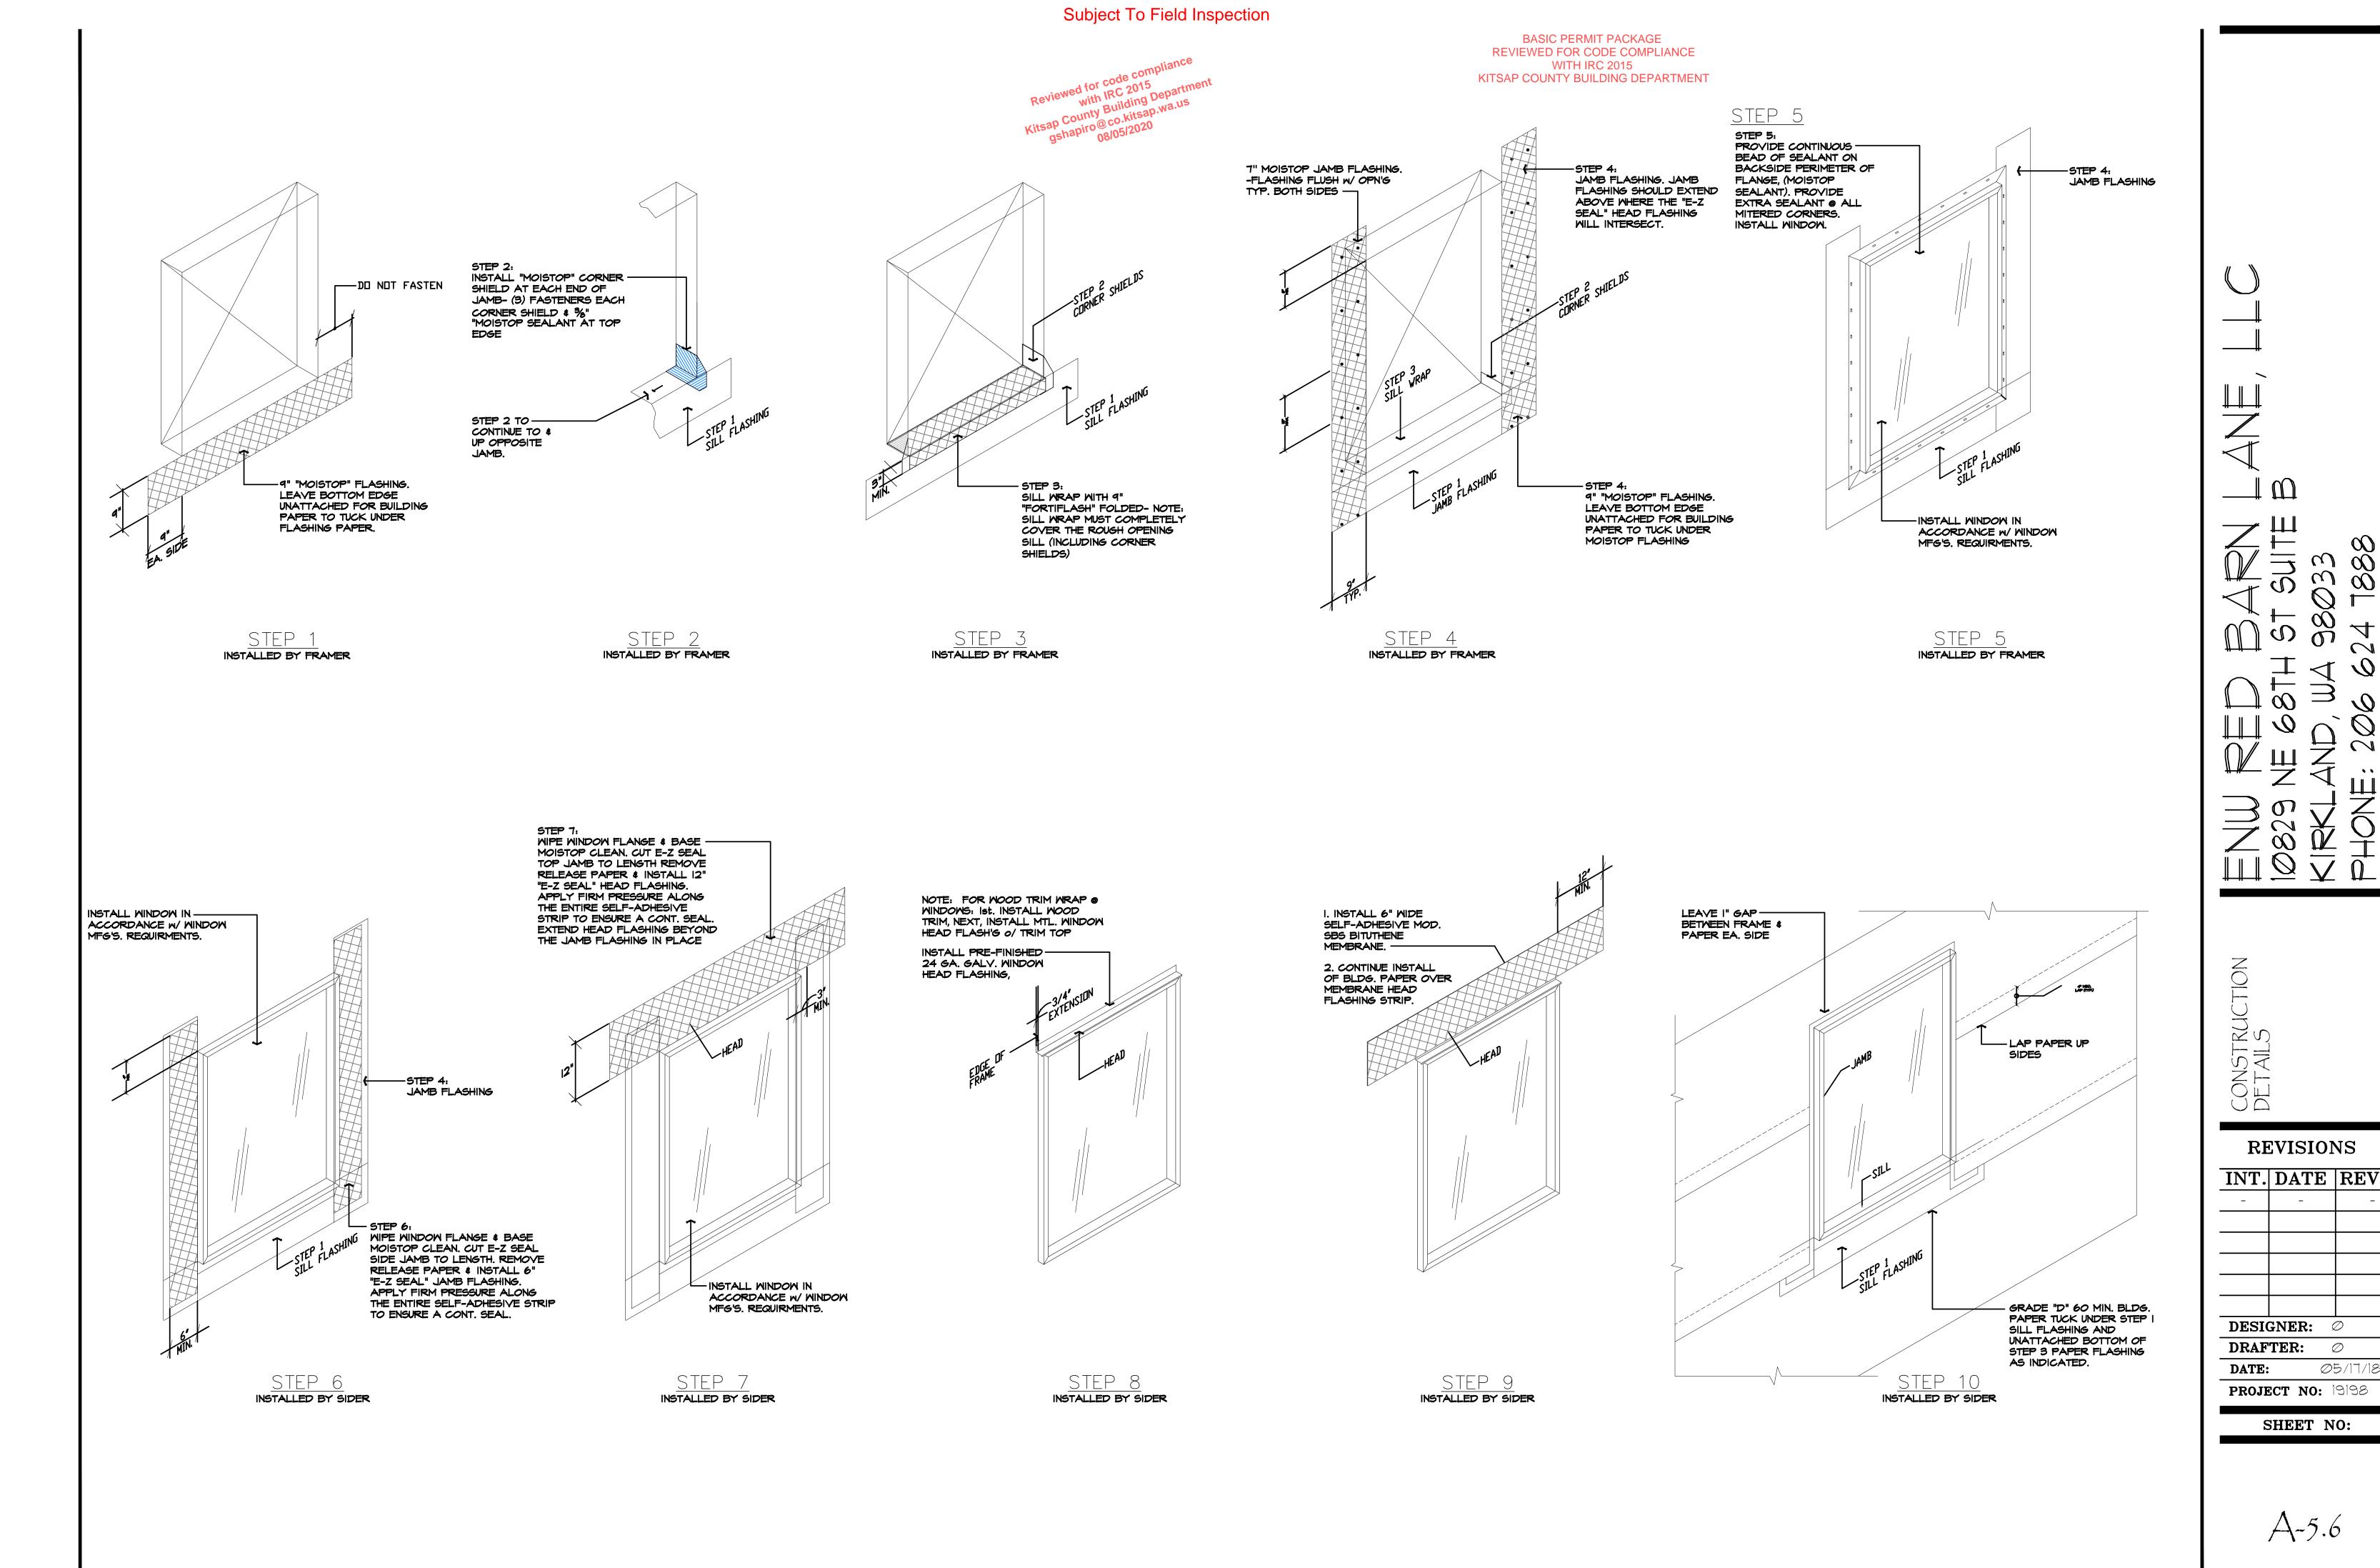

DRAFTER: \emptyset Ø5/17/18 PROJECT NO: 19198 SHEET NO: